


CONSTRUCTION PLANS FOR
WATERLINE IMPROVEMENTS
FOR
HAYSVILLE EMERGENCY WATERLINE
THE CITY OF HAYSVILLE
PEC PROJECT NO. 34-95676-1263

PUBLIC OFFICIALS

MAYOR
CITY COUNCIL

CITY CLERK


TOM LINDSAY
SANDRA BRADSHAW
DOROTHY BOOHER
MICHAEL MORRISON, SR.
BRUCE ARMSTRONG
PHIL HARRIS
WENDELL CORBETT
LARRY EMERSON
TIM NORTON
CAROL McBEATH

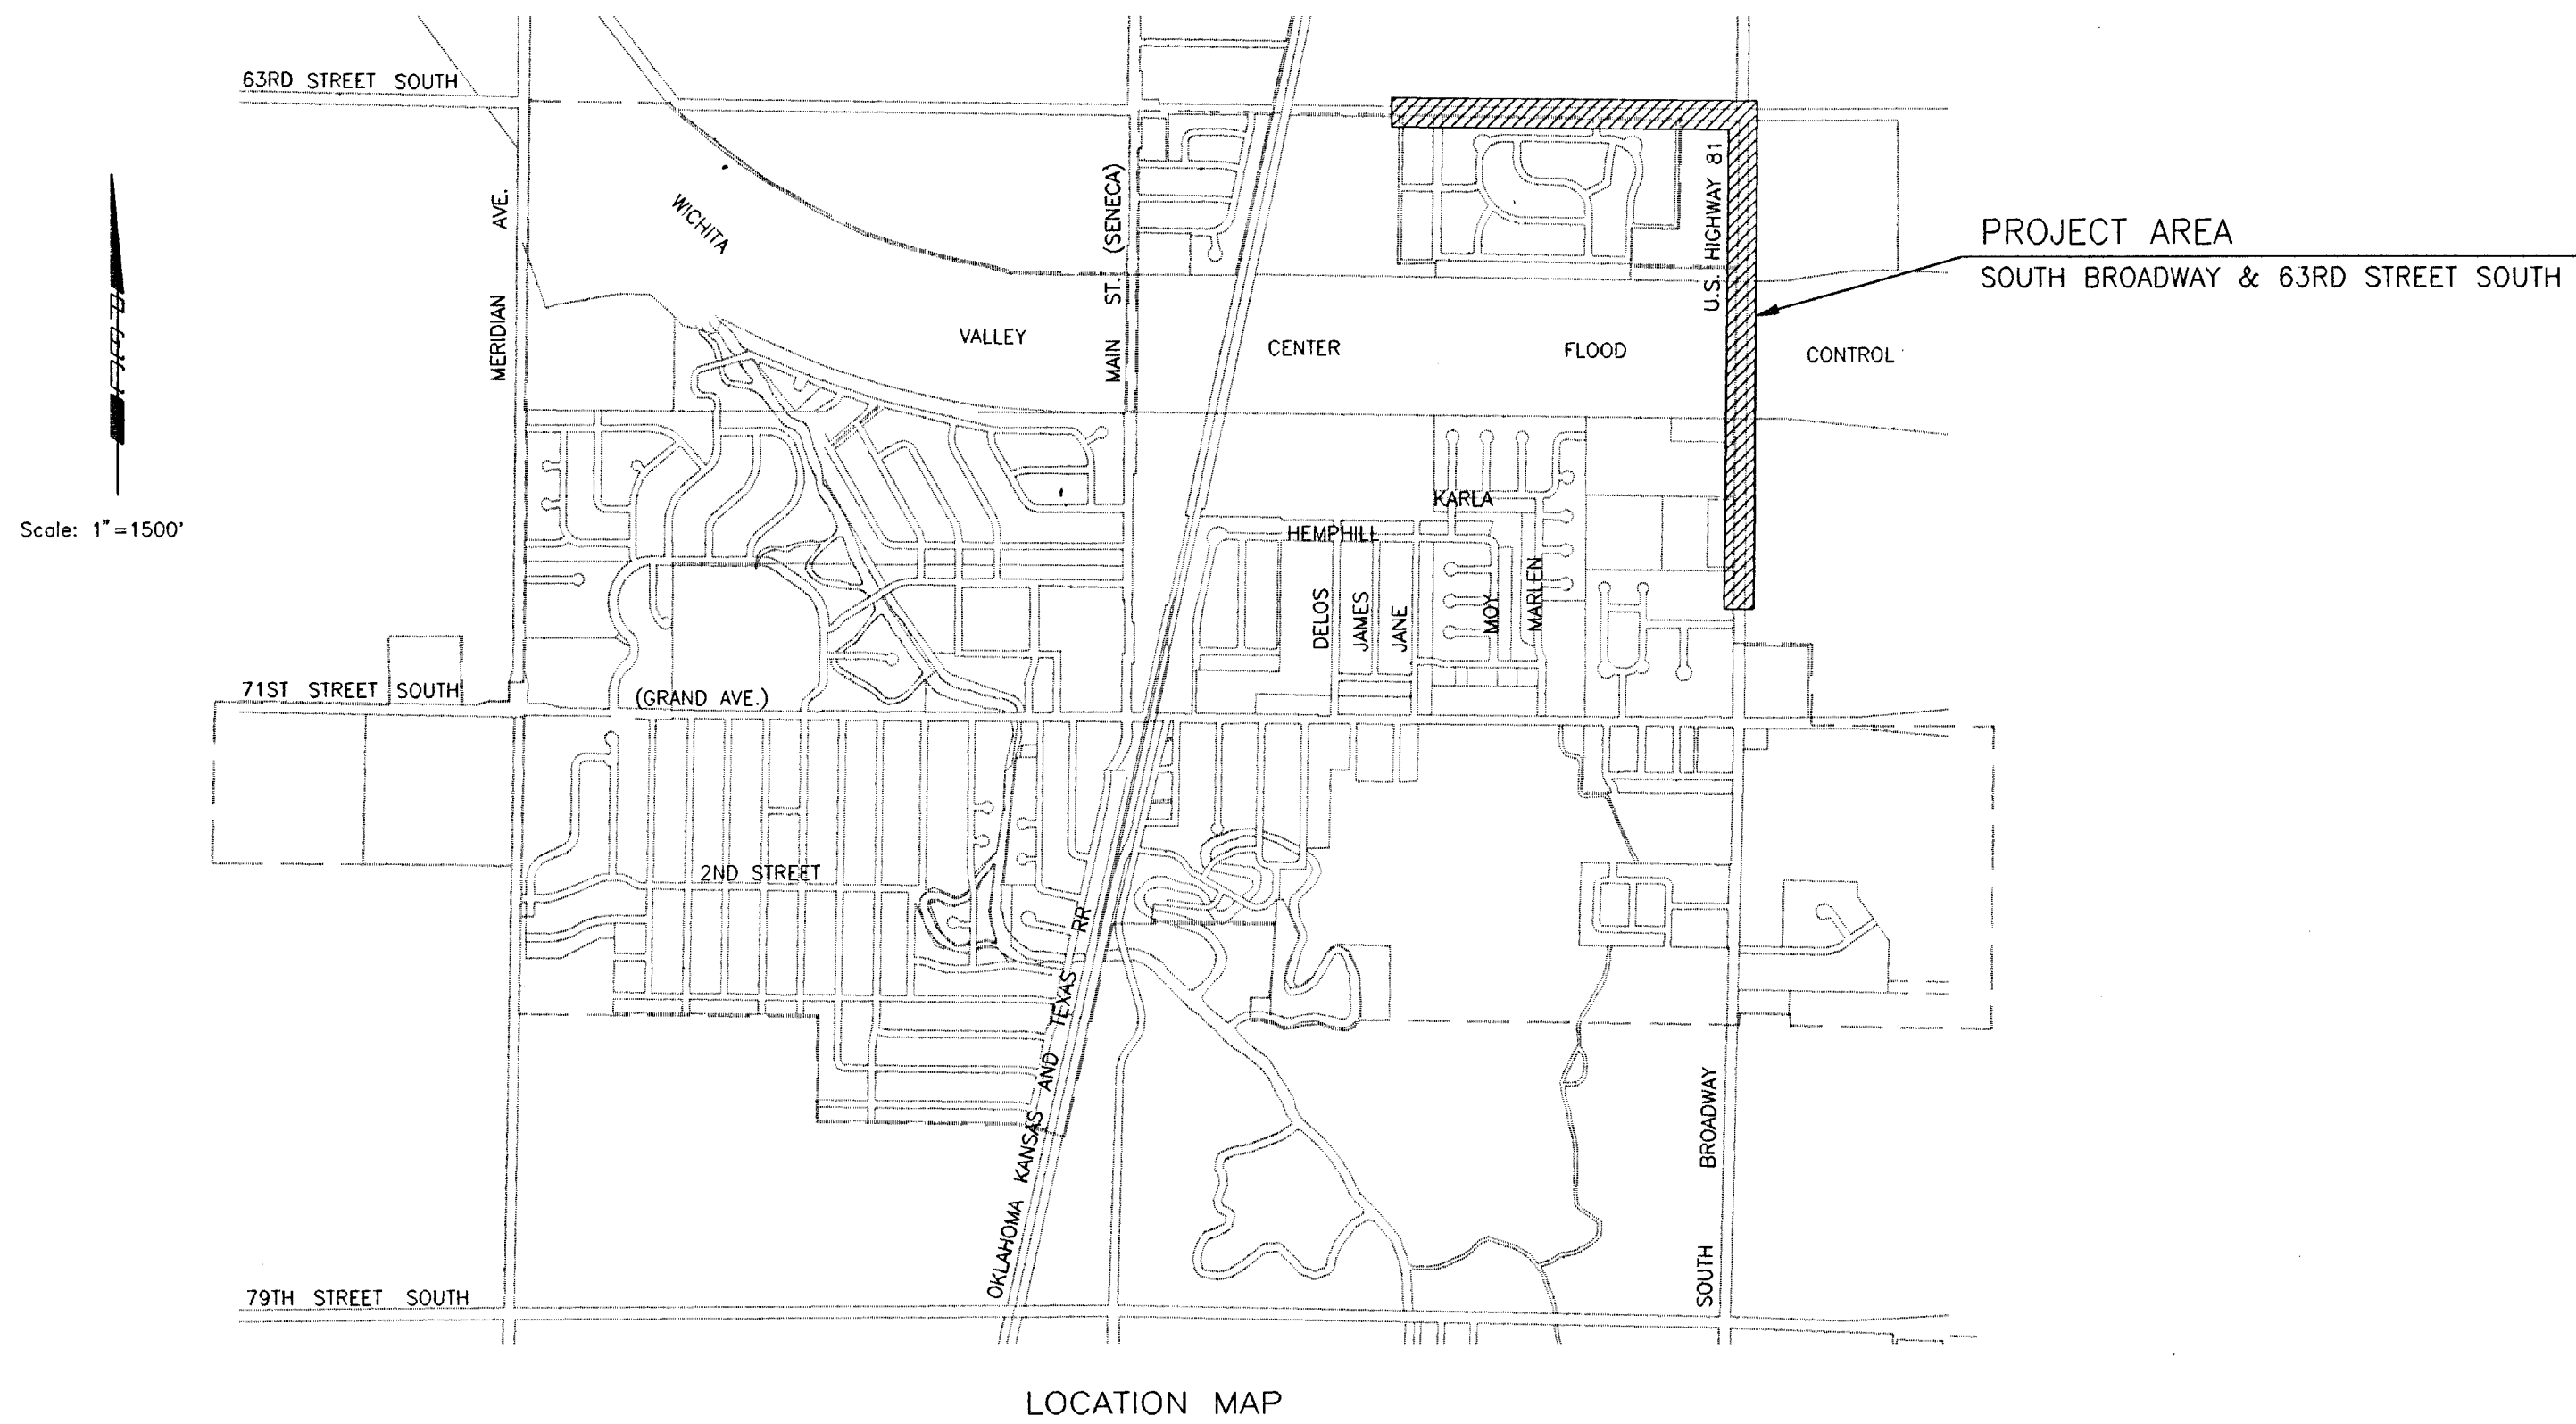

INDEX OF SHEETS	
SHEET NO. 1	TITLE SHEET
SHEET NO. 2	KEY MAP
SHEET NO. 3	MISCELLANEOUS DETAILS
SHEET NO. 4-13	WATERLINE PLAN/PROFILE
SHEET NO. 14-15	BRIDGE ATTACHMENT DETAILS

OCTOBER 1995

PLANS PREPARED BY
PROFESSIONAL ENGINEERING CONSULTANTS, P.A.
ENGINEERS
WICHITA, KANSAS

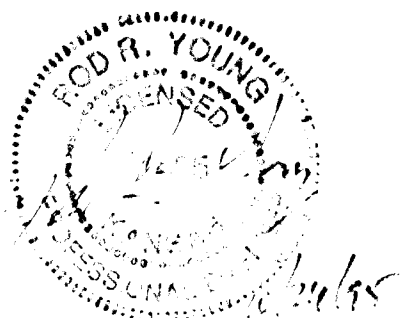

RECORD DRAWING
DATE 10/1/95