


DSUR: REF. OPER. JLM SCALE: 1"=40.00
C:\1995\95676\PP4.DWG 10-24-1995 9:16:56 am

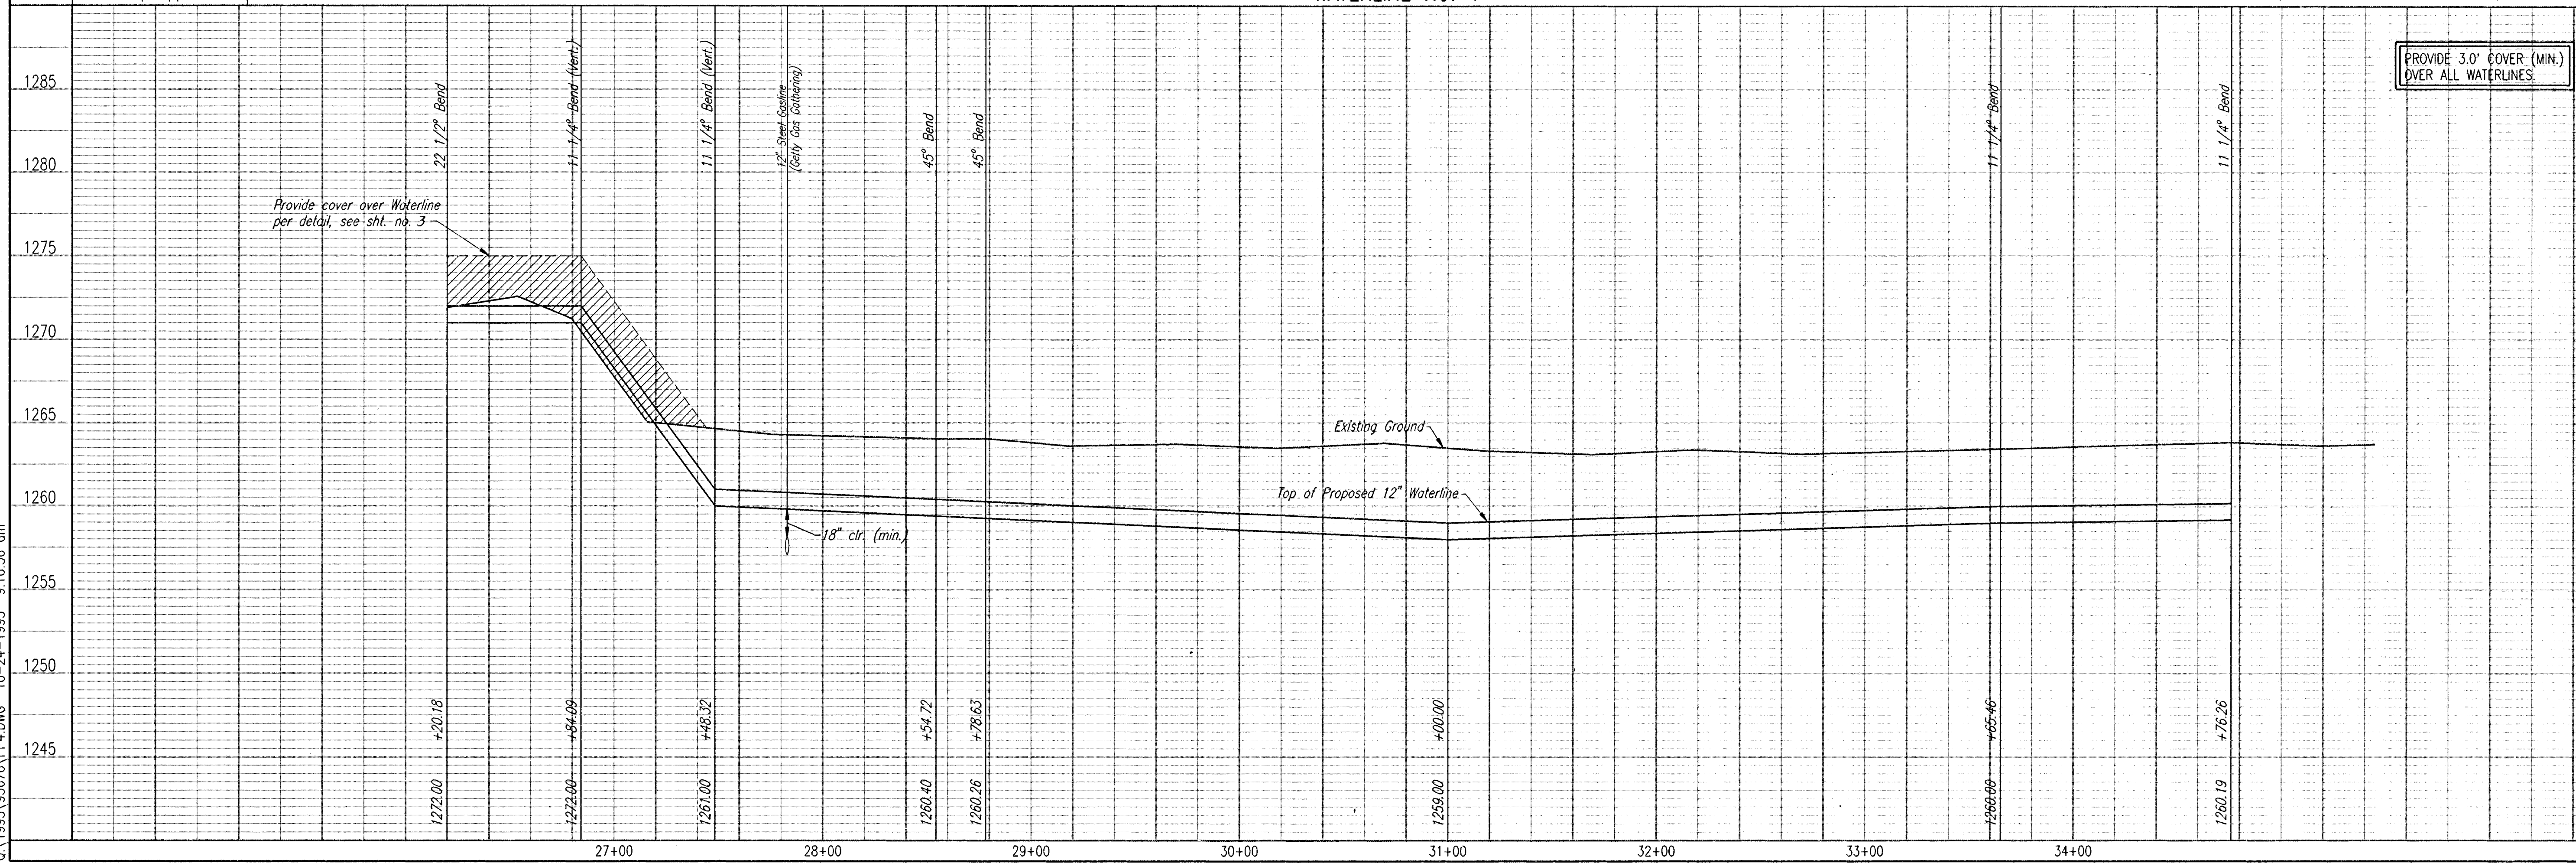

Unless noted otherwise, elevations shown are top of pipe.


* PRIOR TO BEGINNING CONSTRUCTION, THE CONTRACTOR SHALL EXCAVATE THE UTILITIES TO VERIFY THEIR HORIZONTAL AND VERTICAL LOCATIONS. THE UTILITY LOCATION SHALL BE REPORTED TO THE ENGINEER SO THAT ANY NECESSARY PLAN MODIFICATIONS CAN BE MADE. ANY ADDITIONAL LABOR OR MATERIALS NECESSARY TO COMPLETE THE CONNECTIONS SHALL BE CONSIDERED SUBSIDIARY TO THE PROJECT.

WATERLINE NO. 1

ALL PIPE AND FITTINGS SHALL BE D.I.R.J. FROM WL STA. 17+41.72 TO WL STA. 27+68.32 PER THE SPECIFICATIONS.

RECORD DRAWING

DATE 1/11/97
DES. CWS.

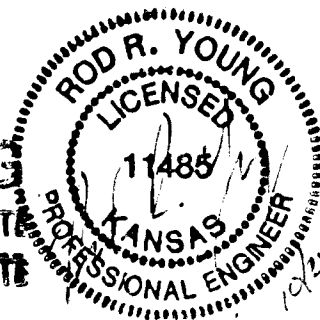

CITY OF HAYSVILLE
SEDGWICK COUNTY, KANSAS
WATERLINE NO. 1
HAYSVILLE EMERGENCY WATERLINE
WATERLINE IMPROVEMENTS

PROFESSIONAL ENGINEERING CONSULTANTS, P.A.
ENGINEERS
WICHITA, KANSAS
Job No. 34-95676
Date October 1995
Designed By MDS, MDK
Drawn By JLM

Sheet 7 of 15