
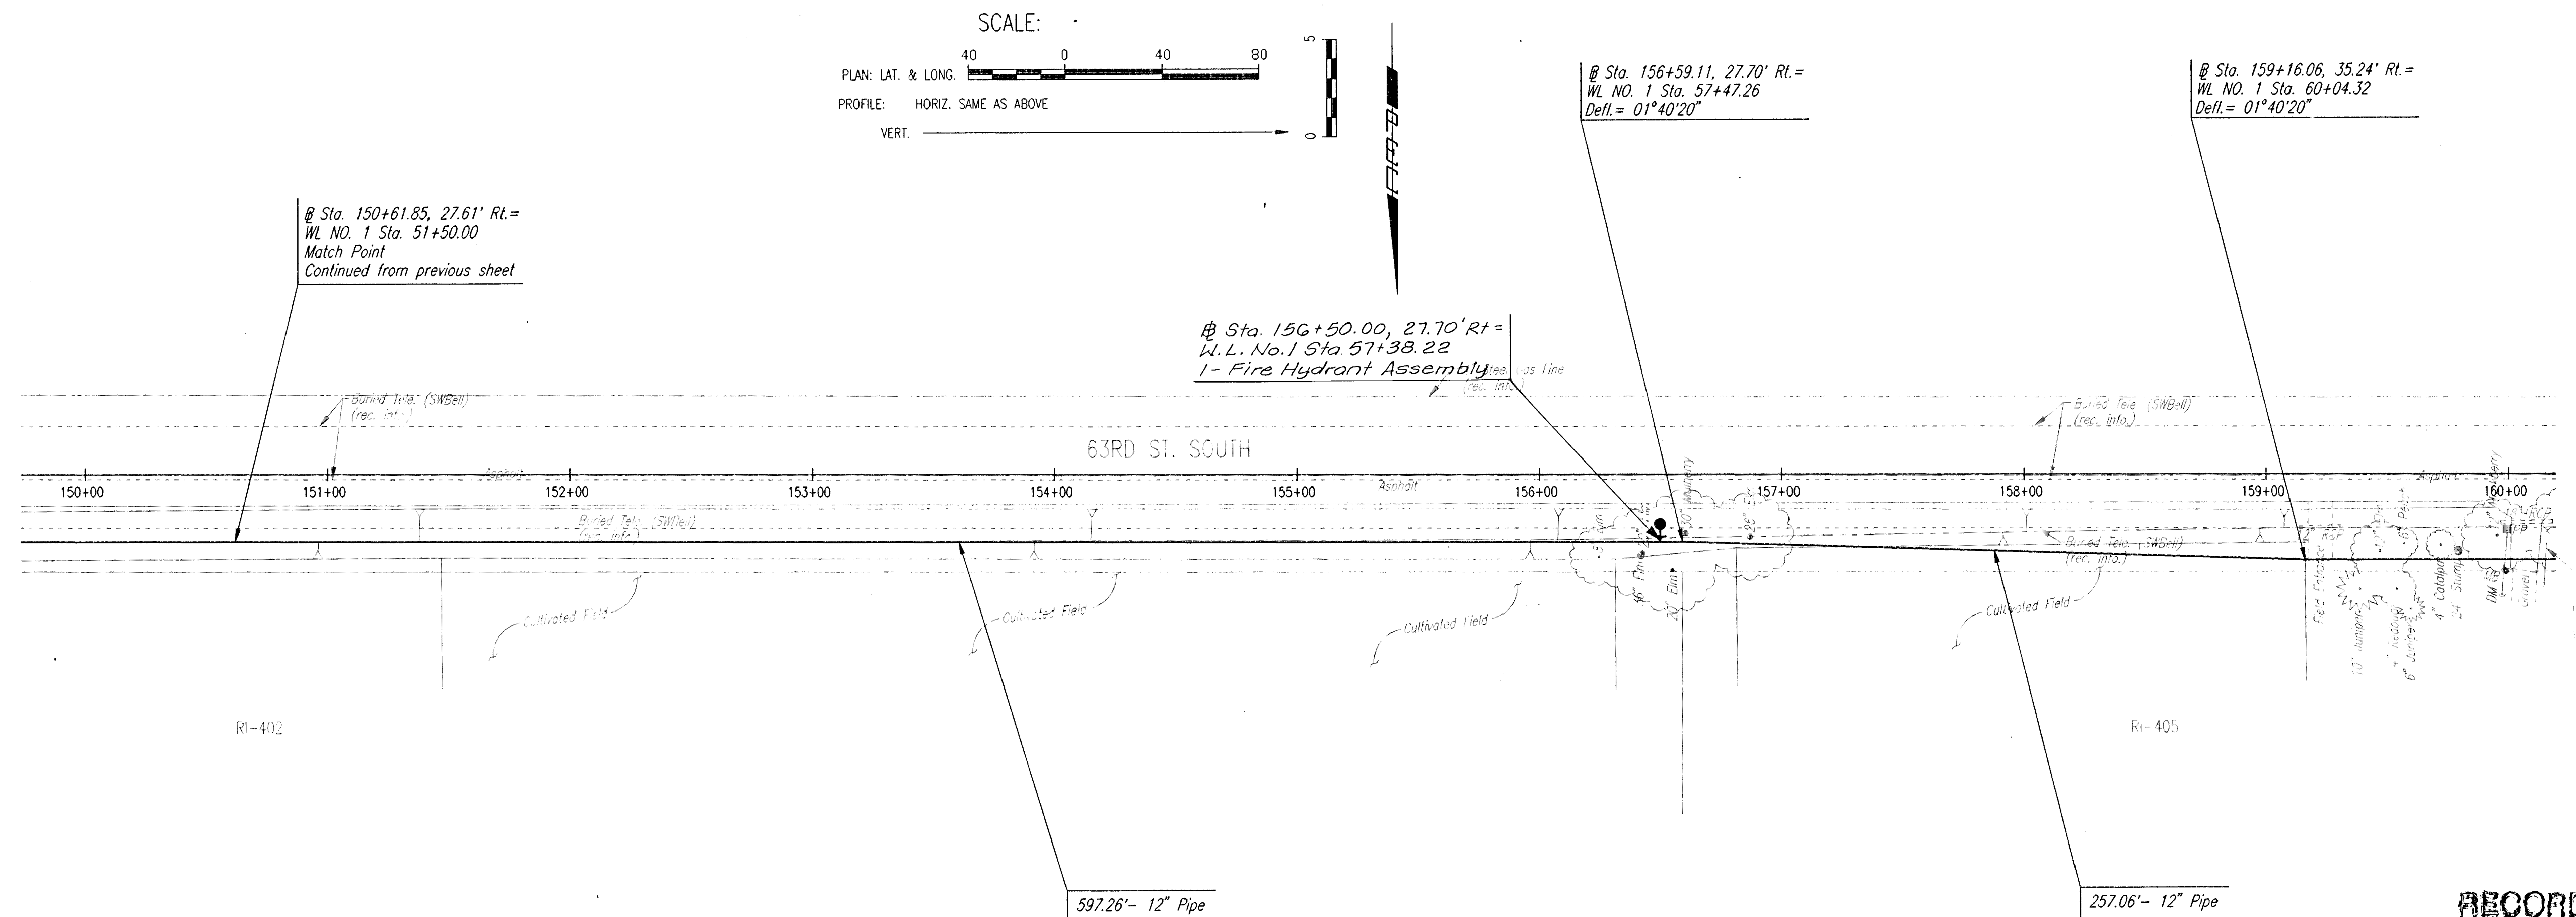


DSNR: REF. OPER. JLM SCALE: 1"=40.00
Q:\1995\95676\PP7.DWG 10-24-1995 9:21:51 am

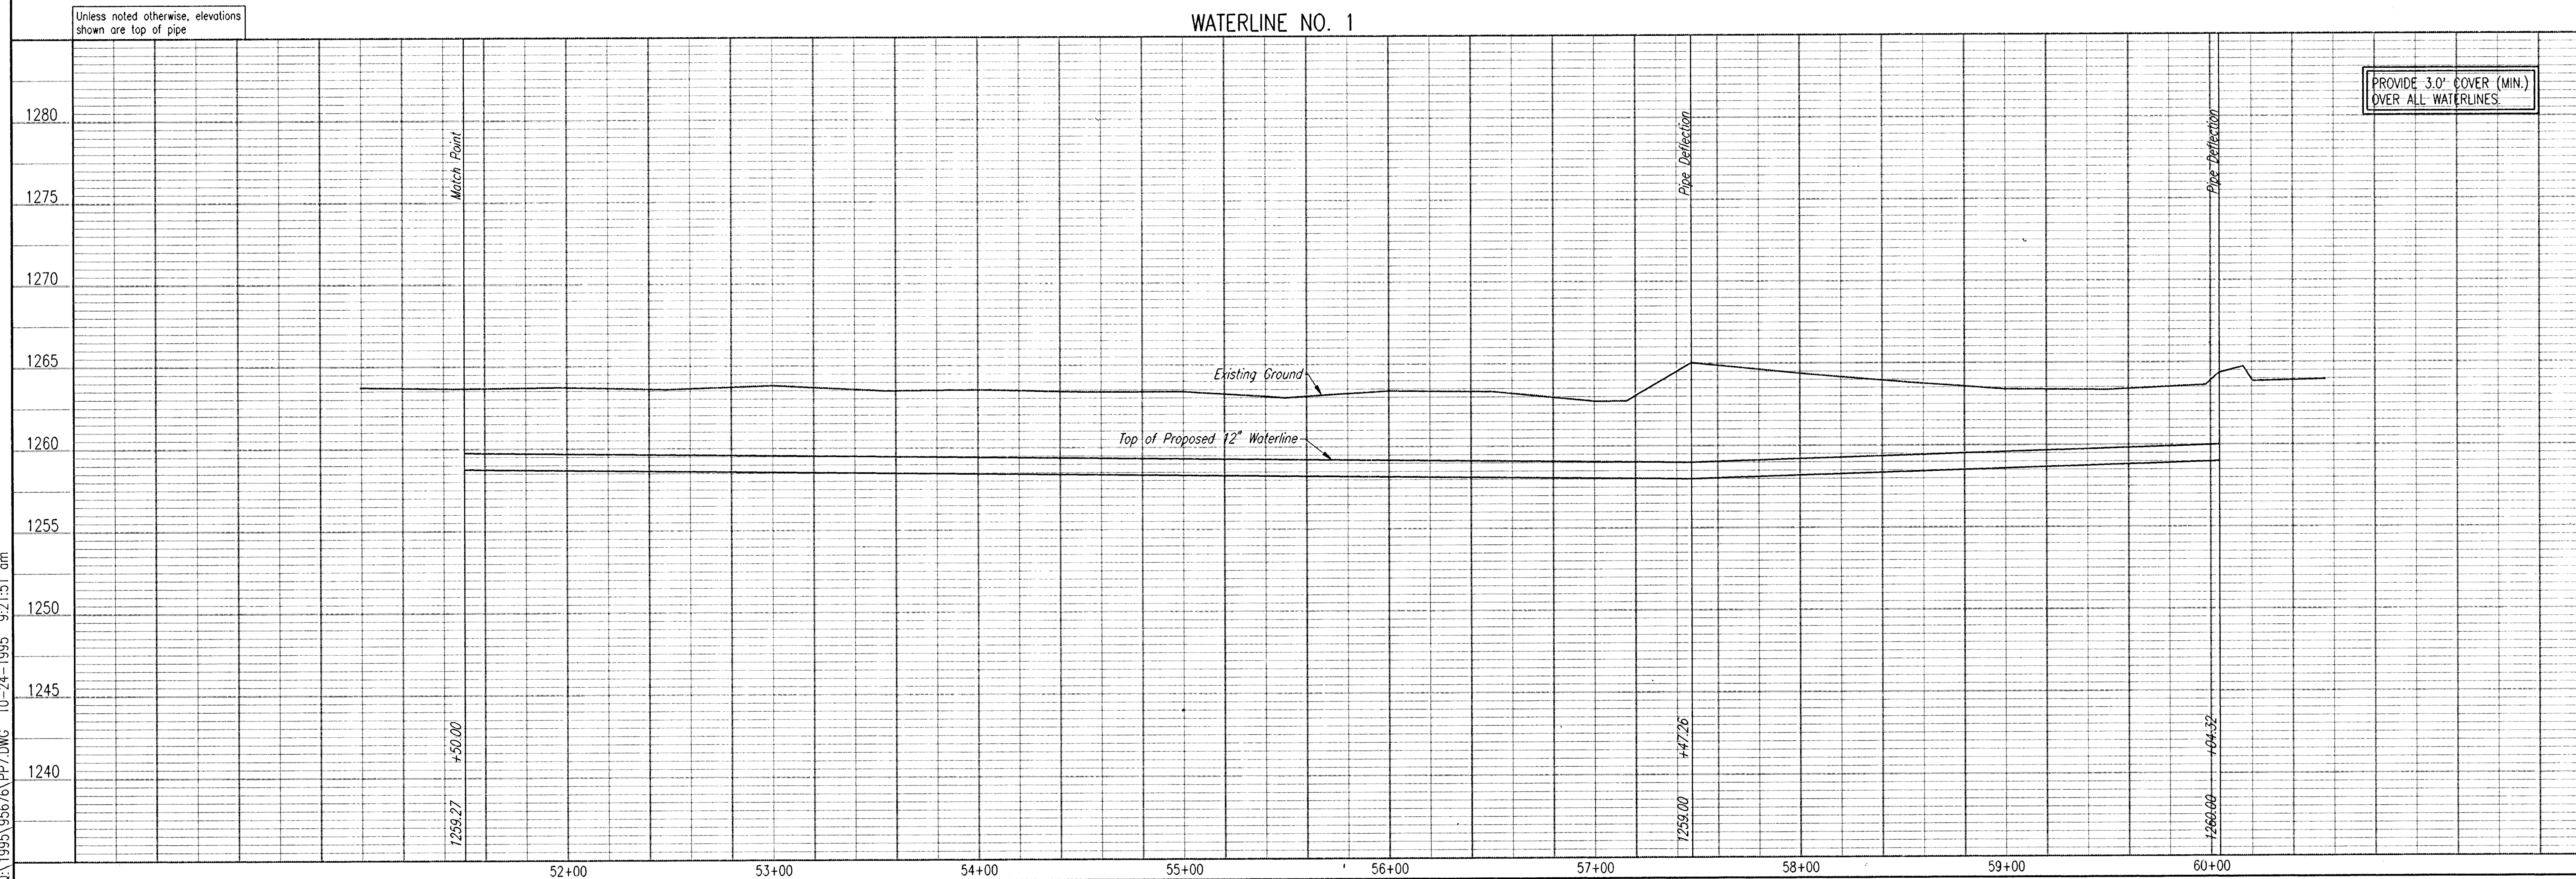


RECORD DRAWING

DATE 10/24/95

DES. ENG. JLM

DATE 10/24/95

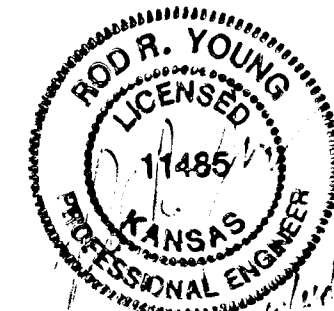

CITY OF HAYSVILLE
SEDGWICK COUNTY, KANSAS

WATERLINE NO. 1

HAYSVILLE EMERGENCY WATERLINE
WATERLINE IMPROVEMENTS

PROFESSIONAL ENGINEERING CONSULTANTS, P.A.
ENGINEERS
WICHITA, KANSAS

Job No. 34-95676
Date October 1995

Designed By MDS, MDK
Drawn By JLM

Sheet 10 of 15