



* PRIOR TO BEGINNING CONSTRUCTION, THE CONTRACTOR SHALL EXCAVATE THE UTILITIES TO VERIFY THEIR HORIZONTAL AND VERTICAL LOCATIONS. THE UTILITY LOCATION SHALL BE REPORTED TO THE ENGINEER SO THAT ANY NECESSARY PLAN MODIFICATIONS CAN BE MADE. ANY ADDITIONAL LABOR OR MATERIALS NECESSARY TO COMPLETE THE CONNECTIONS SHALL BE CONSIDERED SUBSIDIARY TO THE PROJECT.

RECORD DRAWING
DATE 10/19/95
DESIGNED BY JLM
CHECKED BY MDS

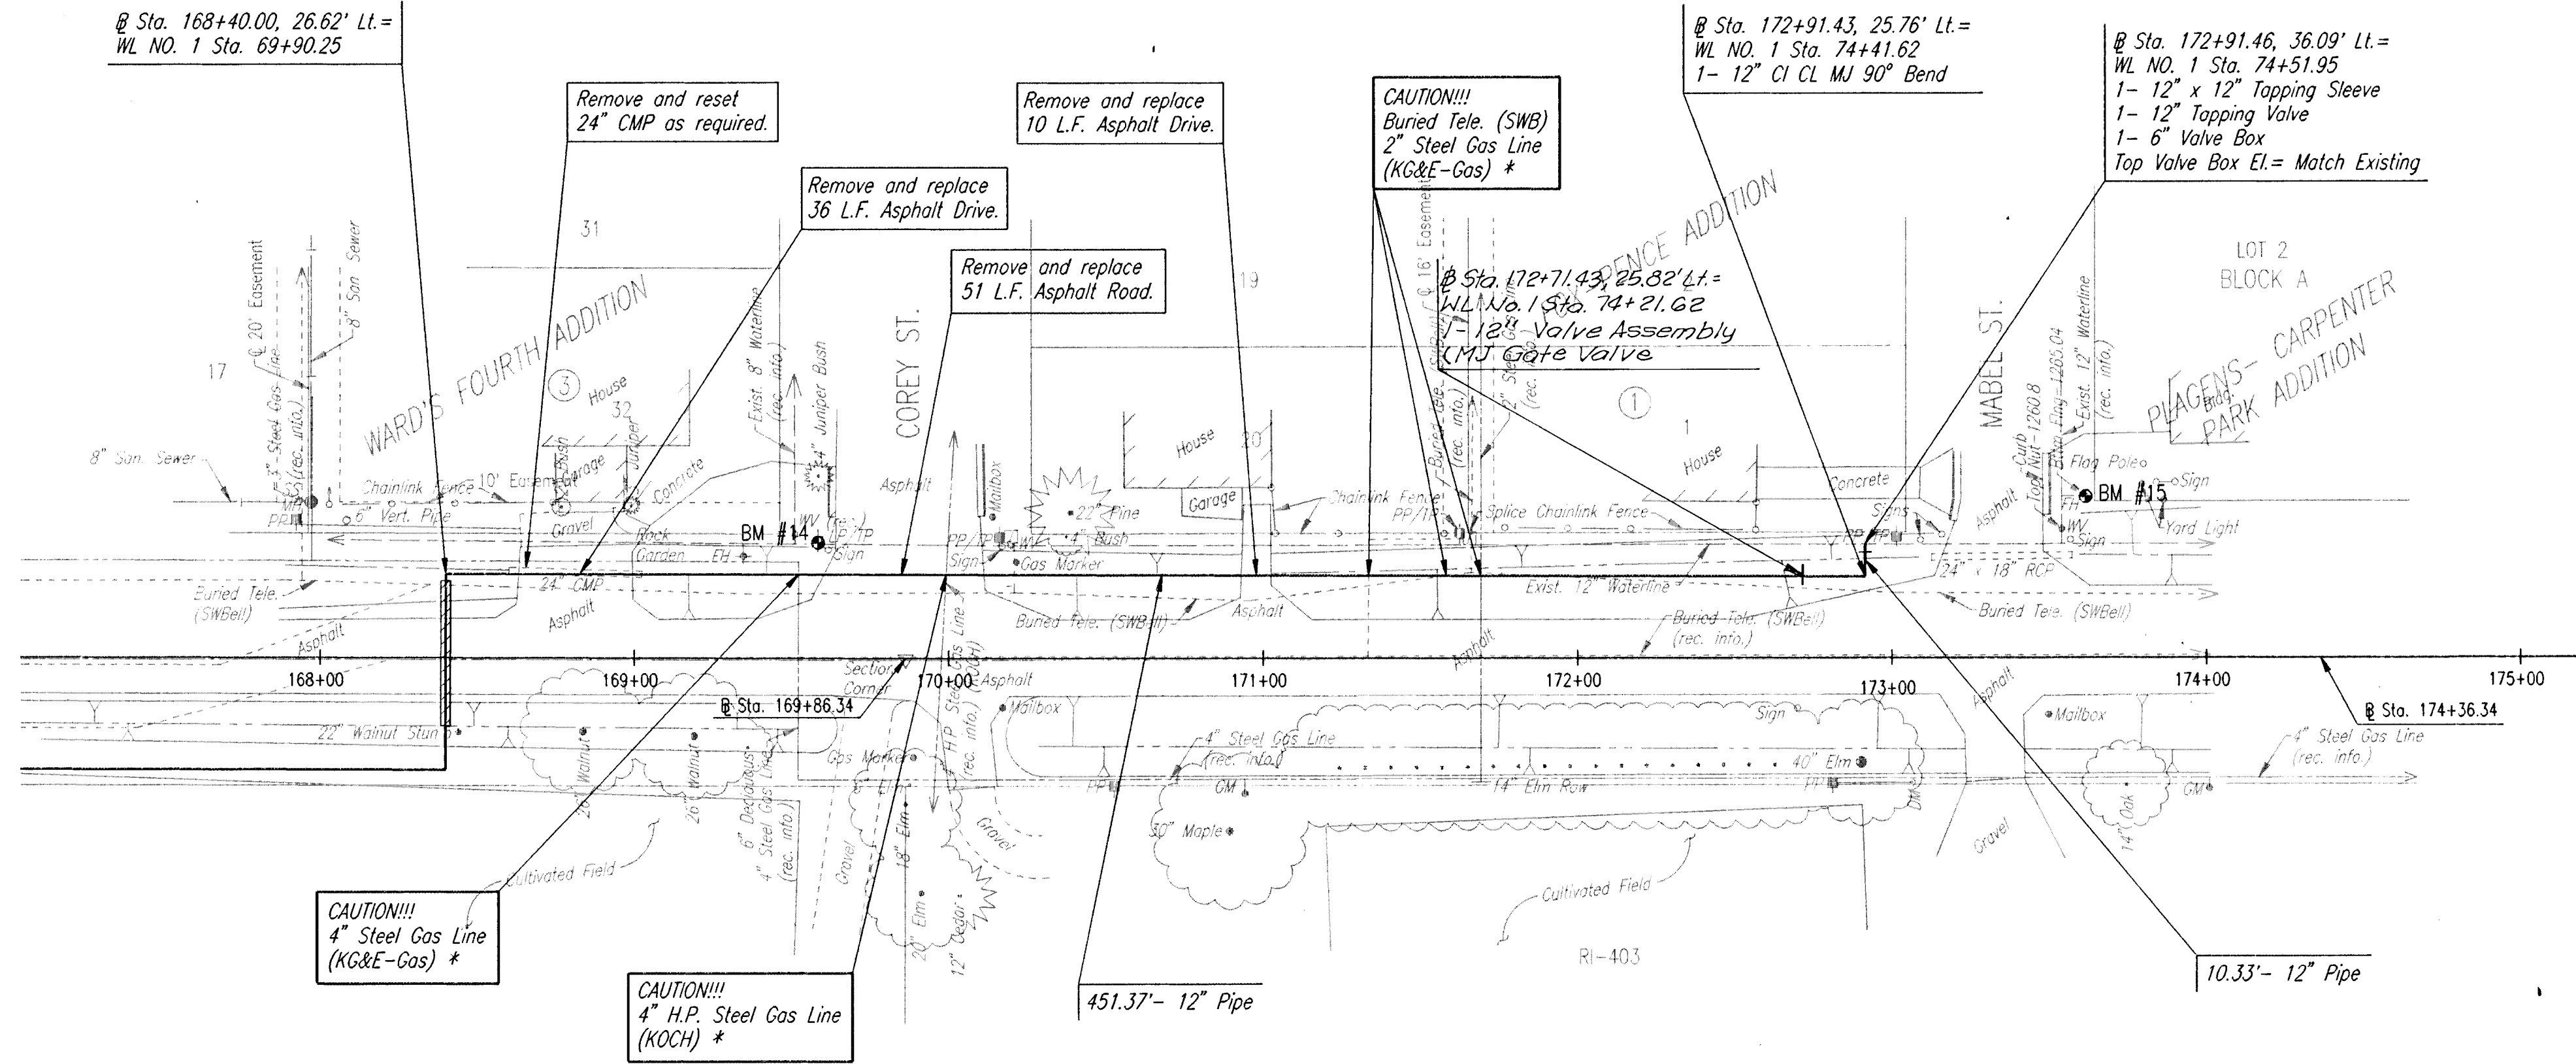

DSNR: REF. OPER. JLM SCALE: 1"=40.00'
0\ 1995\95676\PP9.DWG 10-24-1995 9:25:46 am

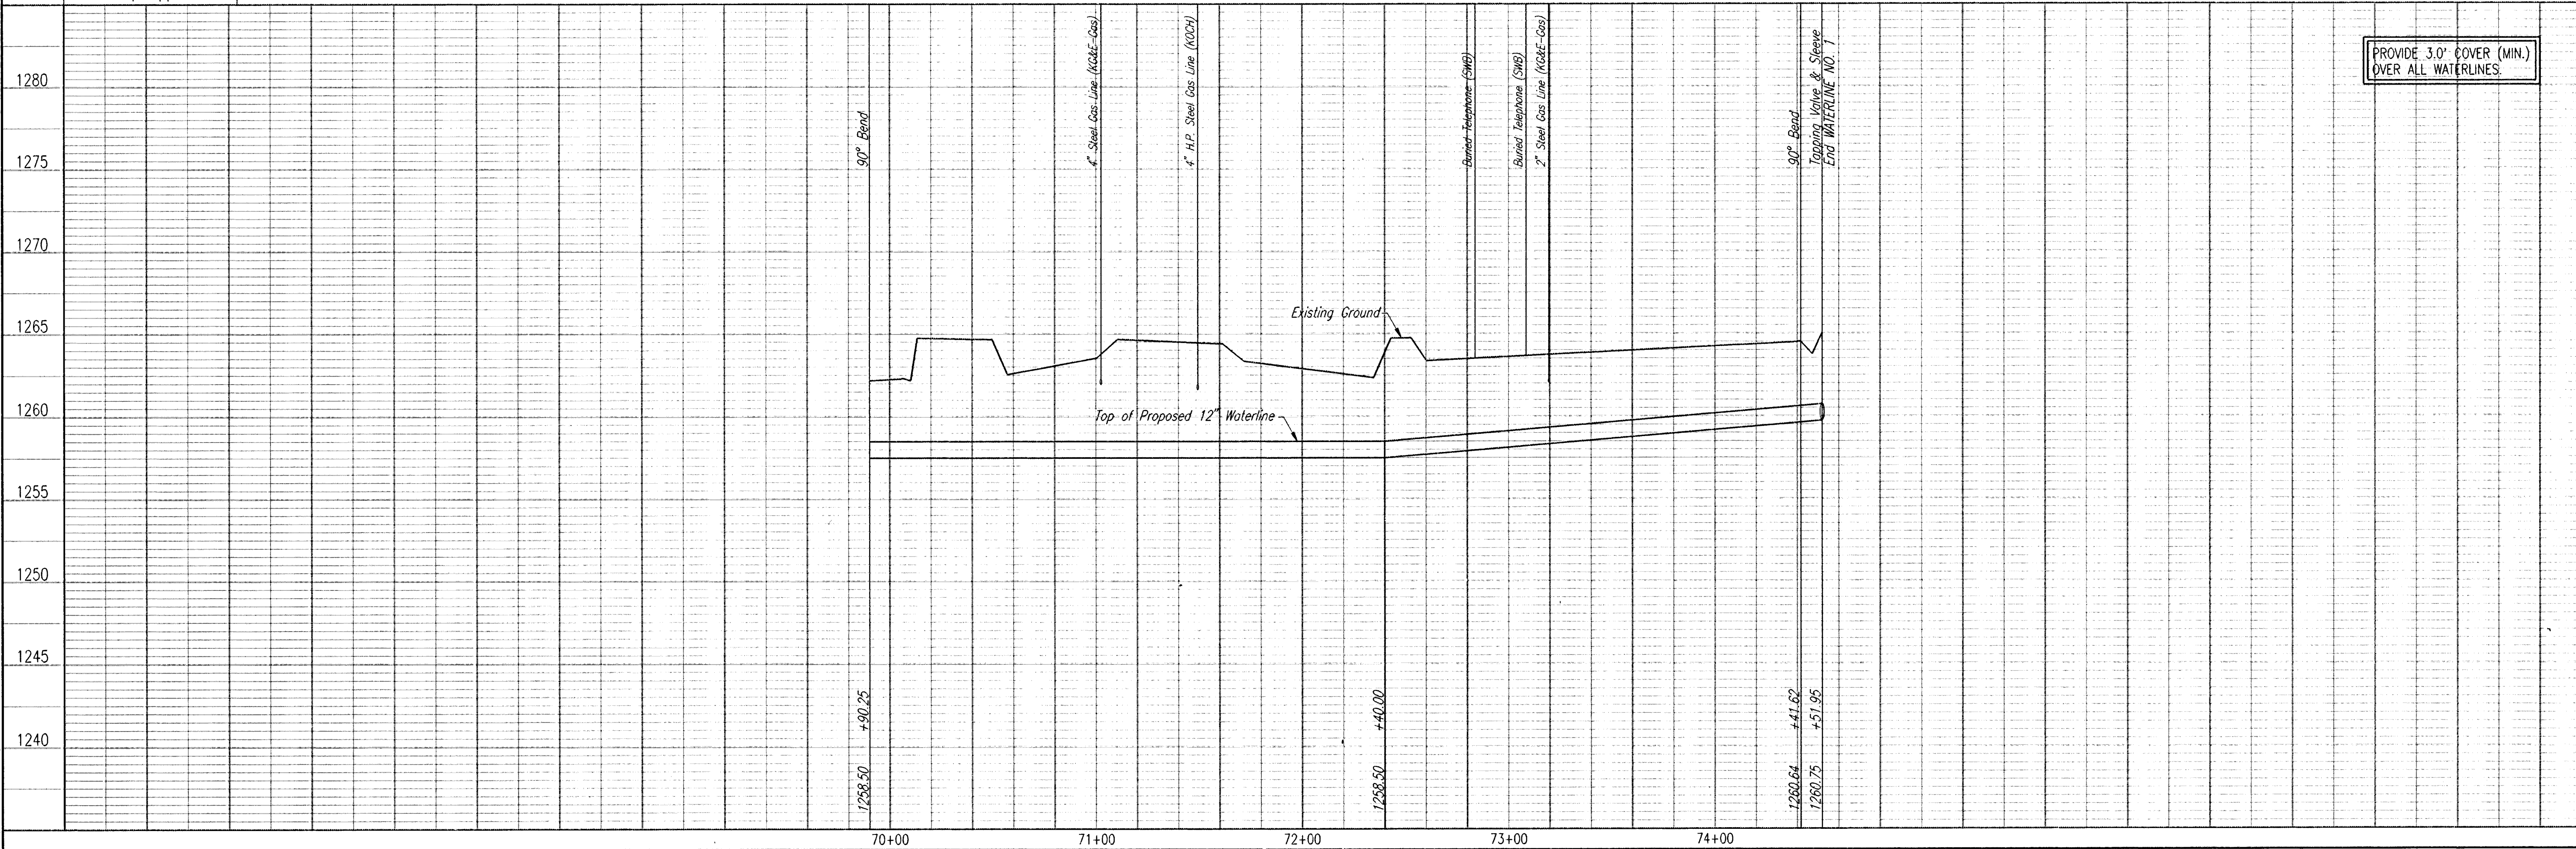

PROVIDE 3.0' COVER (MIN.)
OVER ALL WATERLINES.

CITY OF HAYSVILLE
SEDGWICK COUNTY, KANSAS
WATERLINE NO. 1
HAYSVILLE EMERGENCY WATERLINE
WATERLINE IMPROVEMENTS

PROFESSIONAL ENGINEERING CONSULTANTS, P.A.
ENGINEERS
WICHITA, KANSAS
Job No. 34-55676
Date October 1995
Designed By MDS, MDK
Drawn By JLM