


RECORD DRAWING
WORK. PROJ. NO. 114197 DATE
DES. NO. DATE

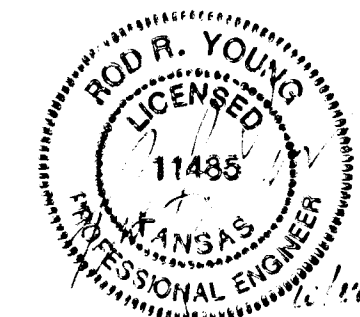

Sheet 13 of 15	 PROFESSIONAL ENGINEERING CONSULTANTS, P.A. ENGINEERS WICHITA, KANSAS	Designed By MDK Drawn By JLM Job No. 34-95676 Date October 1995
----------------	--	--