



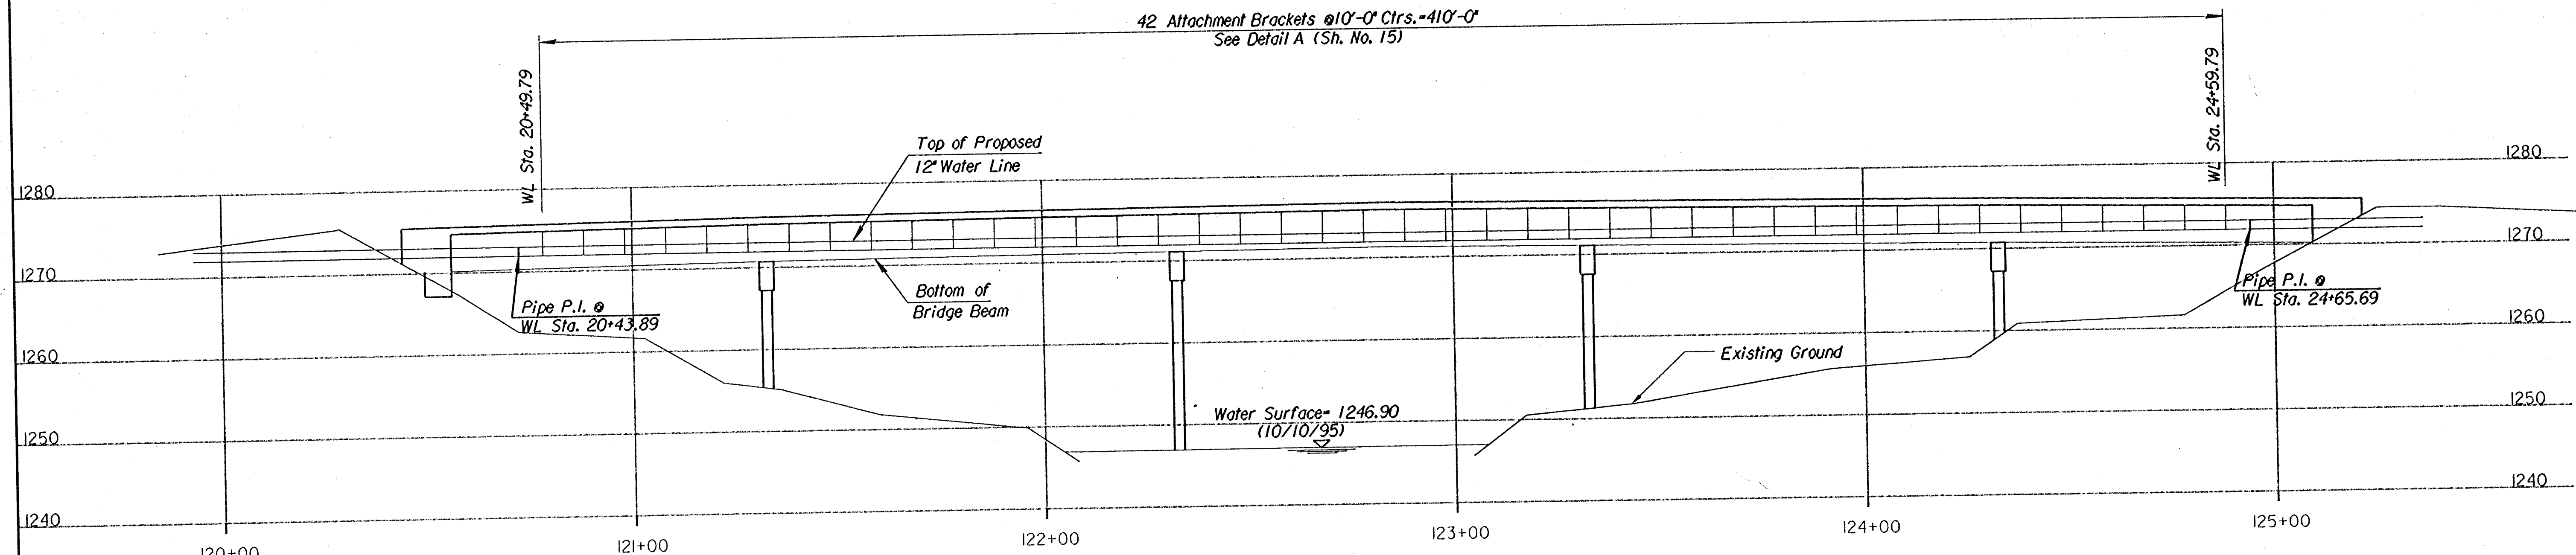


ELEVATION
(Bridge Rail not shown for clarity)

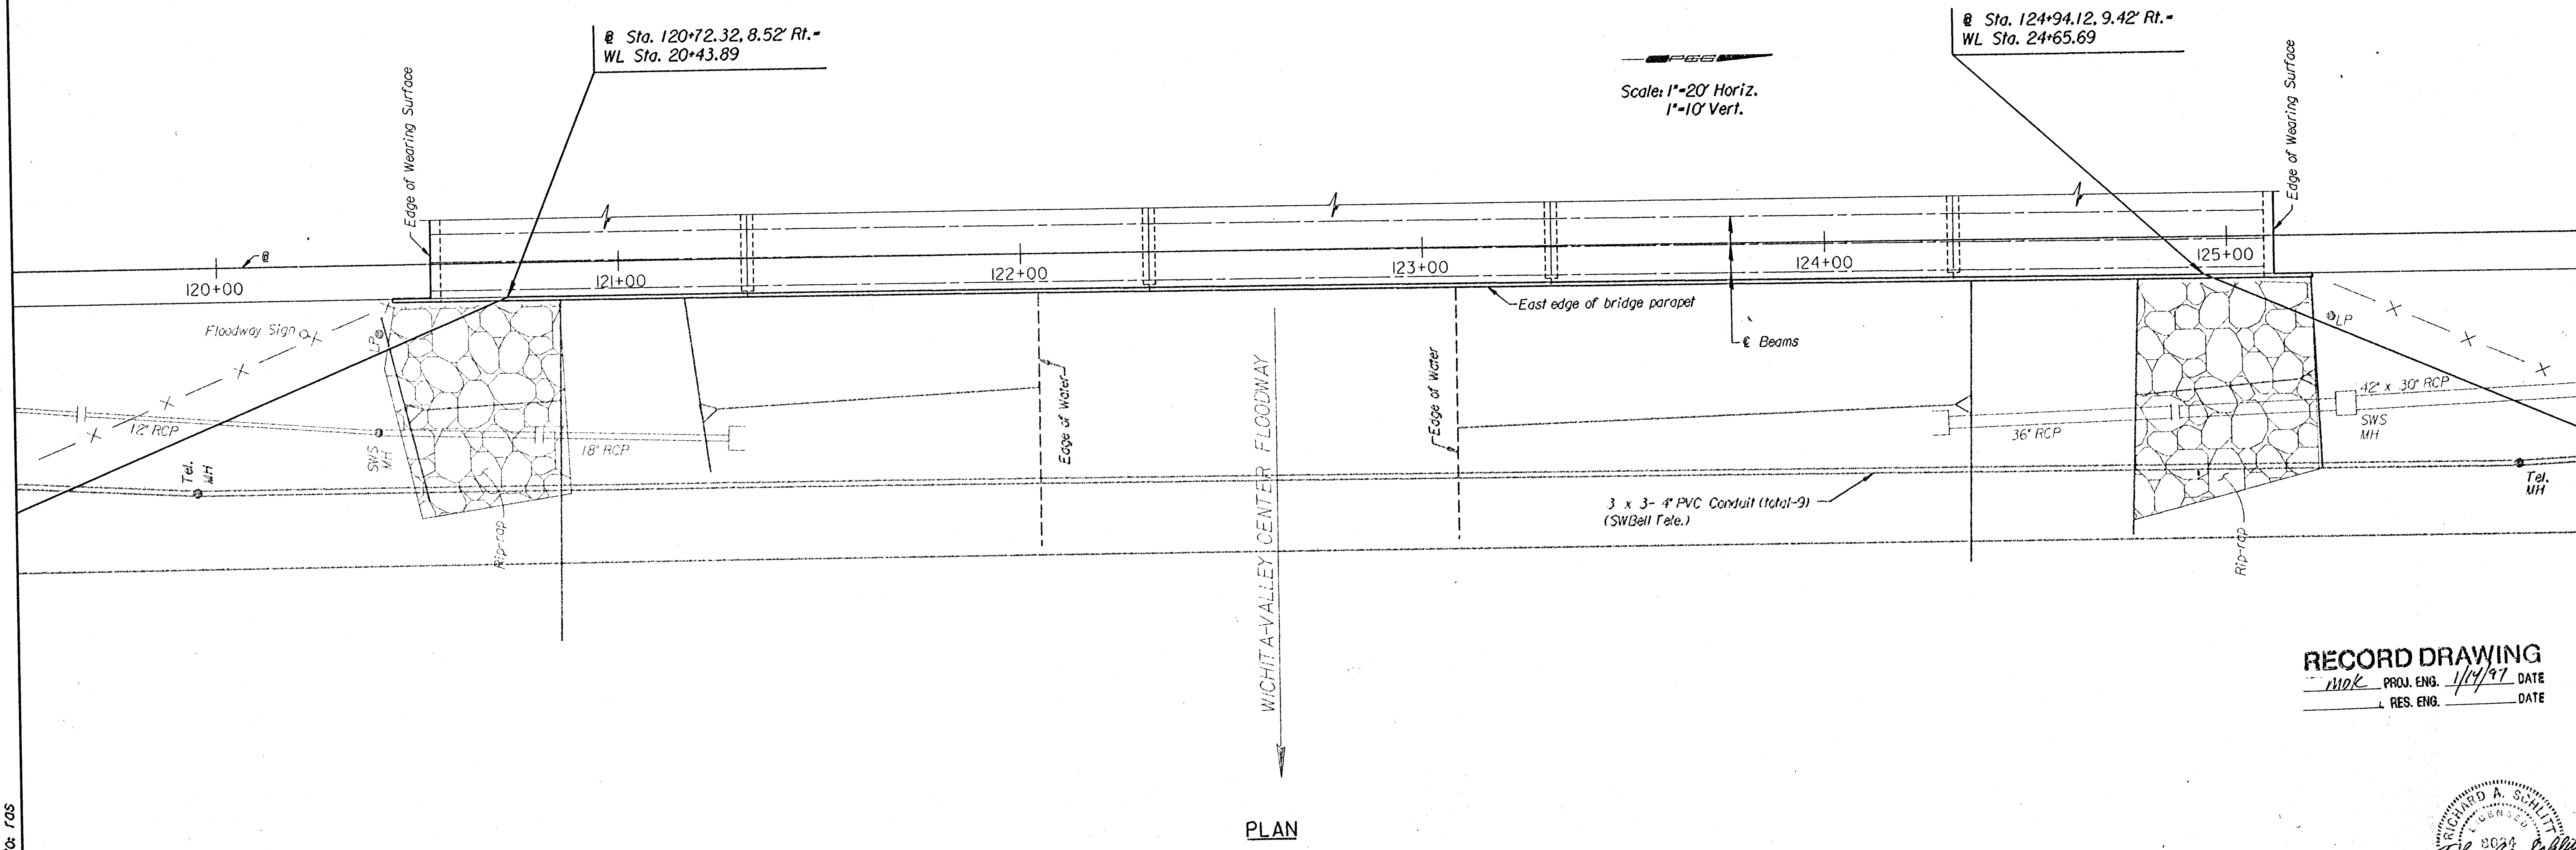

PLAN

RECORD DRAWING
 PROJ. ENG. 1/14/97 DATE
 RES. ENG. DATE

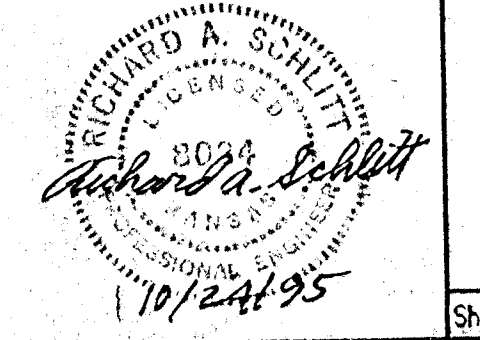

CITY OF HAYSVILLE SEDGWICK COUNTY, KANSAS	
CONSTRUCTION LAYOUT	
OVER WICHITA VALLEY CENTER FLOODWAY	
HAYSVILLE EMERGENCY WATERLINE	
WATERLINE IMPROVEMENTS	
Professional Engineer	CONSULTANTS P.A.
DESIGNED BY: RAS	DATE: 10/24/95
DRAWN BY: NAF	DATE: 10/24/95

i:/1995/95676/pbase.dgn
 drawn by: naf
 plotted by: ras
 10-23-95
 deliver to: ras