

**WICHITA COUNTRY CLUB
SECOND ADDITION
PARKING LOT EXPANSION PLANS**


**STORM WATER
PLAN/PROFILE
LINE 1**

SHEET TITLE
07038
PROJECT NUMBER


SRS
DESIGN BY
MKEC
DRAWN BY
MAB
CHECKED BY

ISSUED
Sept. 2007
REVISED

SHEET NO.
13 of 20

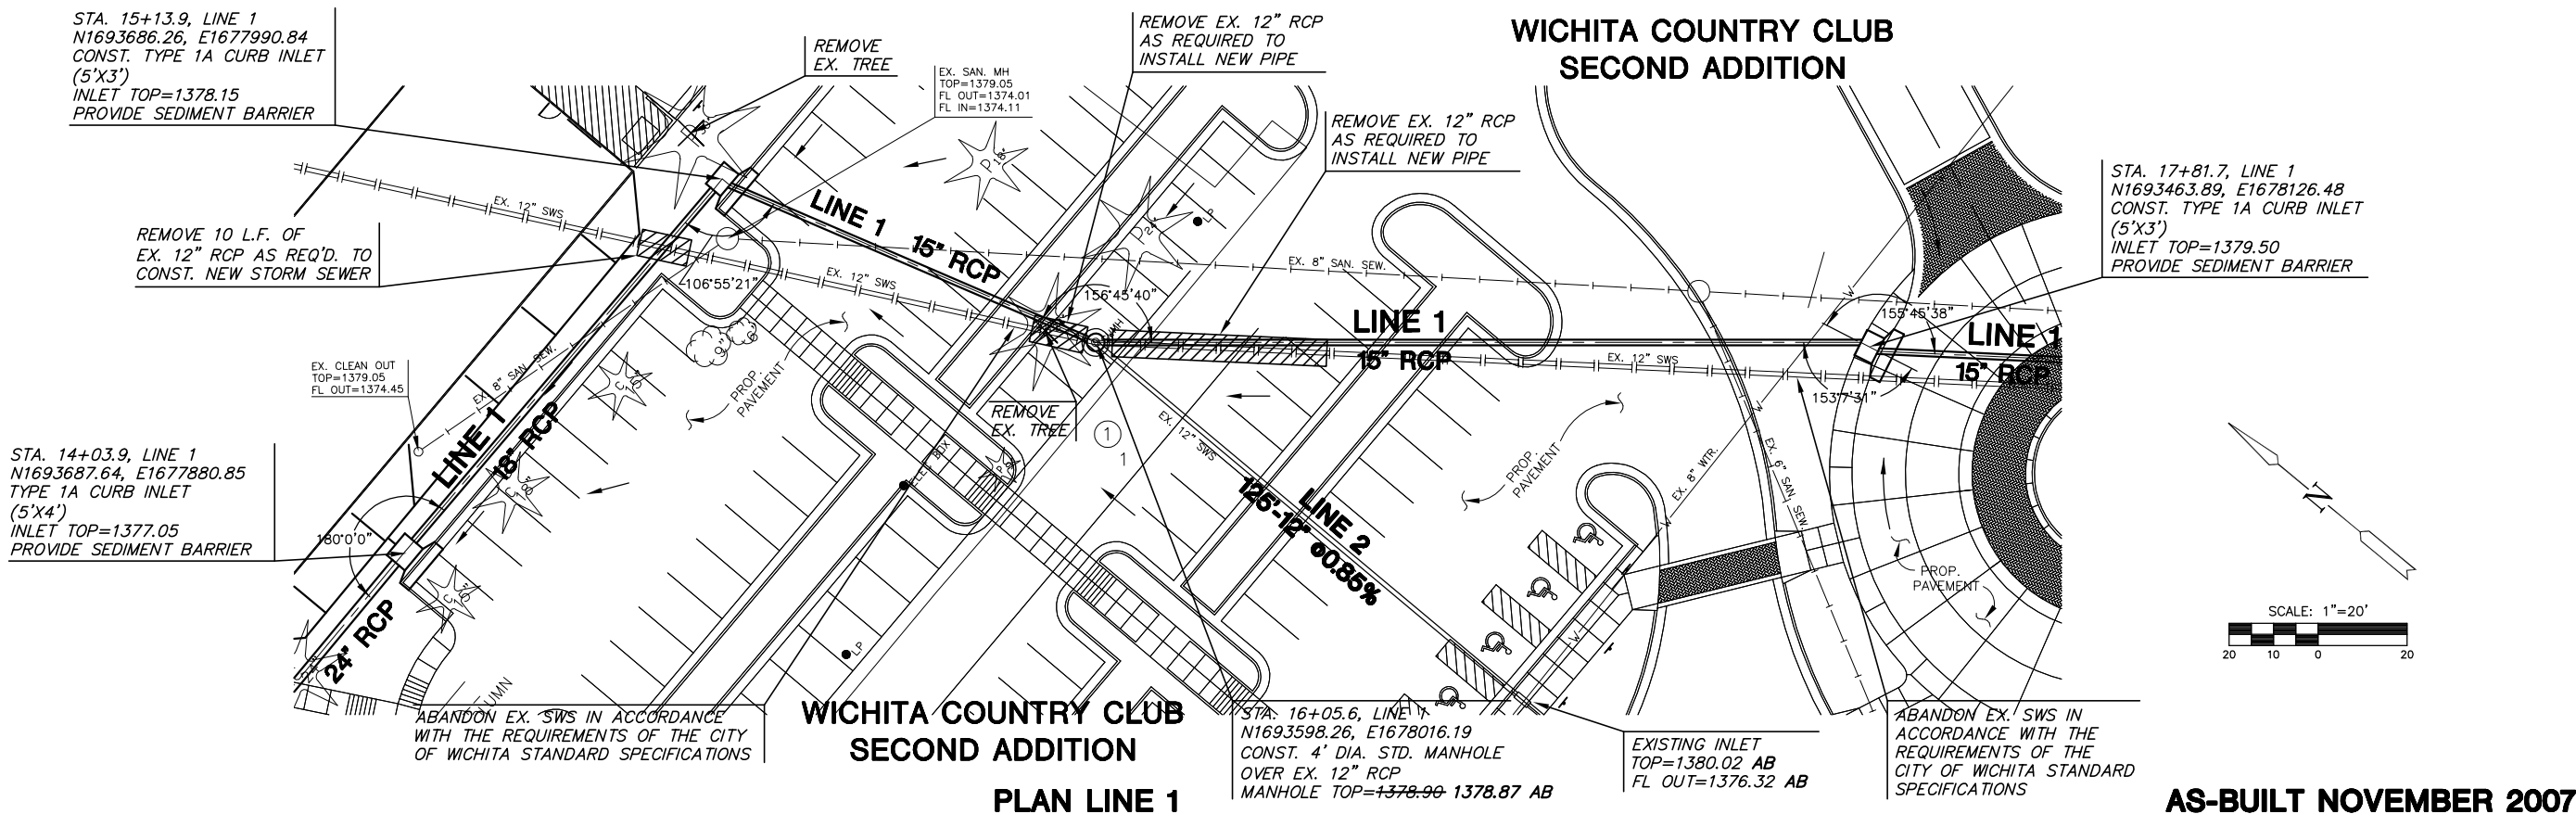

AS-BUILT NOVEMBER 2007

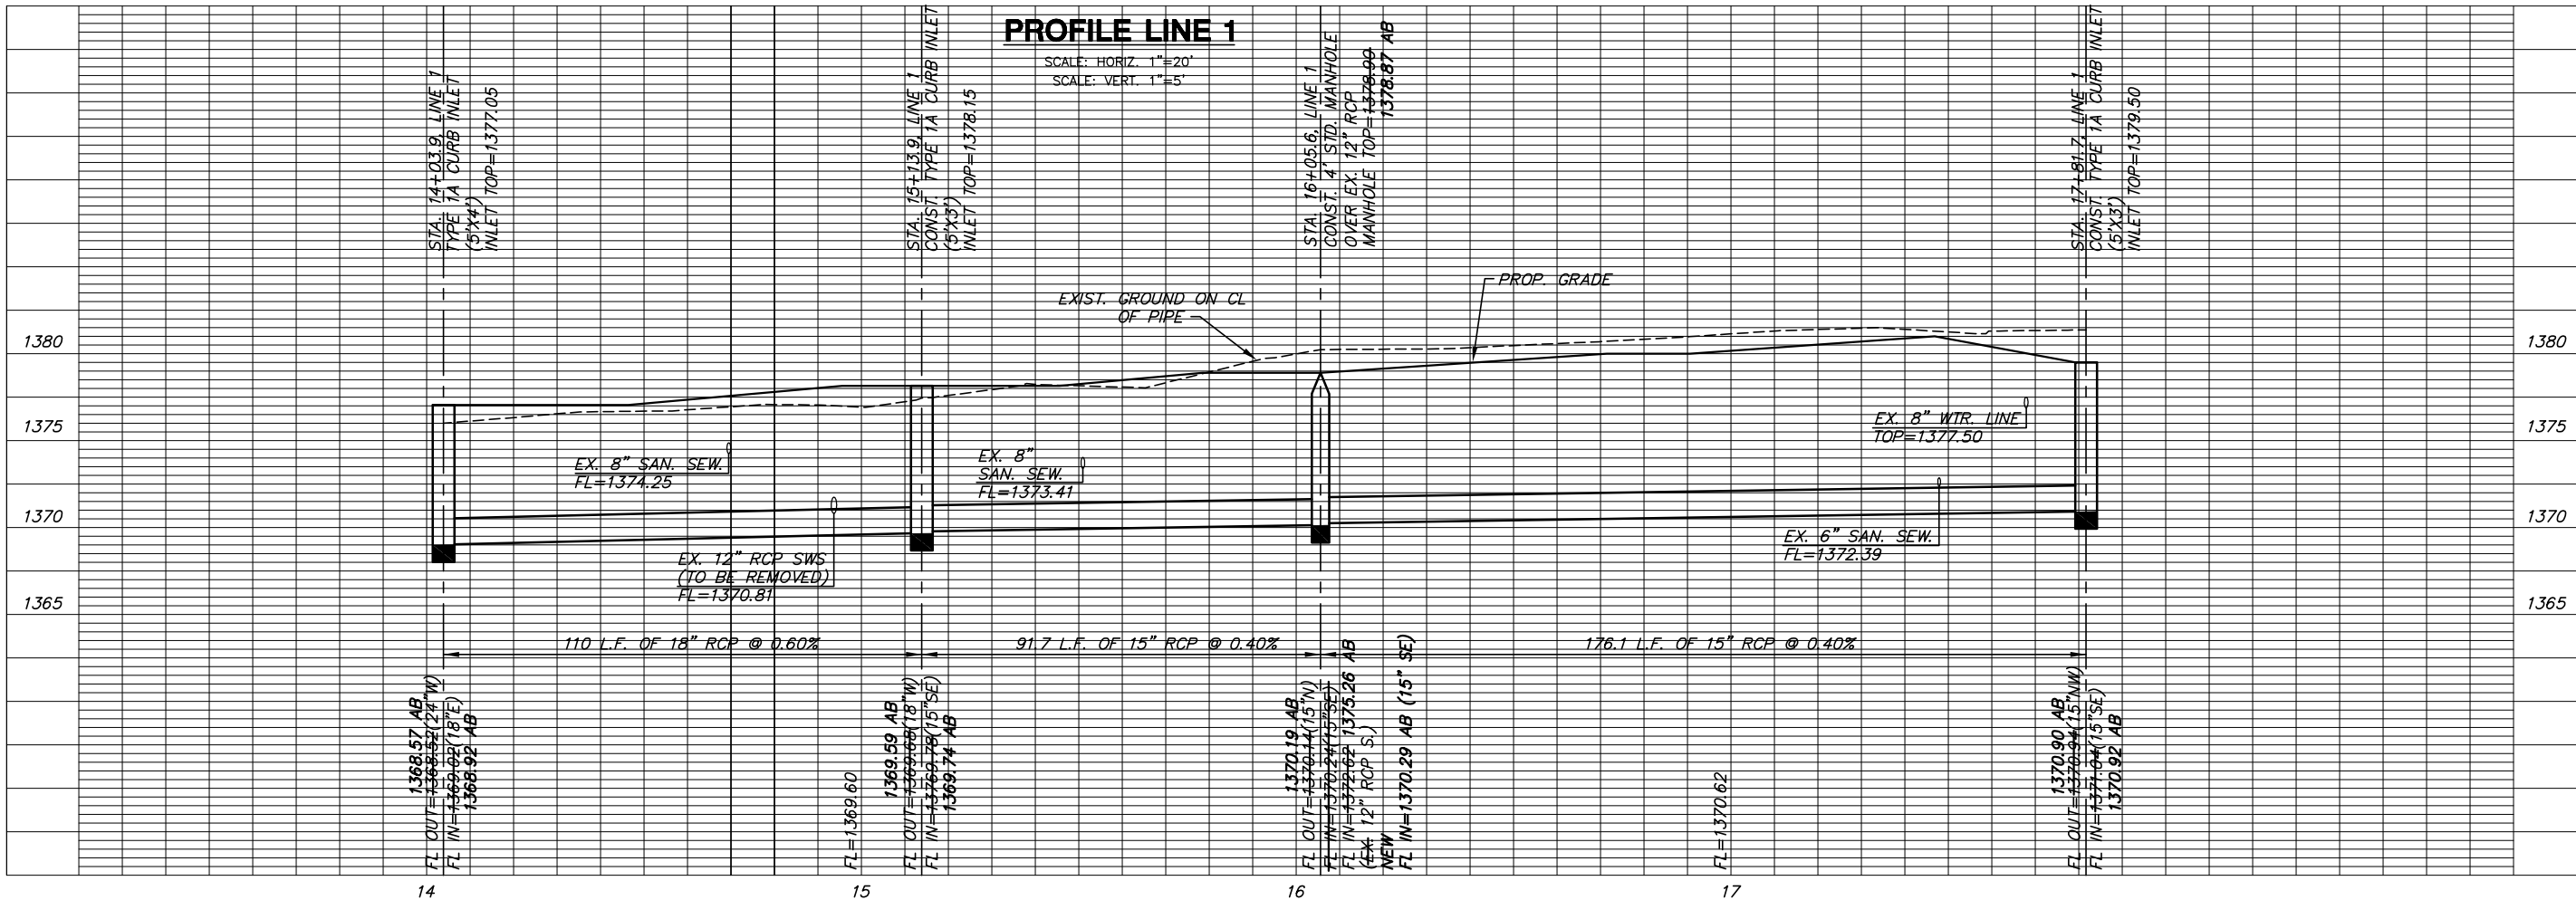

PLOTTED: Tuesday, November 20, 2007 @ 04:14PM

J:\CIVIL\07038.DWG SWS AS-BUILT\0703802.DWG