


SEWER SERVICE TABLE

NUMBER	TYPE	LOCATION			FOR INFORMATION ONLY		
		LOT NO.	BLOCK NO.	LINE NO.	STATION \ DIRECTION	APPROXIMATE LENGTH 4" PIPE VERTICAL	HORIZONTAL
1	8" X 4" Tee Saddle	33	1	1	10+30/R	31.07 21'	10'
2	8" X 4" Tee Saddle	32	1	1	11+25/R	26.12 21'	10' 12.25
3	8" X 4" Tee Saddle	31	1	1	12+18/R	13.35 22'	10' 14
4	8" X 4" Tee Saddle	30	1	1	13+08/R	06.07 22'	10' 12
5	4" MH Riser	29	1	1	13+70/R	10.0 21'	10' 9
6	8" X 4" Tee Saddle	28	1	1	14+85/R	8.3 20'	10' 13
7	8" X 4" Tee Saddle	27	1	1	15+75/R	7.3 20'	10' 12
8	8" X 4" Tee Saddle	26	1	1	16+85/R	10.2 19'	10' 13

NOTE: ALL BACKFILL FOR SHALL BE SAND FLUSHED AND VIBRATED.

NOTE: Vertical Riser Pipe shall be extended to 2' minimum above ground water elevation and 4' maximum below proposed ground elevation.

"AS-BUILT"
3-15-07
AML
12-3-07
AML

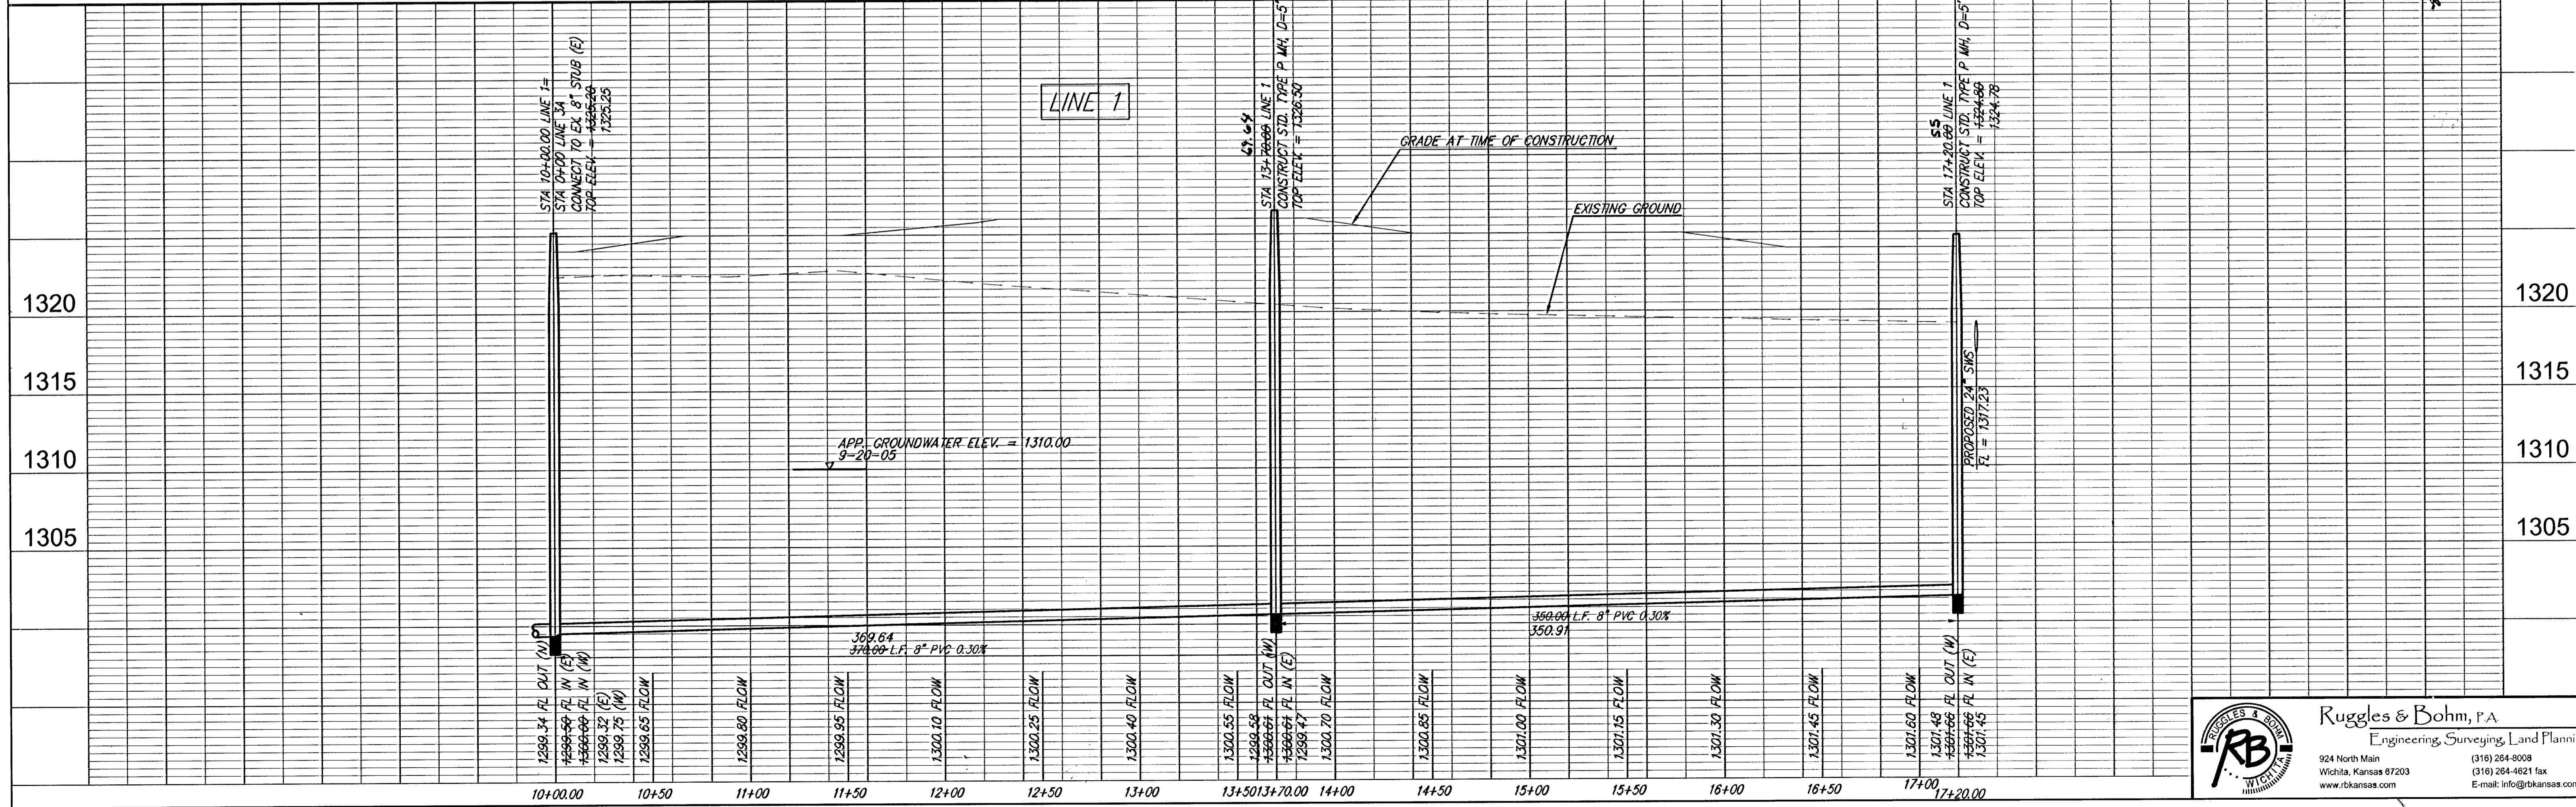

Ruggles & Bohm, P.A.
Engineering, Surveying, Land Planning
924 North Main
Wichita, Kansas 67203
www.rbkansas.com
(316) 264-8008
(316) 264-4621 fax
E-mail: info@rbkansas.com

PROJECT NUMBER: 468-84139
DRAWING FILE: Sanitary Sewer (LINE 1A)
DESIGN: AML
DRAWN: MLP
REVIEW: UTILITY
DATE: Jan. 5, 2006

RB JOB SHEET: 2822E
SHEET: 2 OF 17