
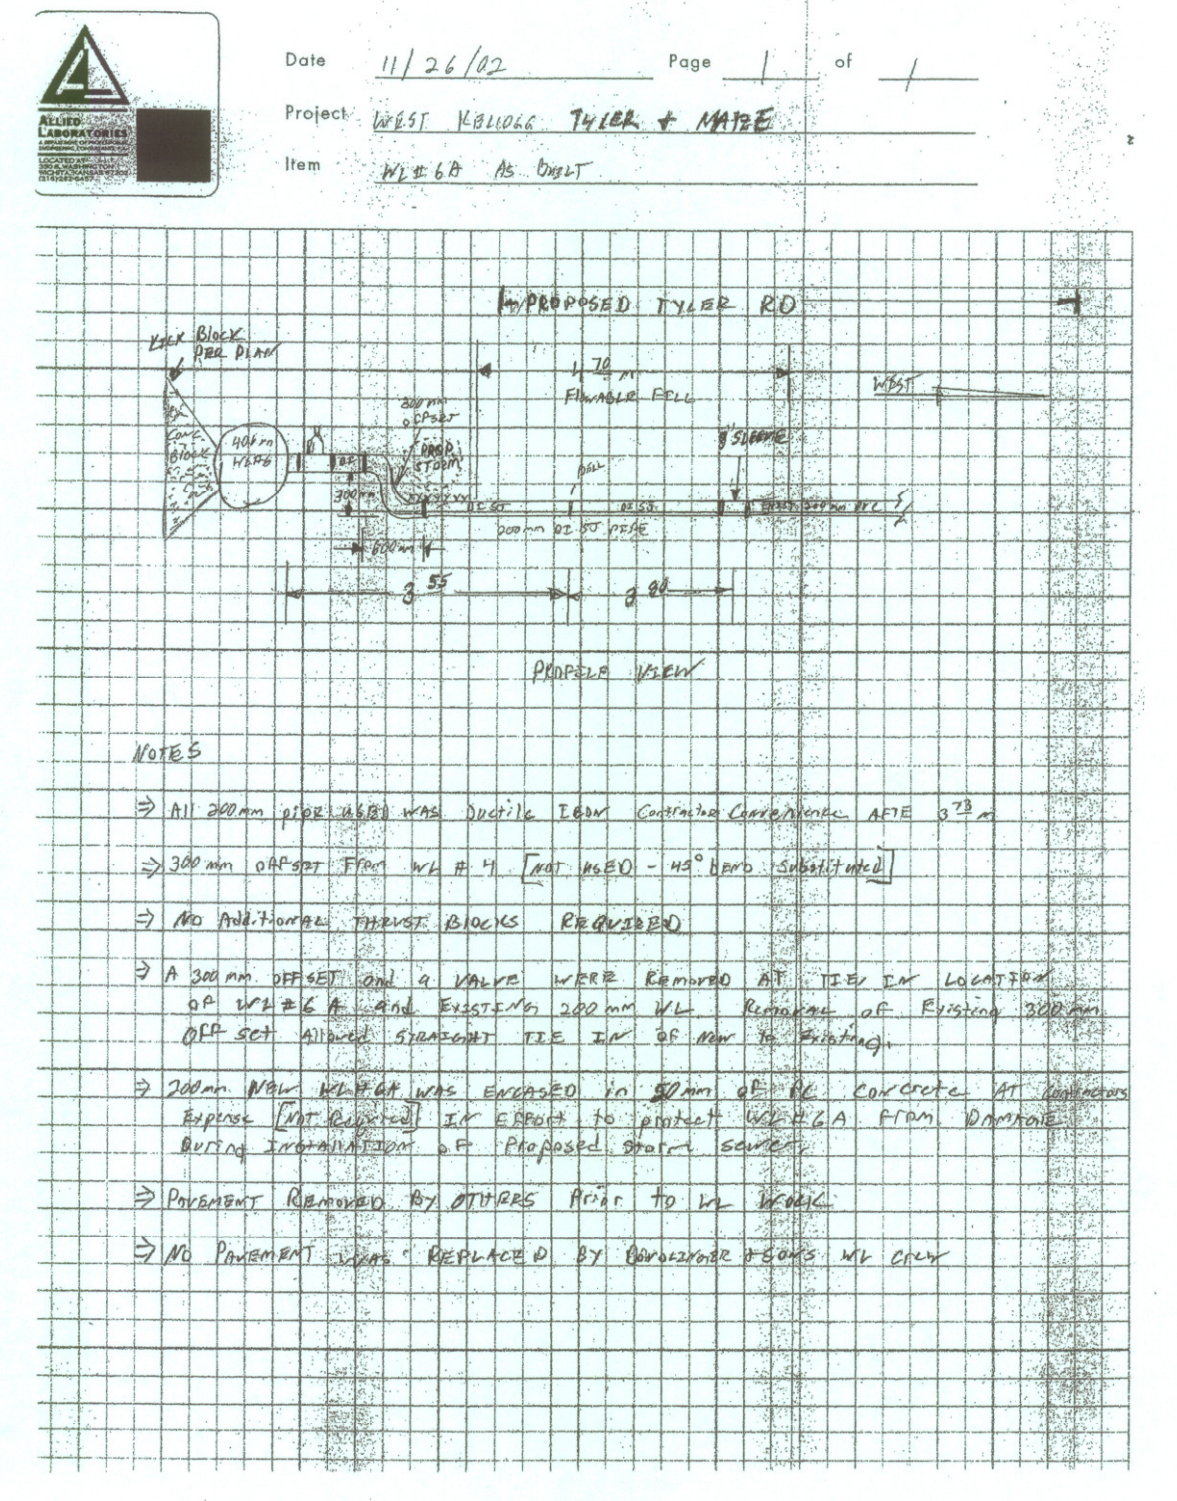


12" & 16" BUTTERFLY VALVE OFFSET LOCATION
 PROJECT: WEST KELLOGG FREEWAY - MAIZE and TYLER ROAD INTERCHANGES
 PROJECT NUMBER: 472-83533 OCA NUMBER: 702315

H2O LINE #	(PLAN STA) H2O LINE STA	BUTTERFLY VALVE SIZE (mm)	OFFSET TO WL CL	OFFSET DIRECTION	REMARKS
1	1+241.3	406	LT	NORTH	
1	1+241.3	406	LT	NORTH	
3	0+000.0	300	RT	WEST	
1	1+659.3	406	LT	NORTH	
1	1+659.3	406	LT	NORTH	
1	1+659.3	406	RT	SOUTH	Non-tapping
1	2+435.4	406	LT	NORTH	
1	2+435.4	406	LT	NORTH	
2	0+000.0	406	RT	WEST	
2	0+992.1	406	LT	NORTH	East of Cross
2	0+992.1	406	RT	SOUTH	West of Cross
5	0+120.2	406	LT	EAST	South of Cross
5	0+120.2	406	LT	EAST	Relocated WL #5 0+020
2	1+413.6	300	RT	WEST	
2	1+831.7	406	RT	WEST	North of Cross
2	1+831.7	406	RT	SOUTH	West of Cross
2	1+831.7	406	LT	EAST	South of Cross
2	1+831.7	406	LT	NORTH	East of Cross
6	0+107.0	300	LT	NORTH	Fire Service Detail
1	1+959.9	406	LT	NORTH	

NOTE: Station location is original Plan reference only see As-Built drawings for actual STA.

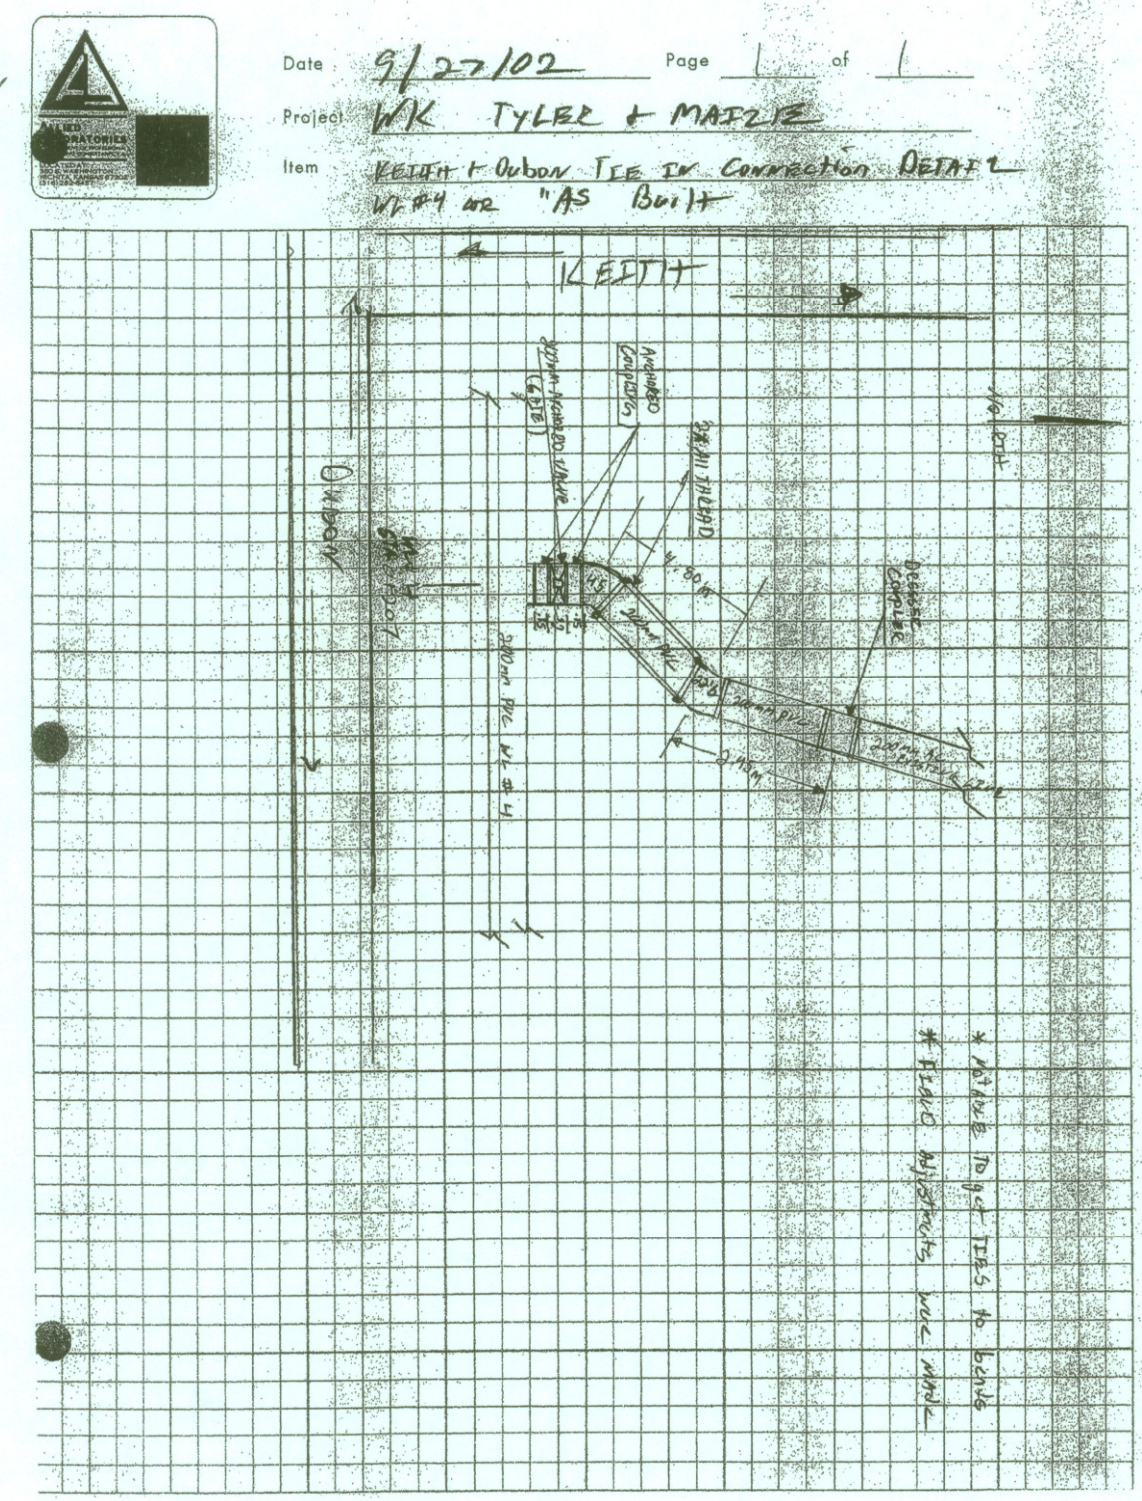

RECORD DRAWING
 Larry D. Powell 10-18-04

1			
No.	Revisions	By	Date
CITY OF WICHITA, KANSAS			
INSPECTOR'S SKETCHES			
SEDGWICK COUNTY			
Professional Engineering Consultants, P.A. 303 S. TOPEKA • WICHITA, KANSAS 67202 316-262-2691 • FAX 316-262-3003			
Designed by	KJW	Checked by	
Drawn by		Date	FEBRUARY, 2004
		Job No.	97362

DSNR: KJW OPER: ILS SCALE: 1"=1.00
 Q:\1997\97362\007\AsBuilts\InspSketch200B 02-20-2004 01:36:06 pm