


25mm (1") SERVICE CONNECTION SCHEDULE

EXISTING METER BOX LOCATION			RELOCATED METER BOX LOCATION						
STATION	OFFSET (M)	ENGLISH UNITS DESCRIPTION	STATION	OFFSET (M)	ENGLISH UNITS DESCRIPTION	DISTANCE FROM MAIN TO BOX (M)	(FT.)	TOP METER BOX ELEVATION	ADDRESS
US-54									
14+312.594	15.320 Rt.	9' S. of S. Pymt. Kellogg Dr., 68' W. of Drive to 11701	14+311.820	41.287 Rt.	124.7' N, 25' W. of NE Cor. W. Bldg. 11701 W. Kellogg	0.438 M	1.44'		11701 W. Kellogg*
14+375.684	18.435 Rt.	12.7' S. of S. Pymt. Kellogg Dr., 81' W. of E. End Pymt.	14+374.597	43.664 Rt.	122' N, 31' W. of NE Cor. E. Bldg. 11701 W. Kellogg	0.568 M	1.86'		11701 W. Kellogg*
14+826.096	42.898 Lt.	4.3' E., 0.5' N. of N.E. Cor. 111th St. W. & Kellogg	Same	Same	Same	6.144 M	20.16'		11118 W. Kellogg*
16+471.144	50.192 Rt.	27' E. of the E. P. Seville, 1.25' S. of S. R/W Kellogg	Same	Same	Same	4.946 M	16.23'	402.822	9501 W. Kellogg
16+573.412	47.261 Rt.	426' E. of the E. P. Seville, on S. R/W Kellogg	Same	48.053 Rt.	426' E. of E. P. Seville, 3' S. of S. R/W US-54	4.493 M	14.74'	403.596	9401 W. Kellogg
16+858.928	44.055 Rt.	525' W. of the W. P. Byron, 1' S. of S. R/W Kellogg	Same	45.700 Rt.	525' W. of W. P. Byron, 6' S. of S. R/W Kellogg	9.491 M	31.14'	403.523	9127 W. Kellogg
17+004.784	42.160 Rt.	46' W. of the W. P. Byron, on S. R/W Kellogg	Same	42.982 Rt.	46' W. of W. P. Byron, 3' S. of S. R/W Kellogg	9.562 M	31.37'	403.324	9021 W. Kellogg
17+123.380	41.399 Rt.	277' E. of the E. P. Byron, 1' S. of S. R/W Kellogg	Same	Same	Same	2.879 M	26.18'	--	8925 W. Kellogg
17+125.153	41.458 Rt.	283' E. of the E. P. Byron, 1' S. of S. R/W Kellogg	Same	Same	Same	6.038 M	26.37'	--	8923 W. Kellogg
17+170.648	39.970 Rt.	432' E. of E. P. Byron, 3' N. of S. R/W Kellogg	Same	Same	Same	6.350 M	20.83'	--	8923 W. Kellogg
17+385.134	56.250 Rt.	201' E. of E. P. Tyler, 2' N. of S. R/W Kellogg	Same	Same	Same	12.955 M	42.50'	--	8725 W. Kellogg
17+414.814	55.099 Rt.	7' E. of W. P., 18' S. of of Irving	17+415.930	Same	11' E. of W. P., 18' S. of of Irving	12.194 M	40.01'	405.436	8629 W. Kellogg
17+519.430	36.461 Rt.	87' E. of E. R/W Irving, 4' S. of S. R/W Kellogg	Same	Same	Same	2.458 M	8.06'	--	8619 W. Kellogg
17+553.912	36.560 Rt.	191' E. of E. R/W Irving, on S. R/W Kellogg	Same	Same	Same	2.355 M	7.73'	--	8535 W. Kellogg
17+587.355	37.458 Rt.	524' W. of of Recca, 4' N. of S. R/W Kellogg	17+581.681	37.447 Rt.	543' W. of of Recca, 3' N. of S. R/W Kellogg	1.754 M	5.75'	405.048	
17+593.604	37.576 Rt.	504' W. of of Recca, 4' N. of S. R/W Kellogg	Same	Same	Same	1.398 M	4.59'	--	8451 W. Kellogg
17+682.430	40.123 Rt.	220' W. of of Recca, 1' N. of S. R/W Kellogg	Same	Same	Same	1.603 M	5.30'	--	8401 W. Kellogg
17+796.911	44.543 Rt.	117' E. of E. P. Recca, 1' S. of S. R/W Kellogg	Same	Same	Same	4.471 M	14.67'	--	8323 W. Kellogg
17+936.029	38.114 Rt.	584' E. of of Recca, 13' N. of S. R/W Kellogg	17+942.272	38.102 Rt.	586' E. of of Recca, 25' N. of S. R/W Kellogg	1.661 M	5.45'	404.647	8211 W. Kellogg
18+015.498	36.018 Rt.	483' W. of of Woodchuck, on S. R/W Kellogg	18+019.999	36.725 Rt.	469' W. of of Woodchuck, 3' S. of S. R/W Kellogg	0.713 M	2.34'	404.600	8181 W. Kellogg
18+060.930	31.892 Rt.	341' W. of of Woodchuck, 15' S. of N. R/W Kellogg	18+060.930	35.966 Lt.	342' W. of of Woodchuck, 2' S. of N. R/W Kellogg	1.956 M	6.5'	404.780	8100 W. Kellogg
18+095.112	33.071 Rt.	224' W. of of Woodchuck, on S. R/W Kellogg	18+091.688	33.070 Rt.	235' W. of of Woodchuck, on S. of S. R/W Kellogg	3.061 M	10.04'	404.513	8027 W. Kellogg
MAIZE									
3+694.634	9.800 Lt.	339' N. of Ringer, 17' W. of E. R/W Maize	Same	Same	Same				1414 S. Maize Rd.
3+696.597	14.612 Rt.	333' N. of Ringer, 2' E. of W. R/W Maize	Same	15.719 Rt.	333' N. of Ringer, 2' W. of W. R/W Maize	27.606 M	90.57'	--	1411 S. Maize Rd.
3+734.790	11.936 Lt.	207.4' N. of Ringer, 10.8' W. of E. R/W Maize Rd.	Same	Same	Same				1434 S. Maize Rd.
4+184.740	14.284 Lt.	311' S. of RR Crossing, 3' W. of E. R/W Maize Rd.	Same	Same	Same	8.4 M	27.5'	403.138	1632 S. Maize Rd.
4+325.605	12.4 Rt.	135' N. of of Merton, 9.2' E. of W. R/W Maize Rd.	Same	Same	Same	25.2 M	83'	403.470	1735 S. Maize Rd.
4+358.361	8.4 Rt.	10.5' S. of S. Drive, 22.5' E. of W. R/W Maize Rd.	Same	11.5 Rt.	10.5' S. of S. Drive, 12.4' E. of W. R/W Maize Rd.	24.1 M	79'	403.440	1745 S. Maize Rd. (Apt. #2)
4+414.351	7.1 Rt.	162' N. of Carr, 27' E. of W. R/W Maize	Same	11.5 Rt.	162' N. of Carr, 23' E. of W. R/W Maize	23.8 M	78'	403.650	1745 S. Maize Rd.
TYLER									
4+933.243	12.310 Rt.	410' S. of Belview, 25' E. of W. R/W Tyler	Same	Same	Same	0.600 M	2'	--	
5+236.657	10.036 Rt.	166' N. of N. R/W Cen. Ks. Rwy., 18' E. of W. R/W Tyler	Same	Same	Same	17.443 M	57.23'	--	1455 S. Tyler Rd.
5+367.029	10.871 Lt.	174' S. of S. R/W Cen. Ks. Rwy., 14' W. of E. R/W Tyler	5+368.334	12.447 Lt.	178' S. of S. R/W Cen. Ks. Rwy., 9' W. of E. R/W Tyler	0.994 M	3.26'	404.370	1520 S. Tyler Rd.
5+402.884	13.922 Lt.	293' S. of S. R/W Cen. Ks. Rwy., 4' W. of E. R/W Tyler	Same	Same	Same	0.481 M	1.58'	404.550	1526 S. Tyler Rd.
5+544.222	11.690 Rt.	226' N. of Harry, 11' E. of W. R/W Tyler	Same	Same	Same	25.200 M	82.68'	402.660	1555 S. Tyler Rd.
WOODCHUCK									
4+930.845	11.70 Lt.	38' E. of Woodchuck, on E. R/W Woodchuck	Same	Same	Same	6.6 M	21.7'	--	7940 W. Kellogg


* New 25mm (1") Meter to be installed by City of Wichita Water Dept. Cost to be reimbursed by the Contractor. See Detail, this Sheet.

See Inspector's Sketches Sheet No. 200C

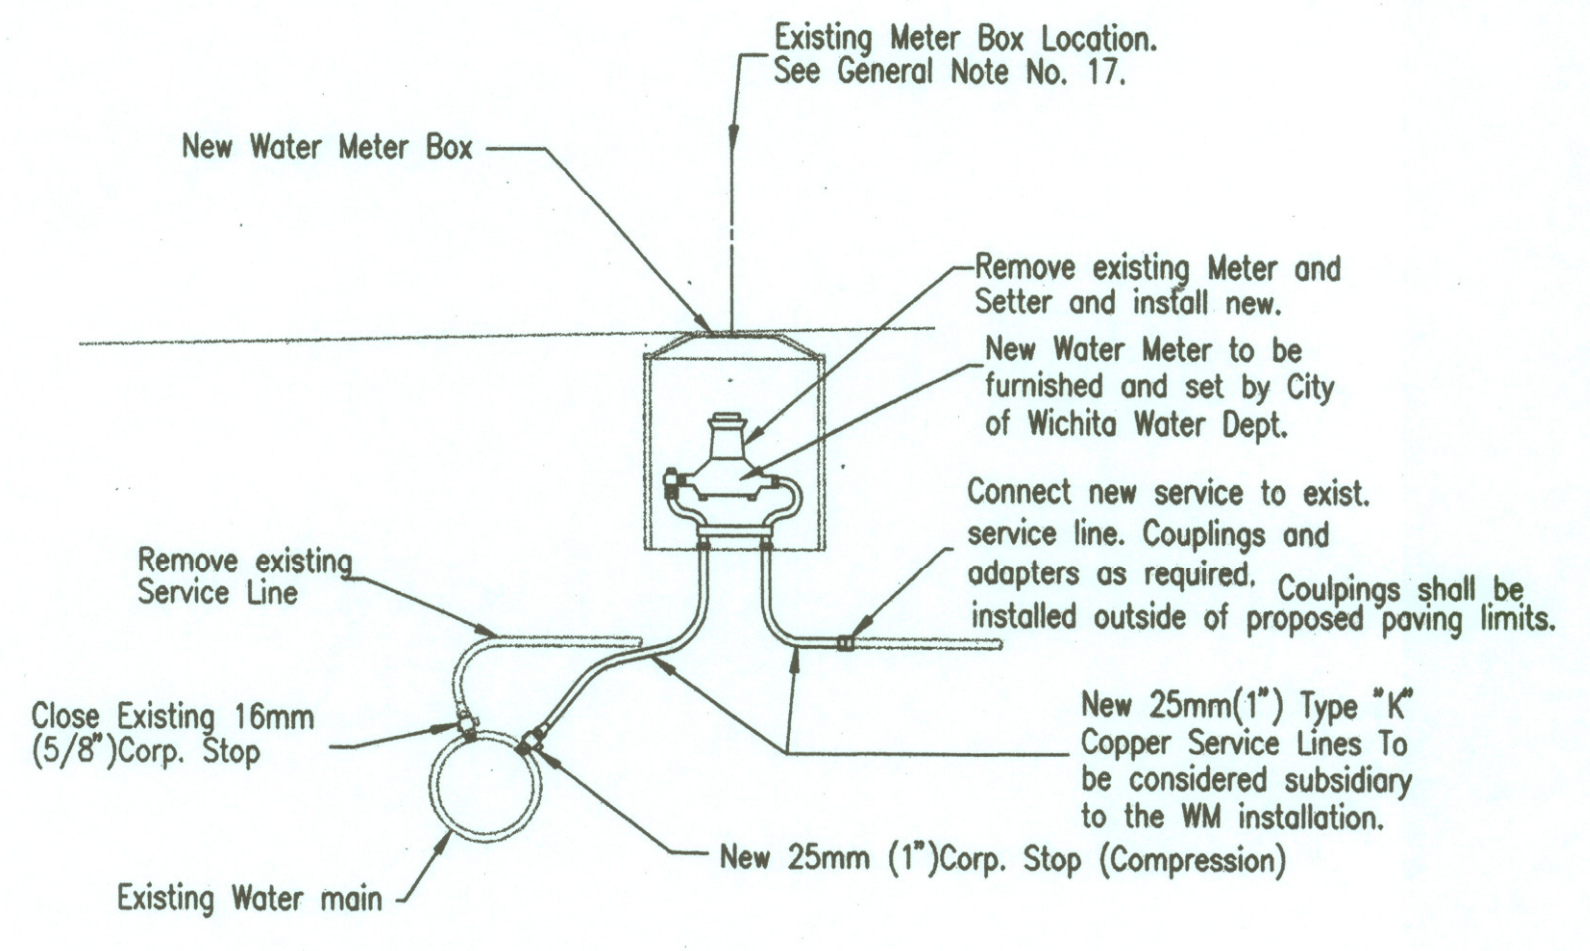


NEW WATER METER INSTALLATION
CONNECTION TO EXISTING WATER MAIN


EXISTING METER BOX LOCATION						
STATION	OFFSET (M)	ENGLISH UNITS DESCRIPTION	DISTANCE FROM MAIN TO BOX (M)	(FT.)	TOP METER BOX ELEVATION	ADDRESS
US-54						
14+816.164	86.159 Rt.	31' S. & 114' W. of the N.W. cor. Bldg.	2.584 M	8.5'	405.827	11135 W. Kellogg
15+106.077	113.167 Rt.	11.5' N. & 28' E. of the S.E. cor Bldg.	2.584 M	8.5'	406.418	10915 W. Kellogg

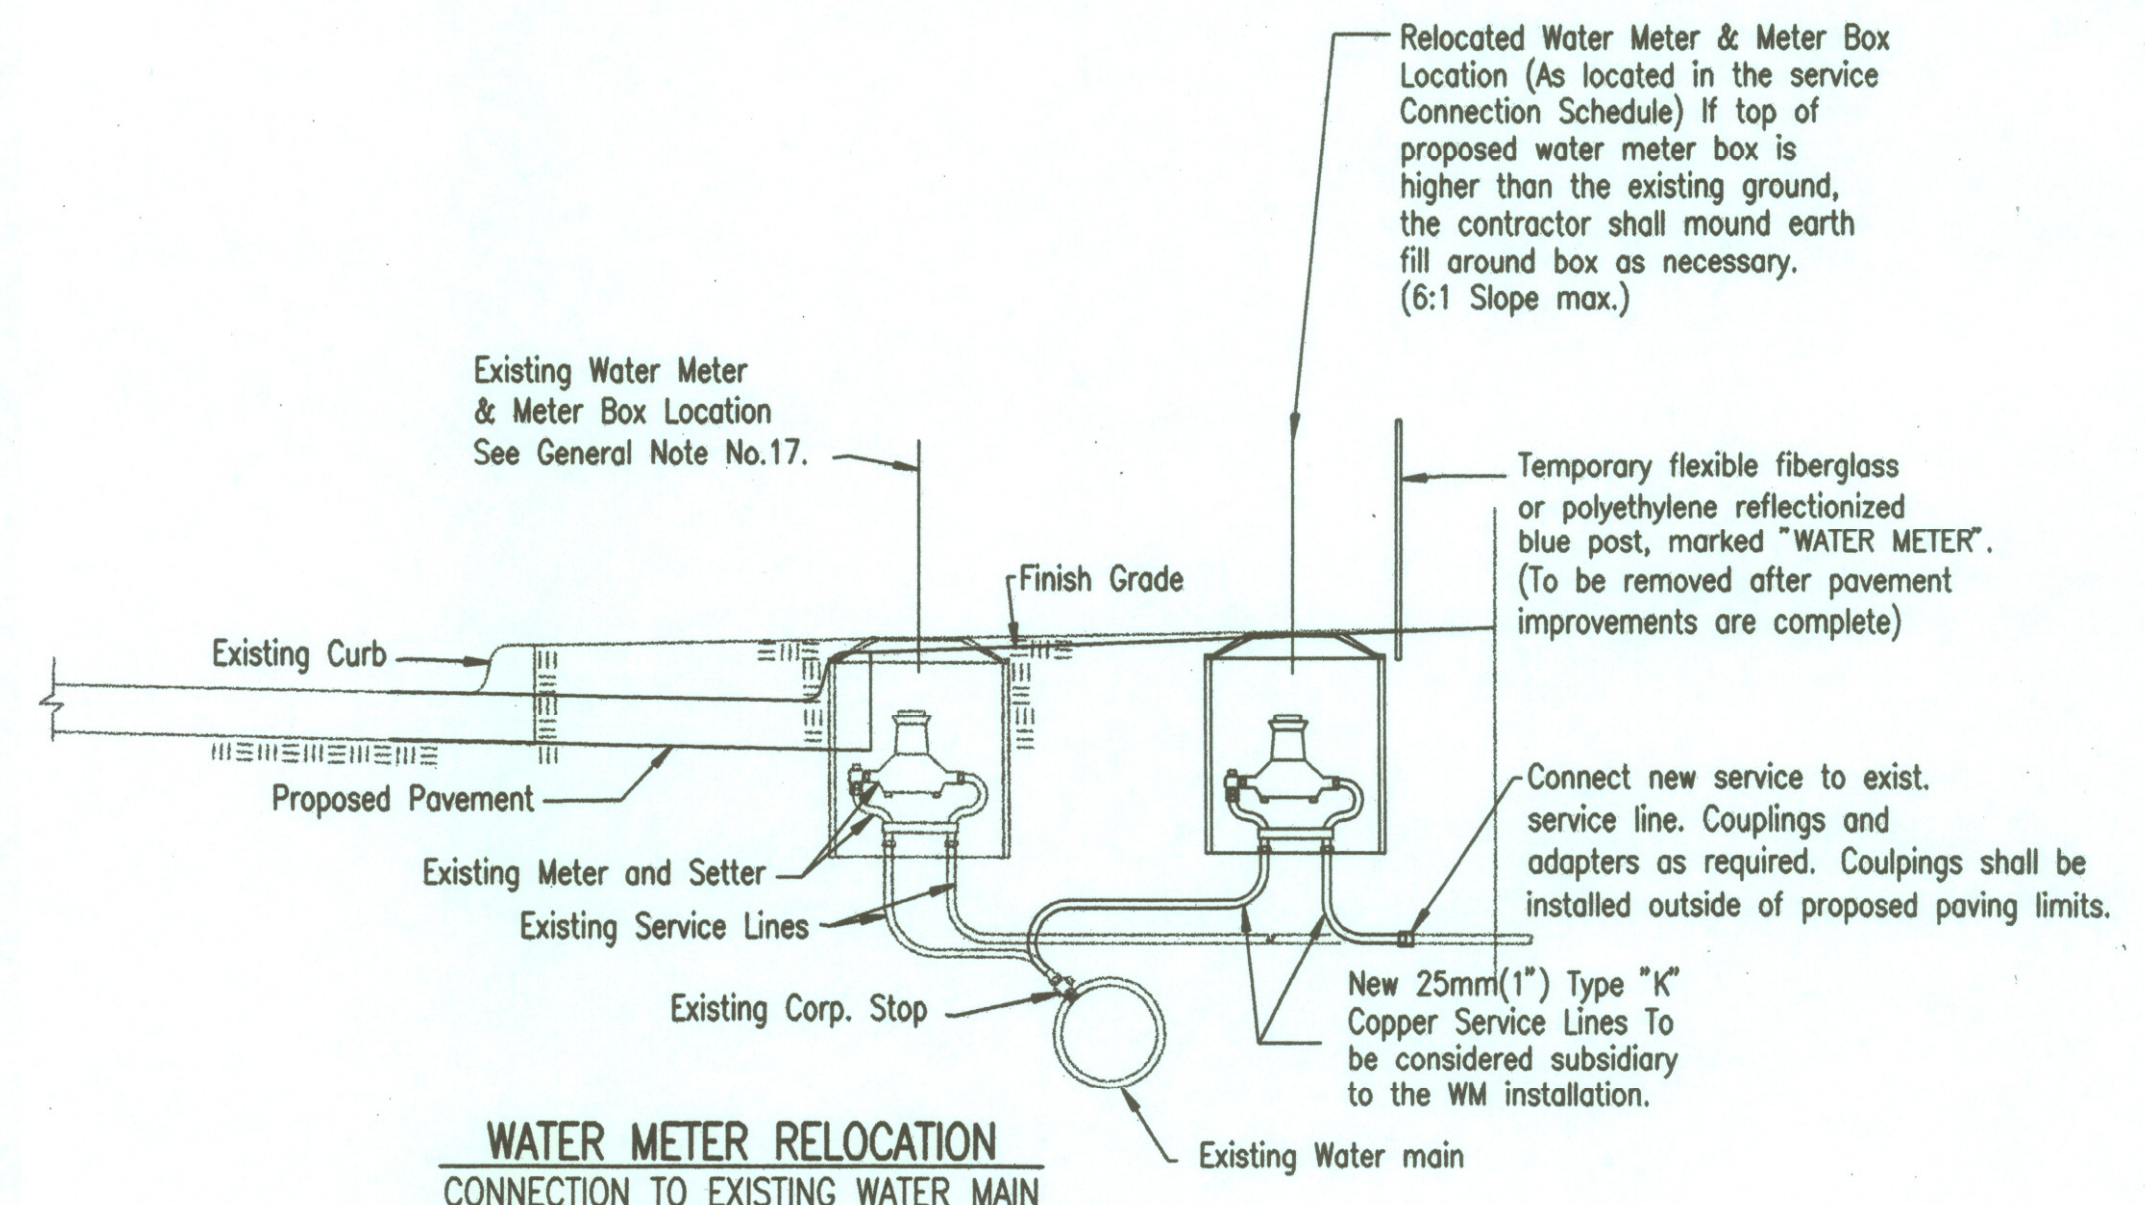

WATER METER RELOCATION
CONNECTION TO EXISTING WATER MAIN

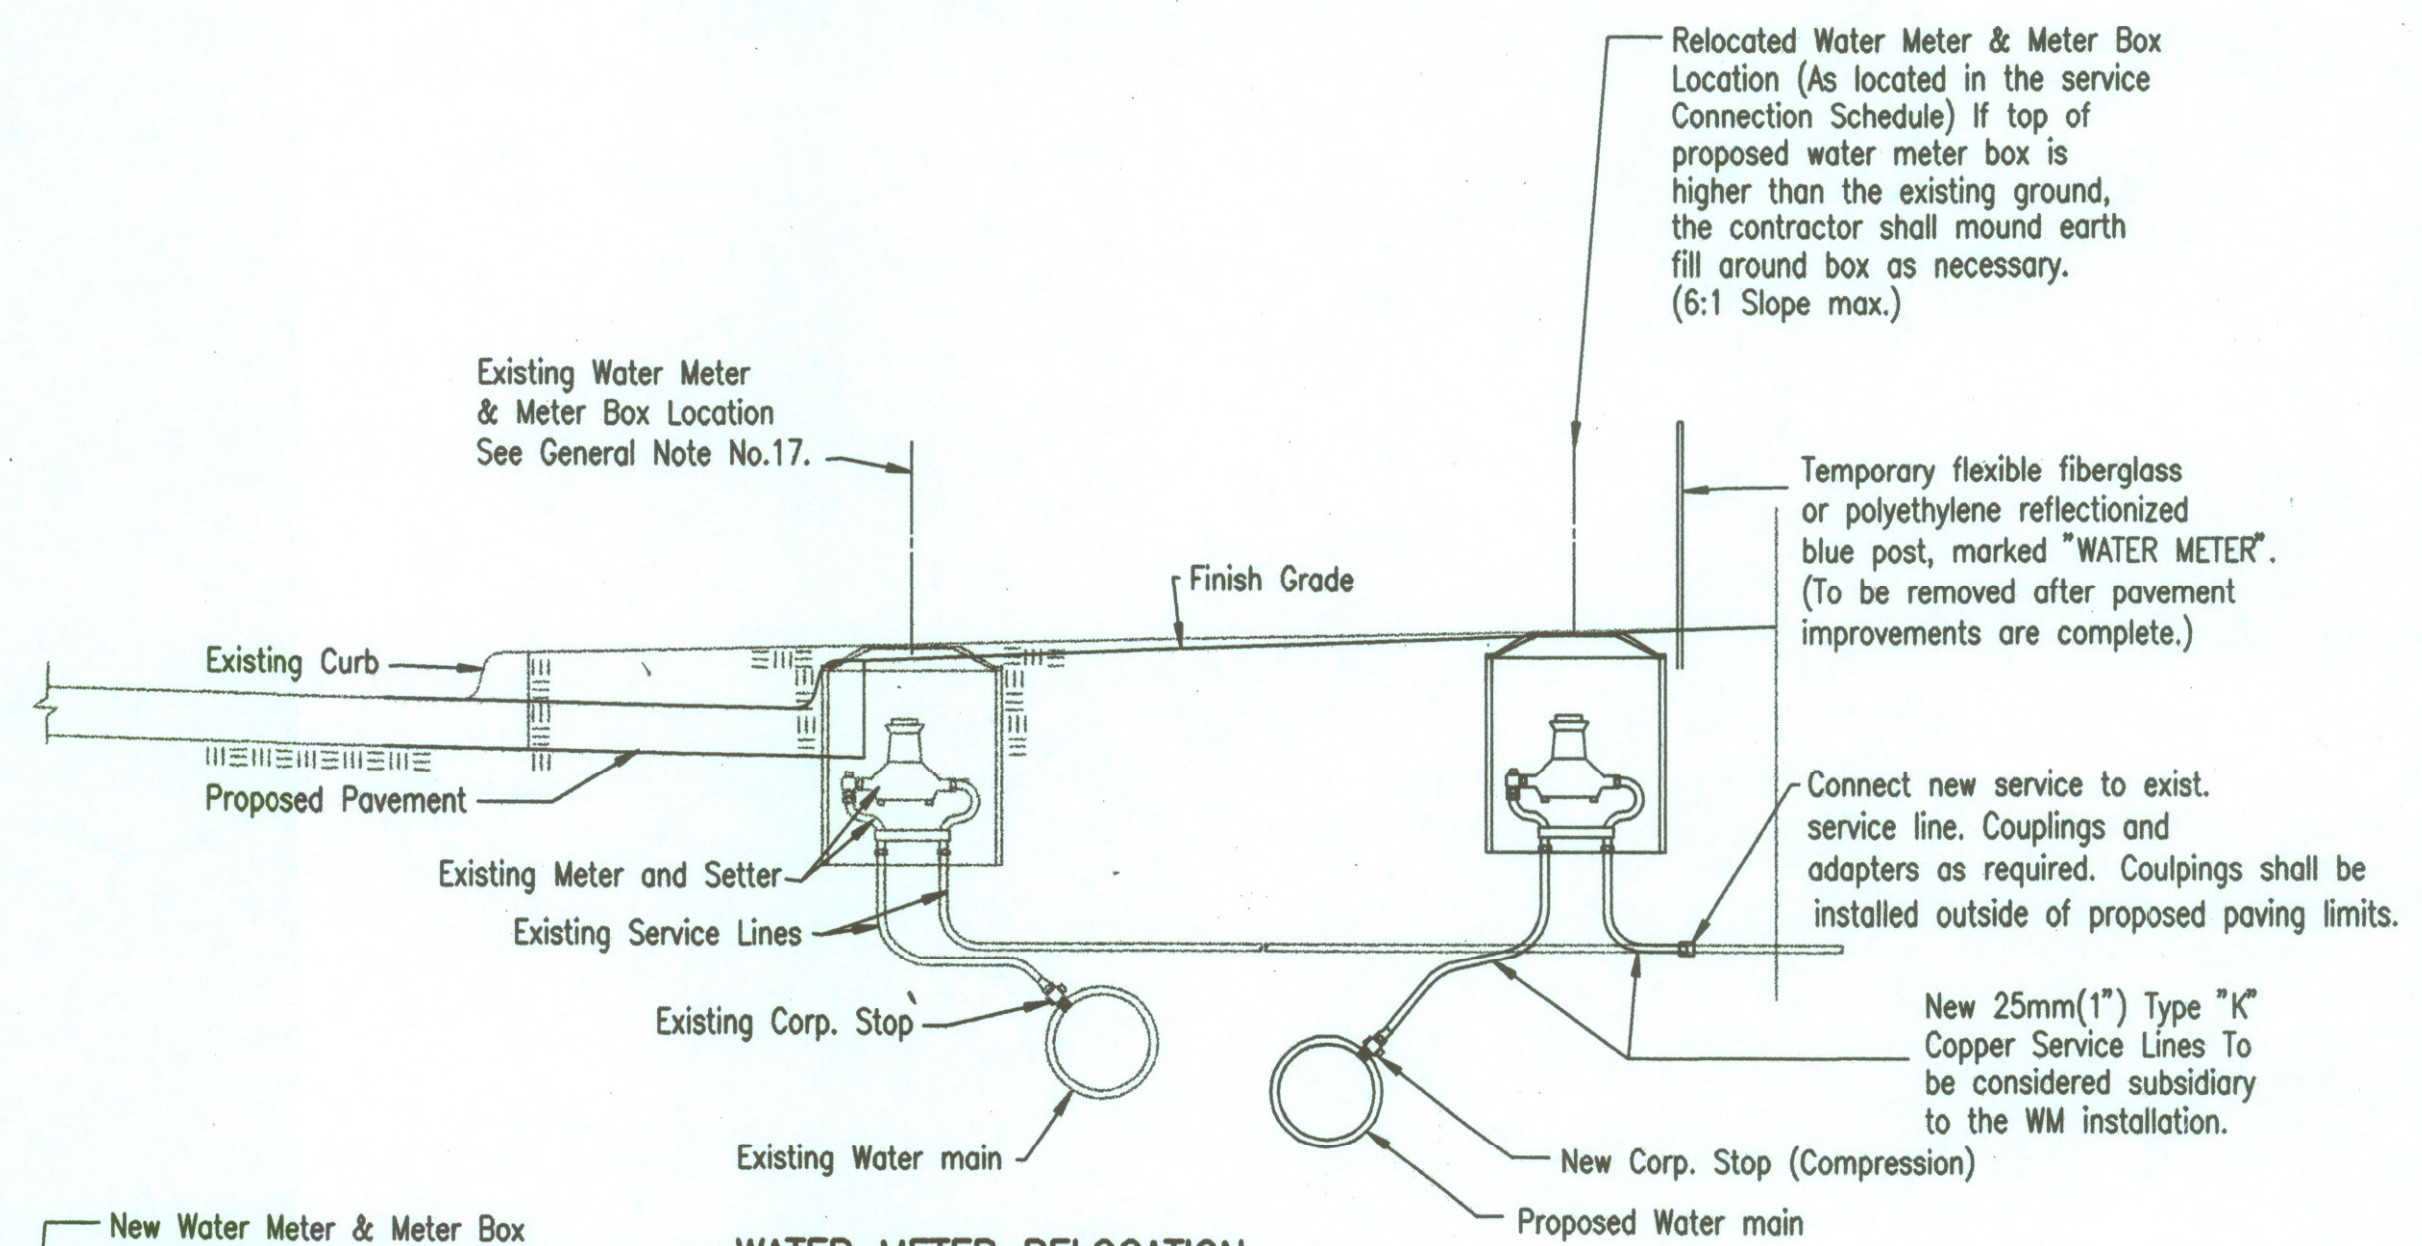

WATER METER RELOCATION
CONNECTION TO PROPOSED WATER MAIN

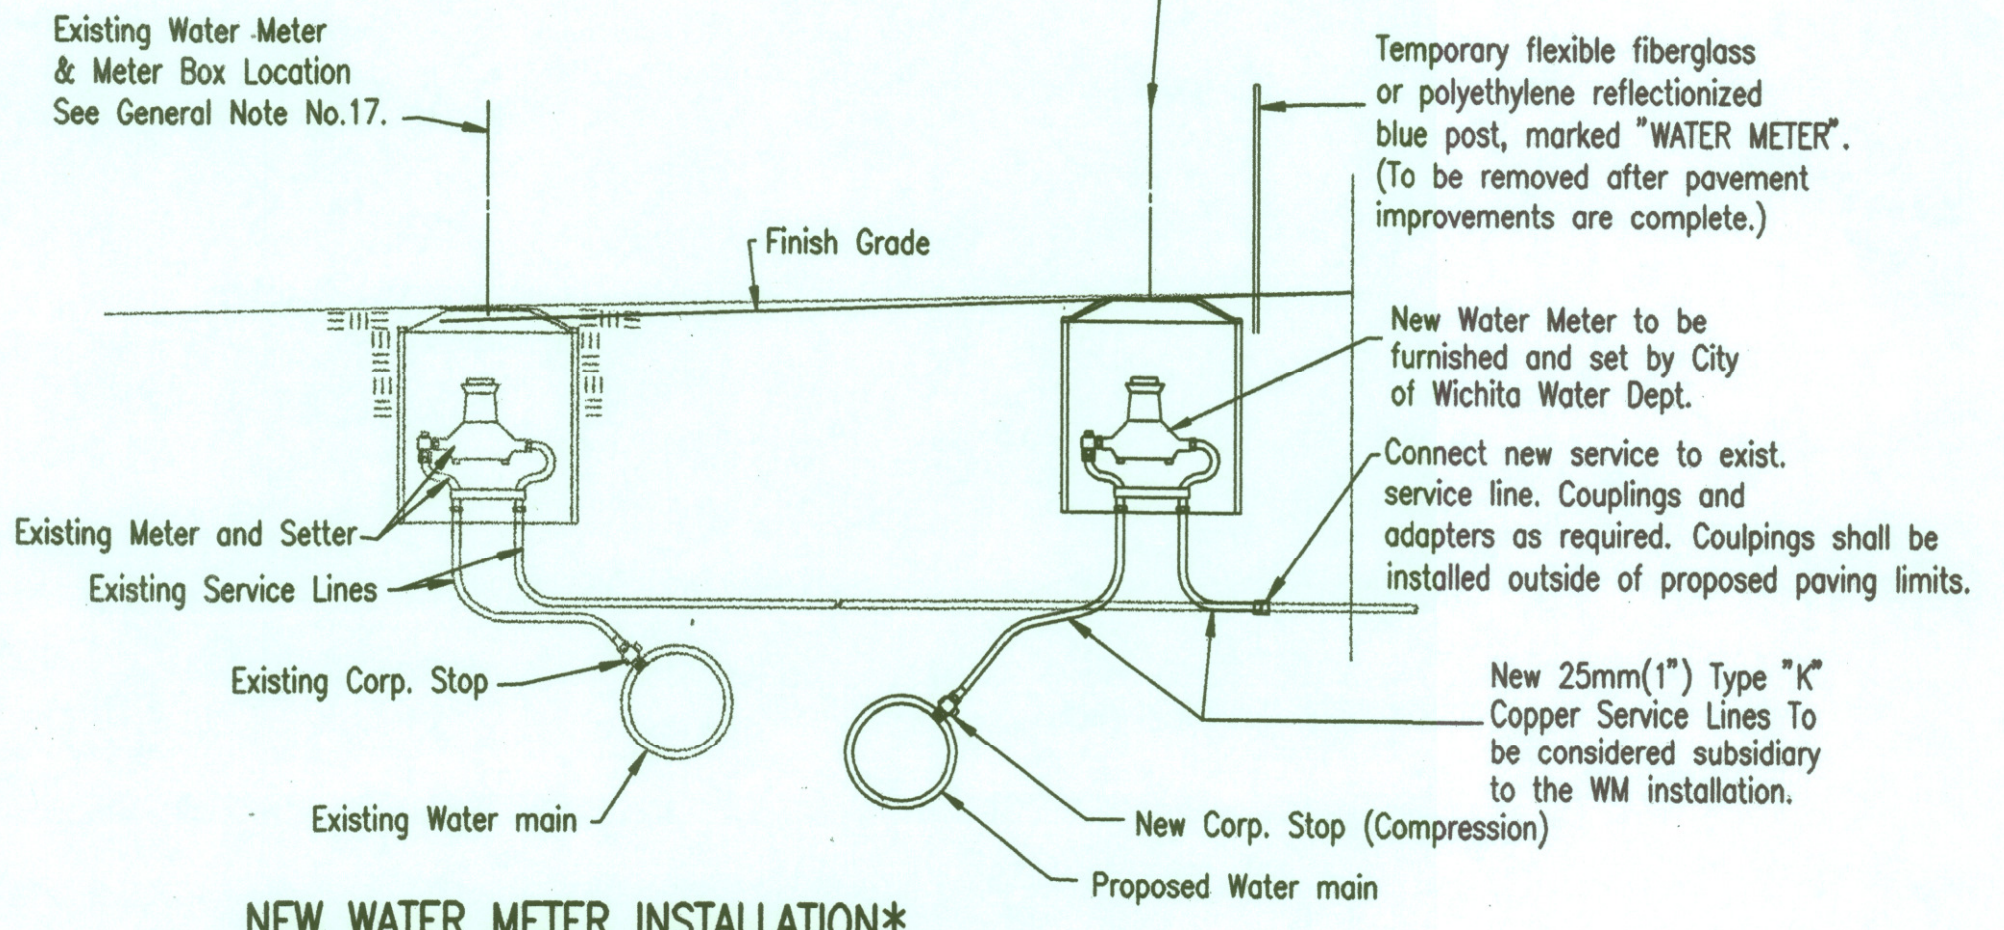

NEW WATER METER INSTALLATION*
CONNECTION TO PROPOSED WATER MAIN

See Inspector's Sketches Sheets 200A, 200B & 200C

RECORD DRAWING
Larry D. Powell 10-18-04

1	Revisions	By	Date
CITY OF WICHITA, KANSAS			
SERVICE SCHEDULE			
SEDGWICK COUNTY			
Professional Engineering Consultants, P.A.			
303 S. TOPKA • WICHITA, KANSAS 67202			
316-262-2691 • FAX 316-262-3003			
Designed by	KJW	Checked by	
Drawn by	TDS, JGA	Date	APRIL, 2002
		Job No.	97362