


SCALE:	PLAN: LAT. & LONG. 1:500	FHWA REGION NO. 7	STATE KANSAS	PROJECT NO. 54-87 K-6657-01	YEAR 2002	SHEET NO. 224	TOTAL SHEETS 1122
	PROFILE: HORIZ. SAME AS ABOVE						
	VERT. 1:50						

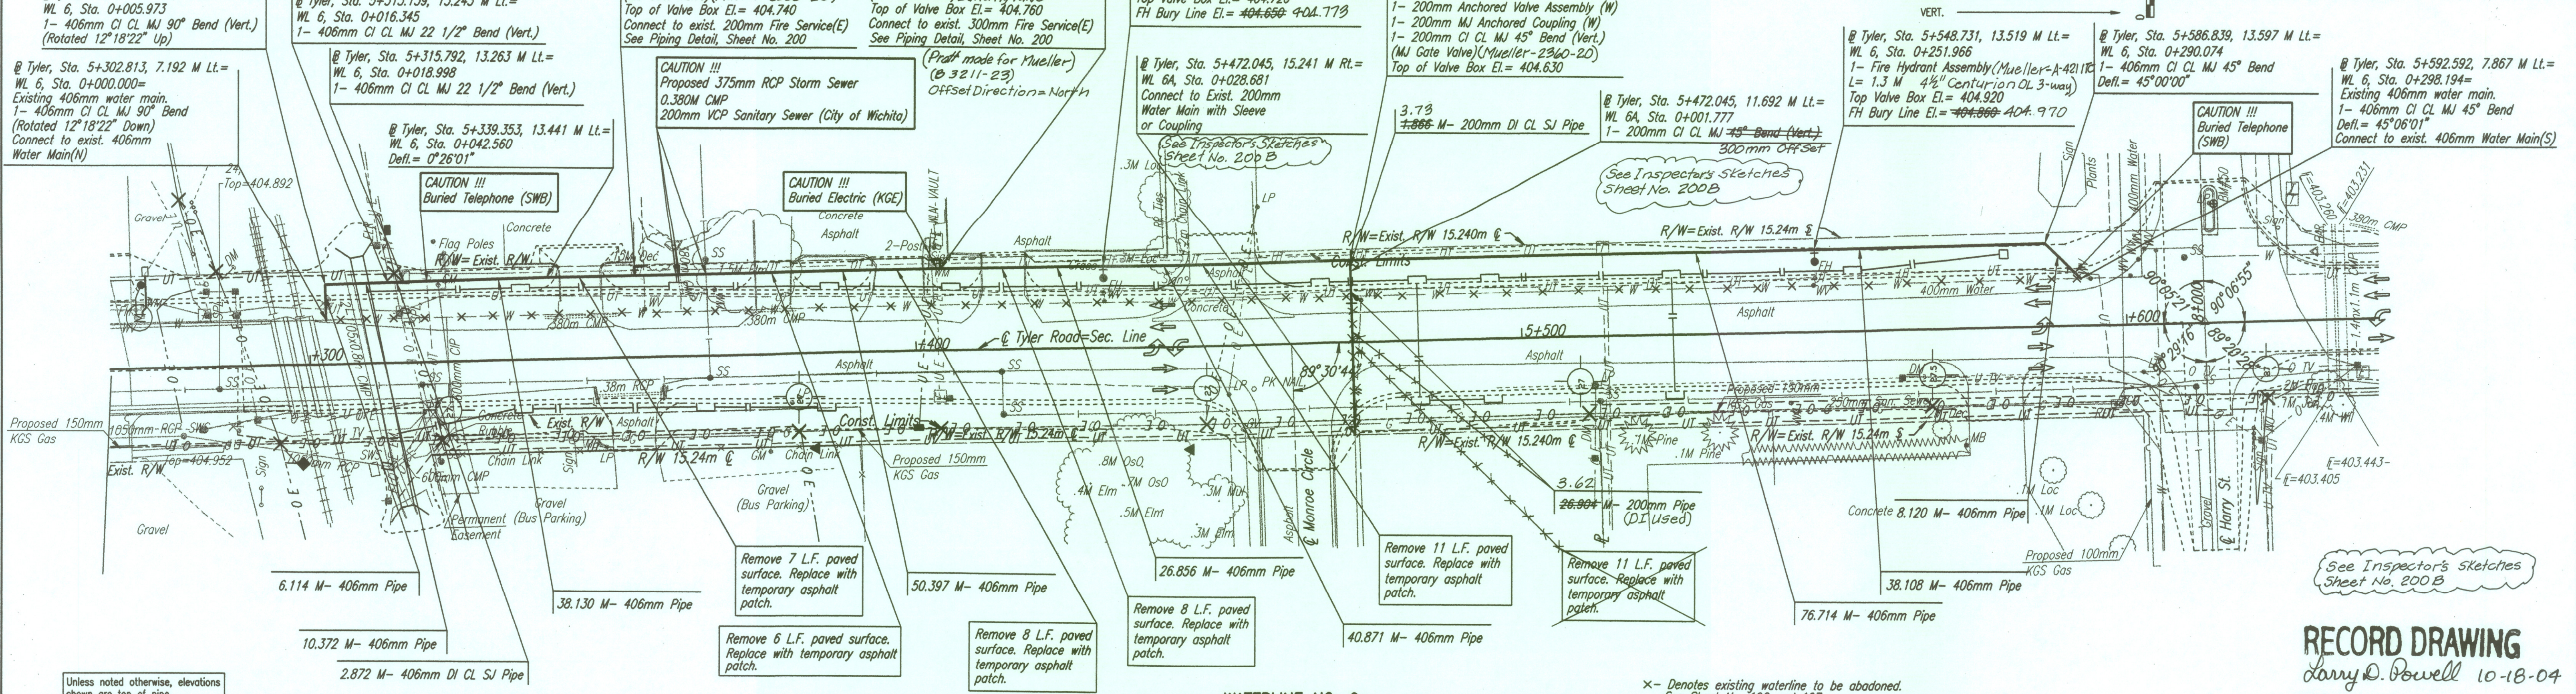


Unless noted otherwise, elevations shown are top of pipe

WATERLINE NO. 6

x - Denotes existing waterline to be abandoned. See Sheet No. 196 and 197.

RECORD DRAWING
 Larry D. Powell 10-18-04

WATERLINE NO. 6A

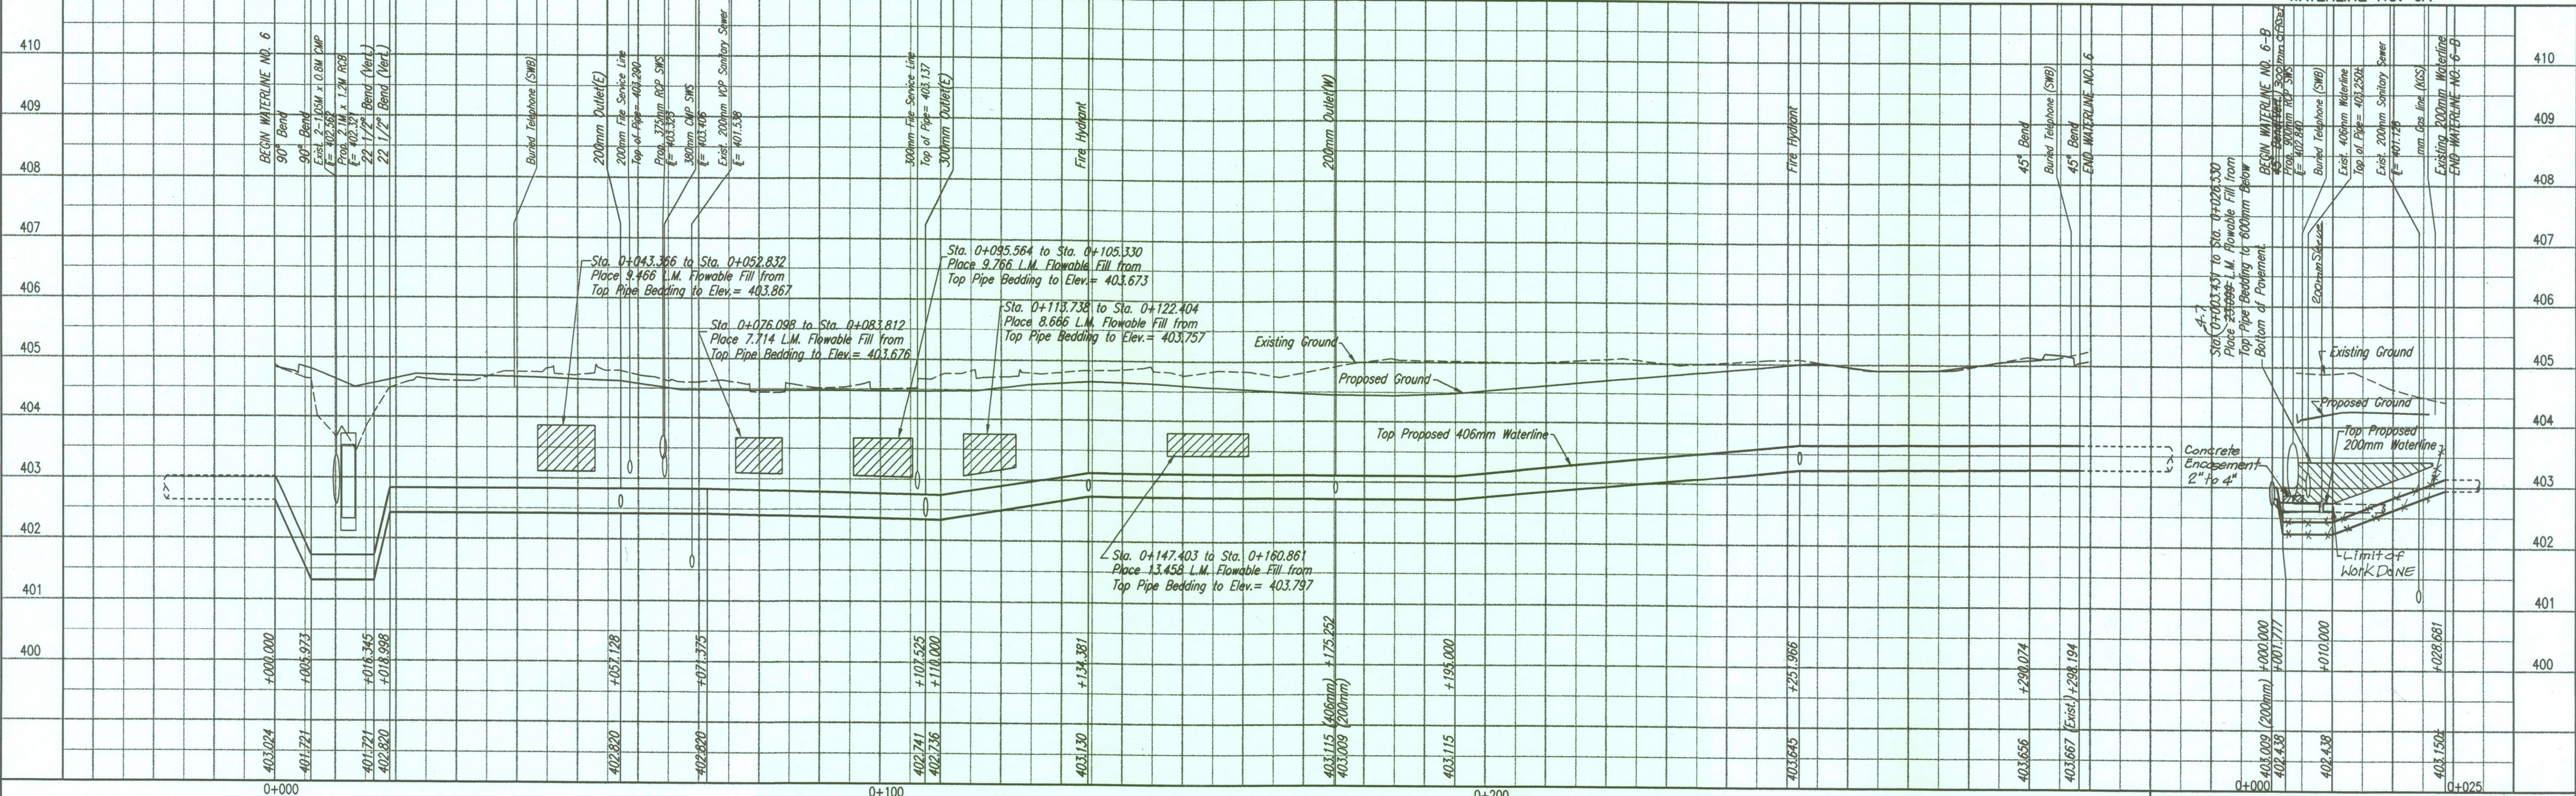

WATERLINE - PLAN/PROFILE