

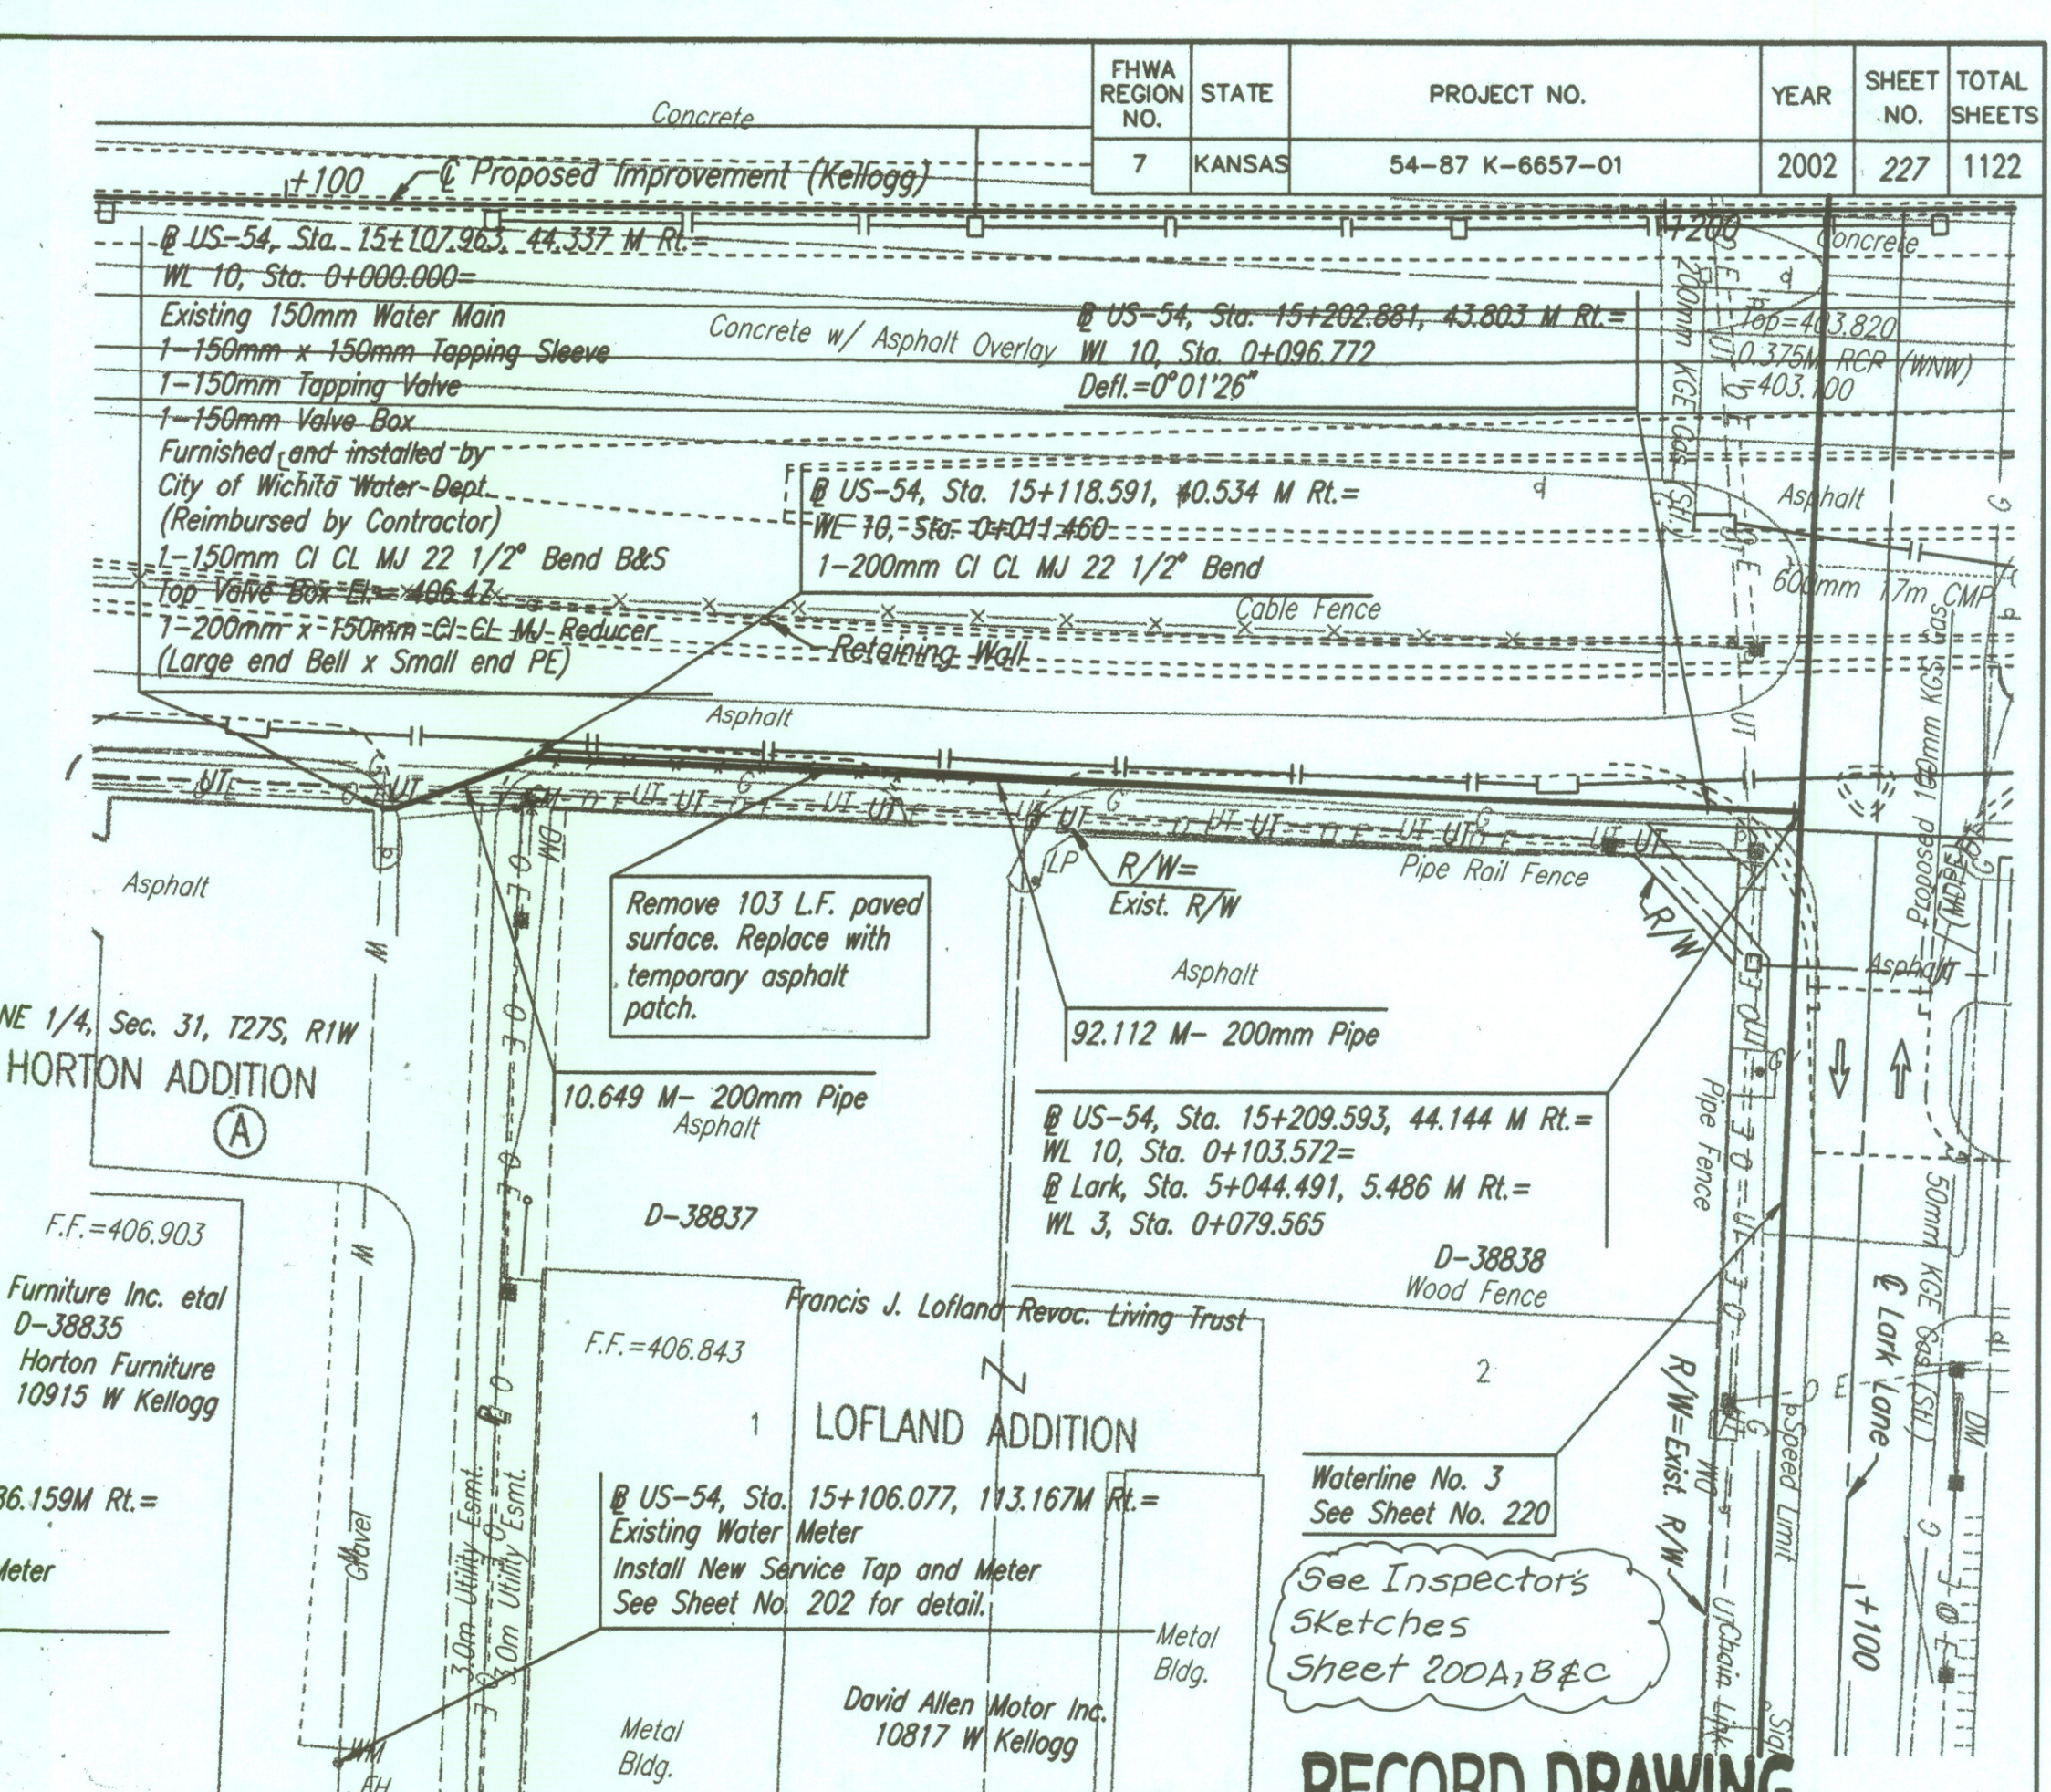
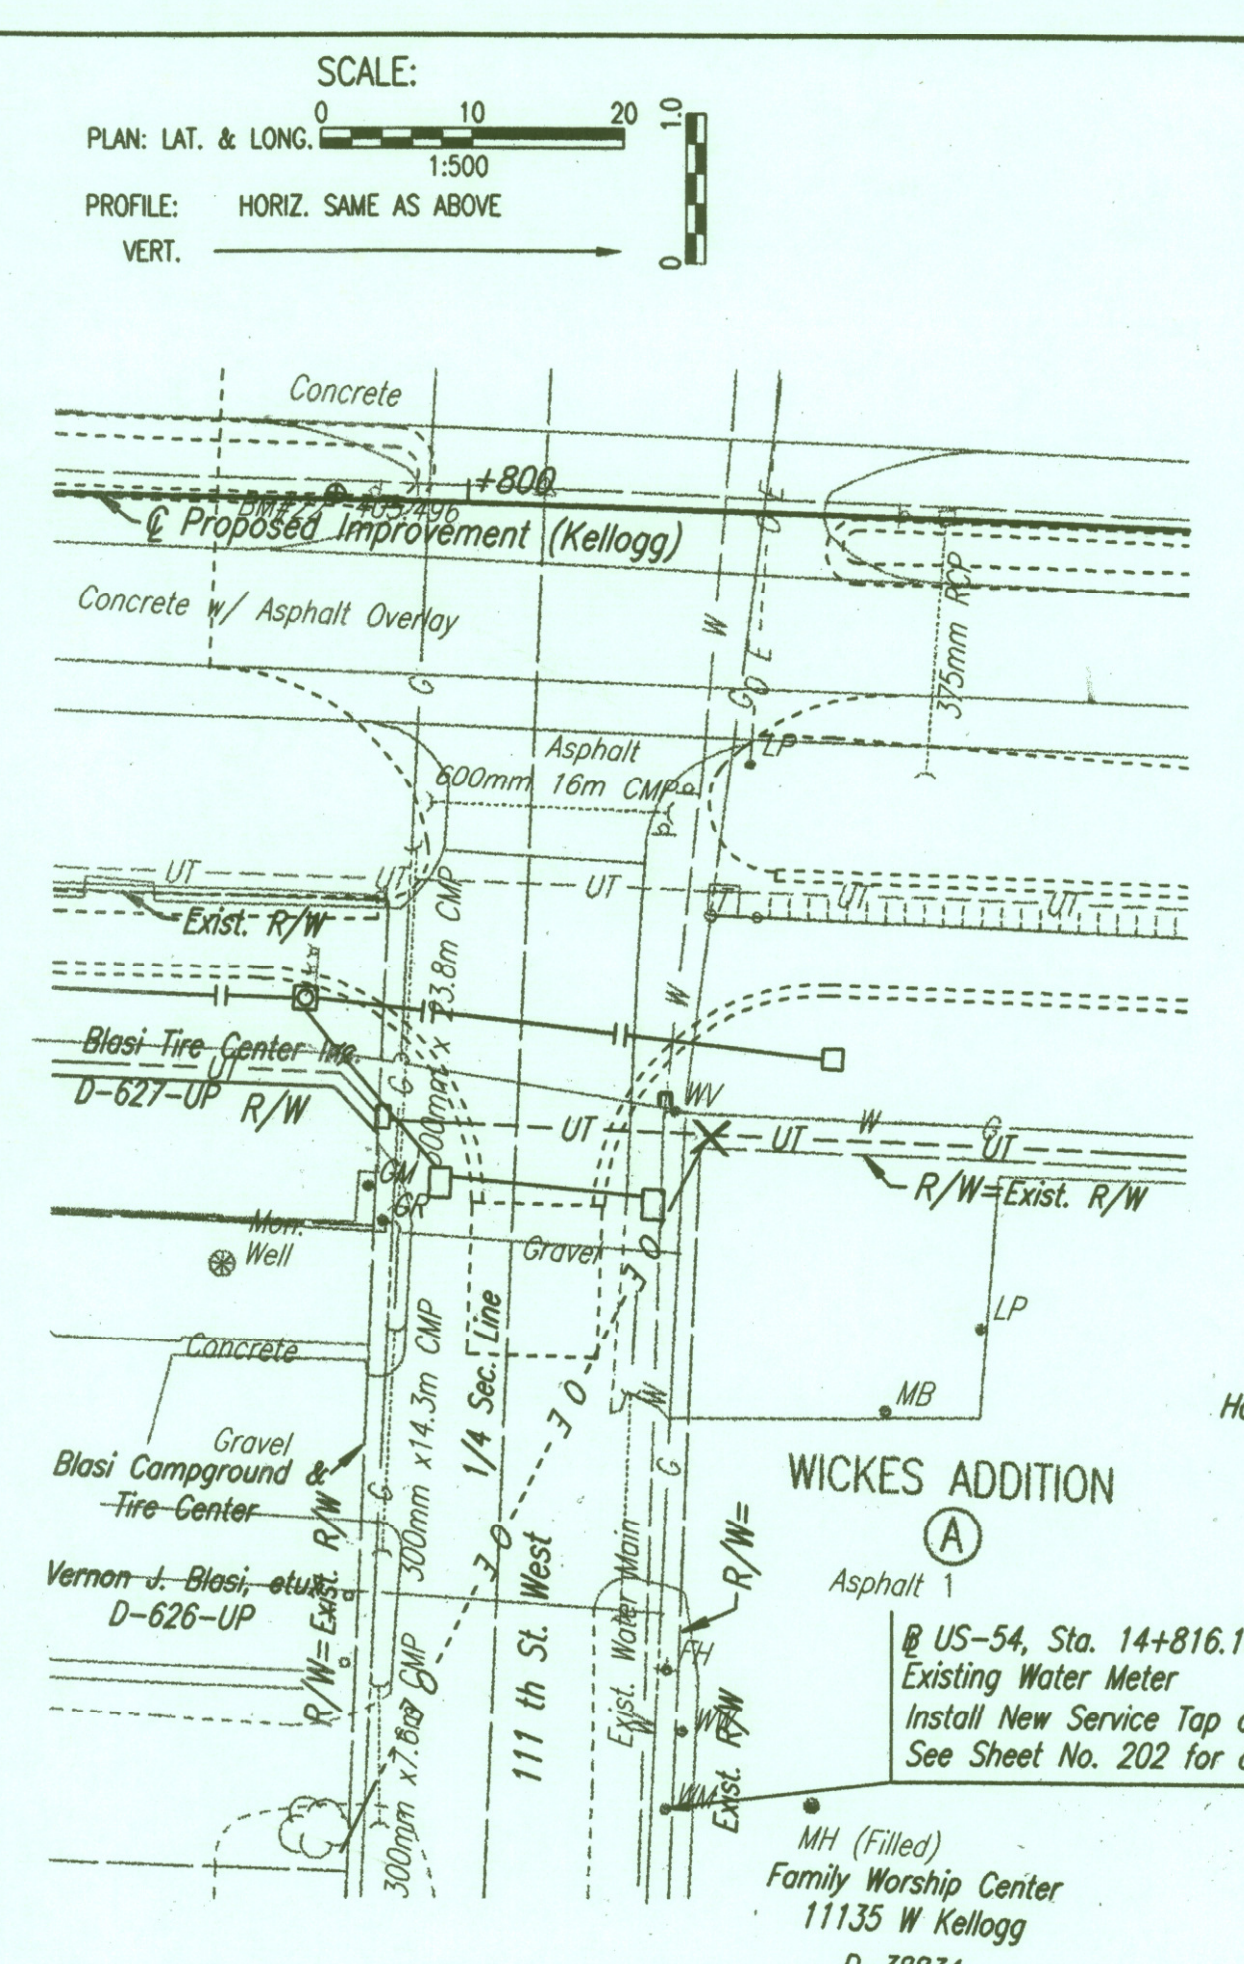


DSNR: K.W. OPER: IDS SCALE: 1=0.50
 Q:\1997\97362\007\wpp23 04-12-2002 11:23:09 am

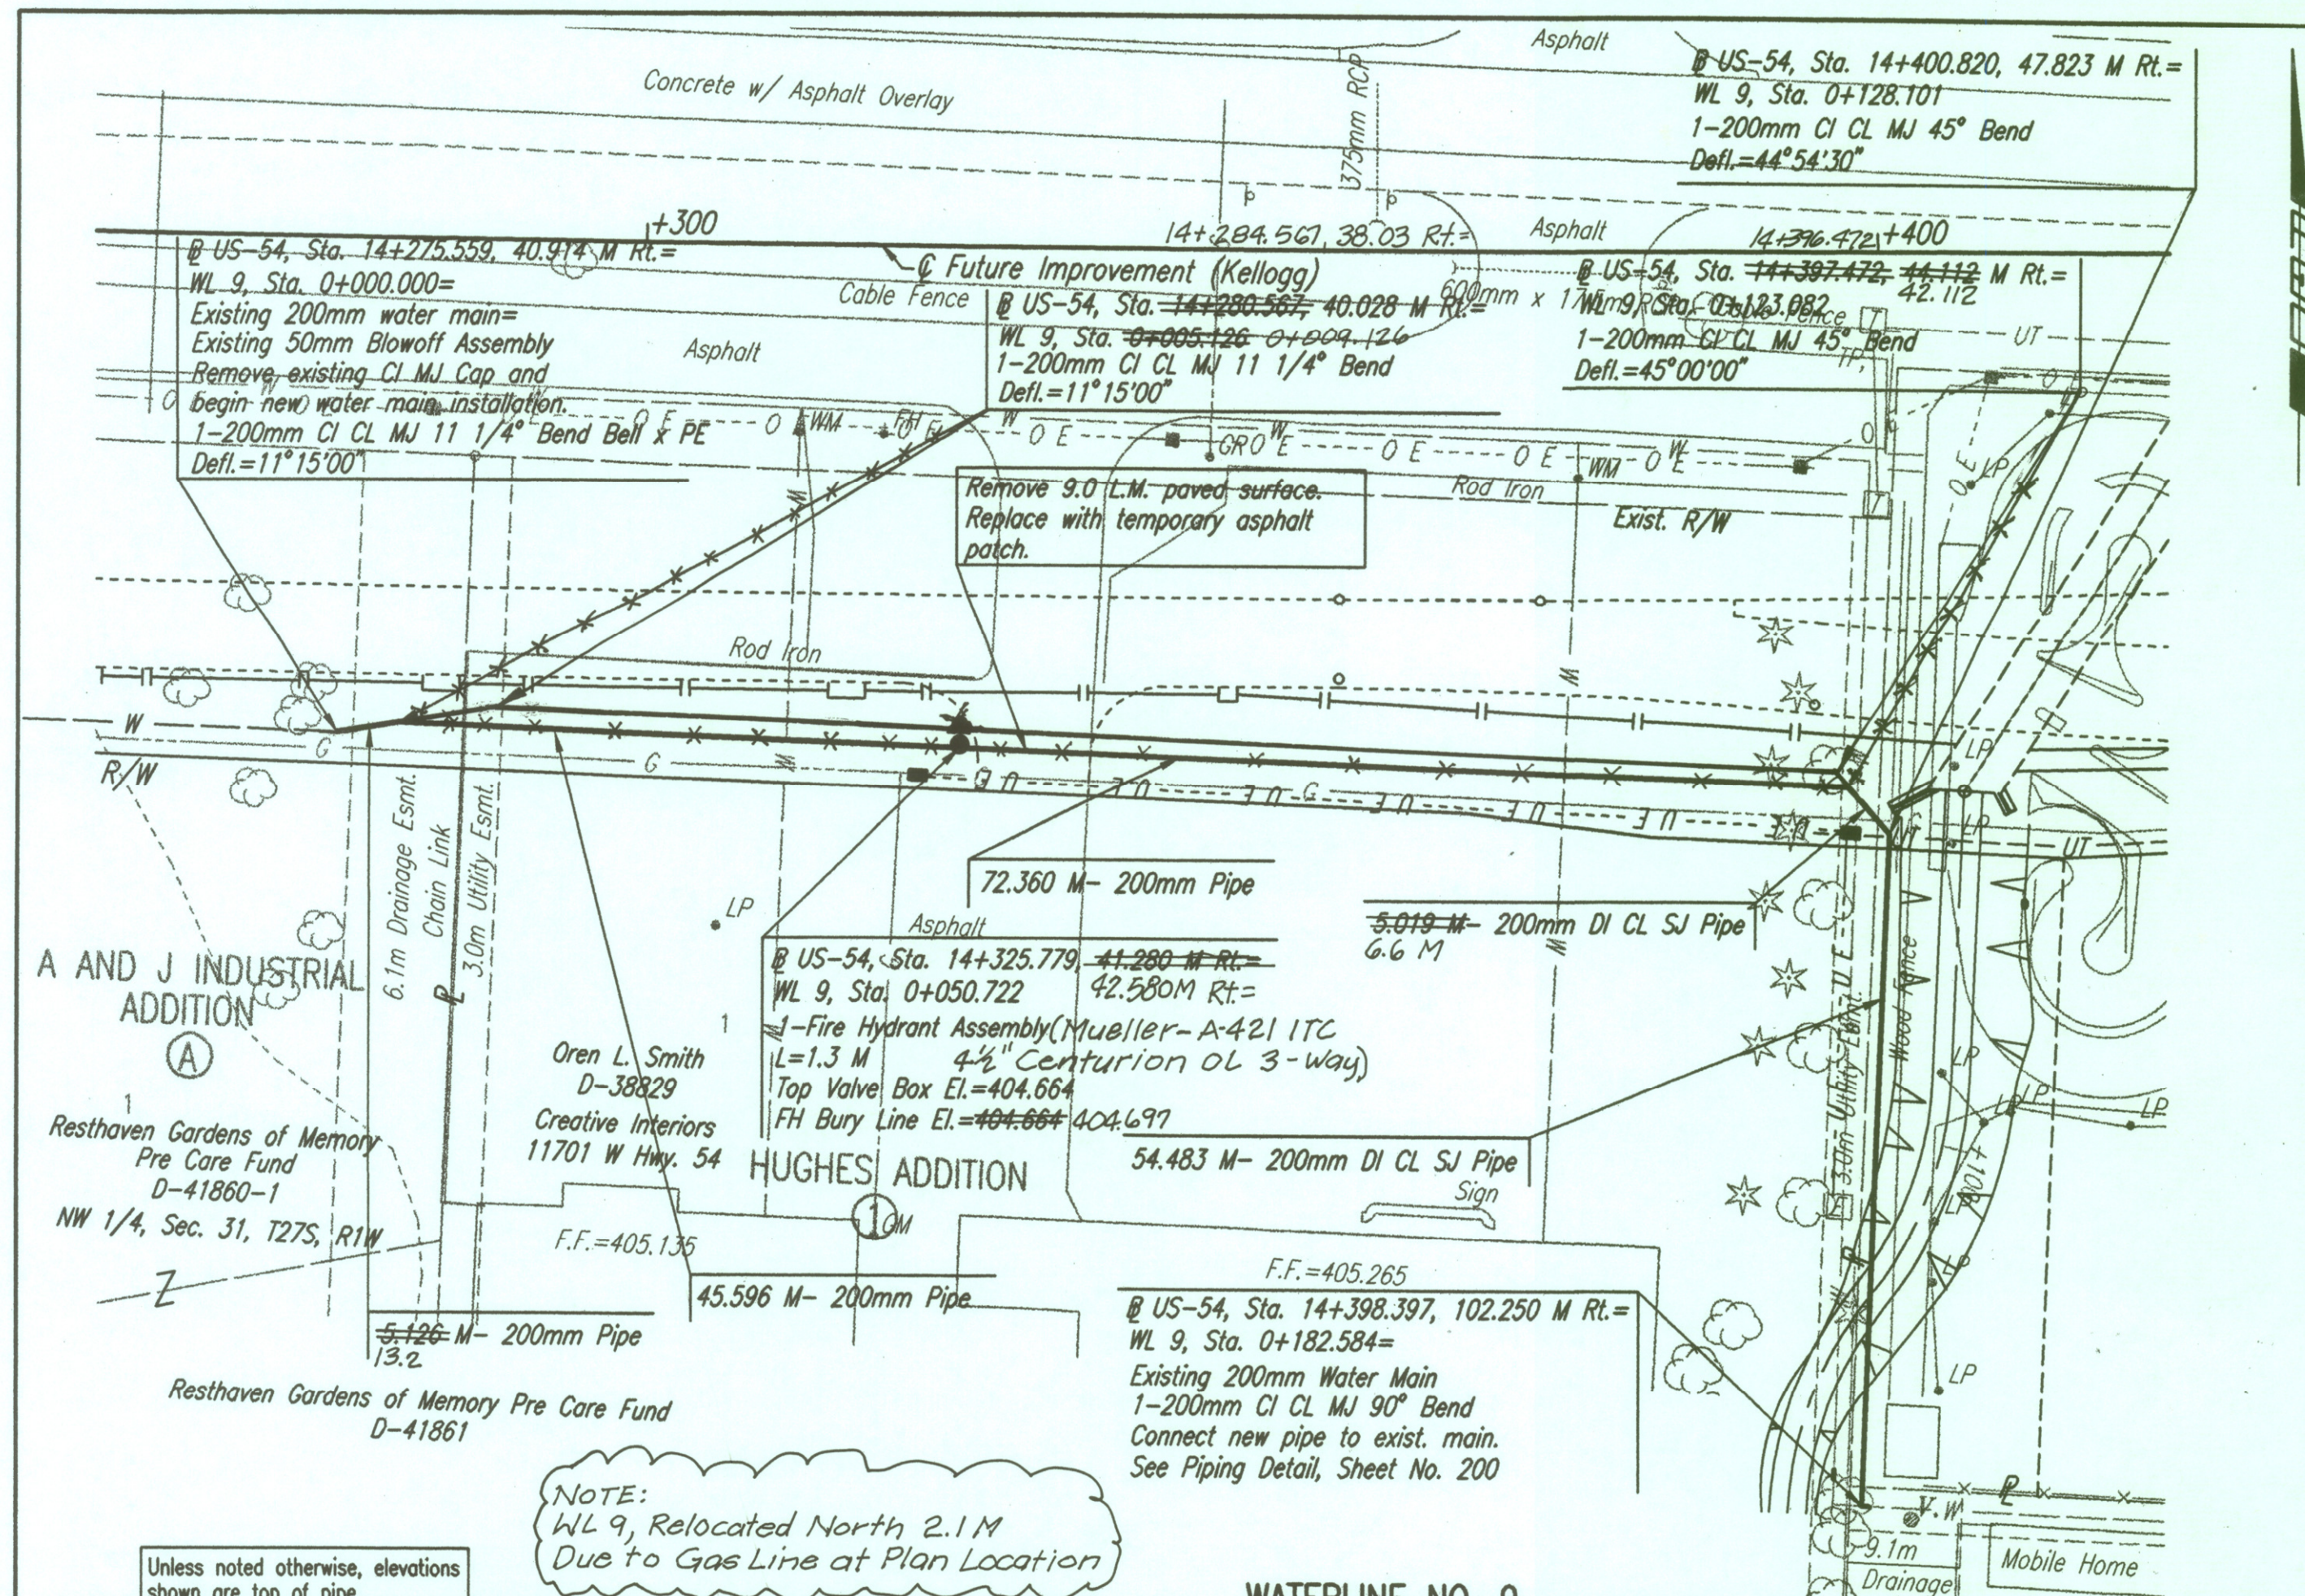

SCALE: 1"=50'
 PLAN: LAT. & LONG. 1:500
 PROFILE: HORIZ. SAME AS ABOVE
 VERT. 1"=50'

FHWA REGION NO.	STATE	PROJECT NO.	YEAR	SHEET NO.	TOTAL SHEETS
7	KANSAS	54-87 K-6657-01	2002	227	1122

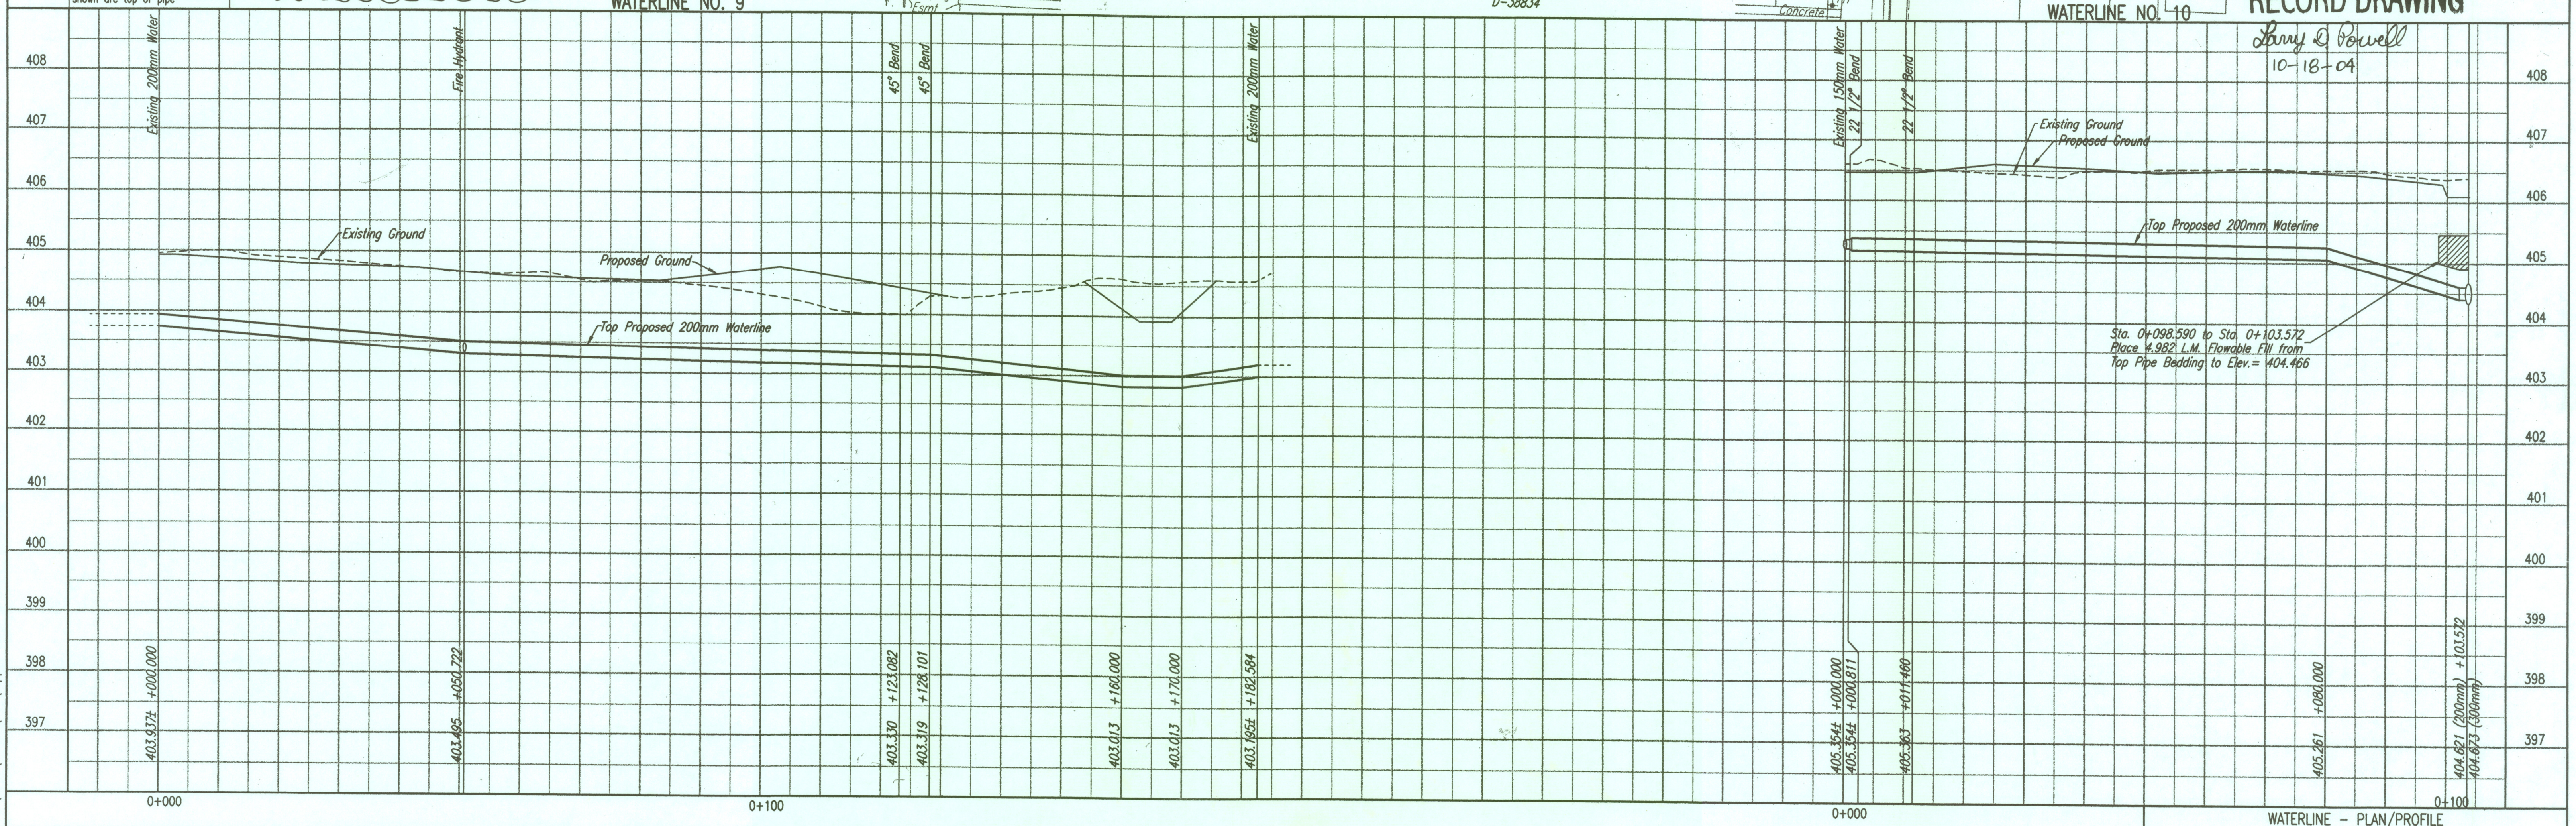

RECORD DRAWING

Larry D. Powell
 10-18-04

WATERLINE - PLAN/PROFILE