


FHWA REGION NO.	STATE	PROJECT NO.	YEAR	SHEET NO.	TOTAL SHEETS
7	KANSAS	54-87 K-6657-01	2002	516A	1122



BR493, PIER#4

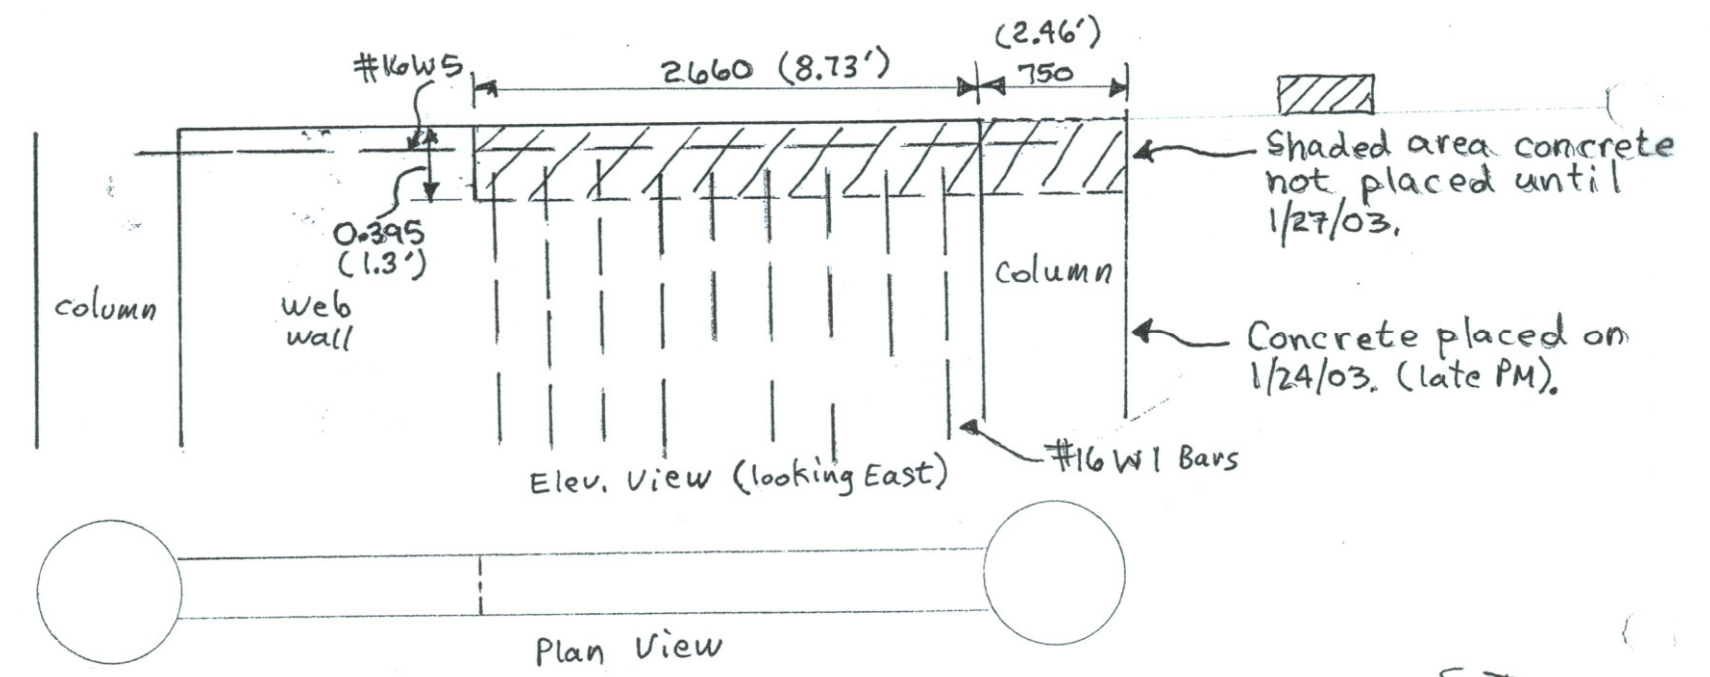

BR# 493 - PIER # 4
(Mainline E.B. Kellogg)

As-Built Sketch
West Kellogg Freeway
(11/13)

RF