


Symbol	Irrigation Equipment
	Toro 570Z 4" Pop-Up Series Spray Heads (1,595 Total)
	Toro 340 Series Rotors (489 Total)
	Toro 1" P-220 Electric Valves (24 Total)
	Toro 1-1/2" P-220 Electric Valves (59 Total)
	Toro 2" P-220 Electric Valves (1 Total)
	Toro 075-SLSC 473 Quick Couplers (4 Total)
	PVC Laterals (Colors & Sizes Vary Per Zone)
	PVC Main Line (Sizes Vary) & 10, 12 & 14 Gauge Wire
	Toro Irrinet Controller - A (1 Total)
	Toro Scorpio Controllers - B, C, D, E & F (5 Total)
	Hunter Mini Clik Rain Sensor - Attached To "A" Irrinet Controller (1 Total)
	Febco 3" RPZ Backflow Prevention Devices & Enclosures (4 Total)
	Point of Connection - 3" Water Meters (4 Total)
	4" Service Valves (4 Total)
	Blowout Ports (4 Total)
	Arad 3" Flow Sensor / Master Valve (4 Total)
	4" Brass Gate Valves (8 Total)

FHWA REGION NO.	STATE	PROJECT NO.	YEAR	SHEET NO.	TOTAL SHEETS
7	KANSAS	54-87 K-6657-01	2002	871J	1122


McCormick

License #: 1840

Note: All Turf Zone Labels Are Black, All Shrub Zone Labels Are Red

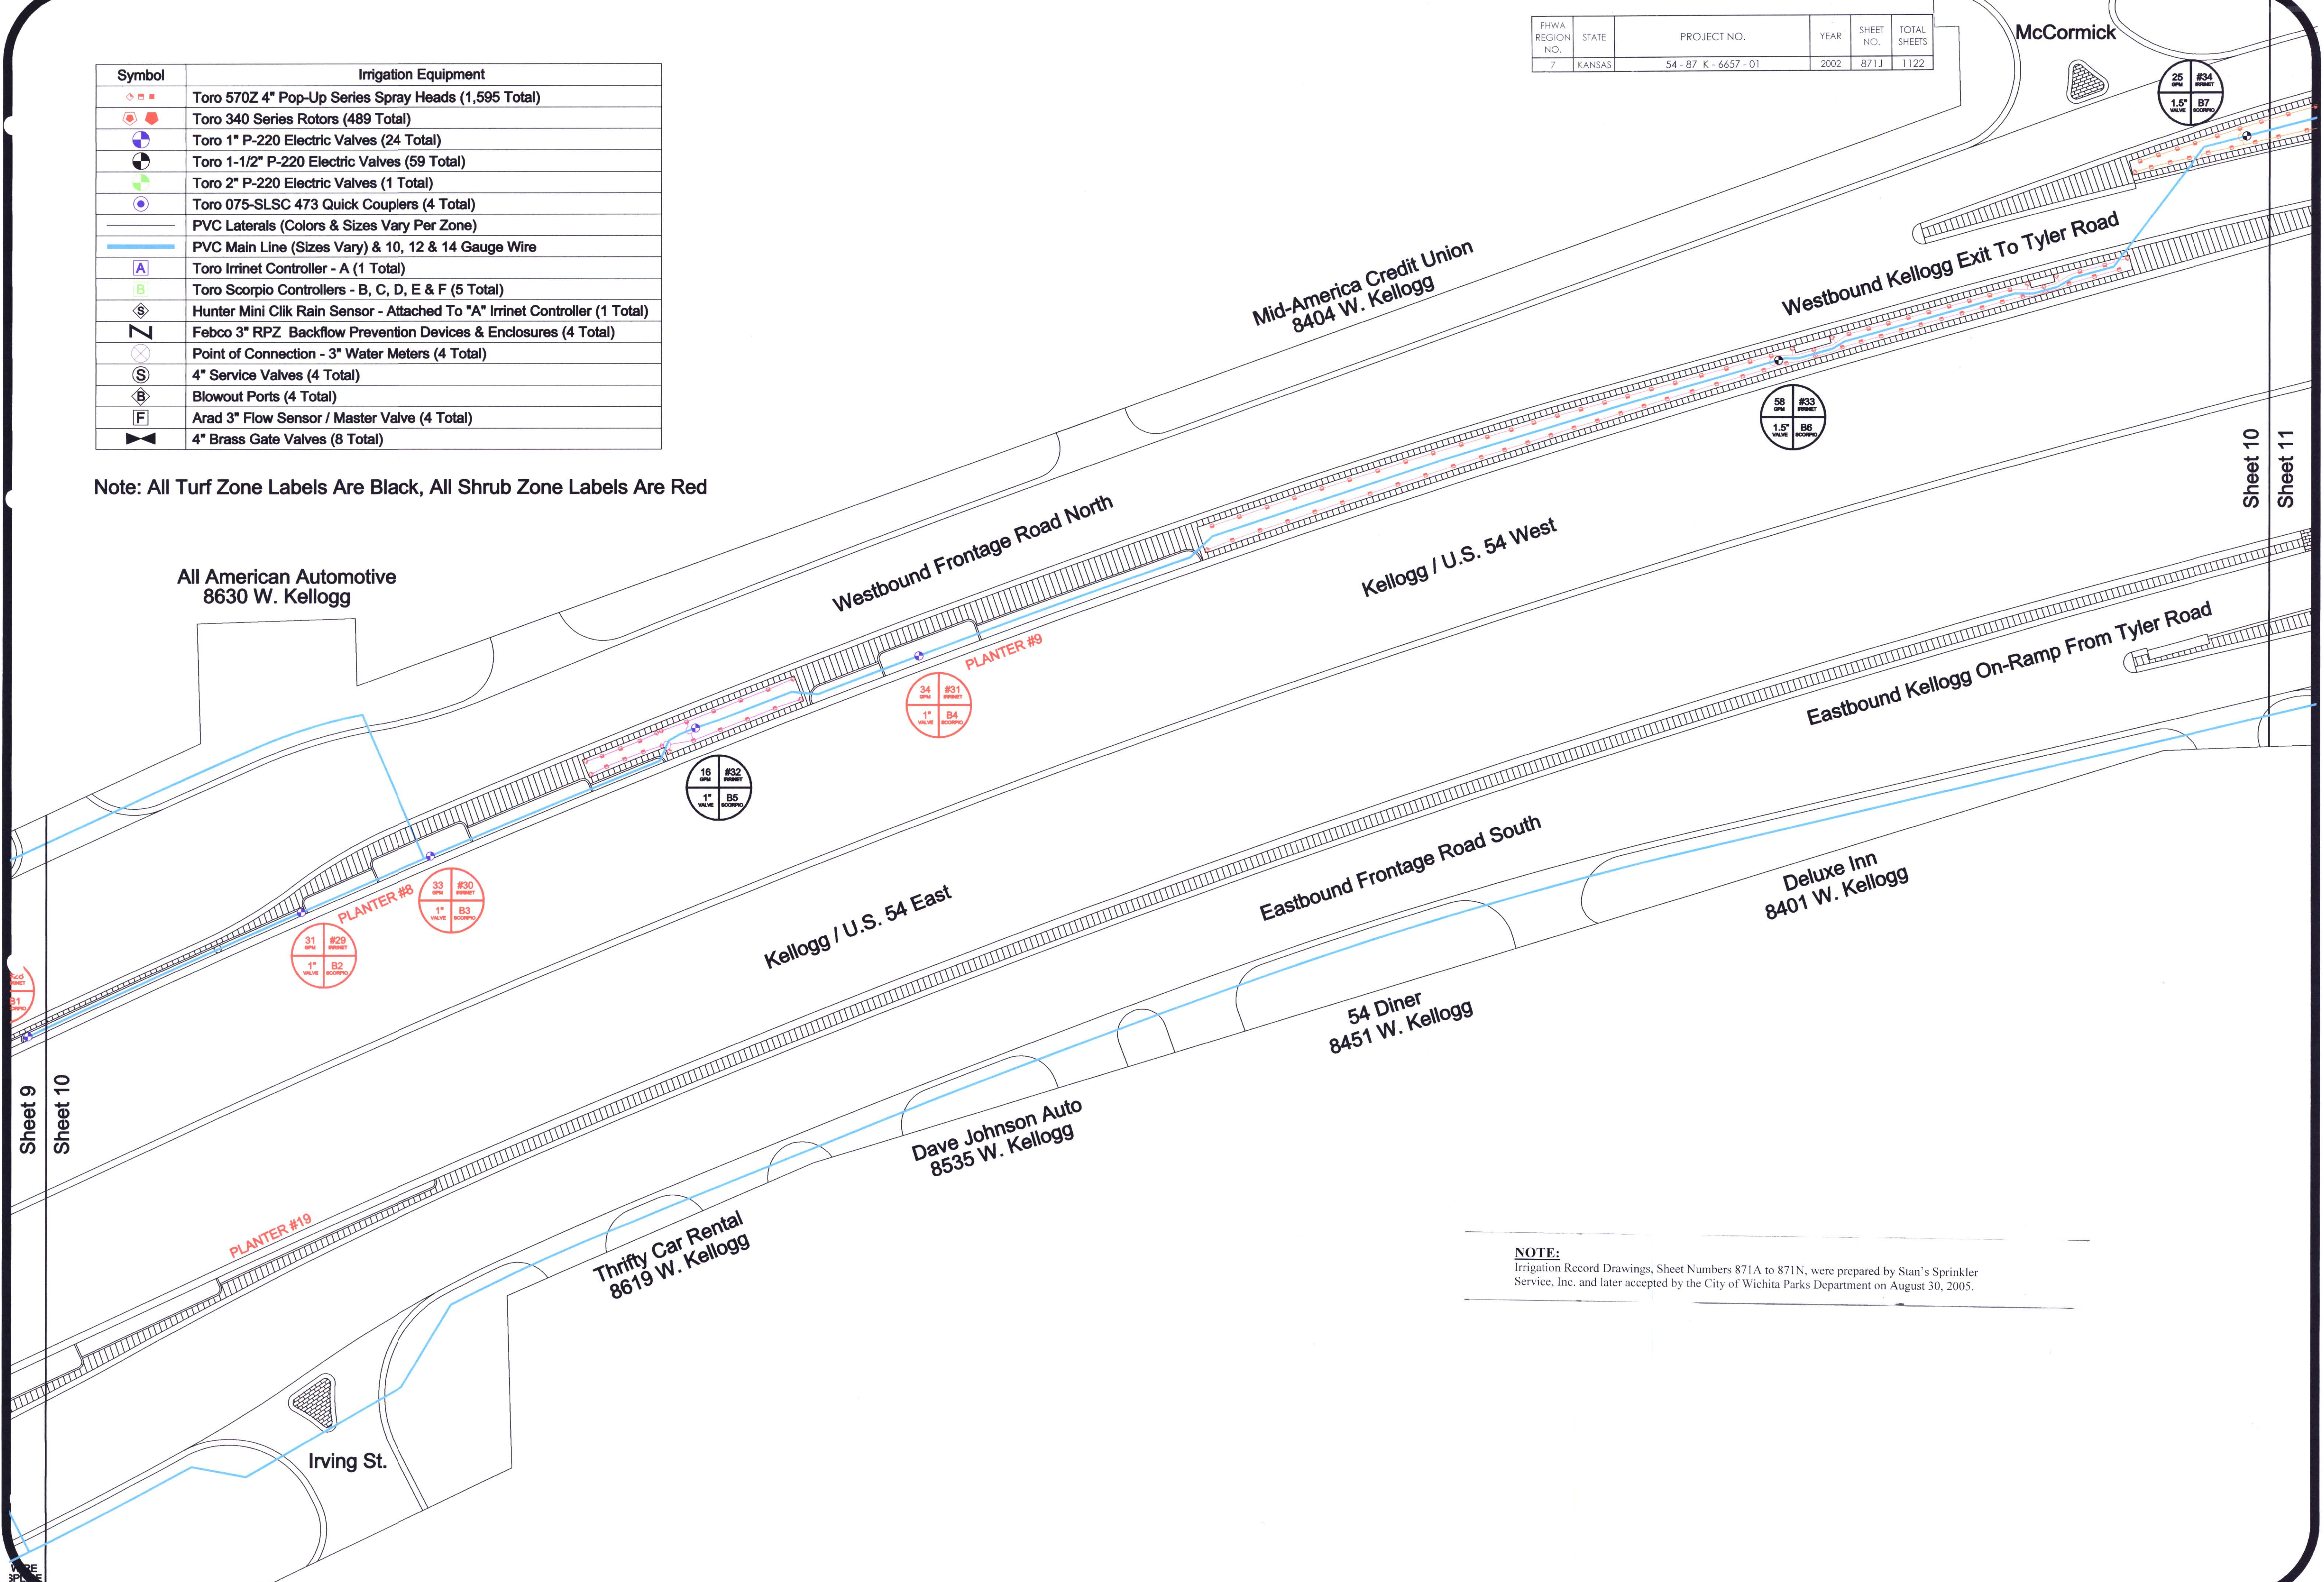

Irrigation As-Built

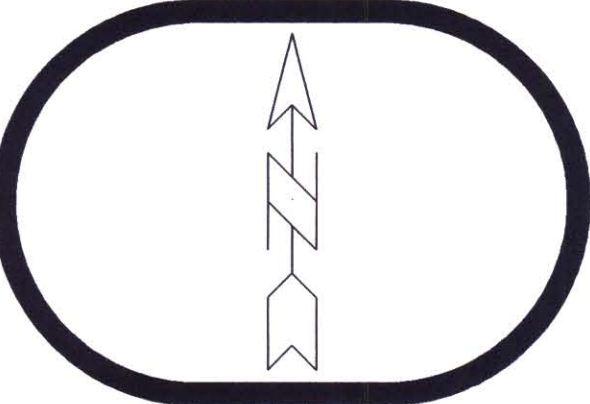

Project:
West Kellogg Flyover: Maize To Tyler - Turf Areas
Sheet 10 of 13

NOTE:
Irrigation Record Drawings, Sheet Numbers 871A to 871N, were prepared by Stan's Sprinkler Service, Inc. and later accepted by the City of Wichita Parks Department on August 30, 2005.

Drawn By:
P.P.
Checked By:
D.D.
Scale:
1"=30'
Date:
8/29/05