



DATE	
BY	
REFERENCES NOTED	
REFERENCES CHECKED	

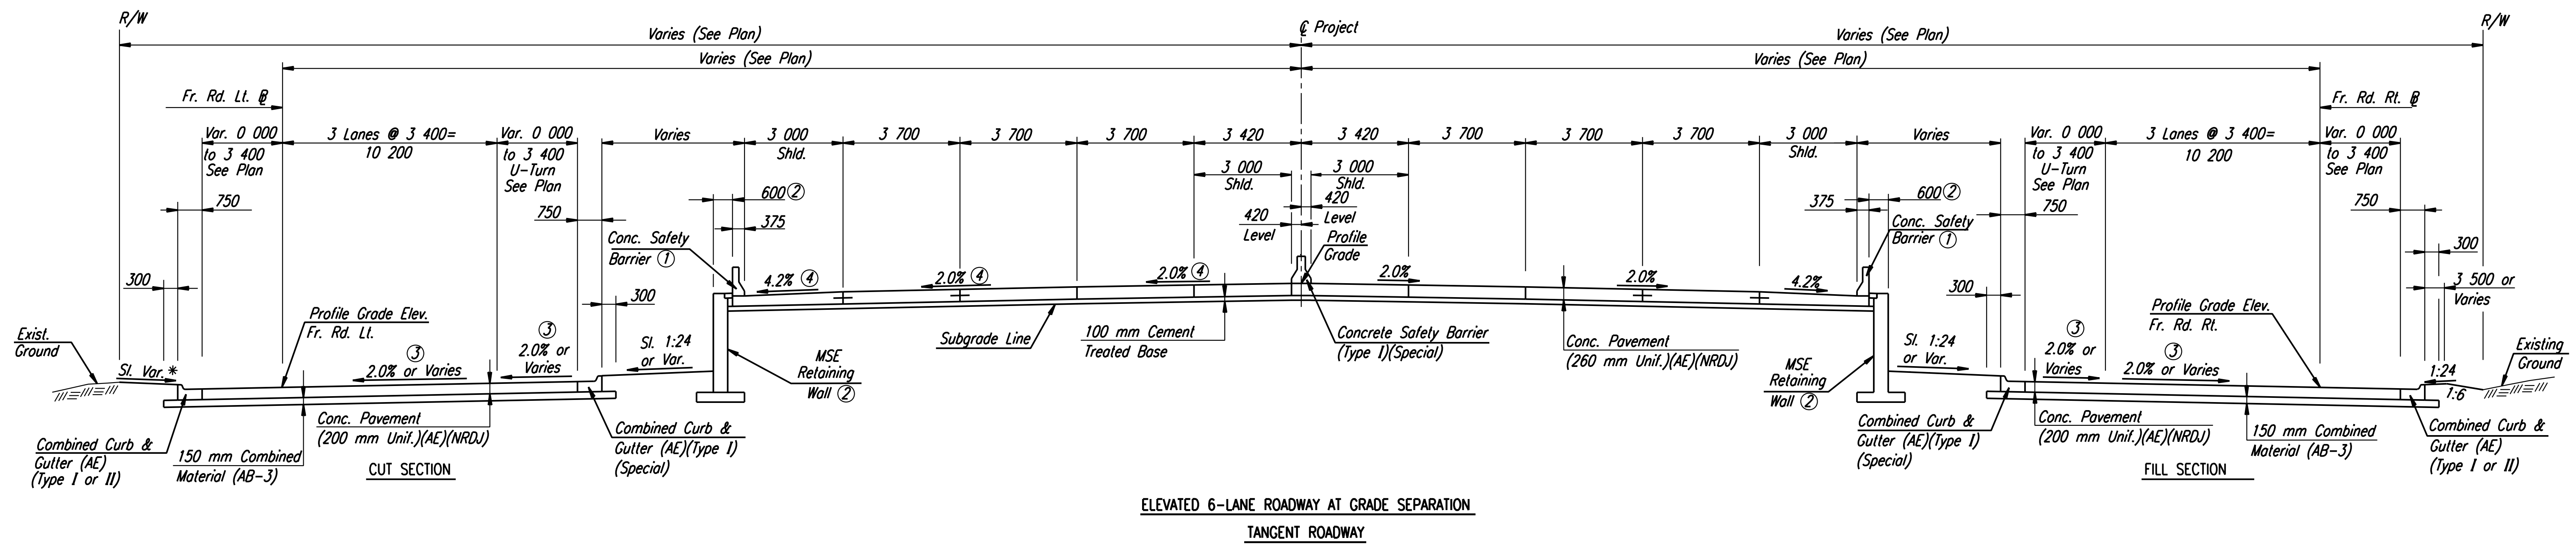

ELEVATED 6-LANE ROADWAY AT GRADE SEPARATION
TANGENT ROADWAY

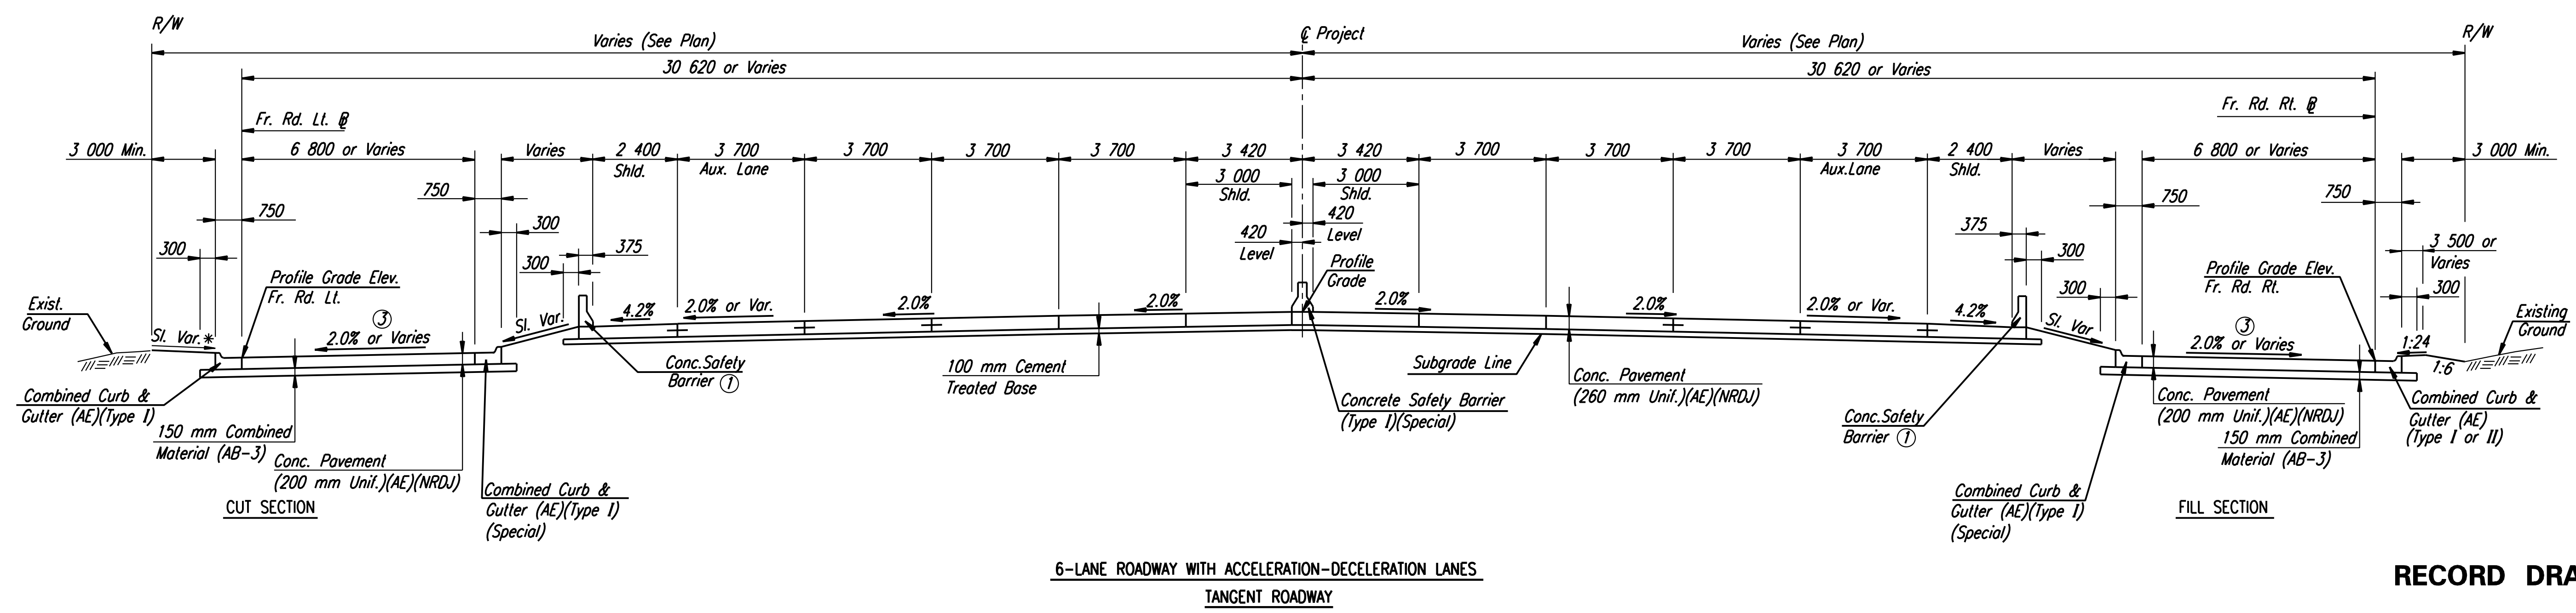

6-LANE ROADWAY WITH ACCELERATION-DECELERATION LANES
TANGENT ROADWAY

- * See Cross-Sections
- ① See Paving Plans for Type of Barrier.
- ② See Plan Sheets for location of retaining walls.
- ③ See Paving Plans for Lane Cross-Slope variations.
- ④ See Kellogg Cross-Slope transition diagrams for Sta. 17+085 to Sta. 17+500.

RECORD DRAWING

No.	Revisions	By	Date
CITY OF WICHITA			
KELLOGG TYPICAL SECTIONS			
SEDGWICK COUNTY			
Professional Engineering Consultants, P.A.			
303 S. TOPEKA • WICHITA, KANSAS 67202 316-262-2691 • FAX 316-262-3003			
Designed by	RCH	Checked by	WDH
Drawn by	JGP	Date	April, 2002
		Job No.	97362

DSNR: WDH OPER: JGP SCALE: 1:100
 I:/1997/97362/As-Builts/dgn's/prop/typ.dgn Last Rev: 7-27-07 By: gdr