



DATE	
BY	
REFERENCES NOTED	
REFERENCES CHECKED	

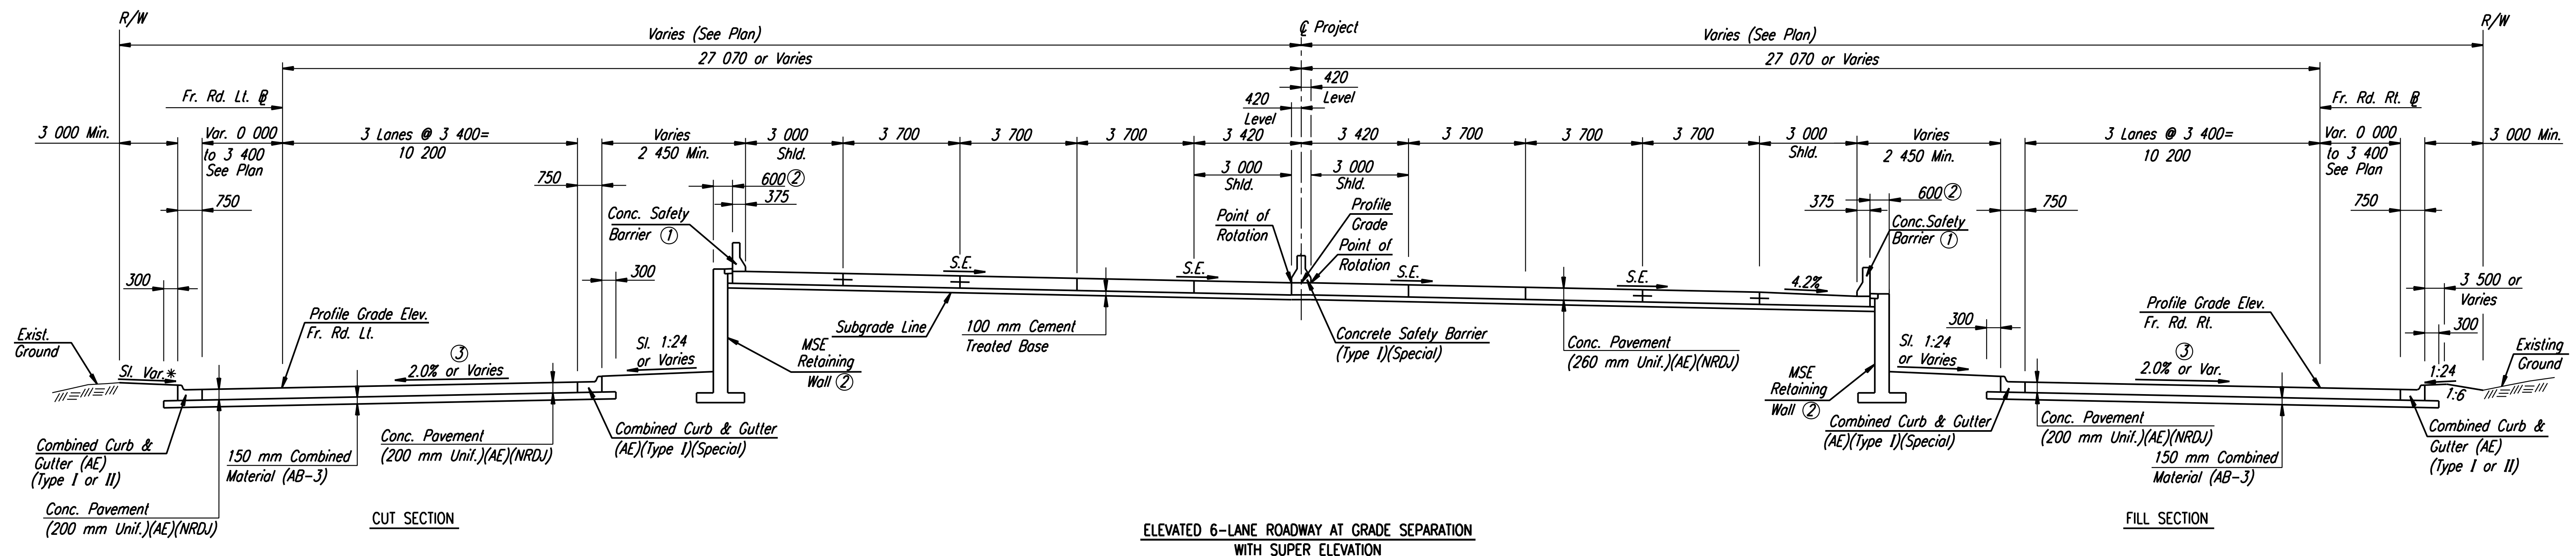

ELEVATED 6-LANE ROADWAY AT GRADE SEPARATION WITH SUPER ELEVATION

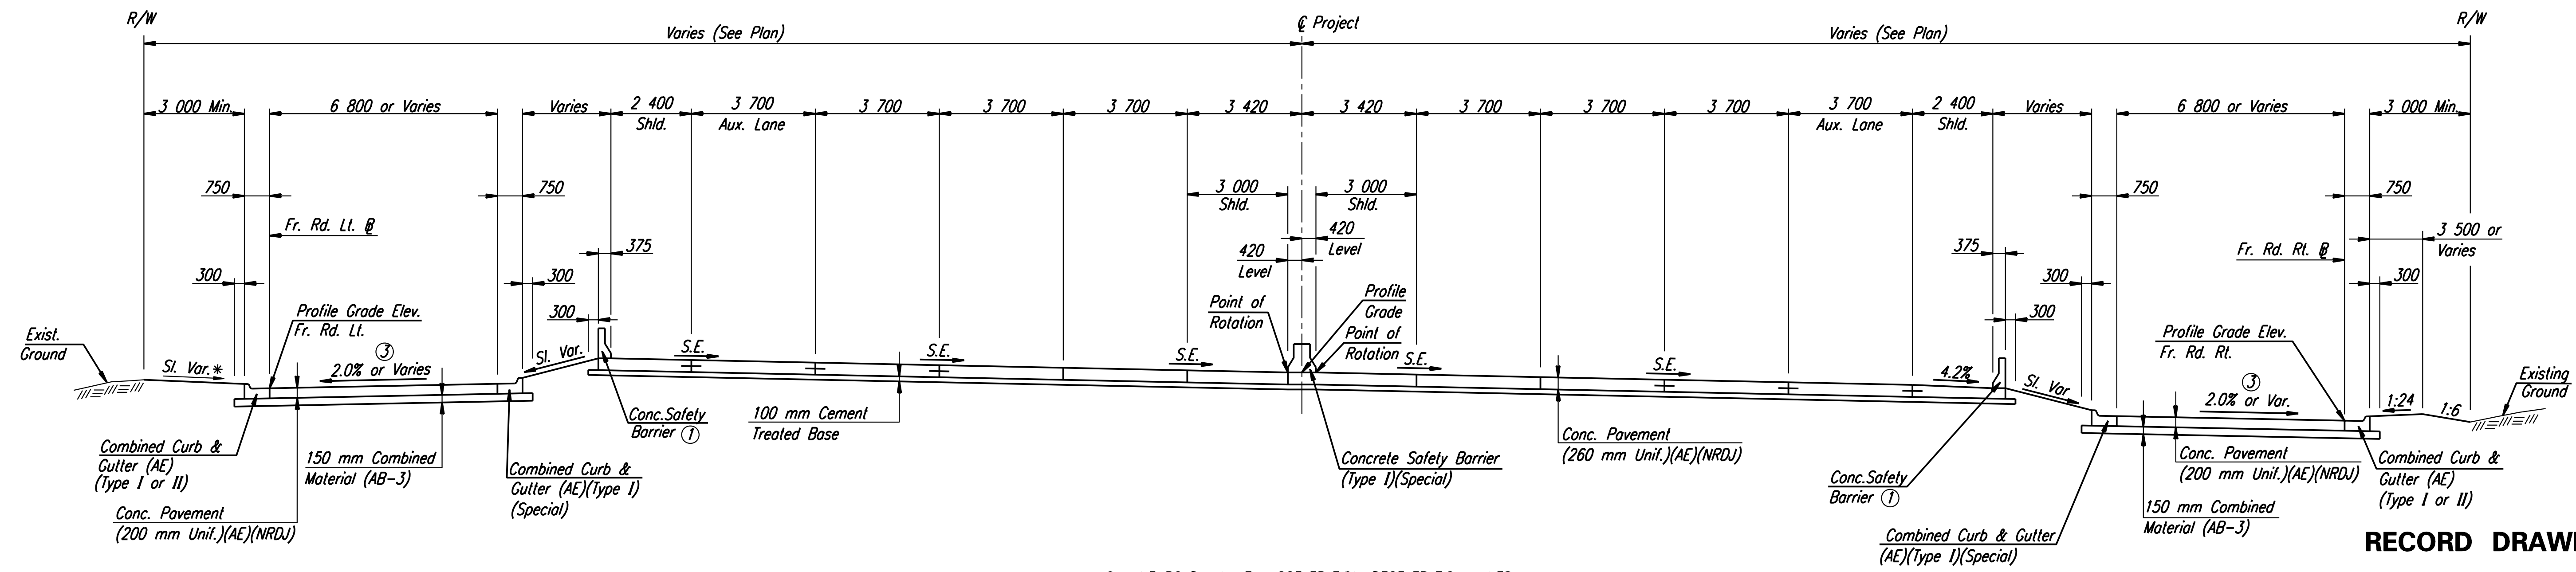

6-LANE ROADWAY WITH ACCELERATION-DECELERATION LANES SUPER ELEVATED ROADWAY

RECORD DRAWING

- * See Cross-Sections
- ① See Paving Plans for Type of Barrier.
- ② See Plan Sheets for location of retaining walls.
- ③ See Paving Plans for Lane Cross-Slope variations.

No.	Revisions	By	Date

CITY OF WICHITA
**KELLOGG
TYPICAL SECTIONS**
SEDGWICK COUNTY

Professional Engineering Consultants, P.A.
303 S. TOPEKA • WICHITA, KANSAS 67202
316-262-2691 • FAX 316-262-3003

Designed by	RCH	Checked by	WDH
Drawn by	JGP	Date	April, 2002
		Job No.	97362

DSNR: WDH OPER: JGP SCALE: 1:100
 I:/1997/97362/As-Builts/dgn's/Sh 5-propotyp.dgn Last Rev: 7-27-07 By: gdr