
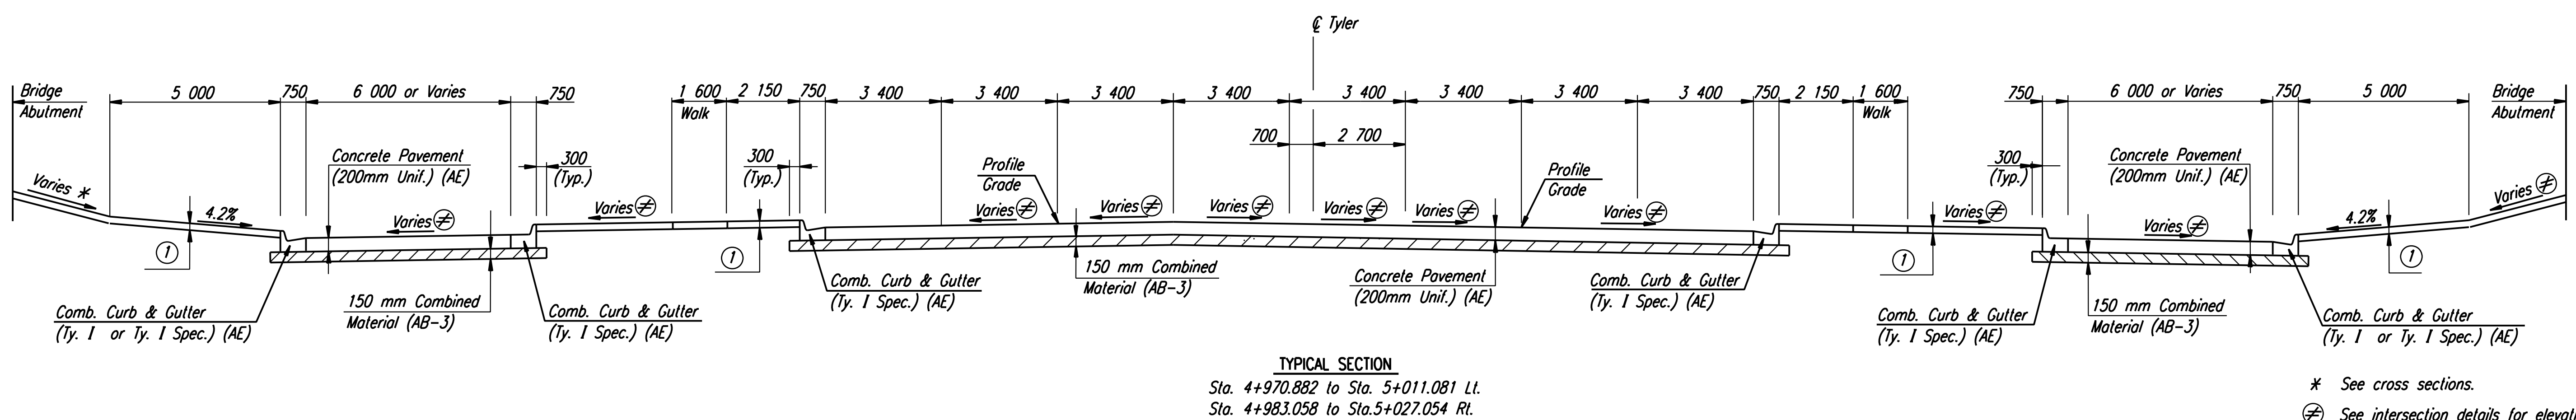
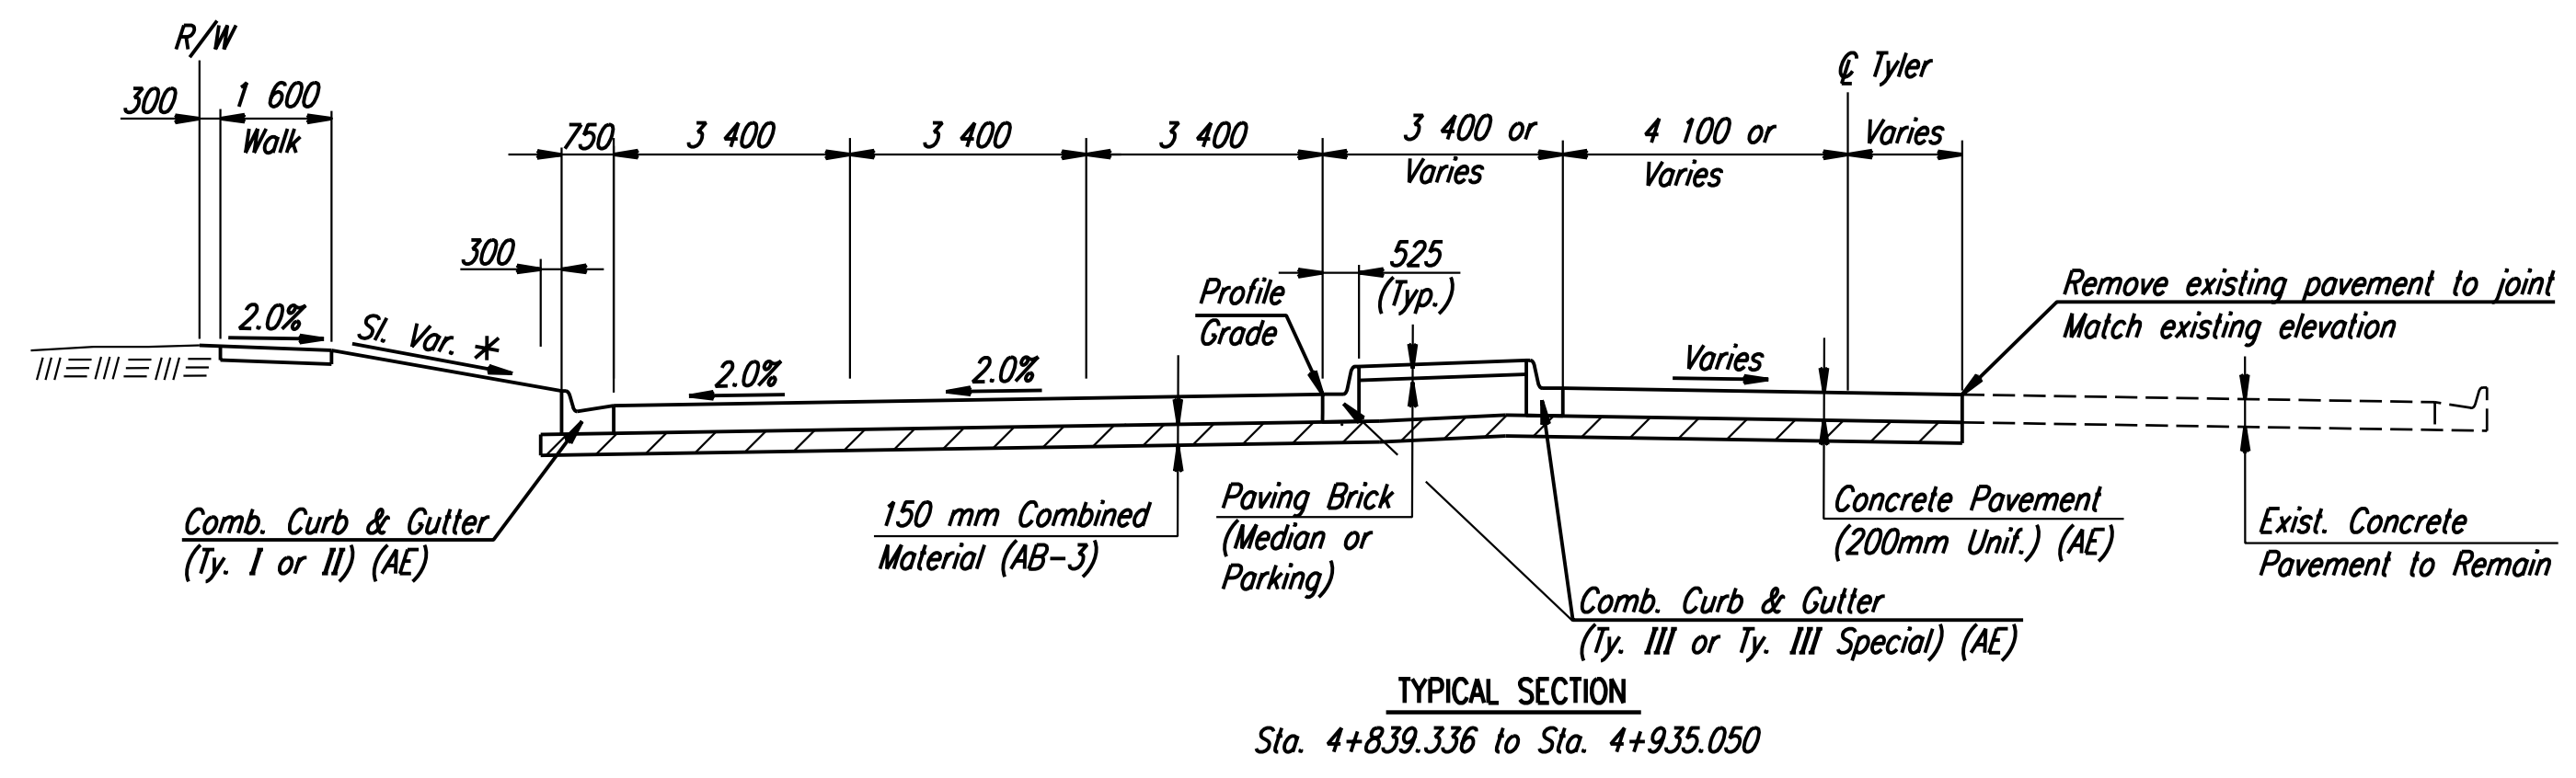


FHWA REGION NO.	STATE	PROJECT NO.	YEAR	SHEET NO.	TOTAL SHEETS
7	KANSAS	54-87 K-6657-01	2002	9	1122

DATE	
BY	
REFERENCES NOTED	
REFERENCES CHECKED	

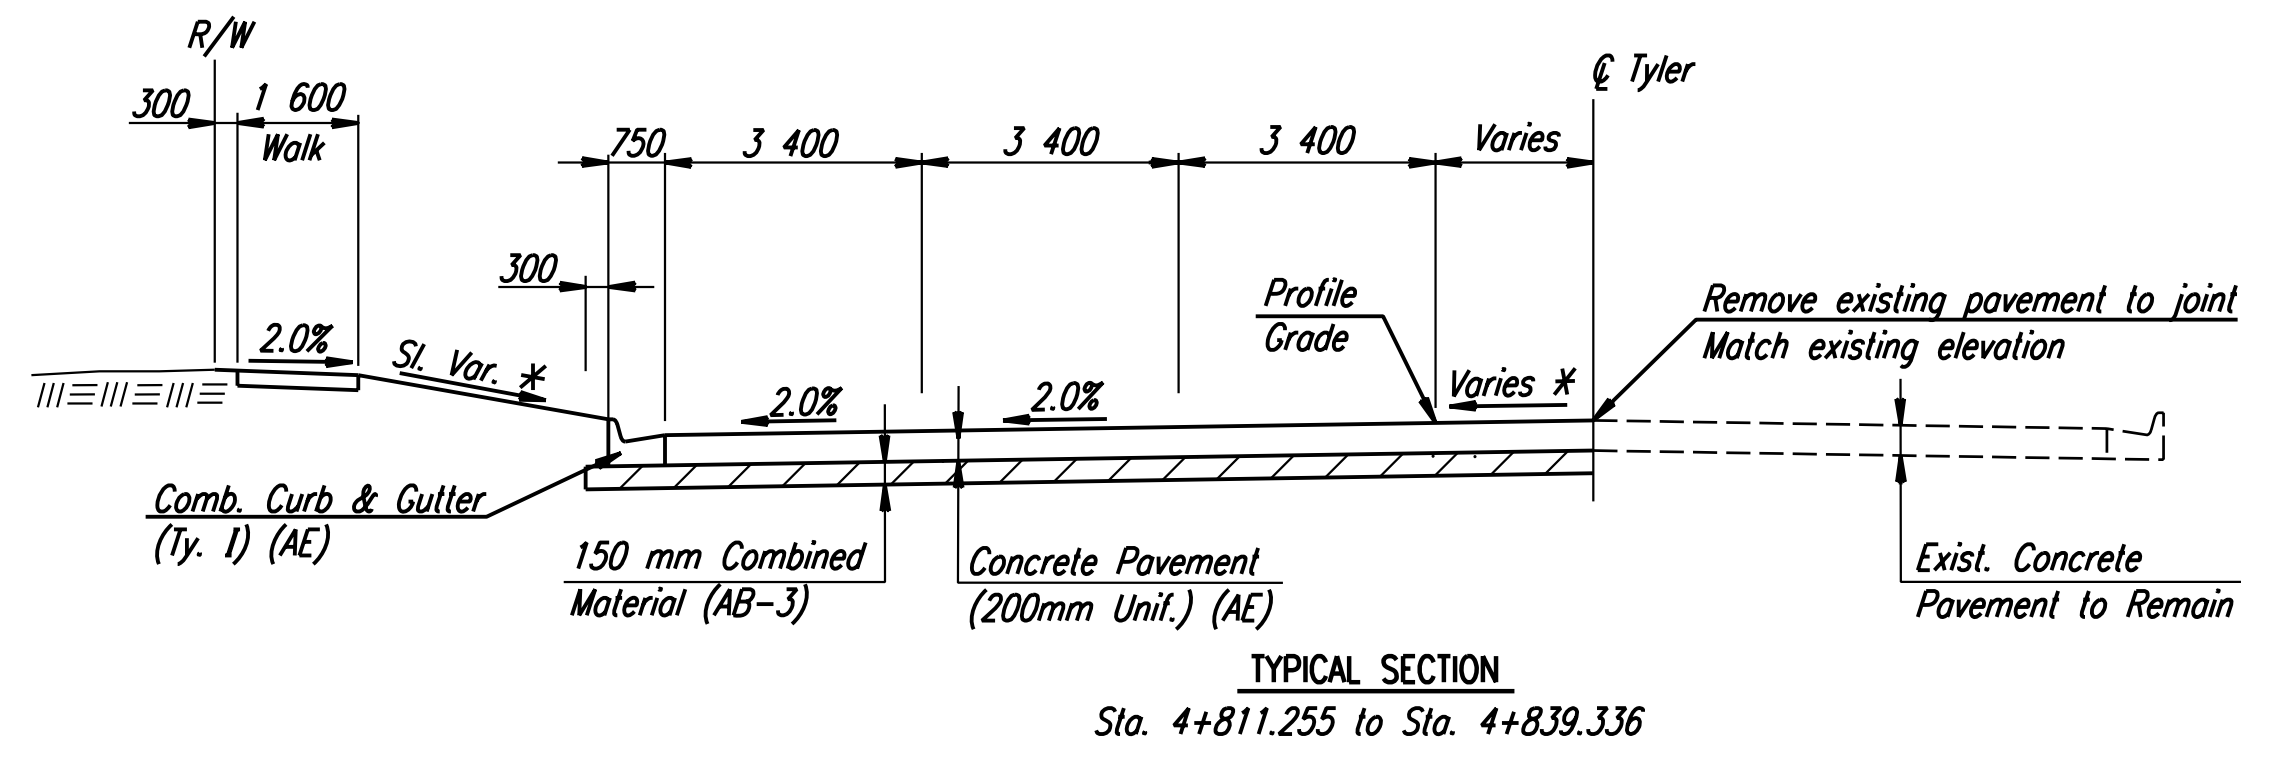

- \* See cross sections.
- ⊕ See intersection details for elevation.
- ① See Landscape Plans for Surfacing Type.

DSNR: RCH OPER: JGP SCALE: 1:100  
 i:/47/97362/As-Built/dgn/s/tyler/tyltyp.dgn Last Rev: 7-27-07 By: gdr

**RECORD DRAWING**

No.	Revisions	By	Date
CITY OF WICHITA <b>TYPICAL SECTIONS</b> <b>TYLER ROAD</b> SEDGWICK COUNTY			
<b>Professional Engineering Consultants, P.A.</b> 303 S. TOPEKA • WICHITA, KANSAS 67202 316-262-2691 • FAX 316-262-3003			
Designed by	RCH	Checked by	WDH
Drawn by	JGP	Date	April, 2002 Job No. 97362