
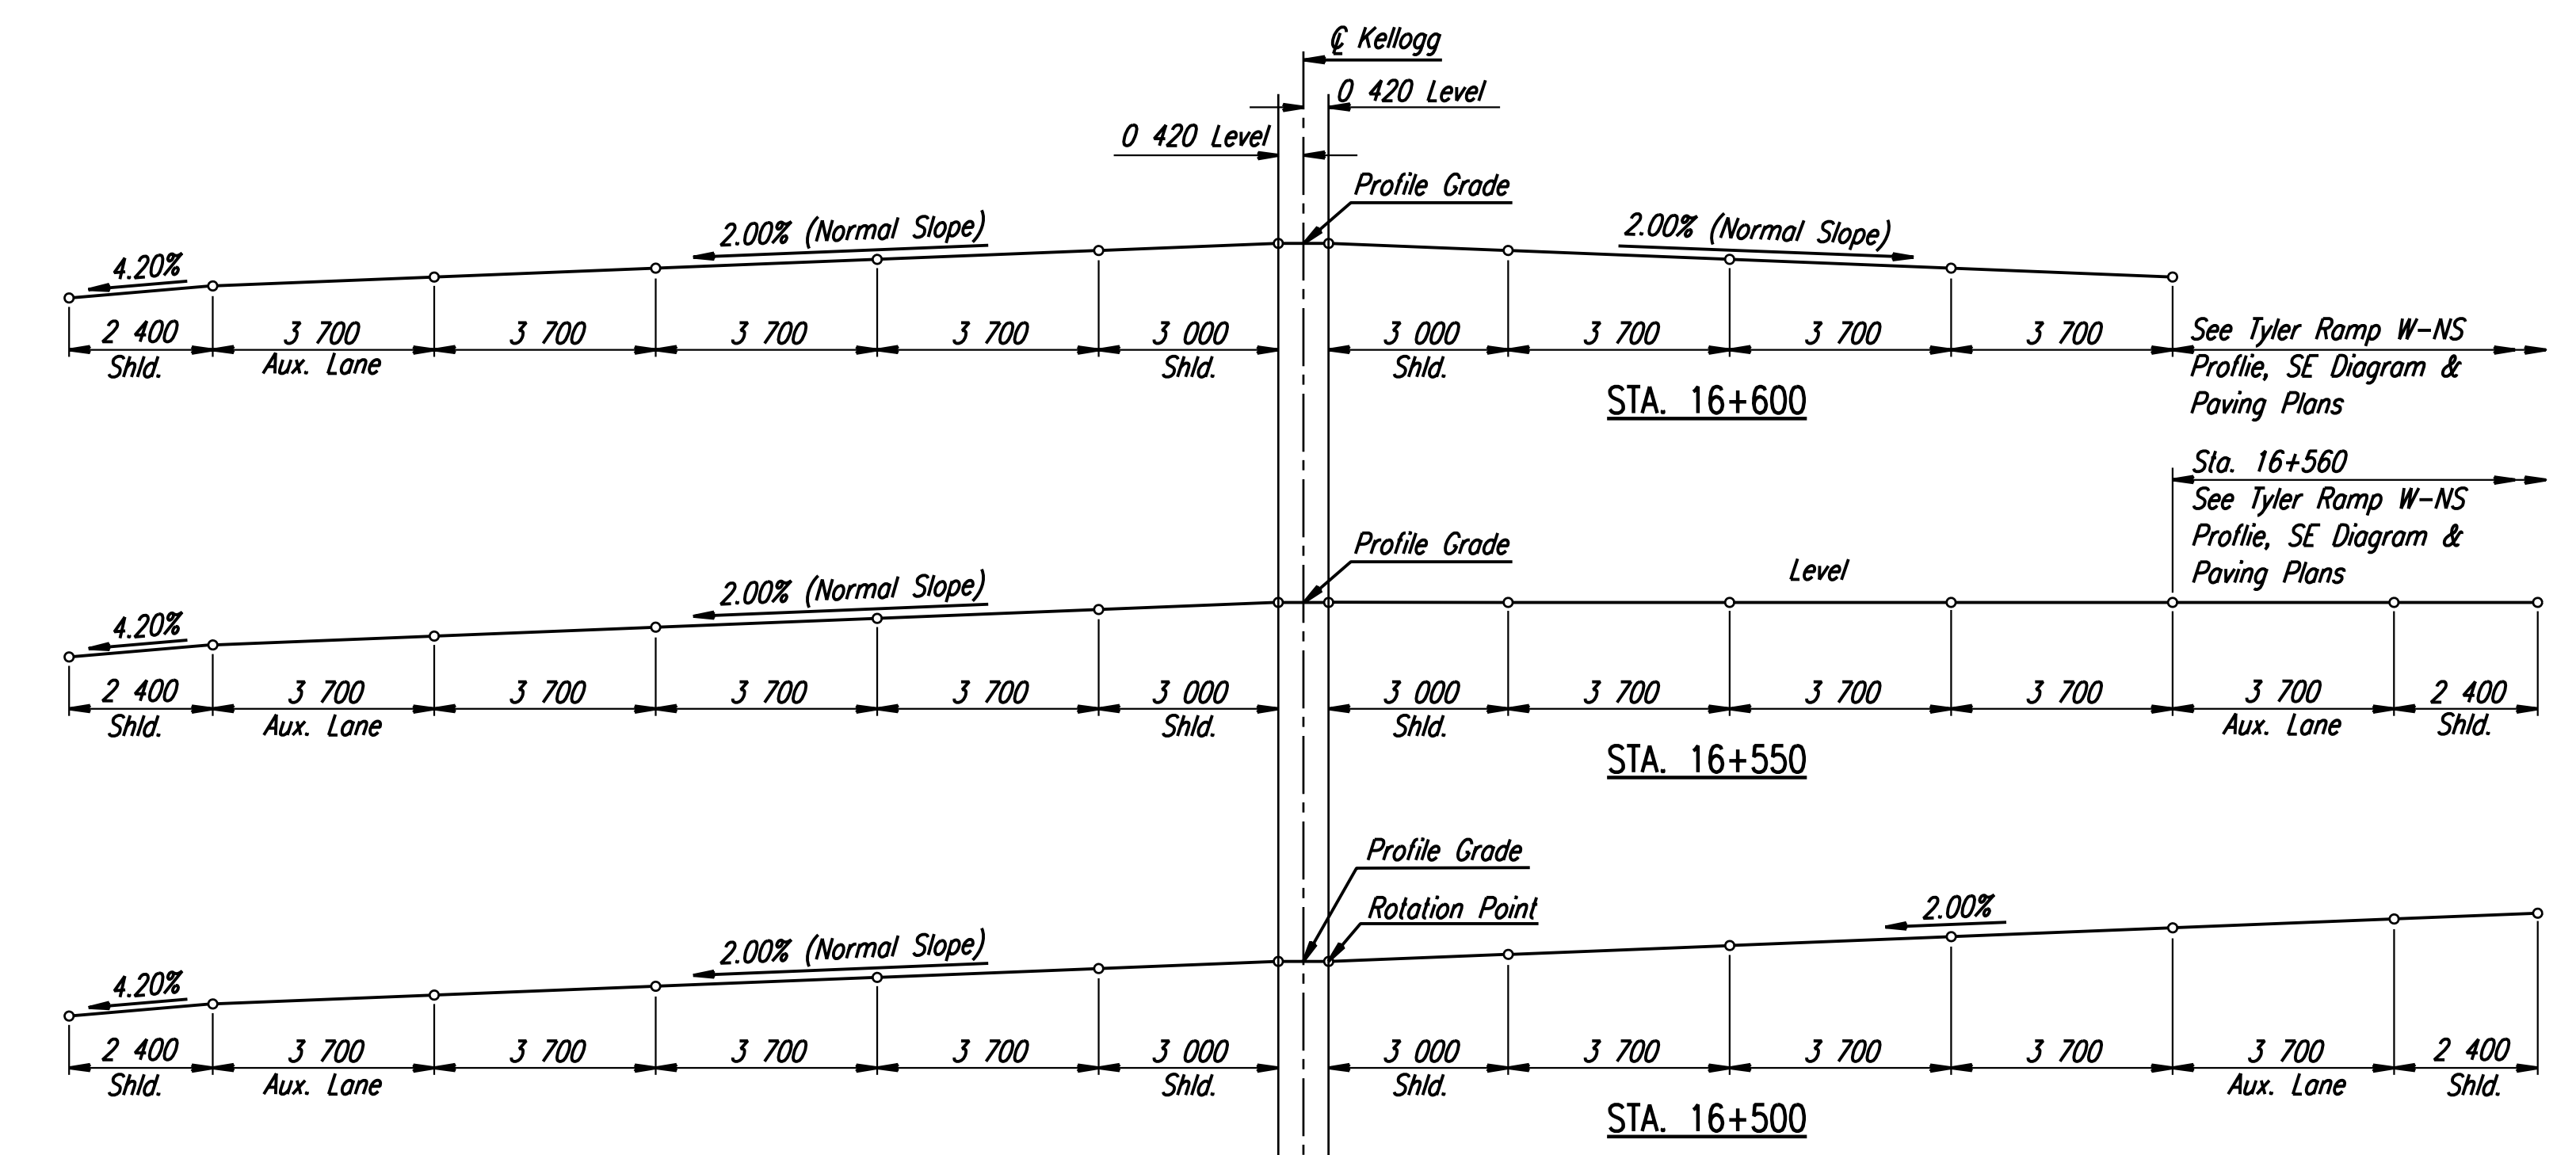
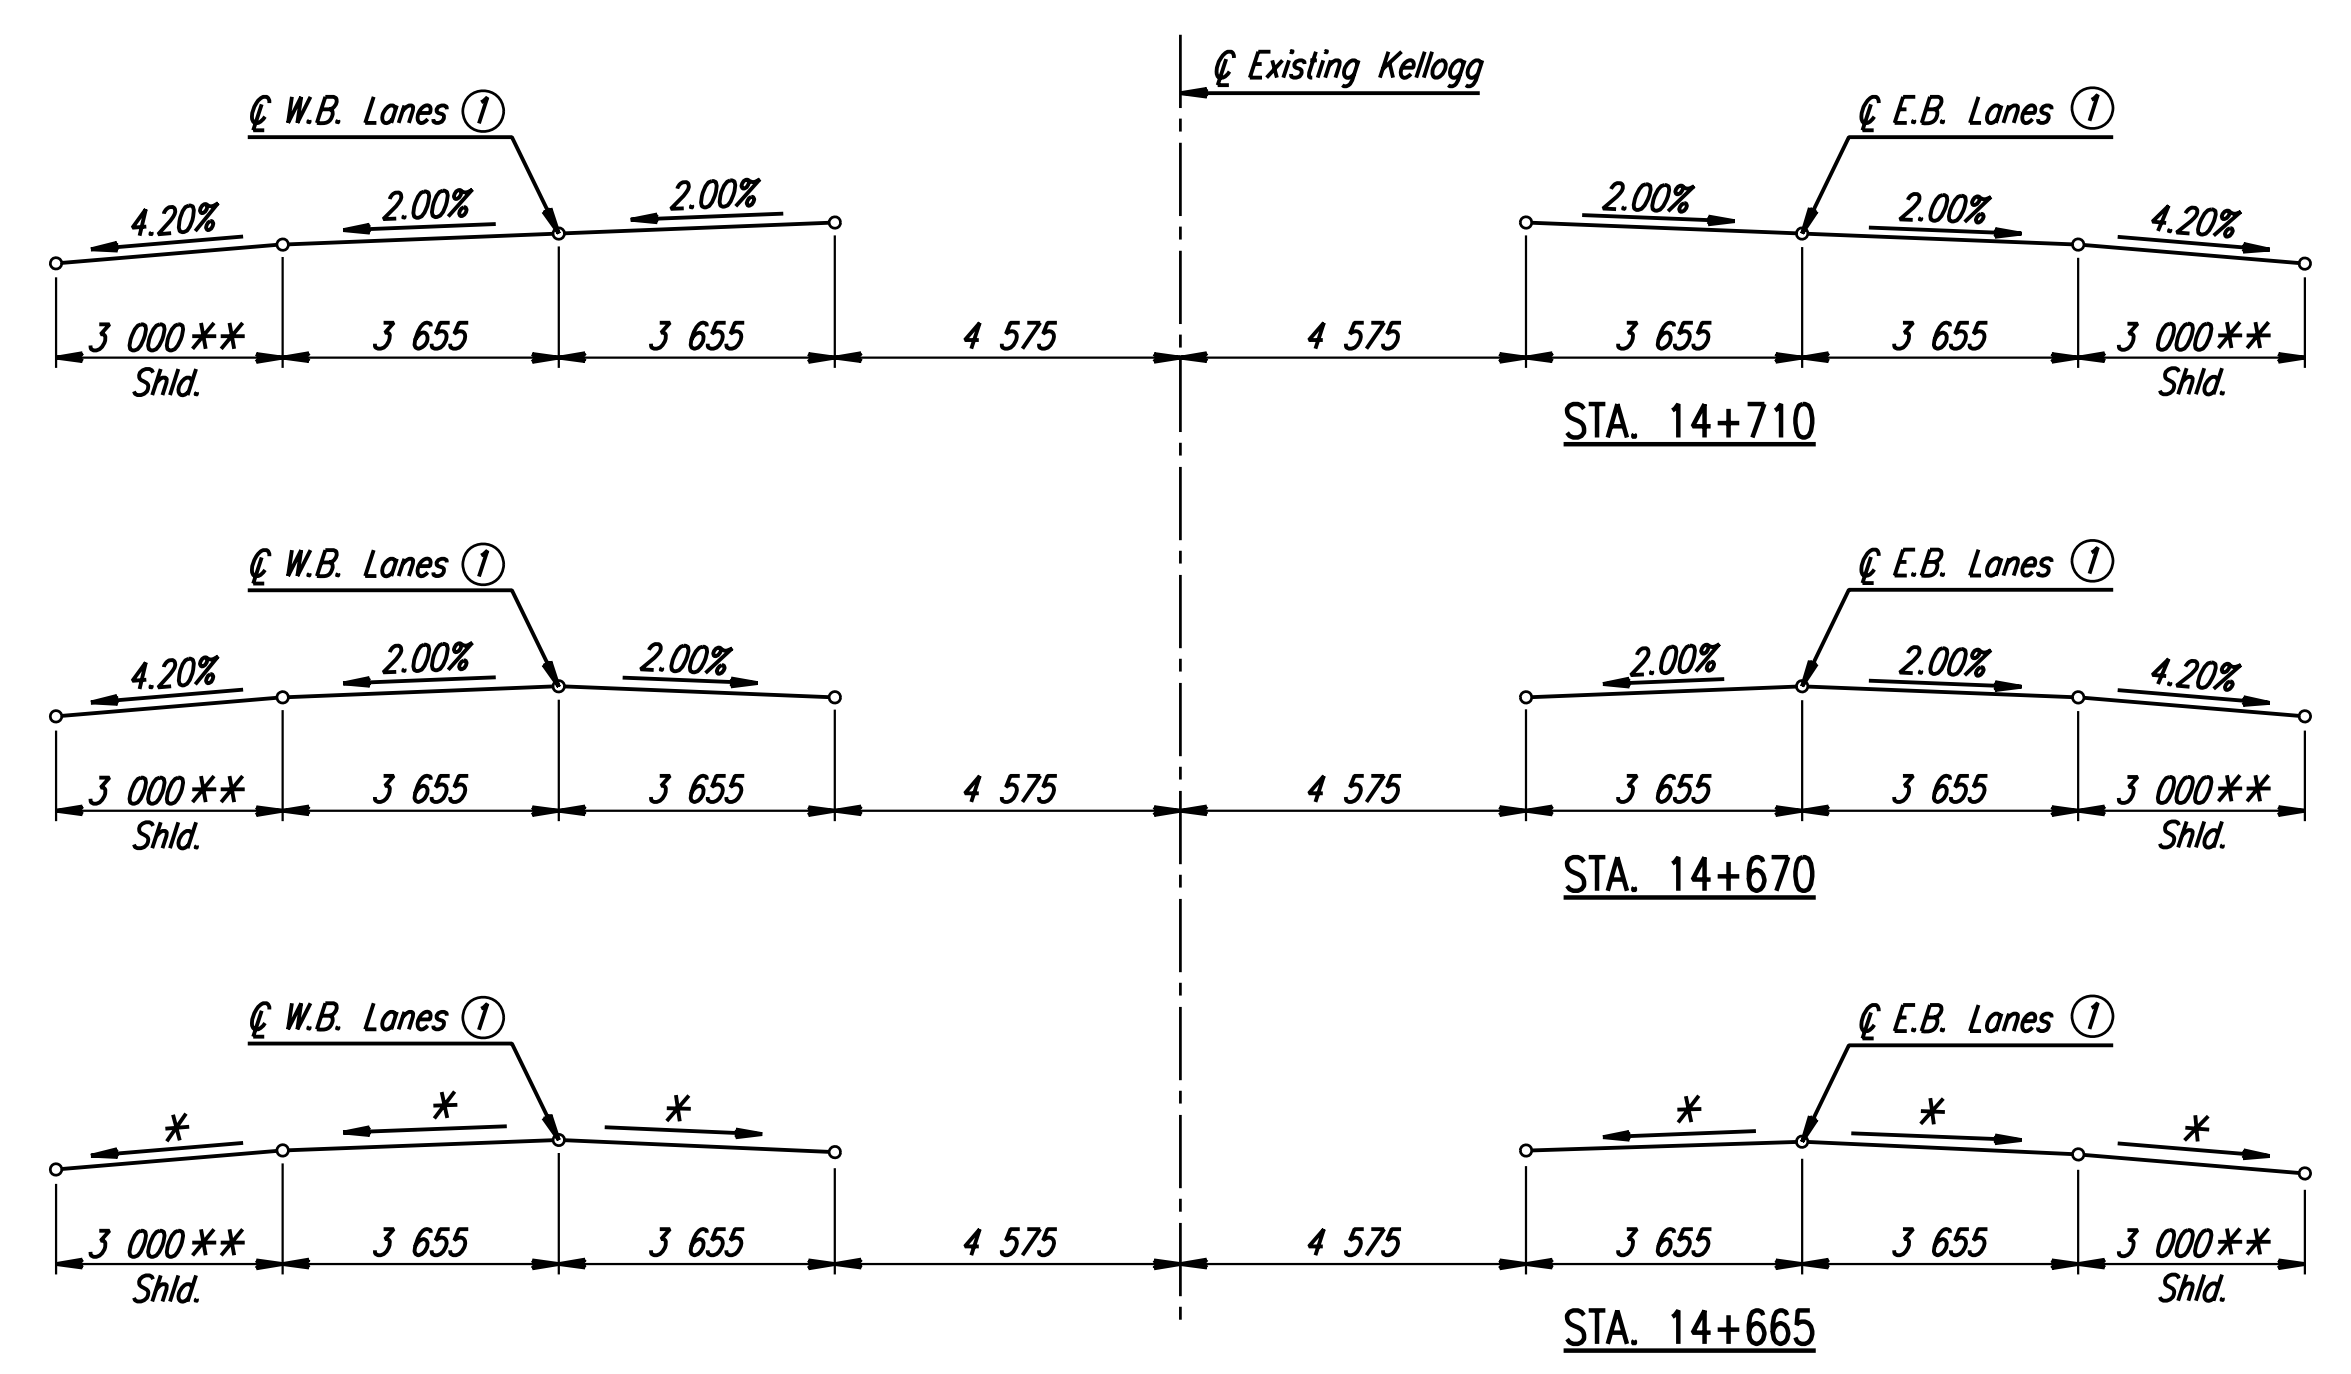
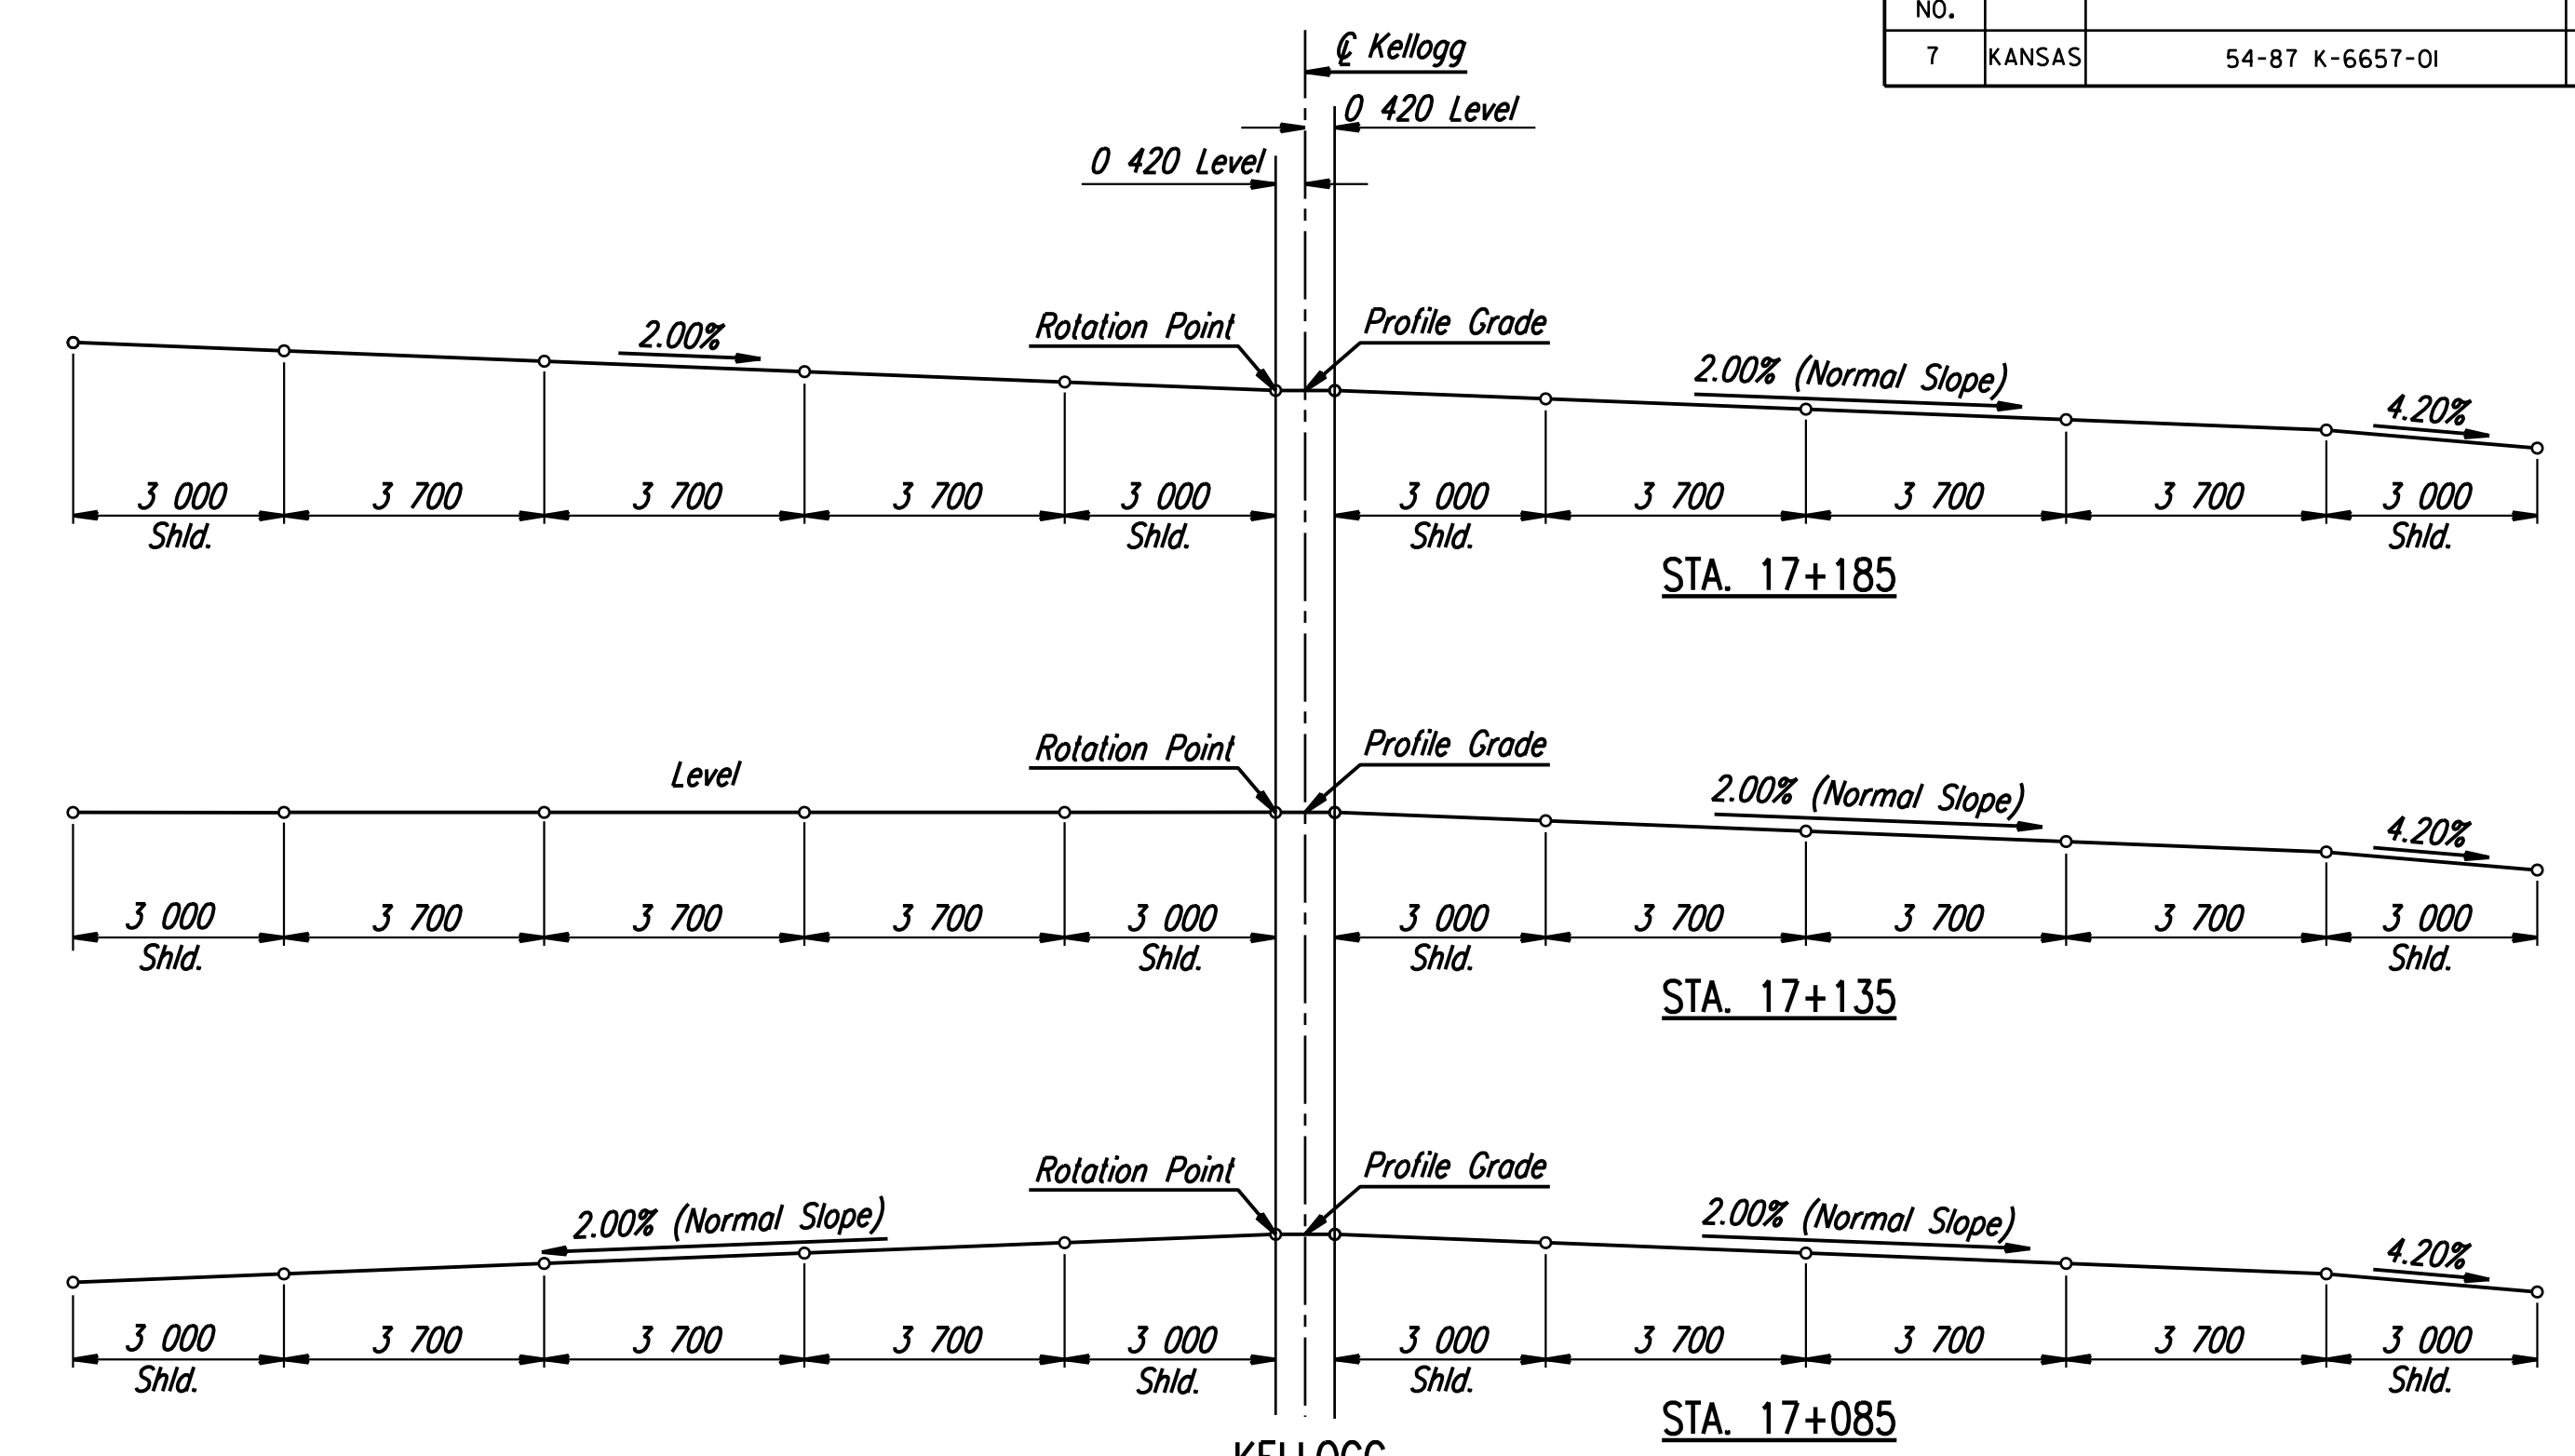


DATE	
BY	
REFERENCES NOTED	
REFERENCES CHECKED	

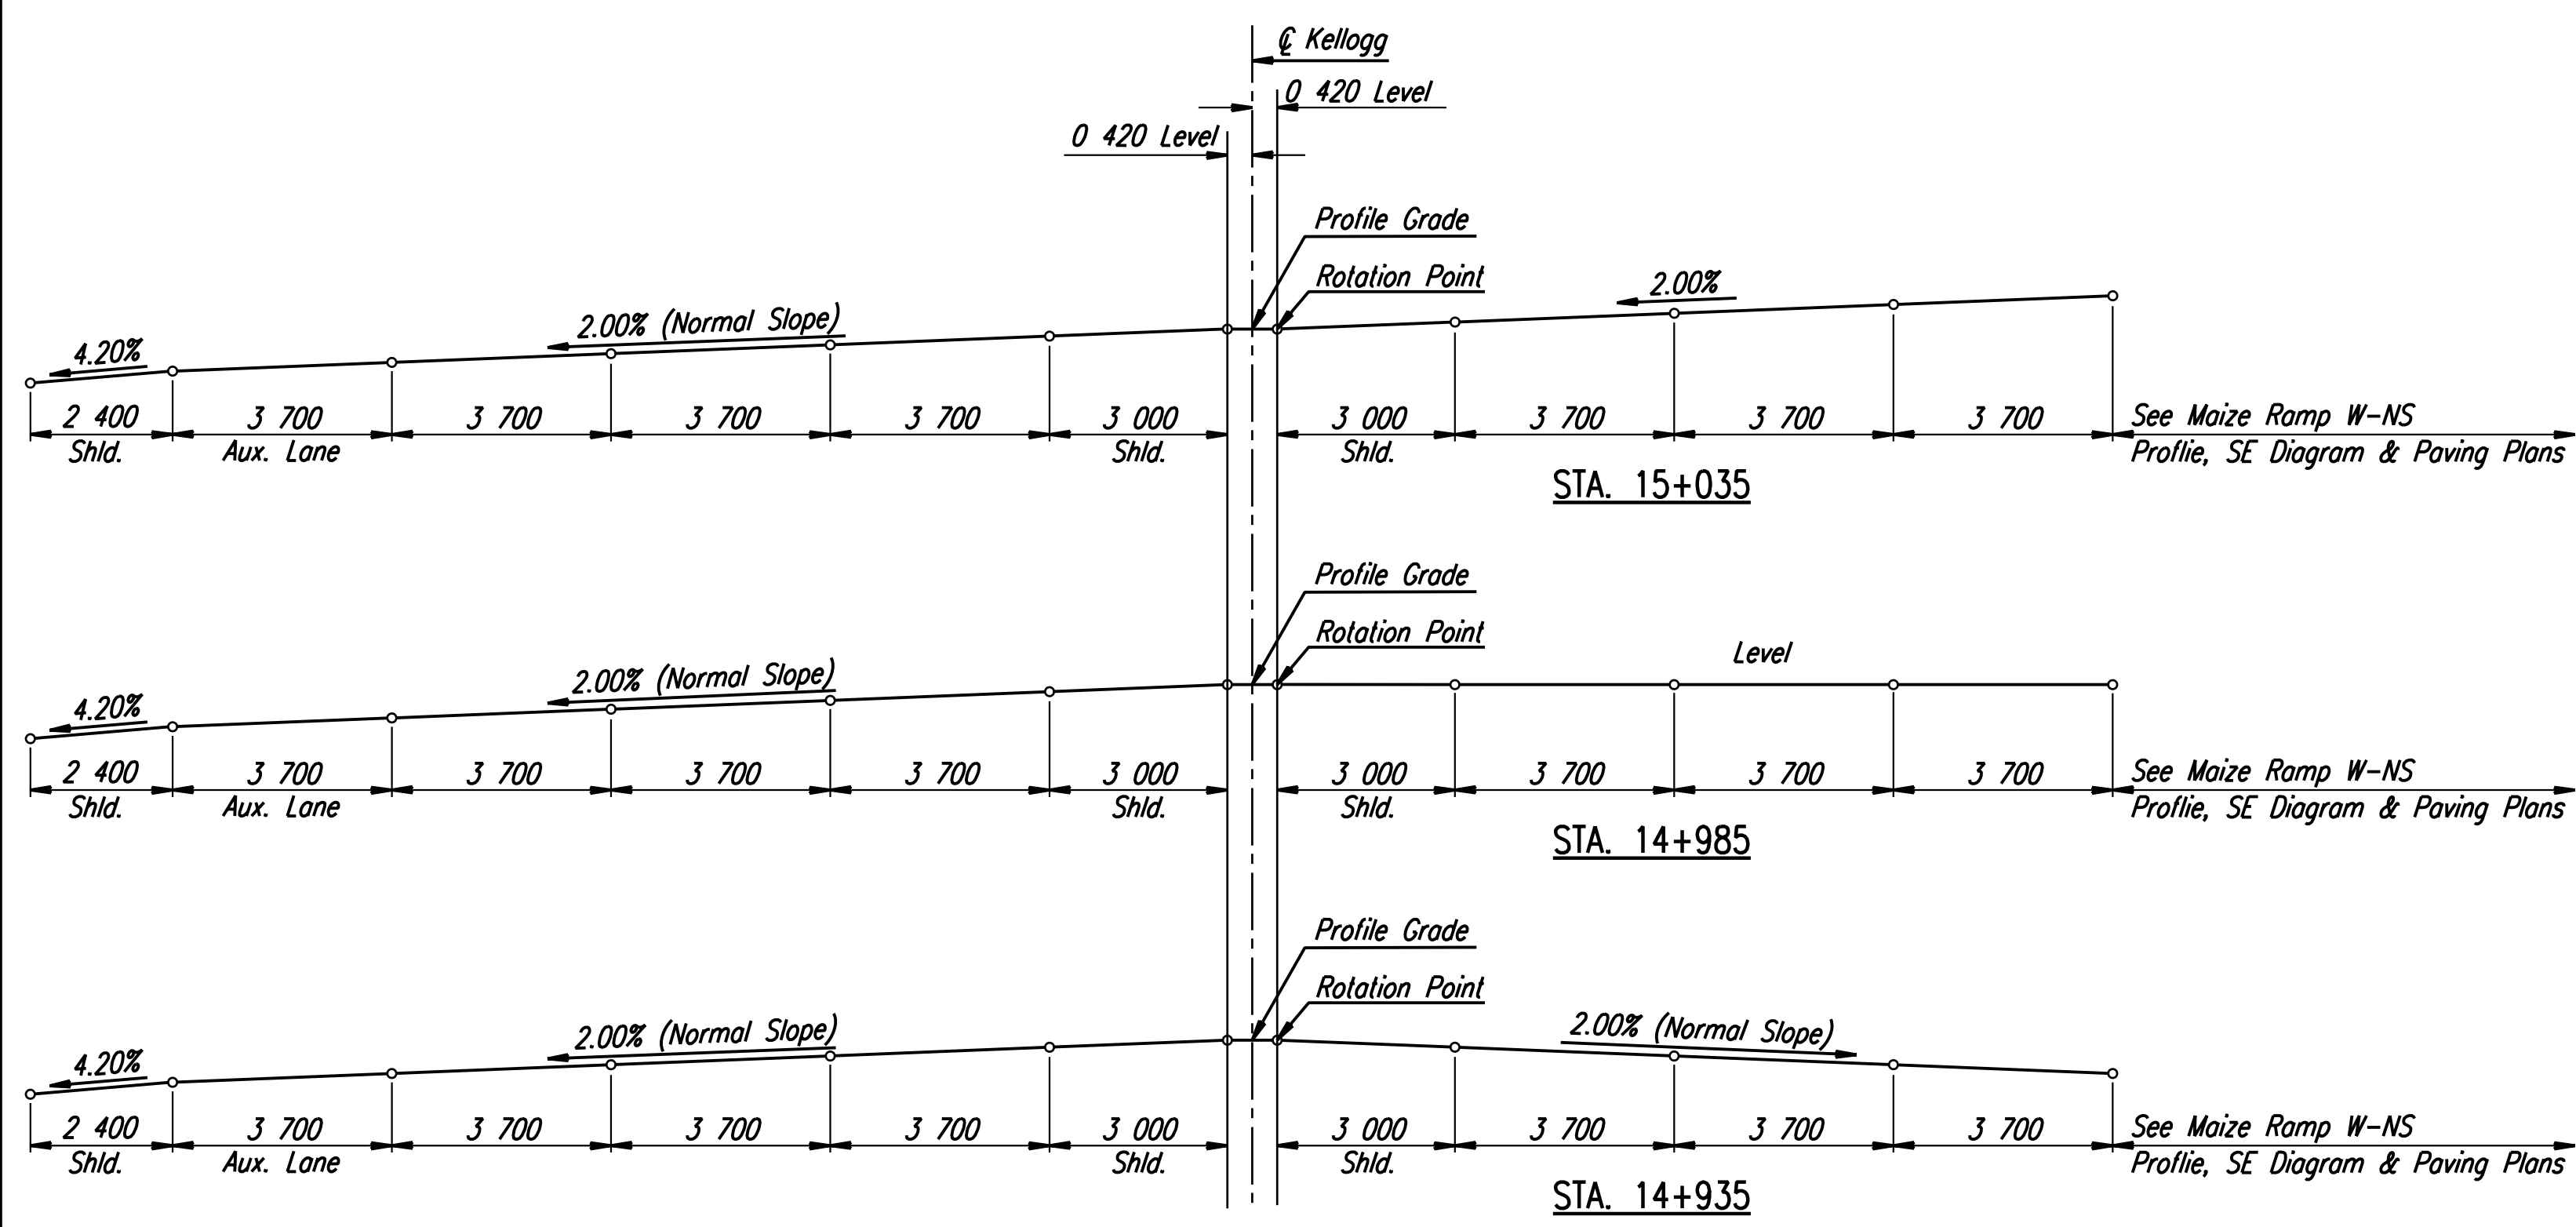

KELLOGG
CROSS-SLOPE TRANSITION
(STA. 14+665 TO STA. 14+710)

KELLOGG
SUPERELEVATION TRANSITION
(STA. 16+500 TO STA. 16+600)

- ① See mainline profile for elevations @ @ lanes.
- * Match existing x-slope.
- ** Match existing edge of shoulder.

Note: See ramp profiles and paving plans for pavement and shoulder x-slope transitions on ramps. See mainline profiles and paving plans for additional shoulder x-slope transitions at bridges and ramp gores.

No.	Revisions	By	Date

CITY OF WICHITA
**KELLOGG
SUPERELEVATION &
CROSS-SLOPE TRANSITIONS**
SEDGWICK COUNTY

Professional Engineering Consultants, P.A.
303 S. TOPEKA • WICHITA, KANSAS 67202
316-262-2691 • FAX 316-262-3003

Designed by	WDH	Checked by	WDH
Drawn by	JGP	Date	April, 2002
		Job No.	97362

RECORD DRAWING

DSNR: WDH OPER: JGP SCALE: 1:100
 i:/1997/97362/As-Builts/dgn s/ Sh 013-SE Transitions.dgn Last Rev: 7-31-07 By: gdr