
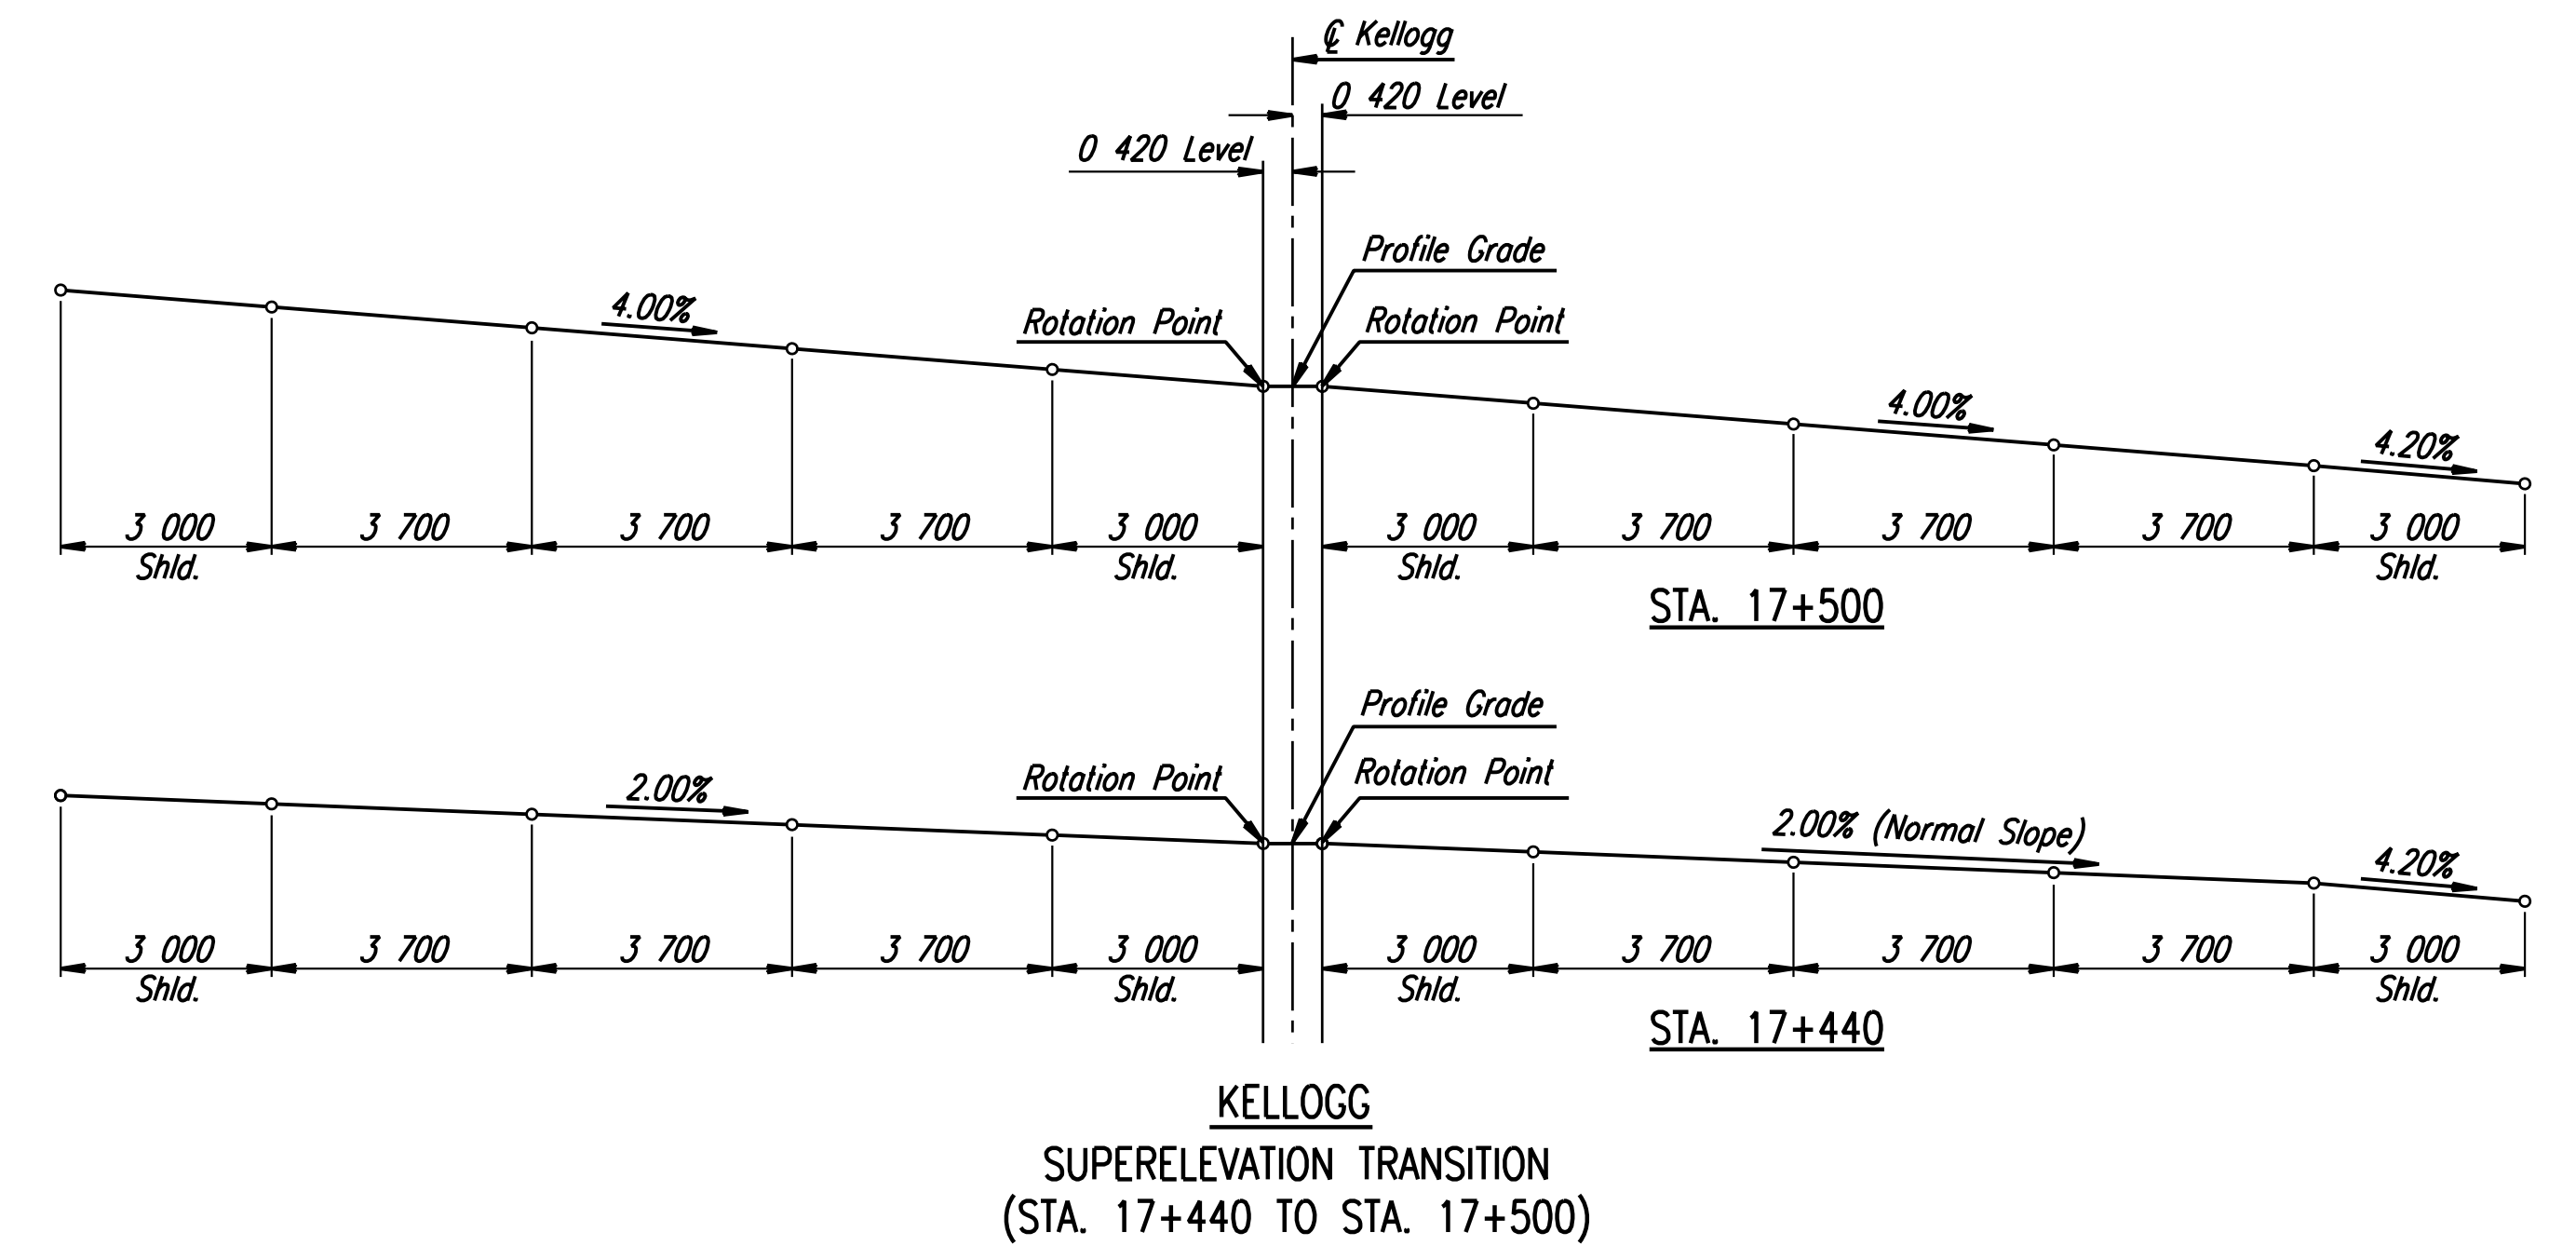
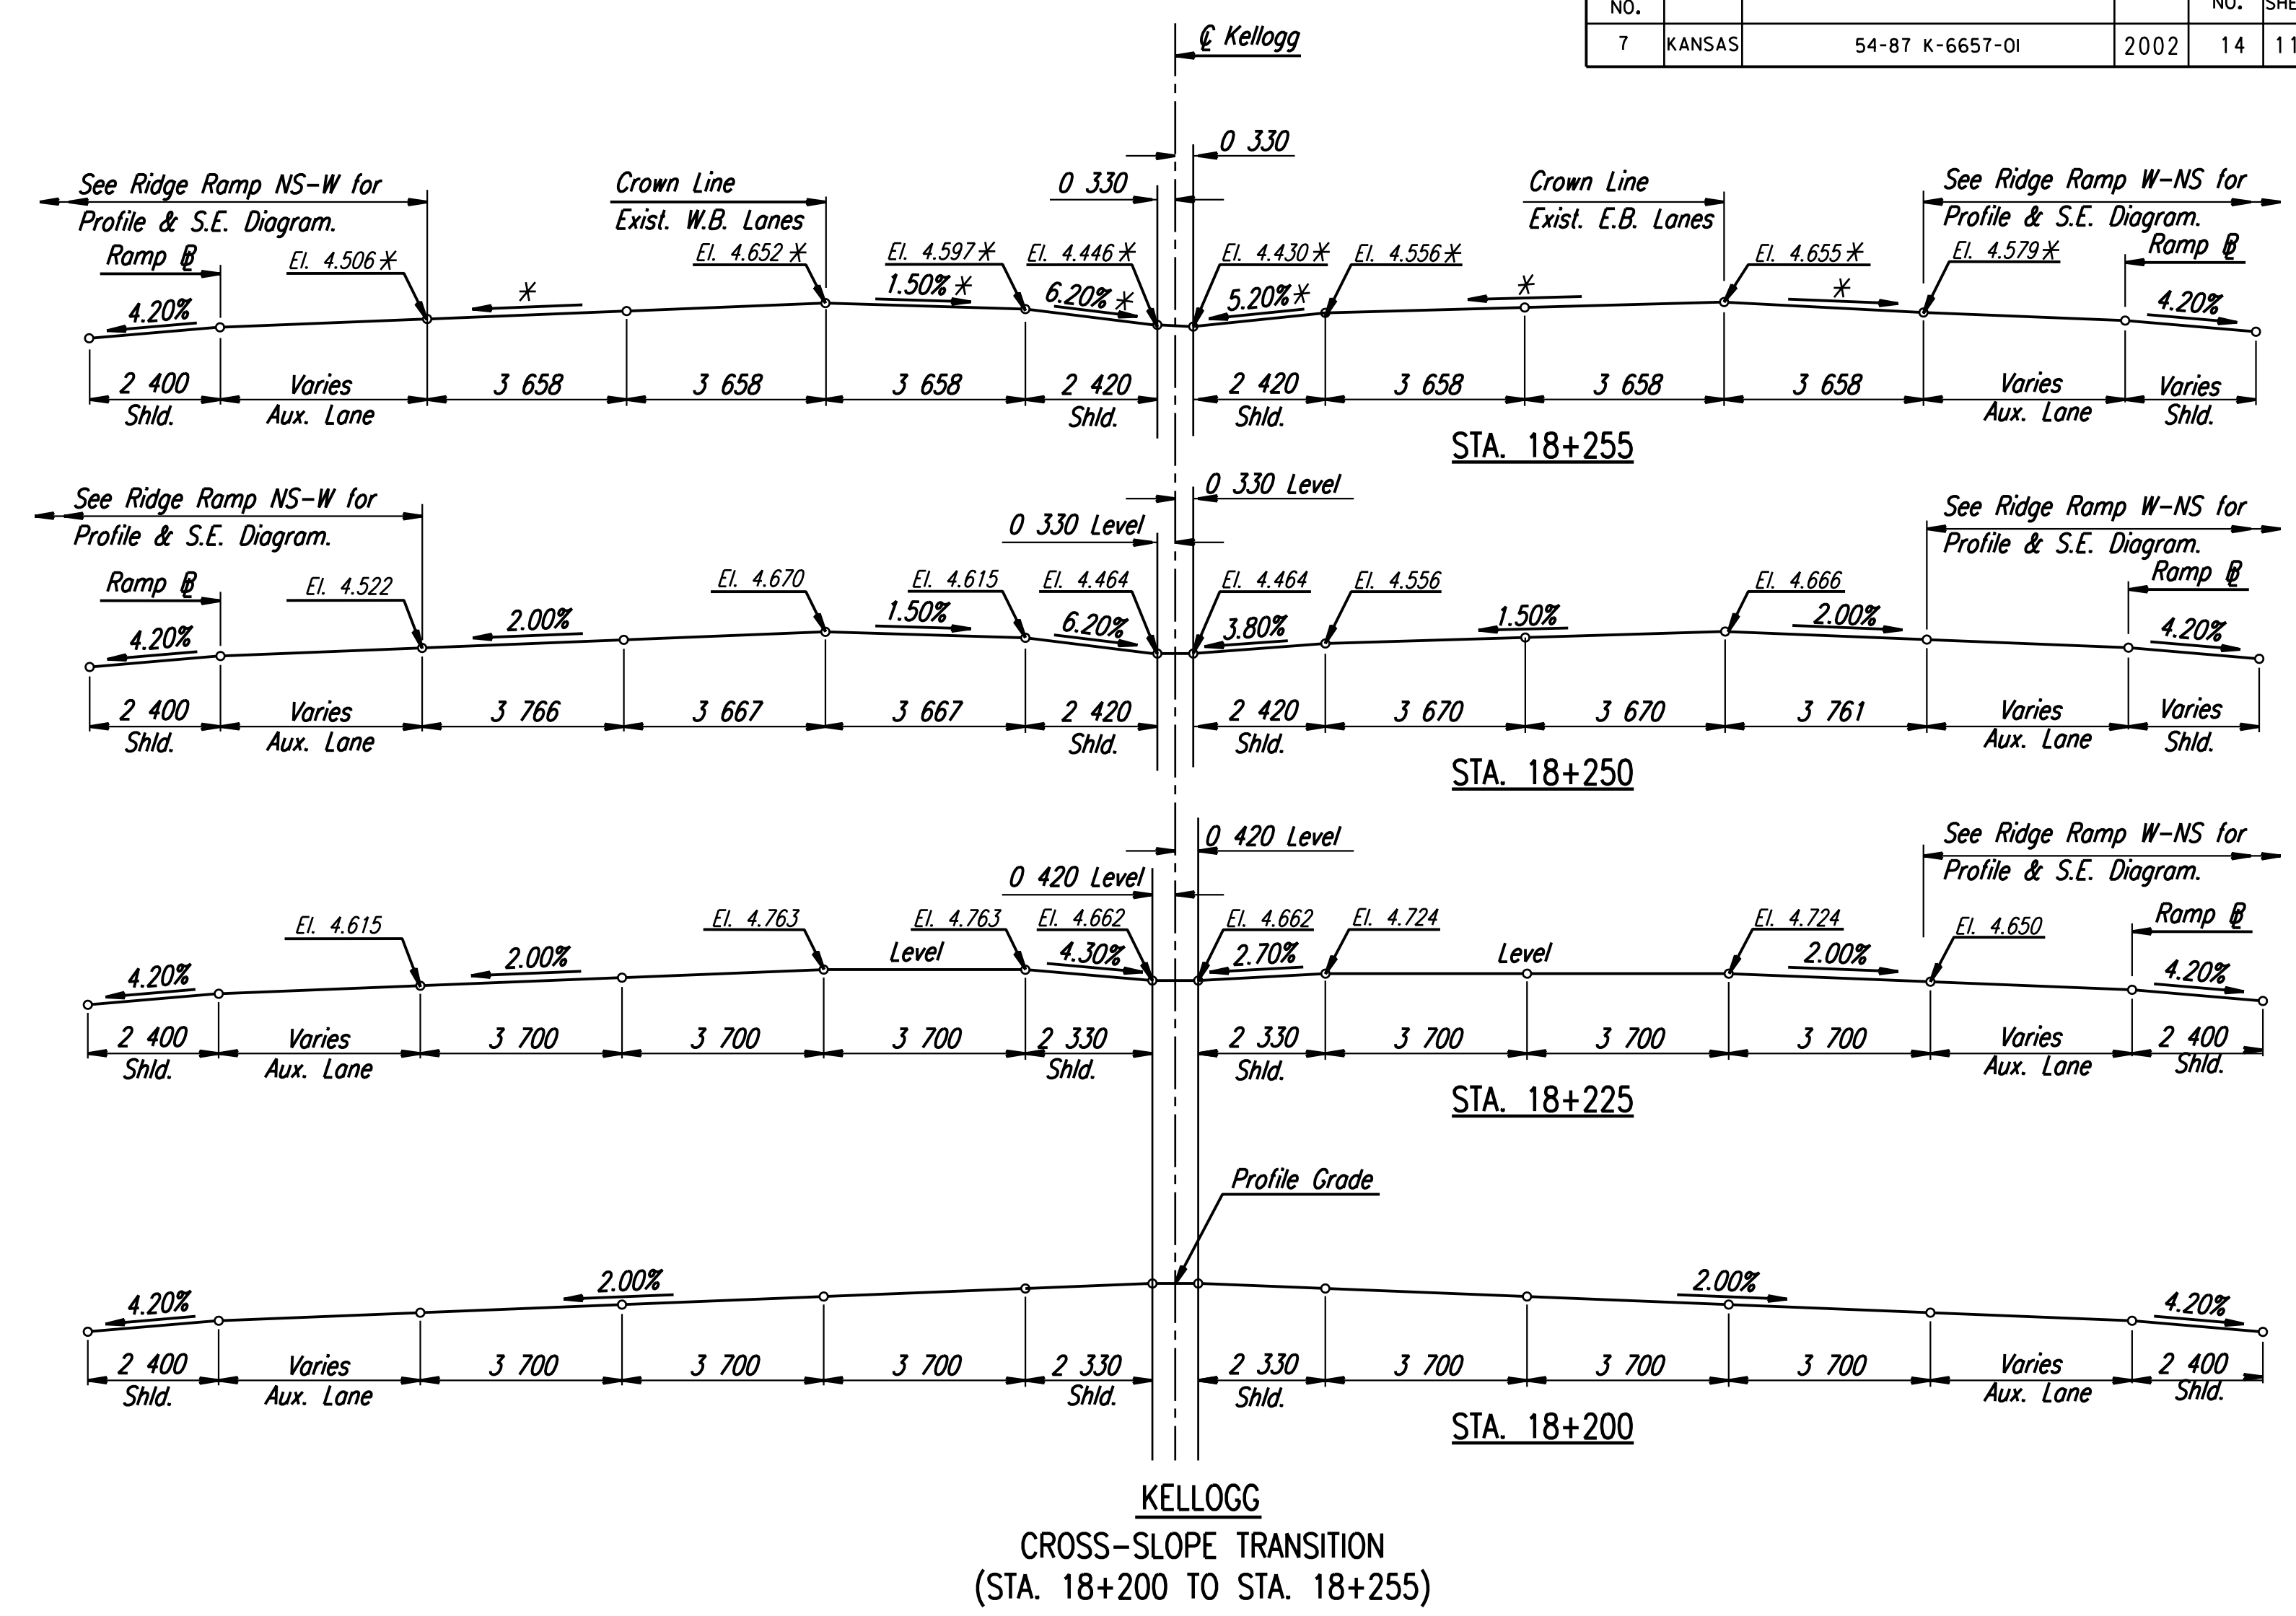


DATE	
BY	
REFERENCES NOTED	
REFERENCES CHECKED	

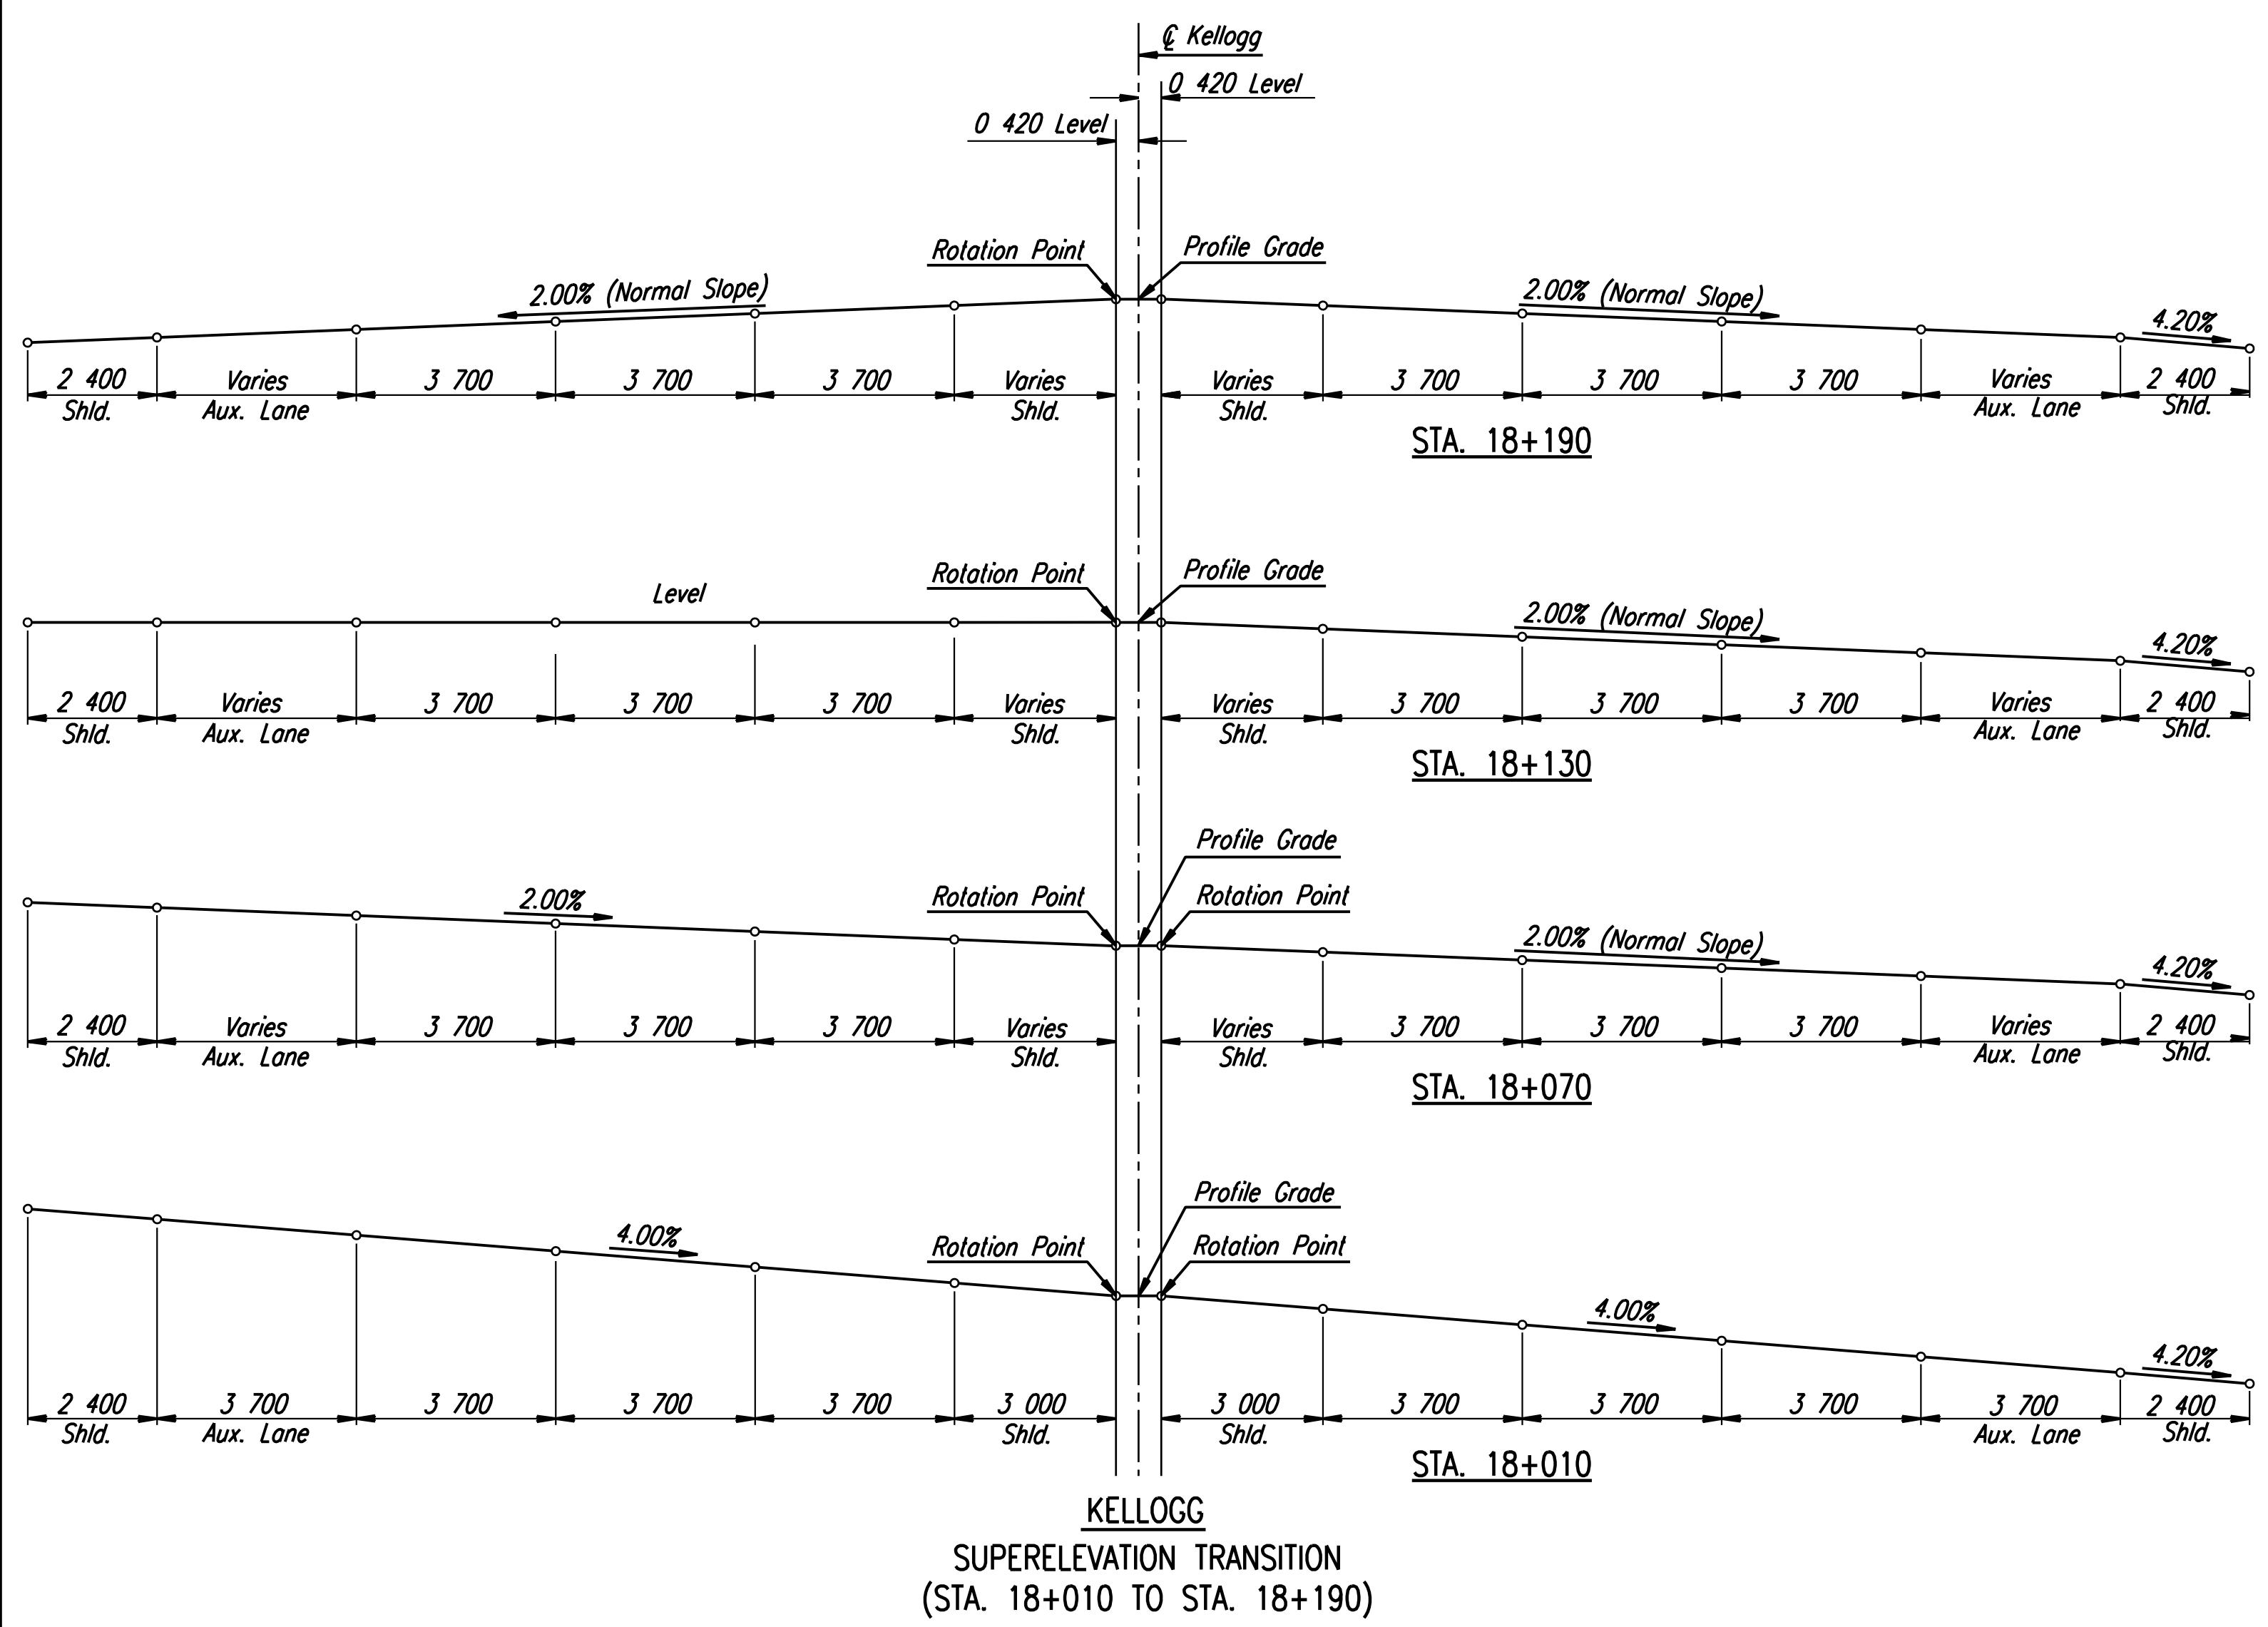

* Match existing.

Note: See ramp profiles and paving plans for pavement and shoulder x-slope transitions on ramps.
See mainline profiles and paving plans for additional shoulder x-slope transitions at bridges and ramp gores.

RECORD DRAWING

No.	Revisions	By	Date
CITY OF WICHITA KELLOGG SUPERELEVATION & CROSS-SLOPE TRANSITIONS SEDGWICK COUNTY			
Professional Engineering Consultants, P.A. <small>303 S. TOPEKA • WICHITA, KANSAS 67202 316-262-2691 • FAX 316-262-3003</small>			
Designed by	WDH	Checked by	WDH
Drawn by	JGP	Date	April, 2002
		Job No.	97362

DSNR: WDH OPER: JGP SCALE: 1:100
 i:/1997/97362/As-Builts/dgn's/Sh 014-SE Transitions.dgn Last Rev: 7-31-07 Bl: gdr