



FHWA REGION NO.	STATE	PROJECT NO.	YEAR	SHEET NO.	TOTAL SHEETS
7	KANSAS	54-87 K-6657-01	2002	18	1122


NOT PART OF THIS PROJECT

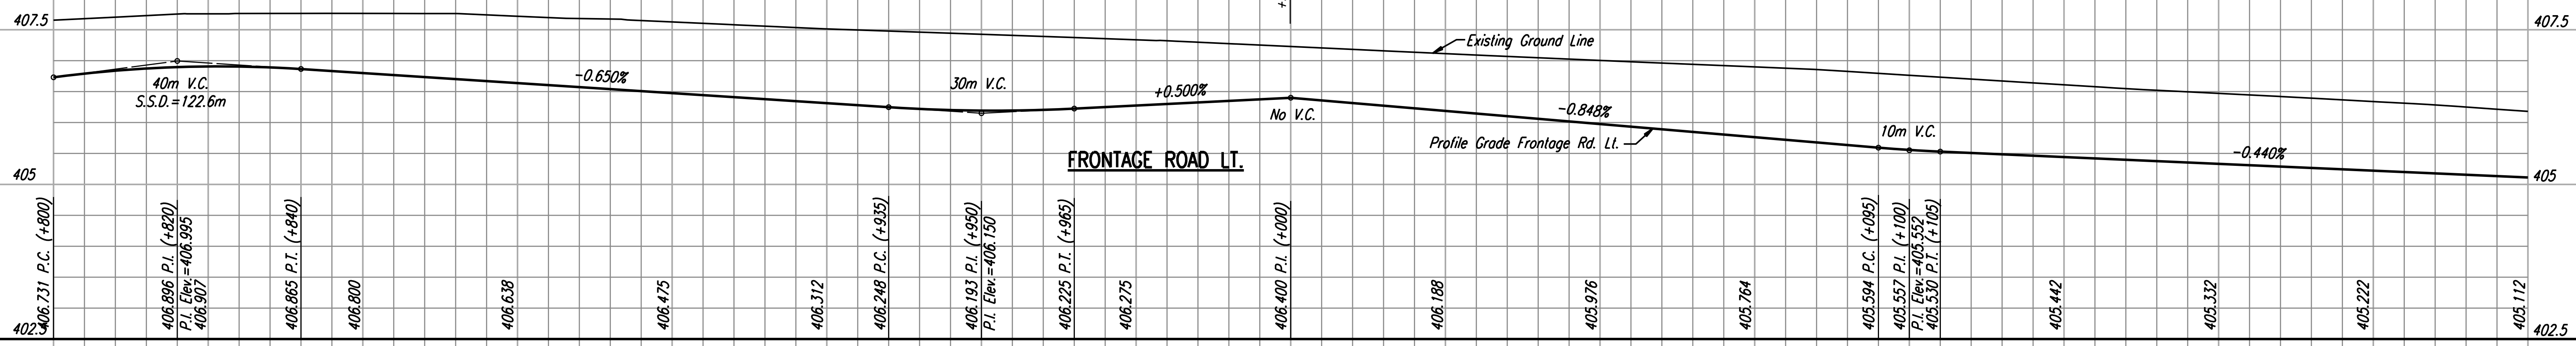

REFERENCES NOTED	DATE

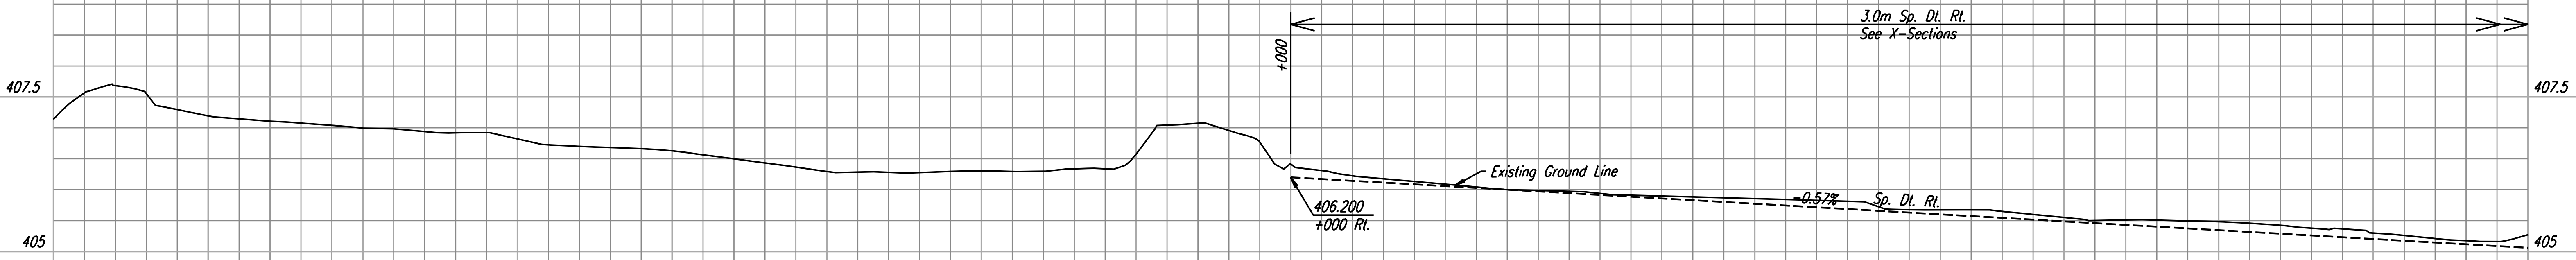

EXISTING C US-54

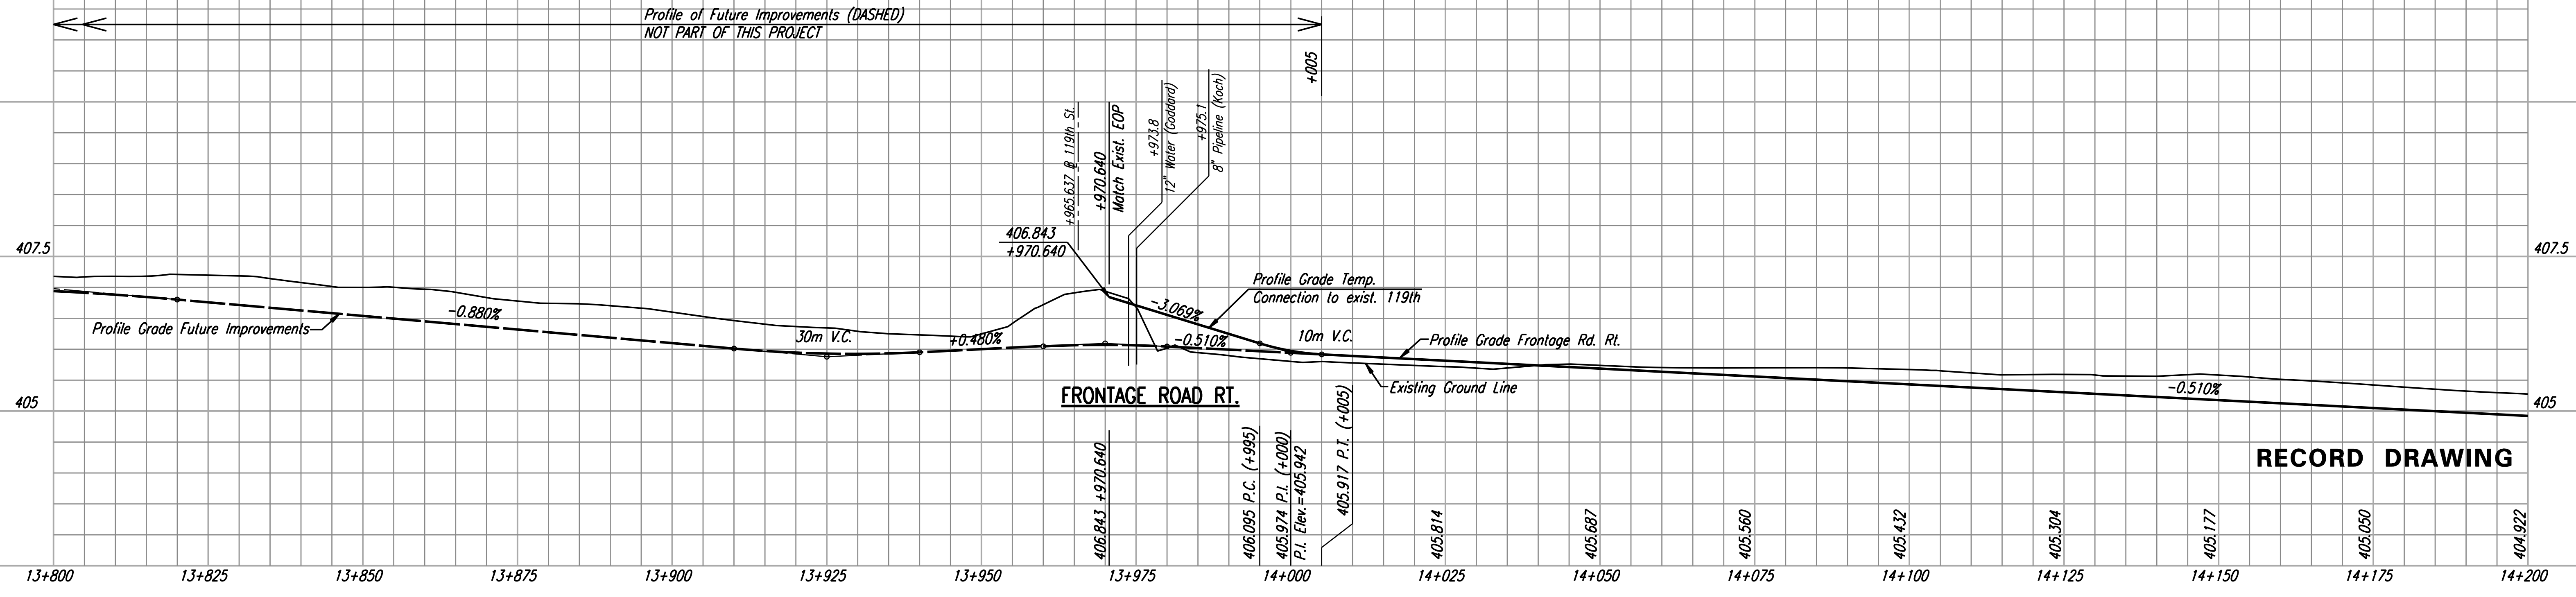

RECORD DRAWING

DSNR: JPS OPER: JGP SCALE: 1:500
 i:/1997/97362/As-Builts/dgn's/Sh 018-prfrd138.dgn Last Rev: 7-31-07 By: gdr

Frontage Roads Lt. & Rt. Sta. 13+800 to 14+200