
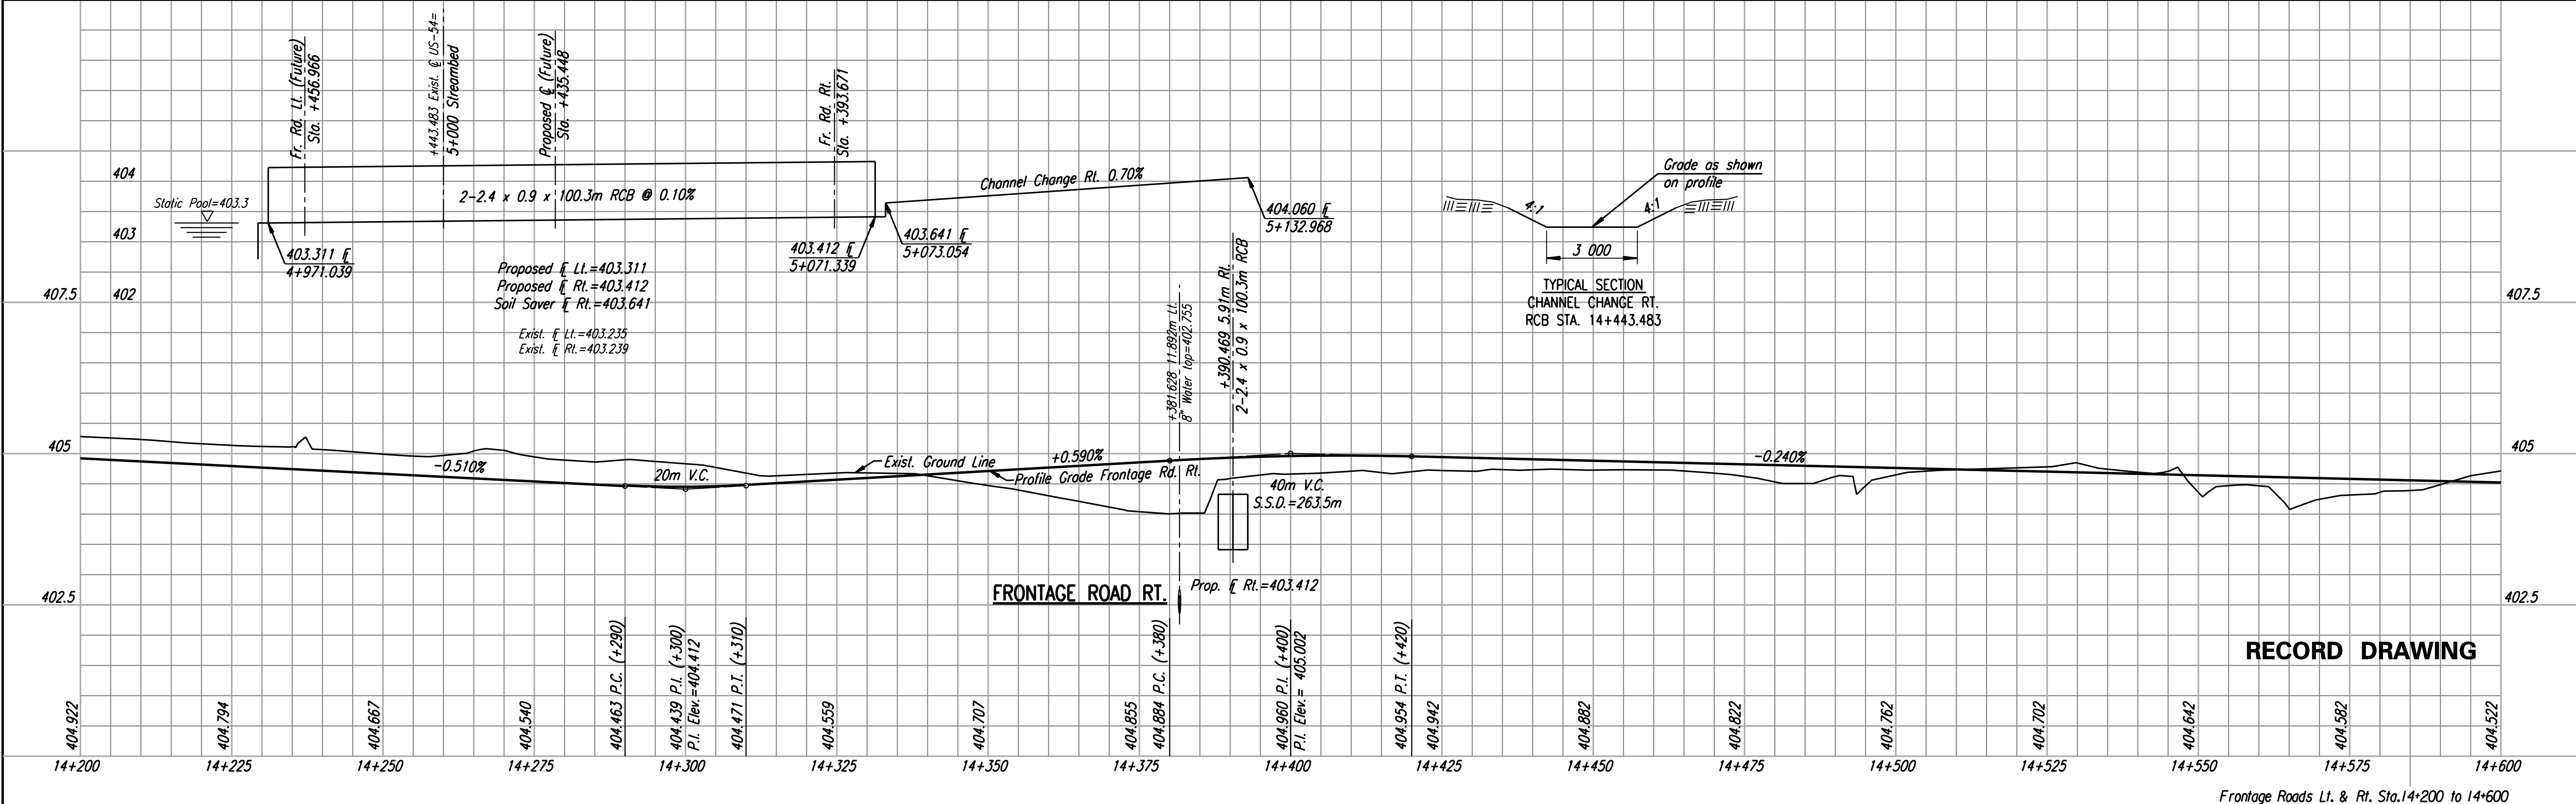
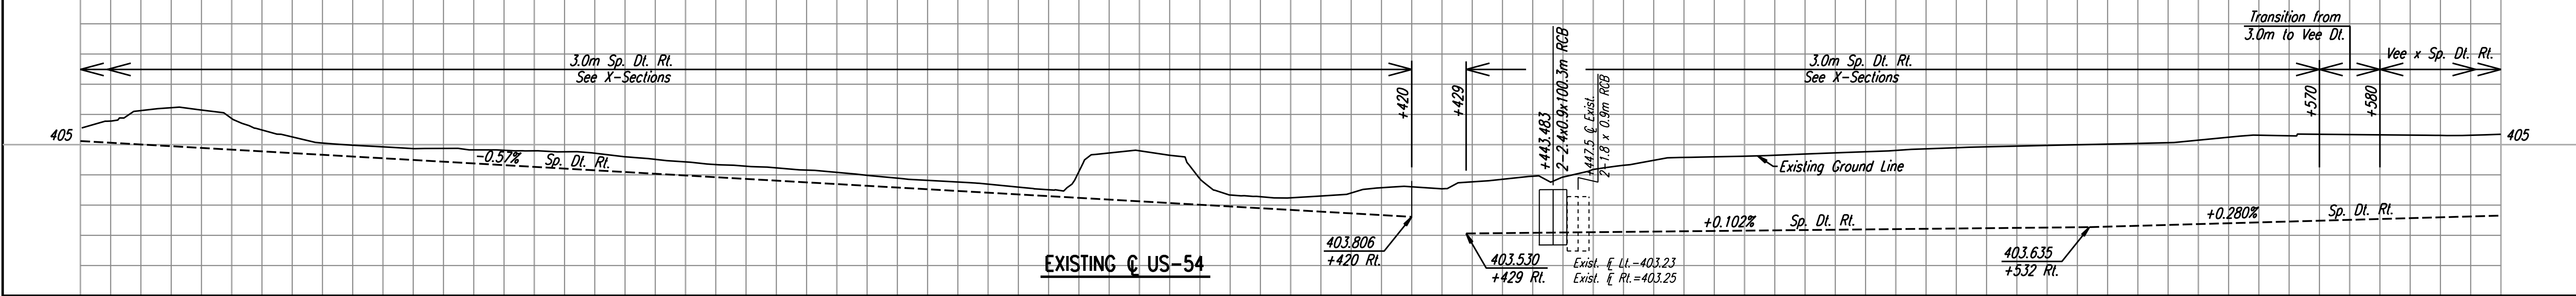


FHWA REGION NO.	STATE	PROJECT NO.	YEAR	SHEET NO.	TOTAL SHEETS
7	KANSAS	54-B7 K-6657-01	2002	22	1122

NOT PART OF THIS PROJECT

REFERENCES NOTED	BY	DATE
REFERENCES CHECKED		

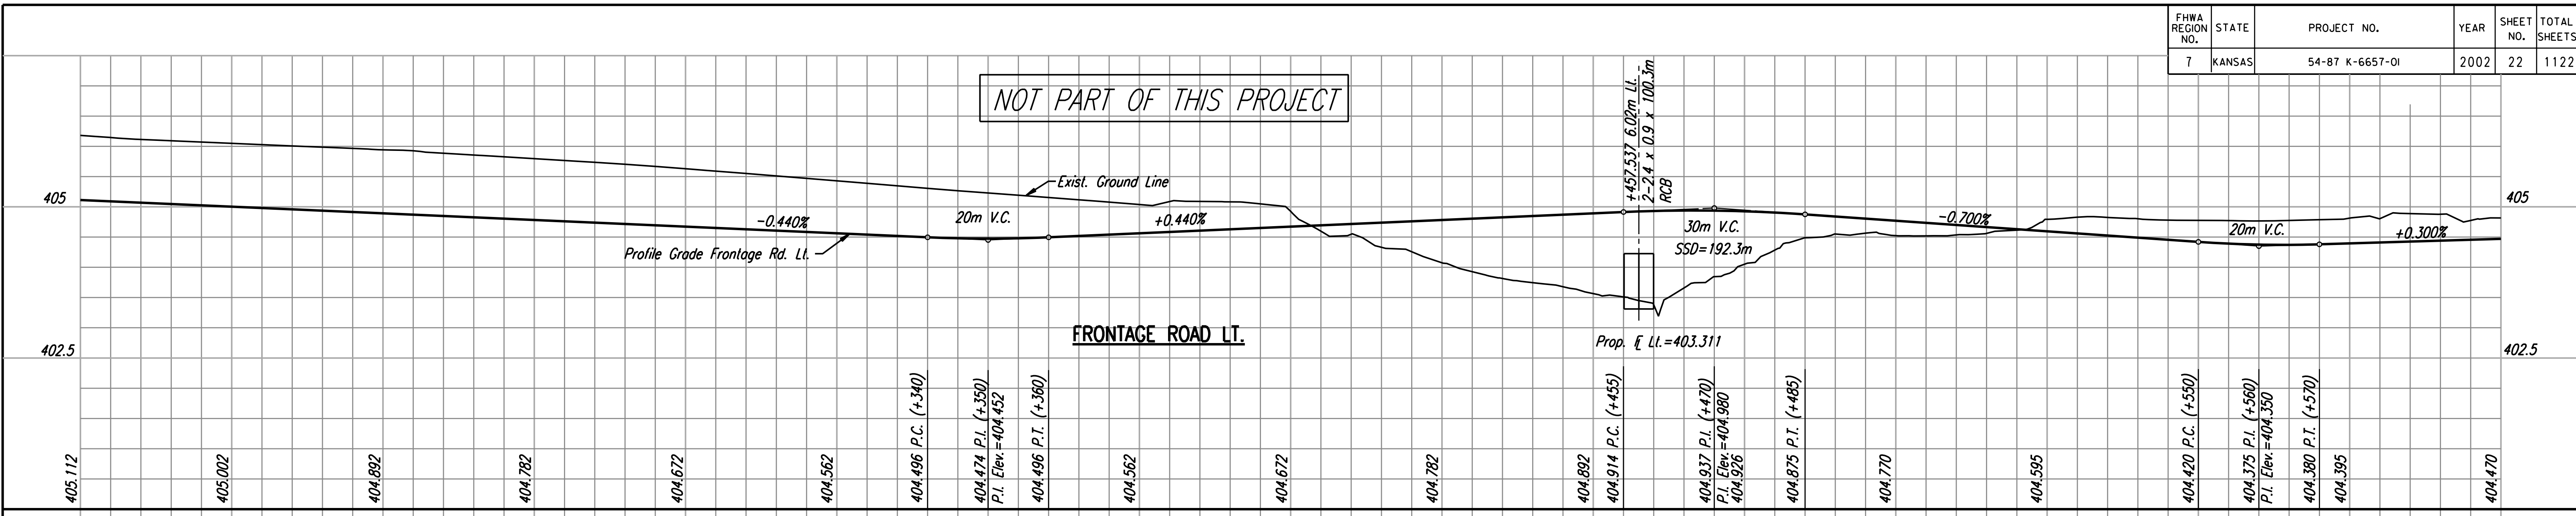

RECORD DRAWING

DSNR: JPS OPER: JGP SCALE: 1:500
 i:/1997/97362/As-Builts/dgn's/Sh_022-prfrd142.dgn Last Rev: 8-1-07 By: gdr

Frontage Roads Lt. & Rt. Sta. 14+200 to 14+600