
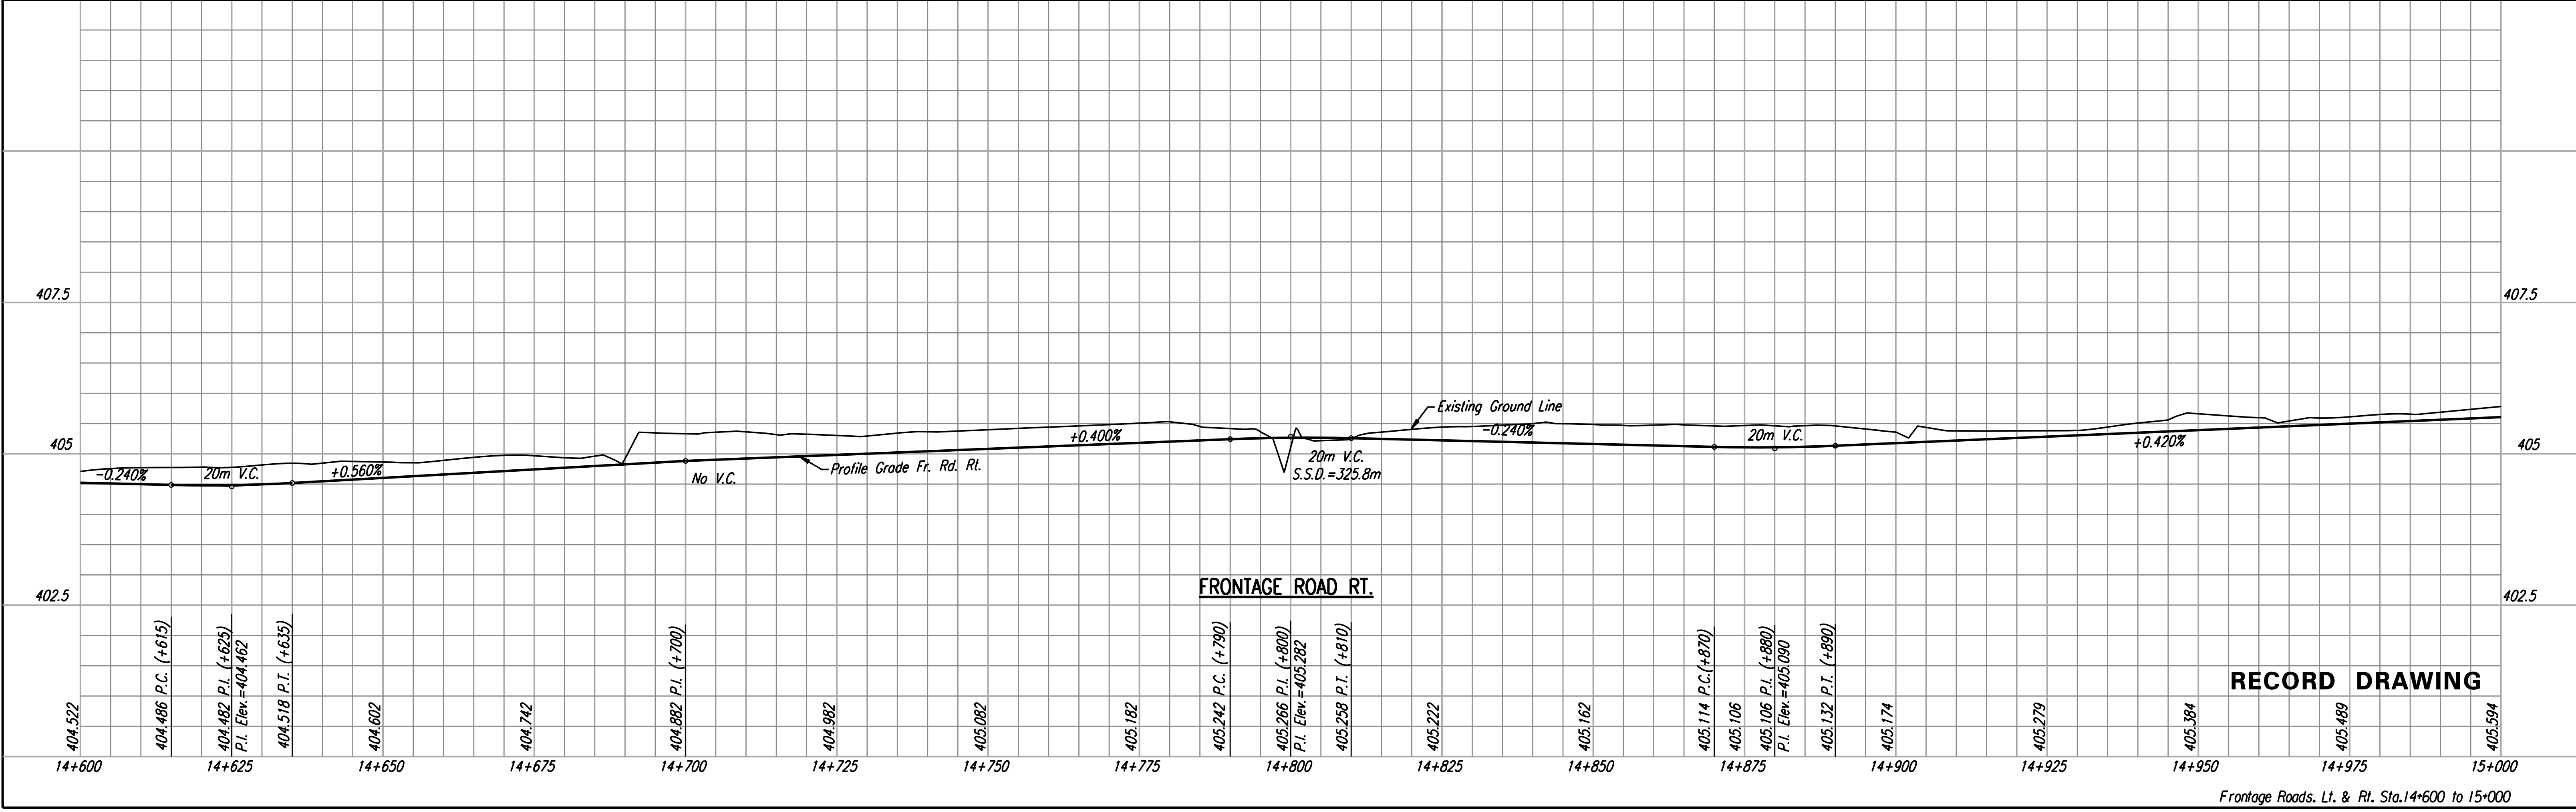


| FHWA REGION NO. | STATE  | PROJECT NO.     | YEAR | SHEET NO. | TOTAL SHEETS |
|-----------------|--------|-----------------|------|-----------|--------------|
| 7               | KANSAS | 54-87 K-6657-01 | 2001 | 26        | 1122         |

| REFERENCES NOTED   | DATE |
|--------------------|------|
| REFERENCES CHECKED |      |

DSNR: WDH OPER: JGP SCALE: 1:500  
 i:/1997/97362/As-Builts/dgn's/Sh 026-prfrd146.dgn Last Rev: 8-2-07 By: gdr

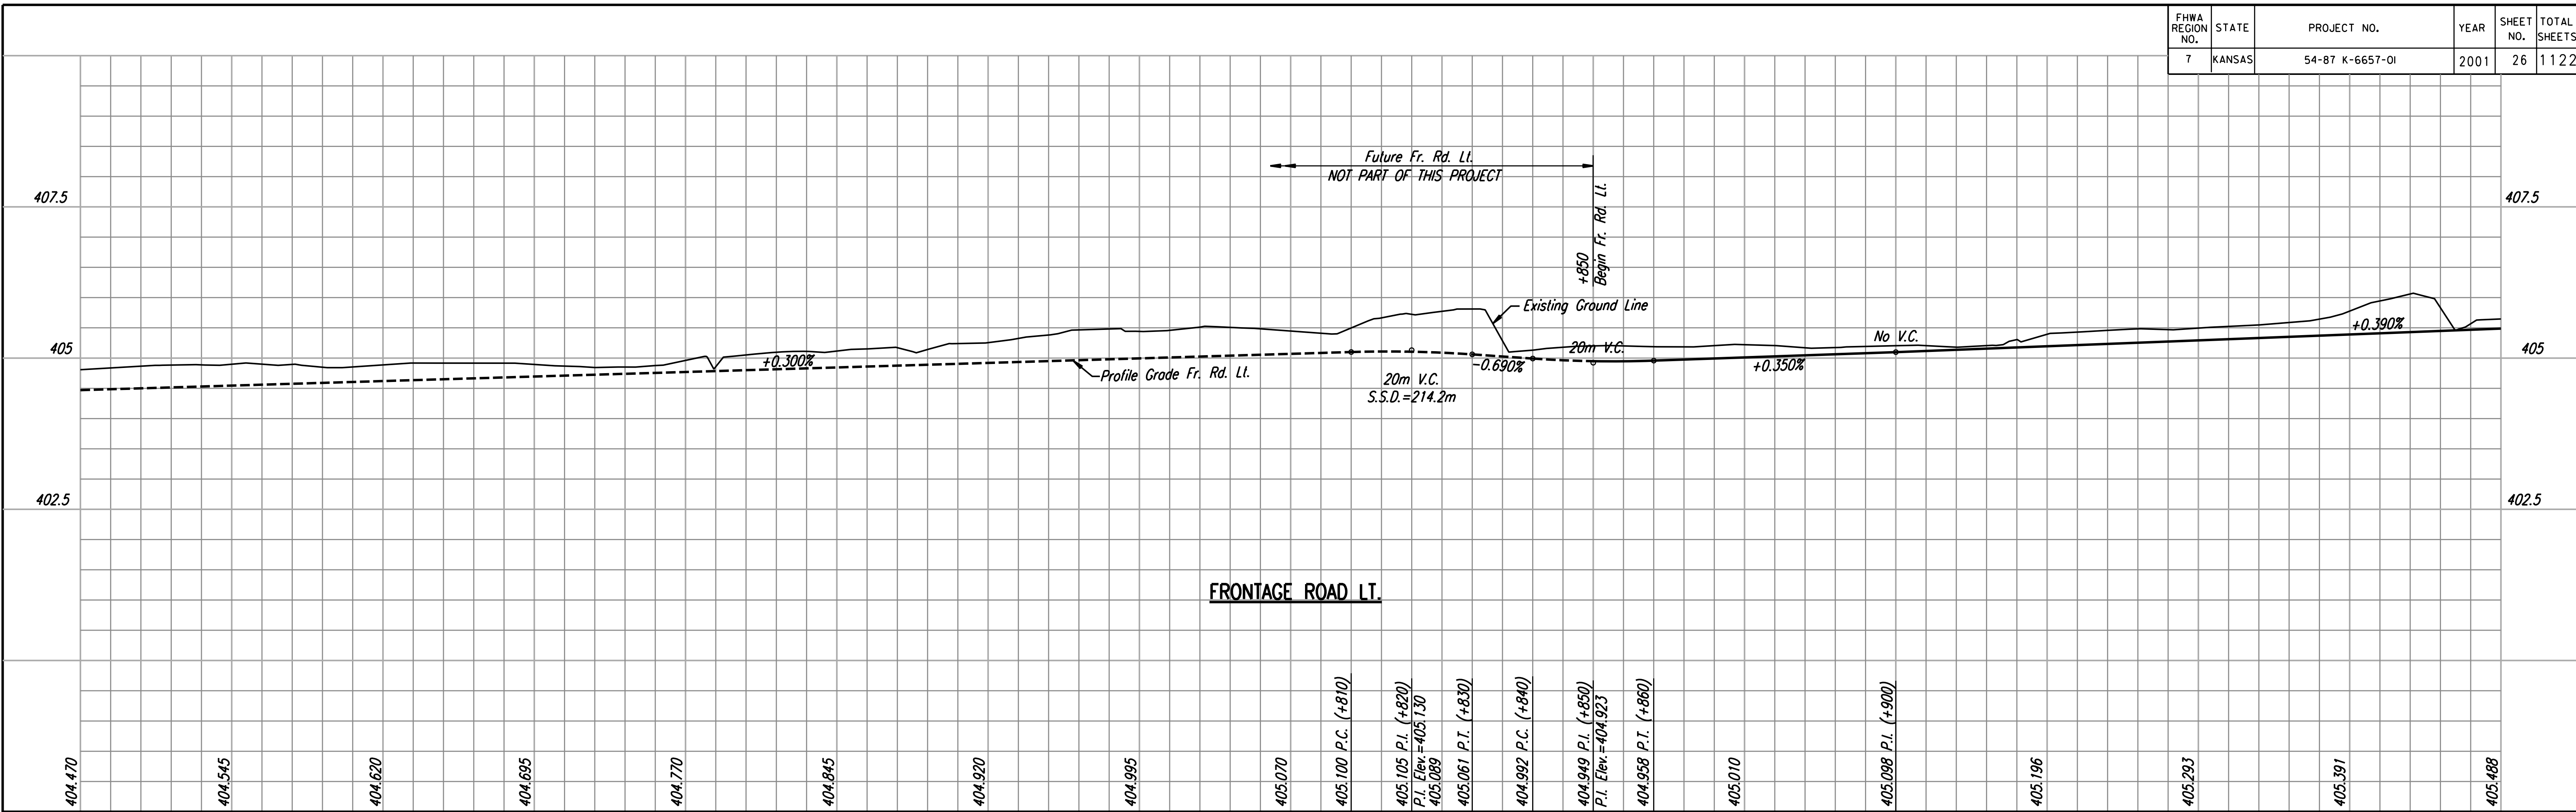

**RECORD DRAWING**