


FHWA REGION NO.	STATE	PROJECT NO.	YEAR	SHEET NO.	TOTAL SHEETS
7	KANSAS	54-87 K-6657-01	2002	30	1122

P.C. +018830
 +0.35
 +2.00%
 E. B. Lanes X-Slope Rt.
 Profile Grade Diagrammatic
SUPERELEVATION DIAGRAM E.B. LANES
 (Note: W.B. Lane Normal X-Slope, -2.00%)

REFERENCES NOTED	BY	DATE
REFERENCES CHECKED		

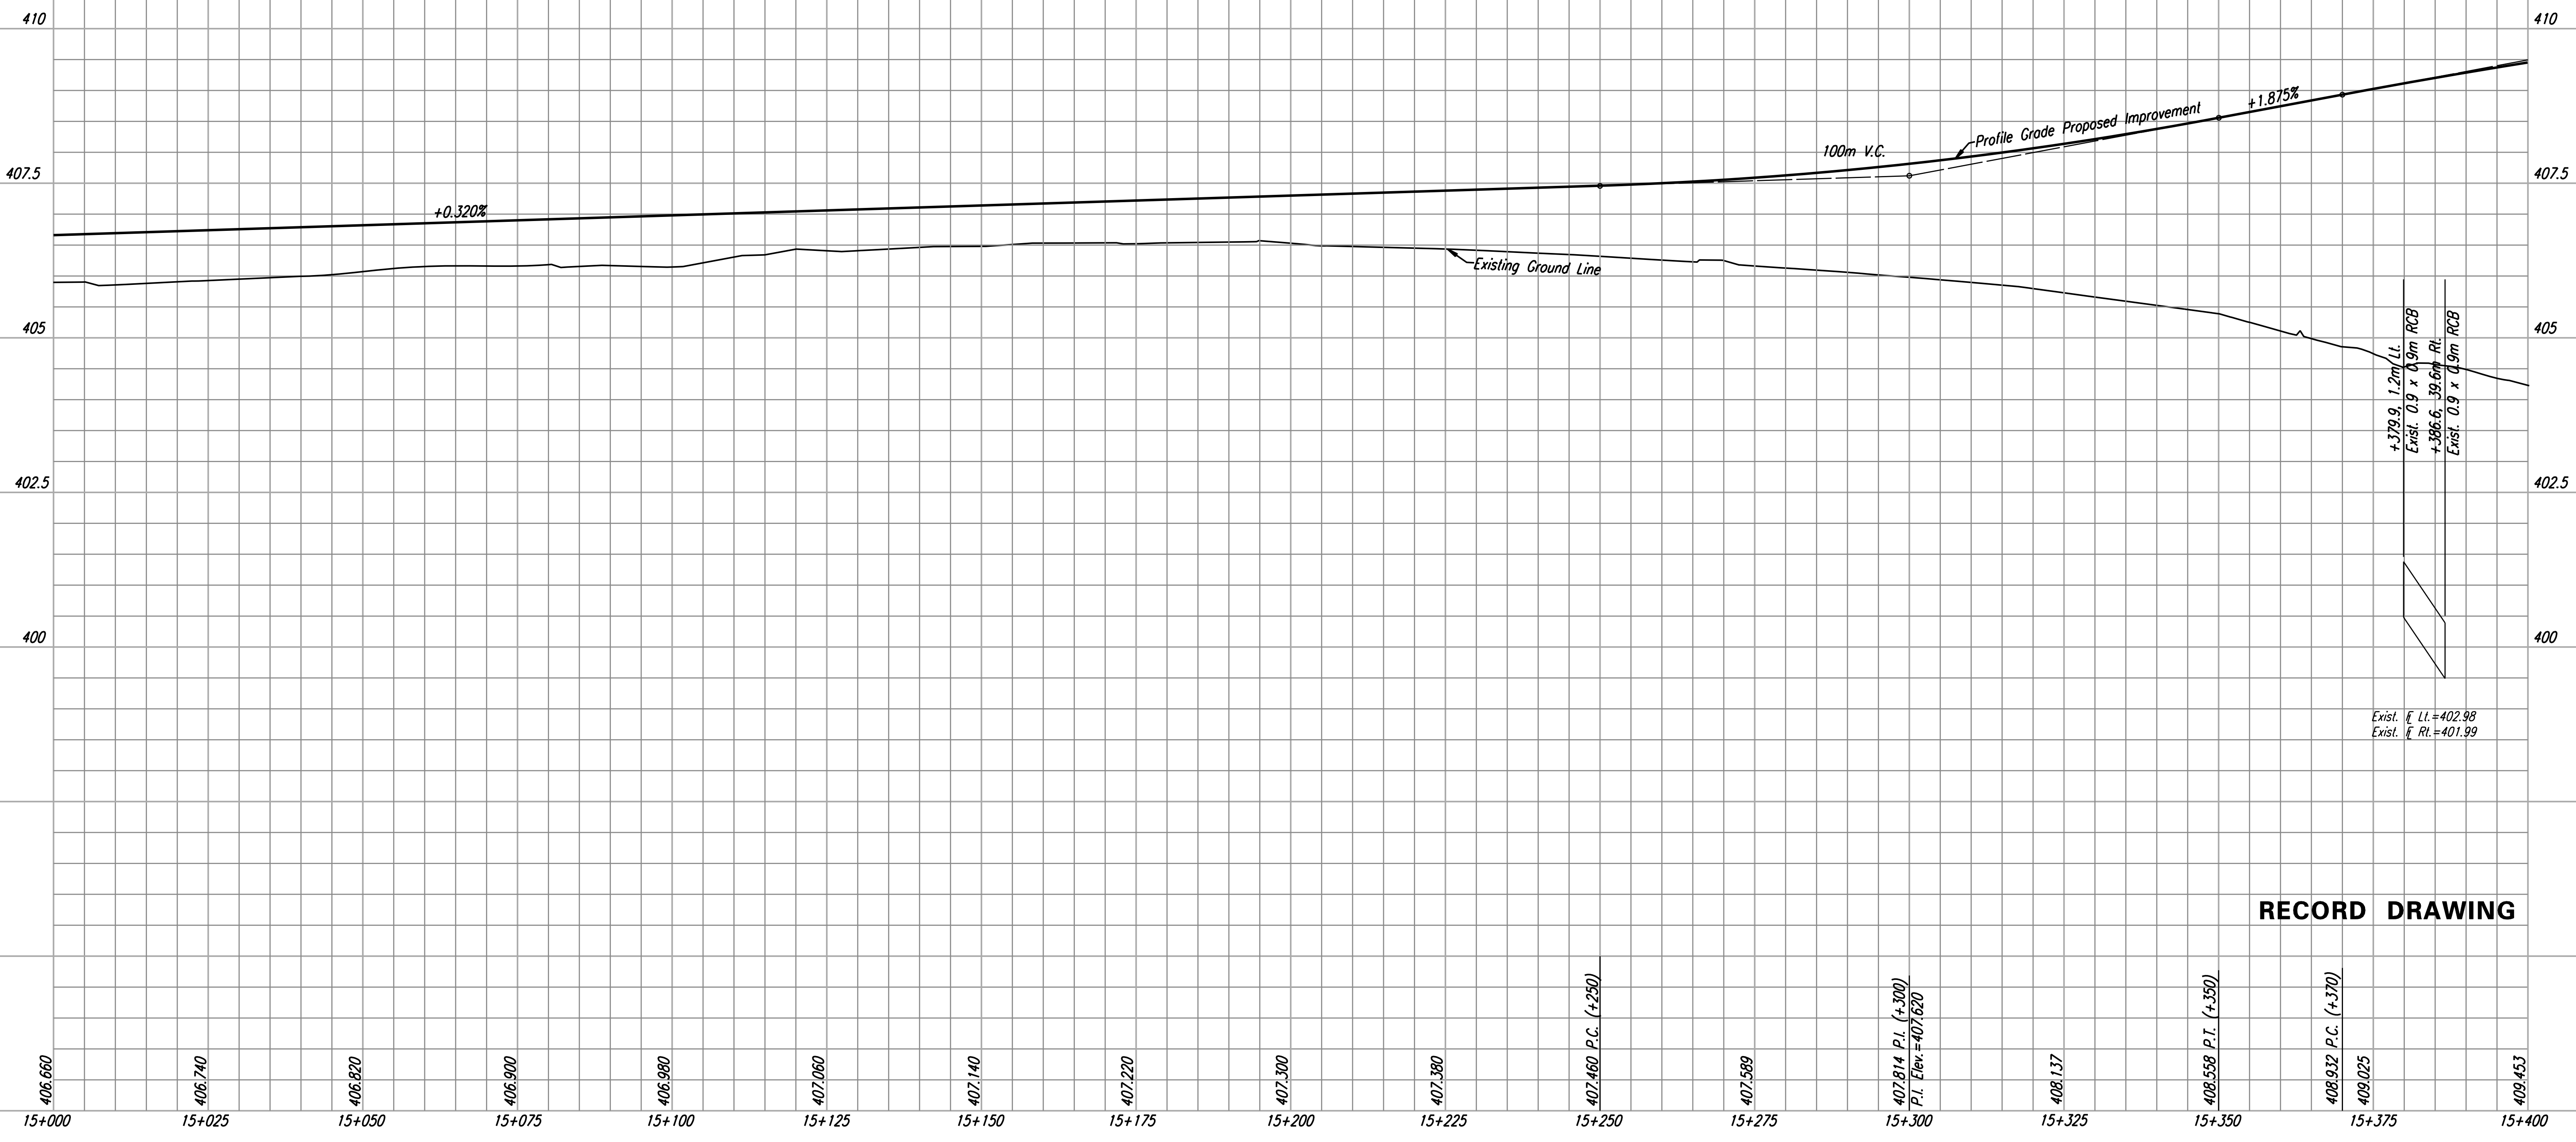

DSNR: WDH OPER: JGP SCALE: 1:500
 i:/1997/97362/As-Builts/dgn's/Sh 030-pr150.dgn Last Rev: 8-3-07 By: gdr

RECORD DRAWING