
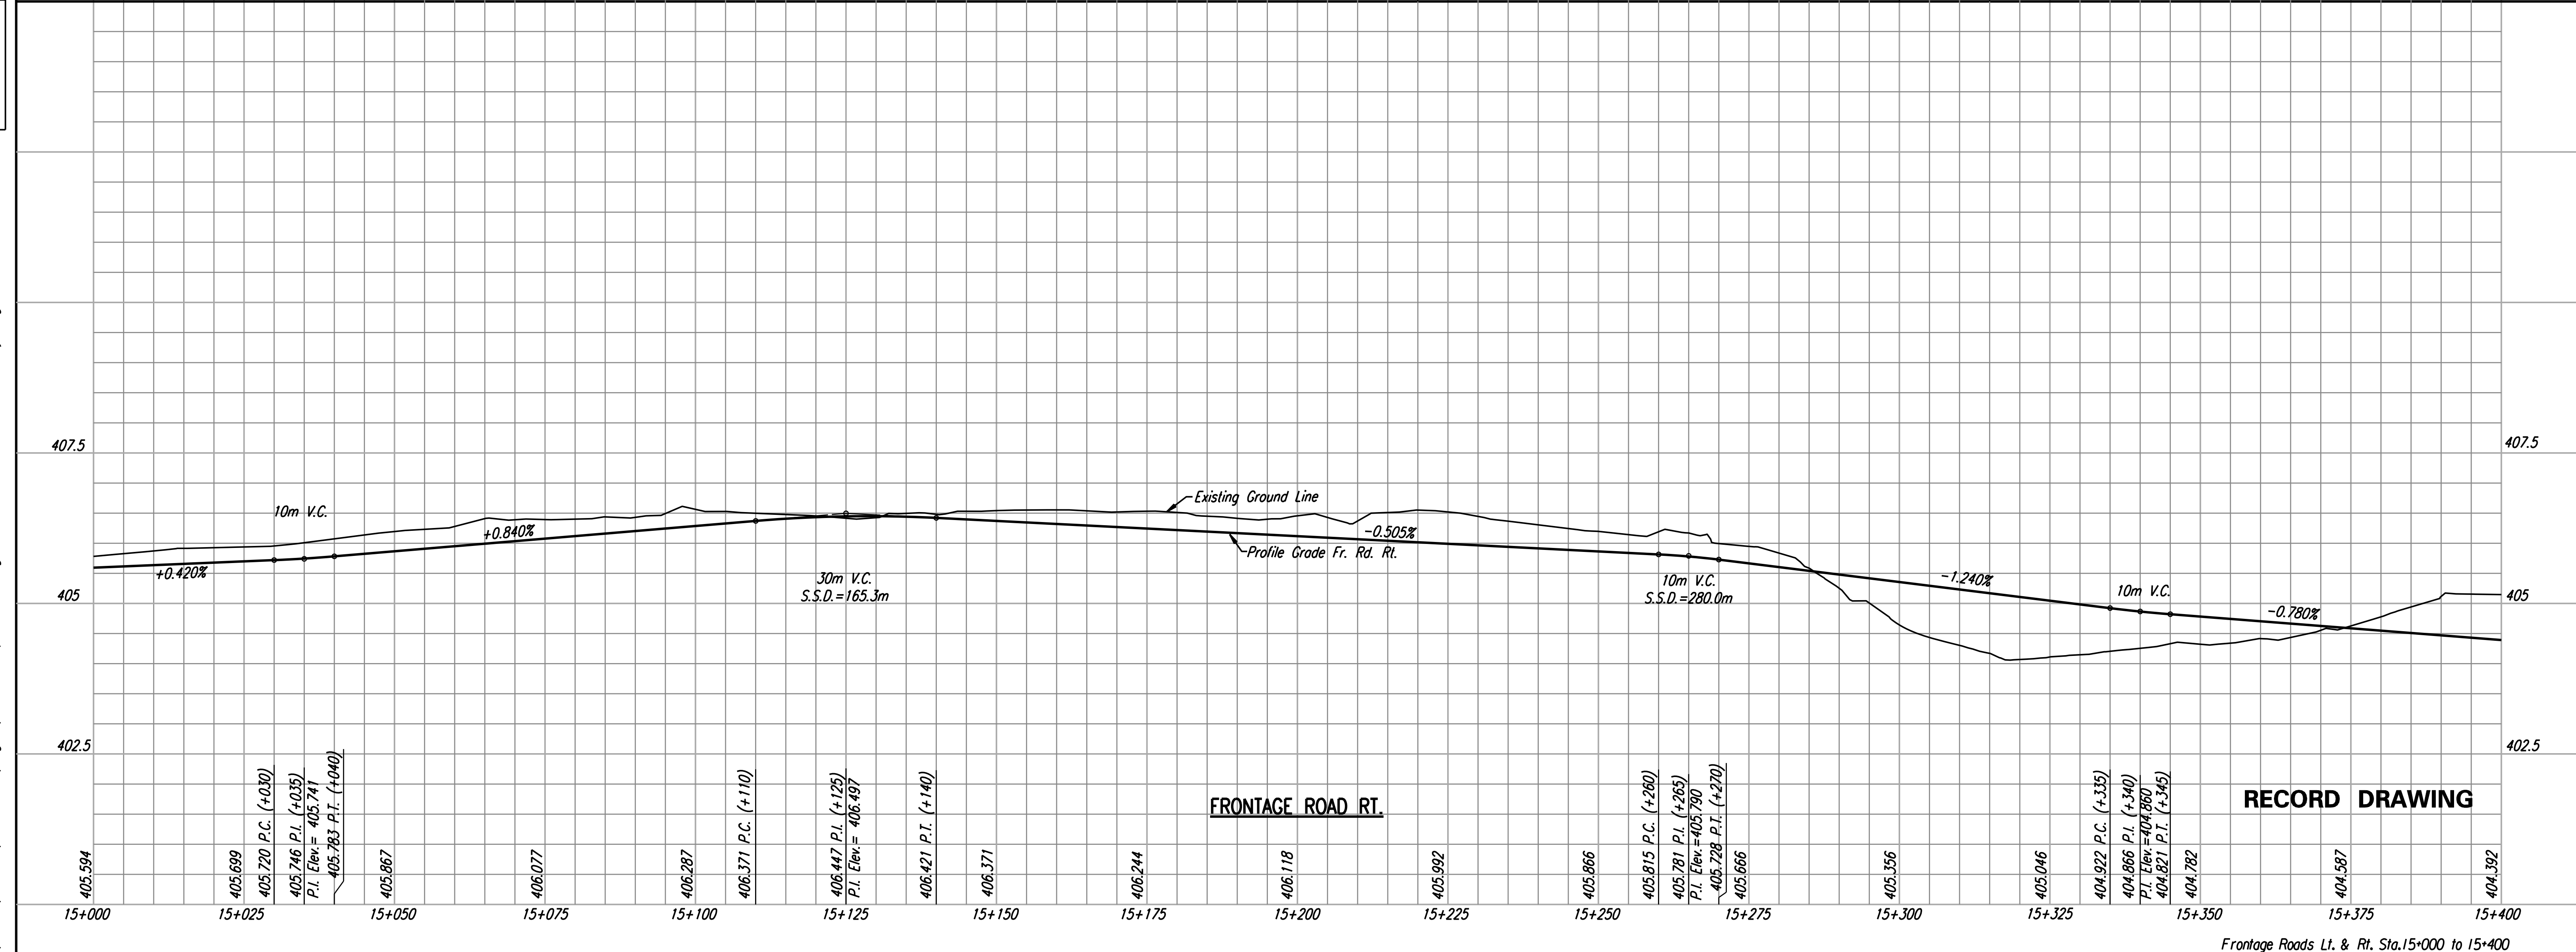


FHWA REGION NO.	STATE	PROJECT NO.	YEAR	SHEET NO.	TOTAL SHEETS
7	KANSAS	54-87 K6657-01	2002	31	1122

REFERENCES NOTED	BY	DATE
REFERENCES CHECKED		

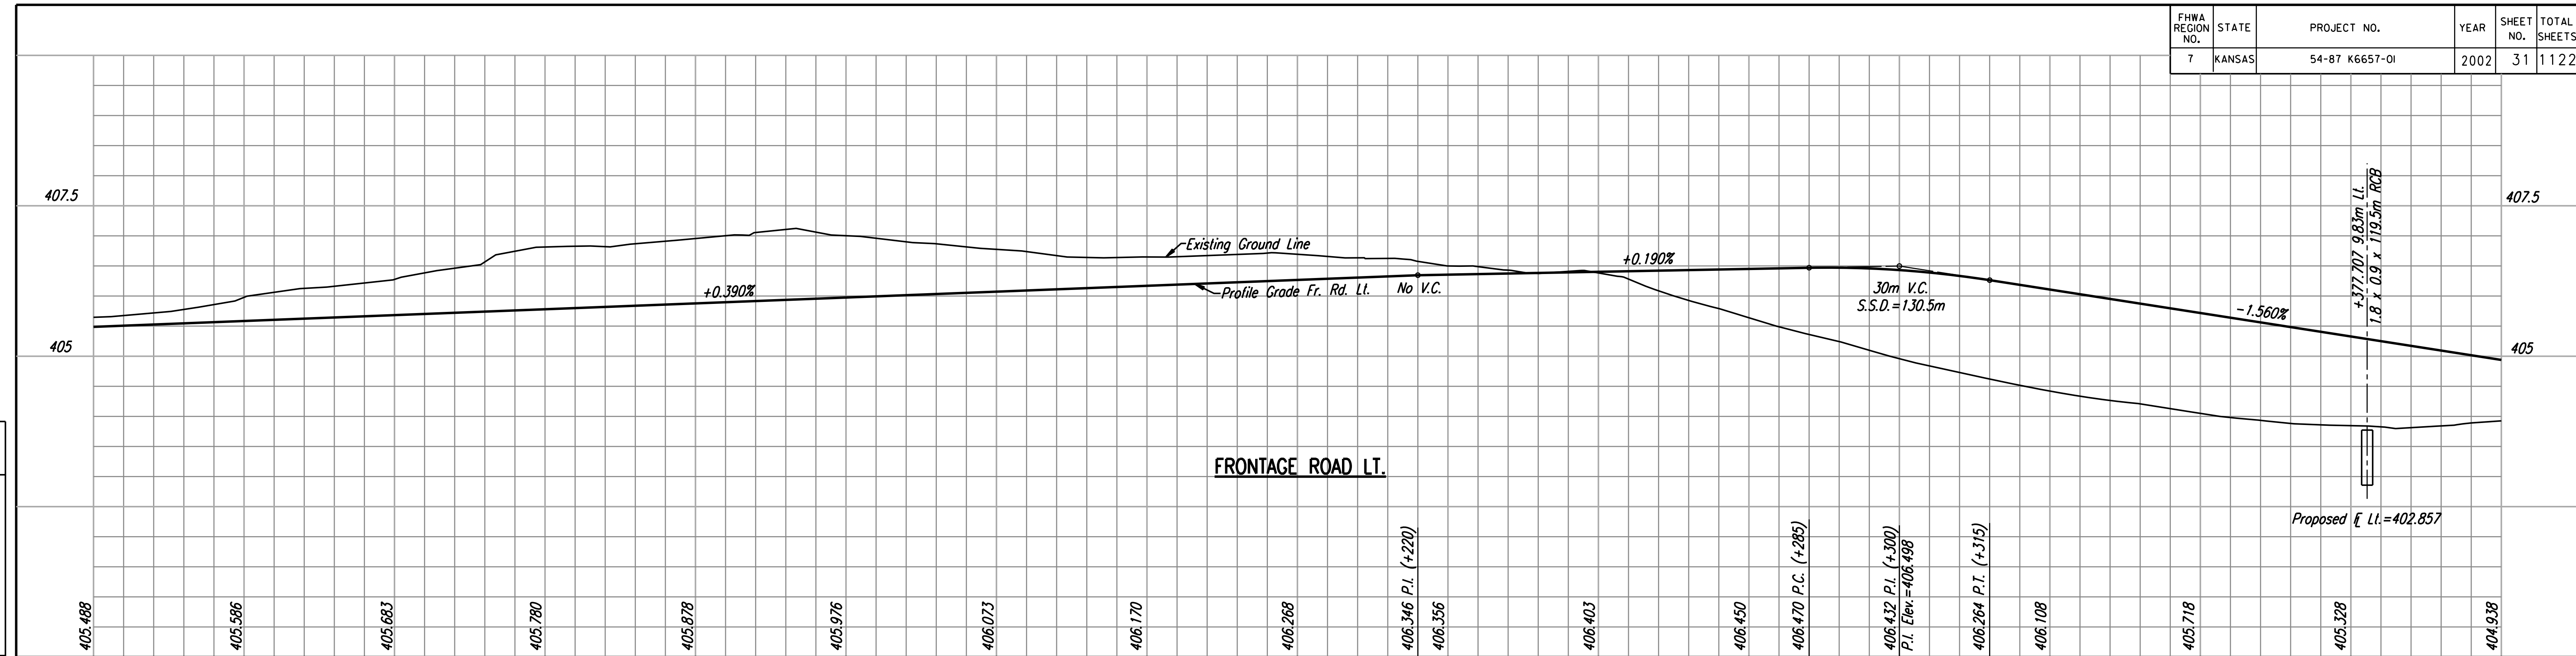

RECORD DRAWING

DSNR: WDH OPER: JGP SCALE: 1:500
 i:/1997/97362/As-Builts/dgn's/Sh 031-prfrnd150.dgn Last Rev: 8-3-07 By: gdr