
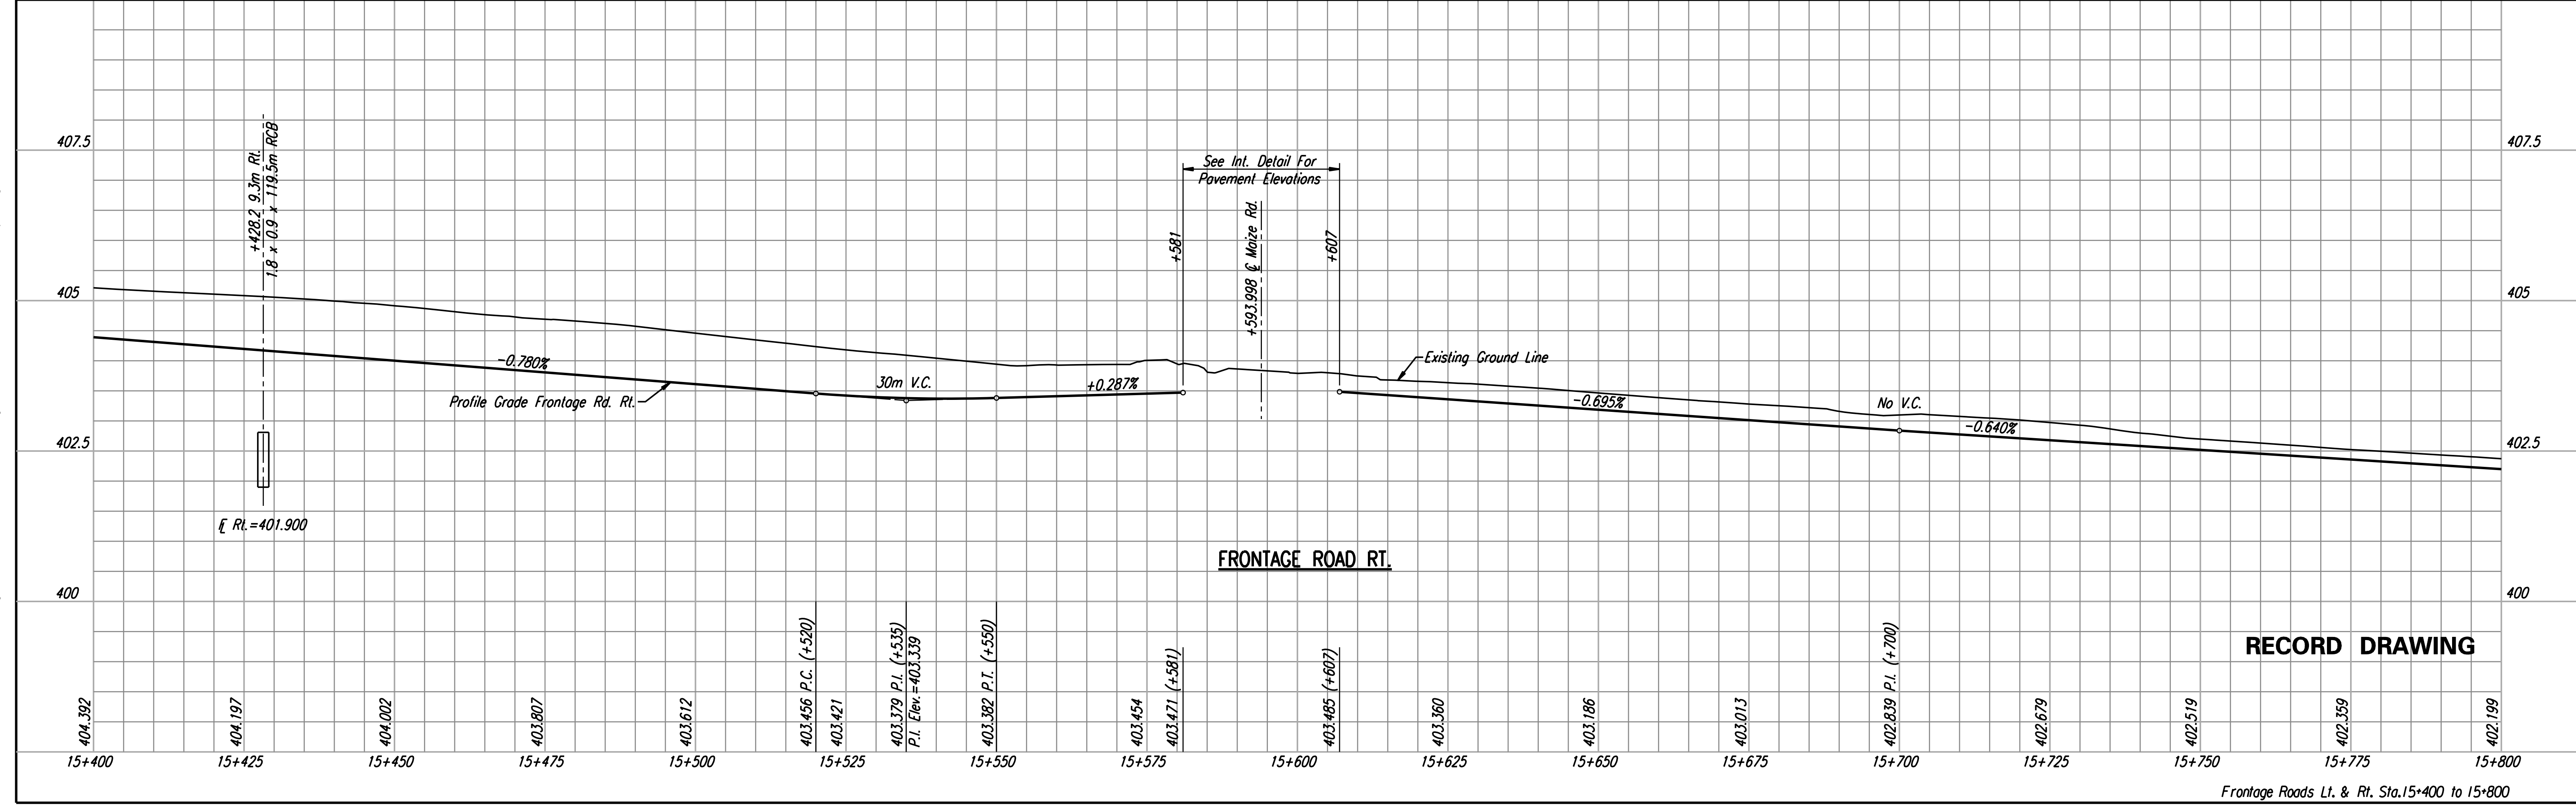


FHWA REGION NO.	STATE	PROJECT NO.	YEAR	SHEET NO.	TOTAL SHEETS
7	KANSAS	54-87 K-6657-01	2002	36	1122

REFERENCES NOTED	DATE
REFERENCES CHECKED	

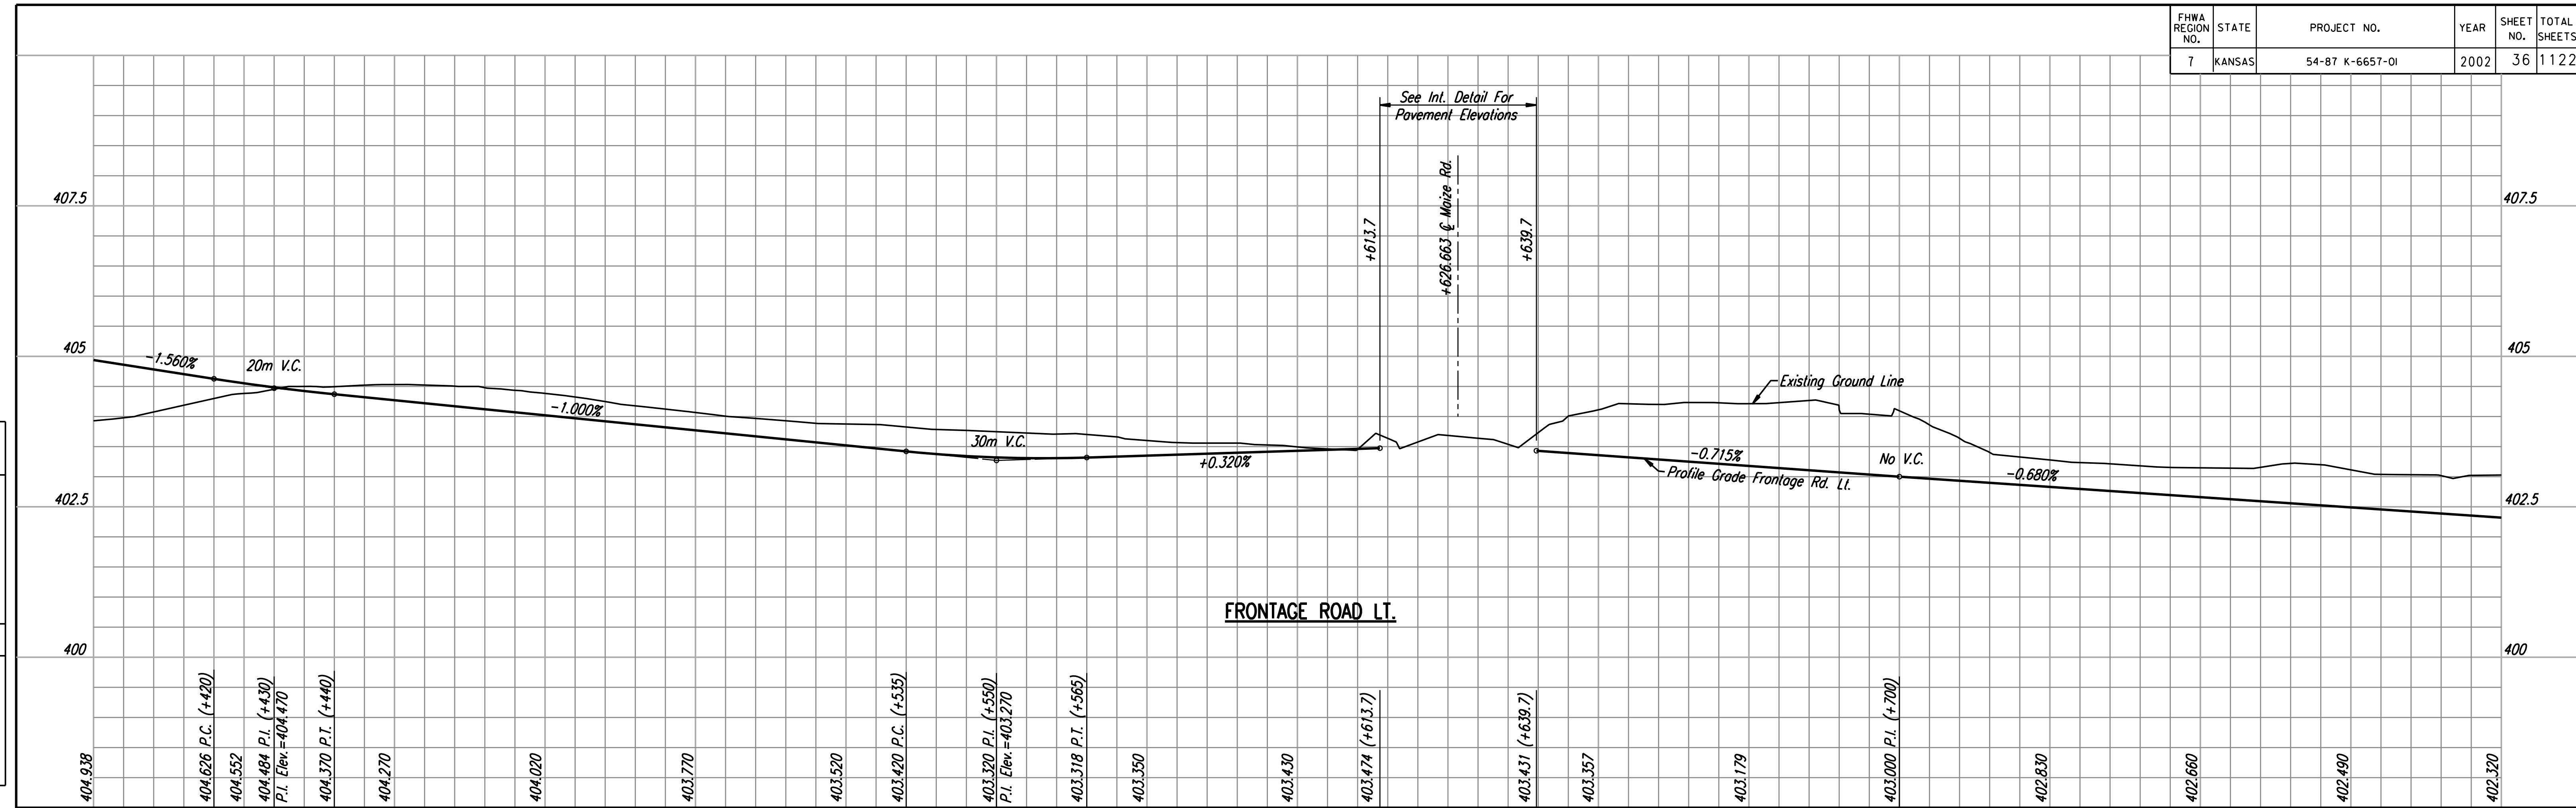

**RECORD DRAWING**

DSNR: WDH OPER: JGP SCALE: 1:500  
 i:/1997/97362/As-Builts/dgn's/Sh 036-prfrd154.dgn Last Rev: 8-6 By: gdr

Frontage Roads Lt. & Rt. Sta. 15+400 to 15+800