


FHWA REGION NO.	STATE	PROJECT NO.	YEAR	SHEET NO.	TOTAL SHEETS
7	KANSAS	54-87 K-6657-01	2002	39	1122

REFERENCES NOTED	DATE
REFERENCES CHECKED	

DSNR: WDH OPER: JGP SCALE: 1:500  
 I:/1997/97362/As-Builts/dgn's/Sh 039-pr158.dgn Last Rev: 8-6-07 By: gdr

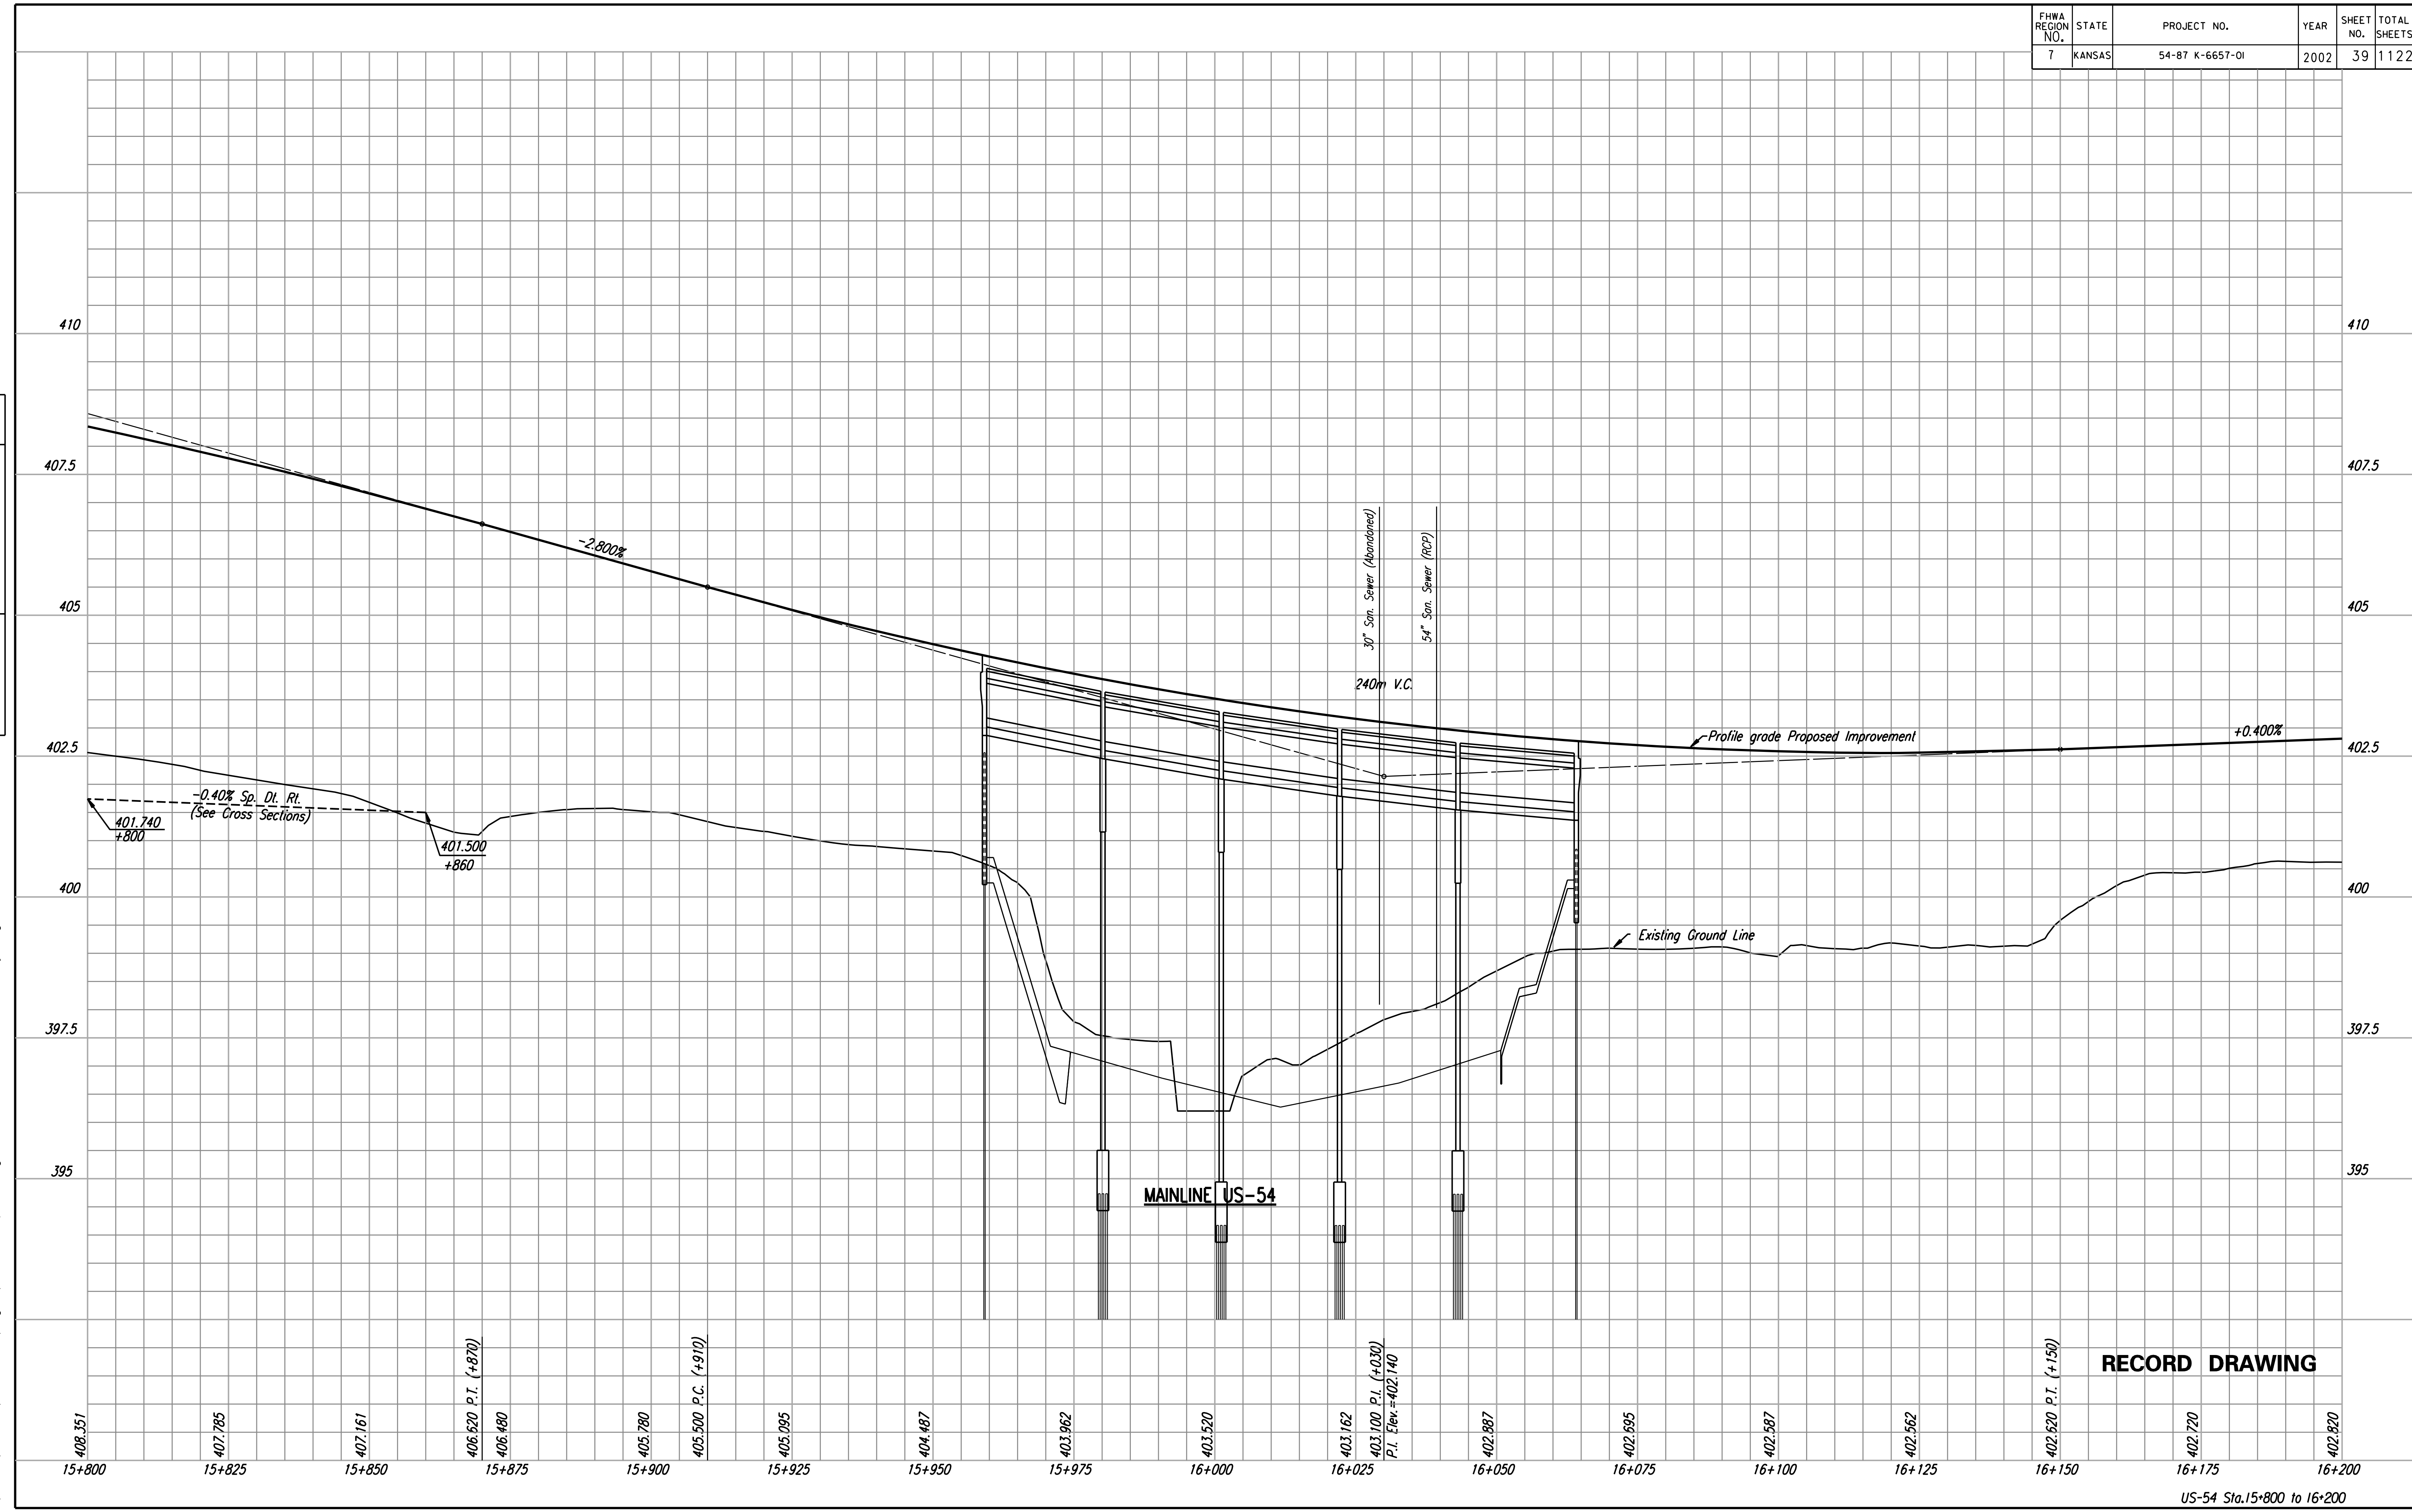

RECORD DRAWING

US-54 Sta. 15+800 to 16+200