
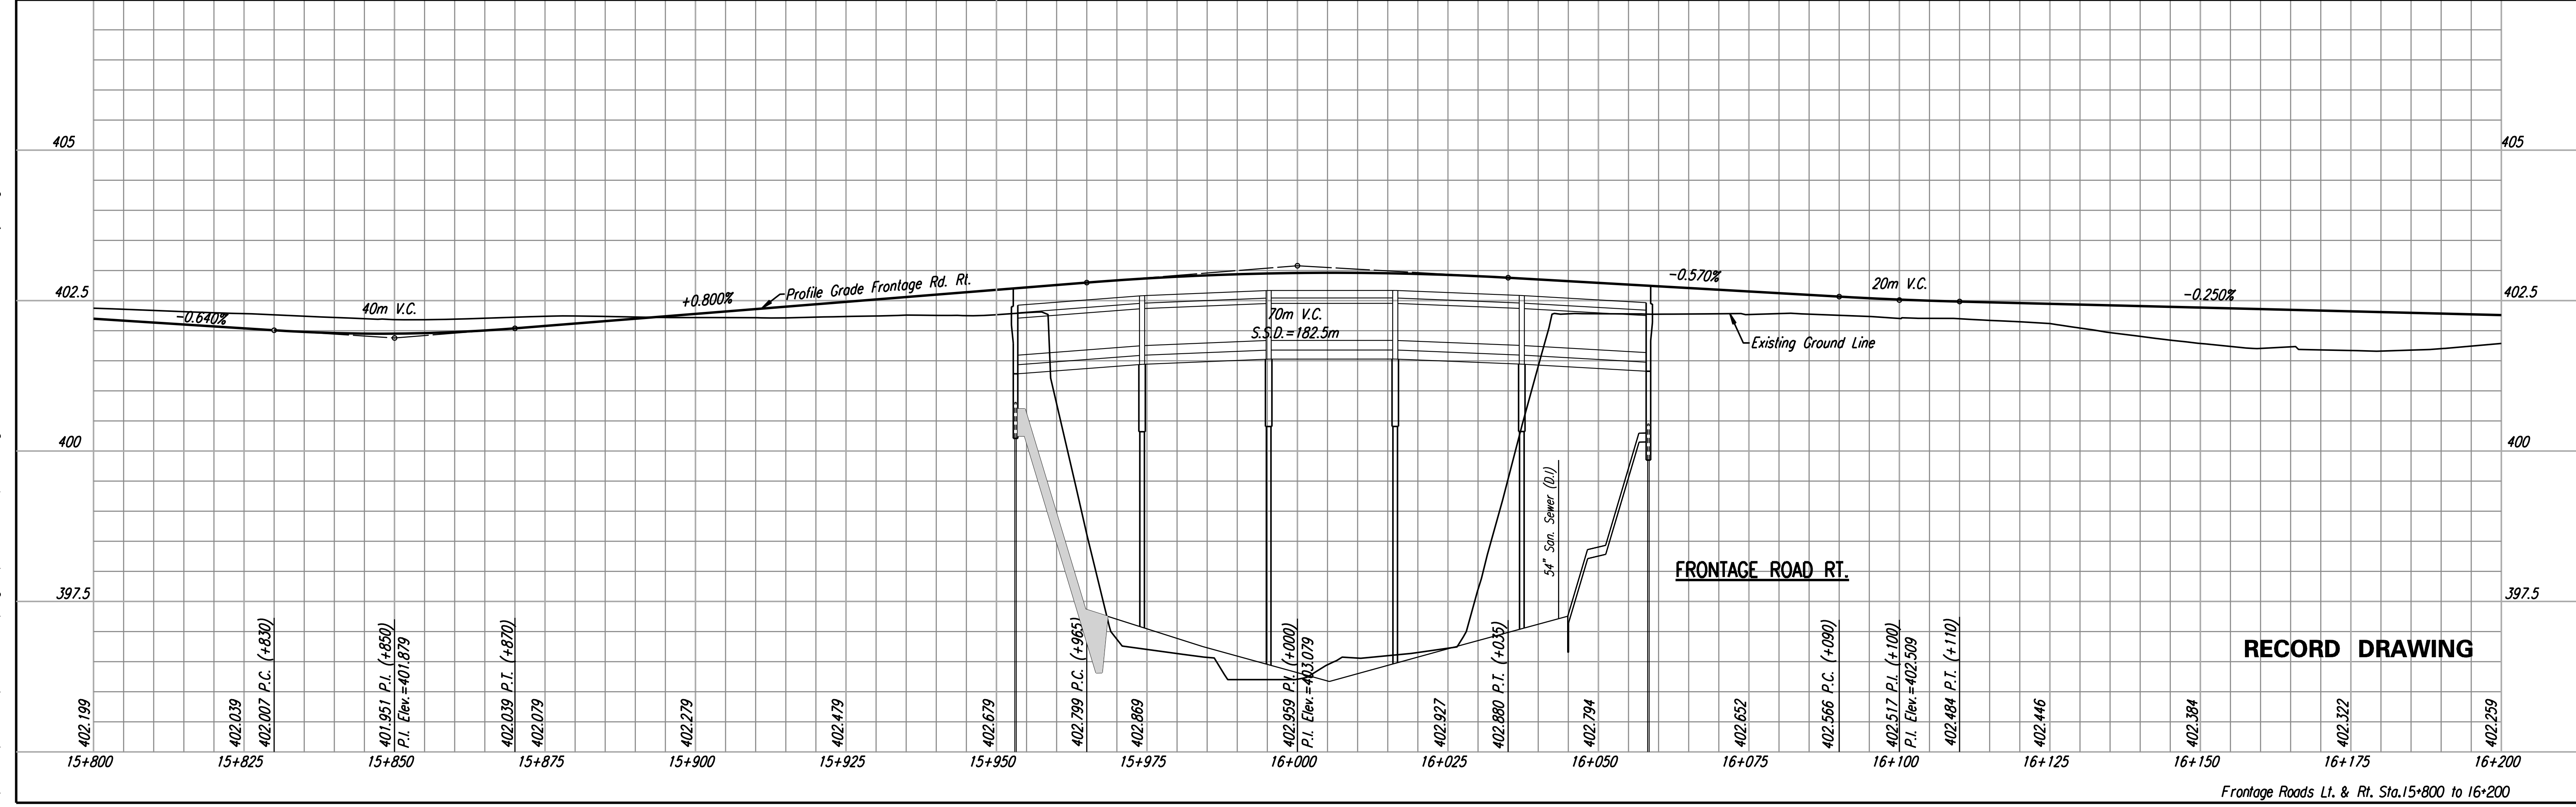


FHWA REGION NO.	STATE	PROJECT NO.	YEAR	SHEET NO.	TOTAL SHEETS
7	KANSAS	54-87 K-6657-01	2002	40	1122

REFERENCES NOTED	BY	DATE
REFERENCES CHECKED		

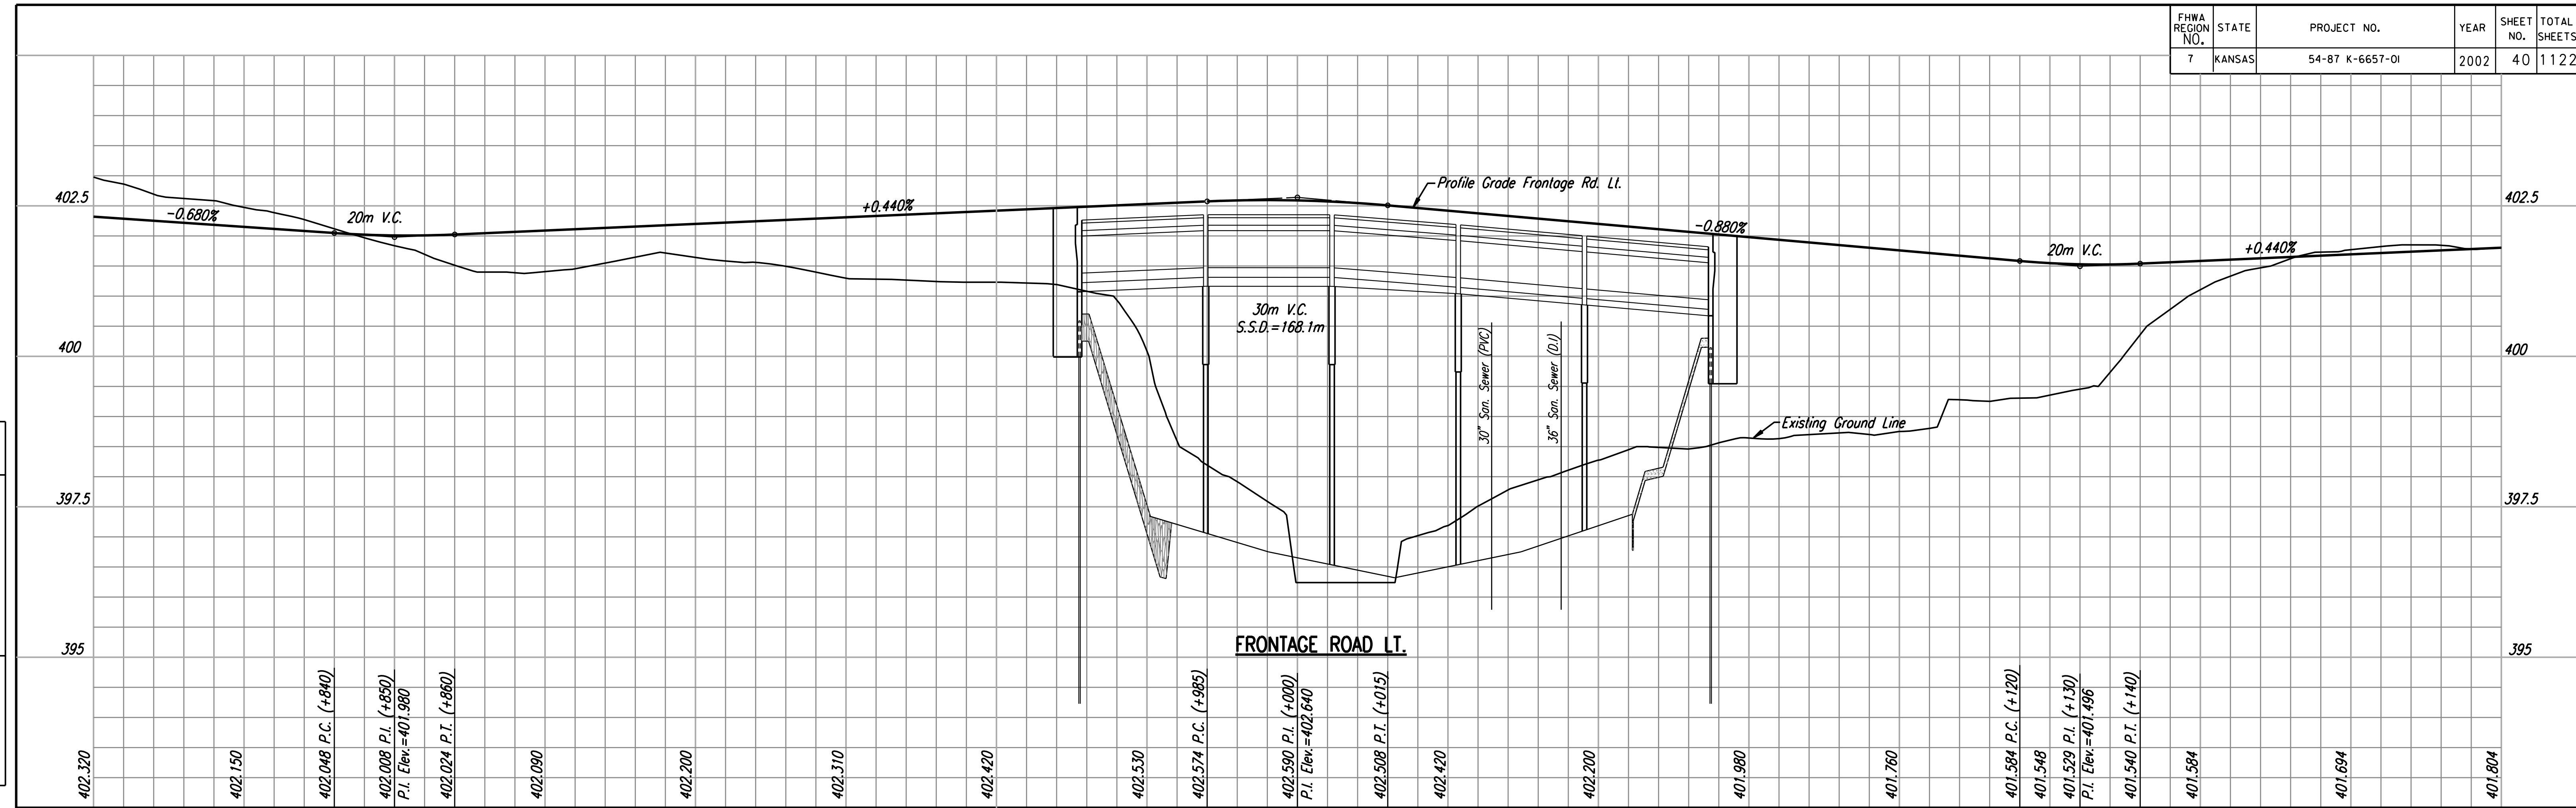

RECORD DRAWING

DSNR: WDH OPER: JGP SCALE: 1:500
 I:/1997/97362/As-Builts/dgn's/Sh 040-prfrd.dgn Last Rev: 8-6-07 By: gdr

Frontage Roads Lt. & Rt. Sta. 15+800 to 16+200