


FHWA REGION NO.	STATE	PROJECT NO.	YEAR	SHEET NO.	TOTAL SHEETS
7	KANSAS	54-87 K-6657-01	2002	43	1122

REFERENCES NOTED	BY	DATE
REFERENCES CHECKED		

DSWR: WDH OPER: JGP SCALE: 1:500
 i:/1997/97362/As-Builts/dgn's/Sh 043-pr162-dgn Last Rev: 8-6-07 By: gdr

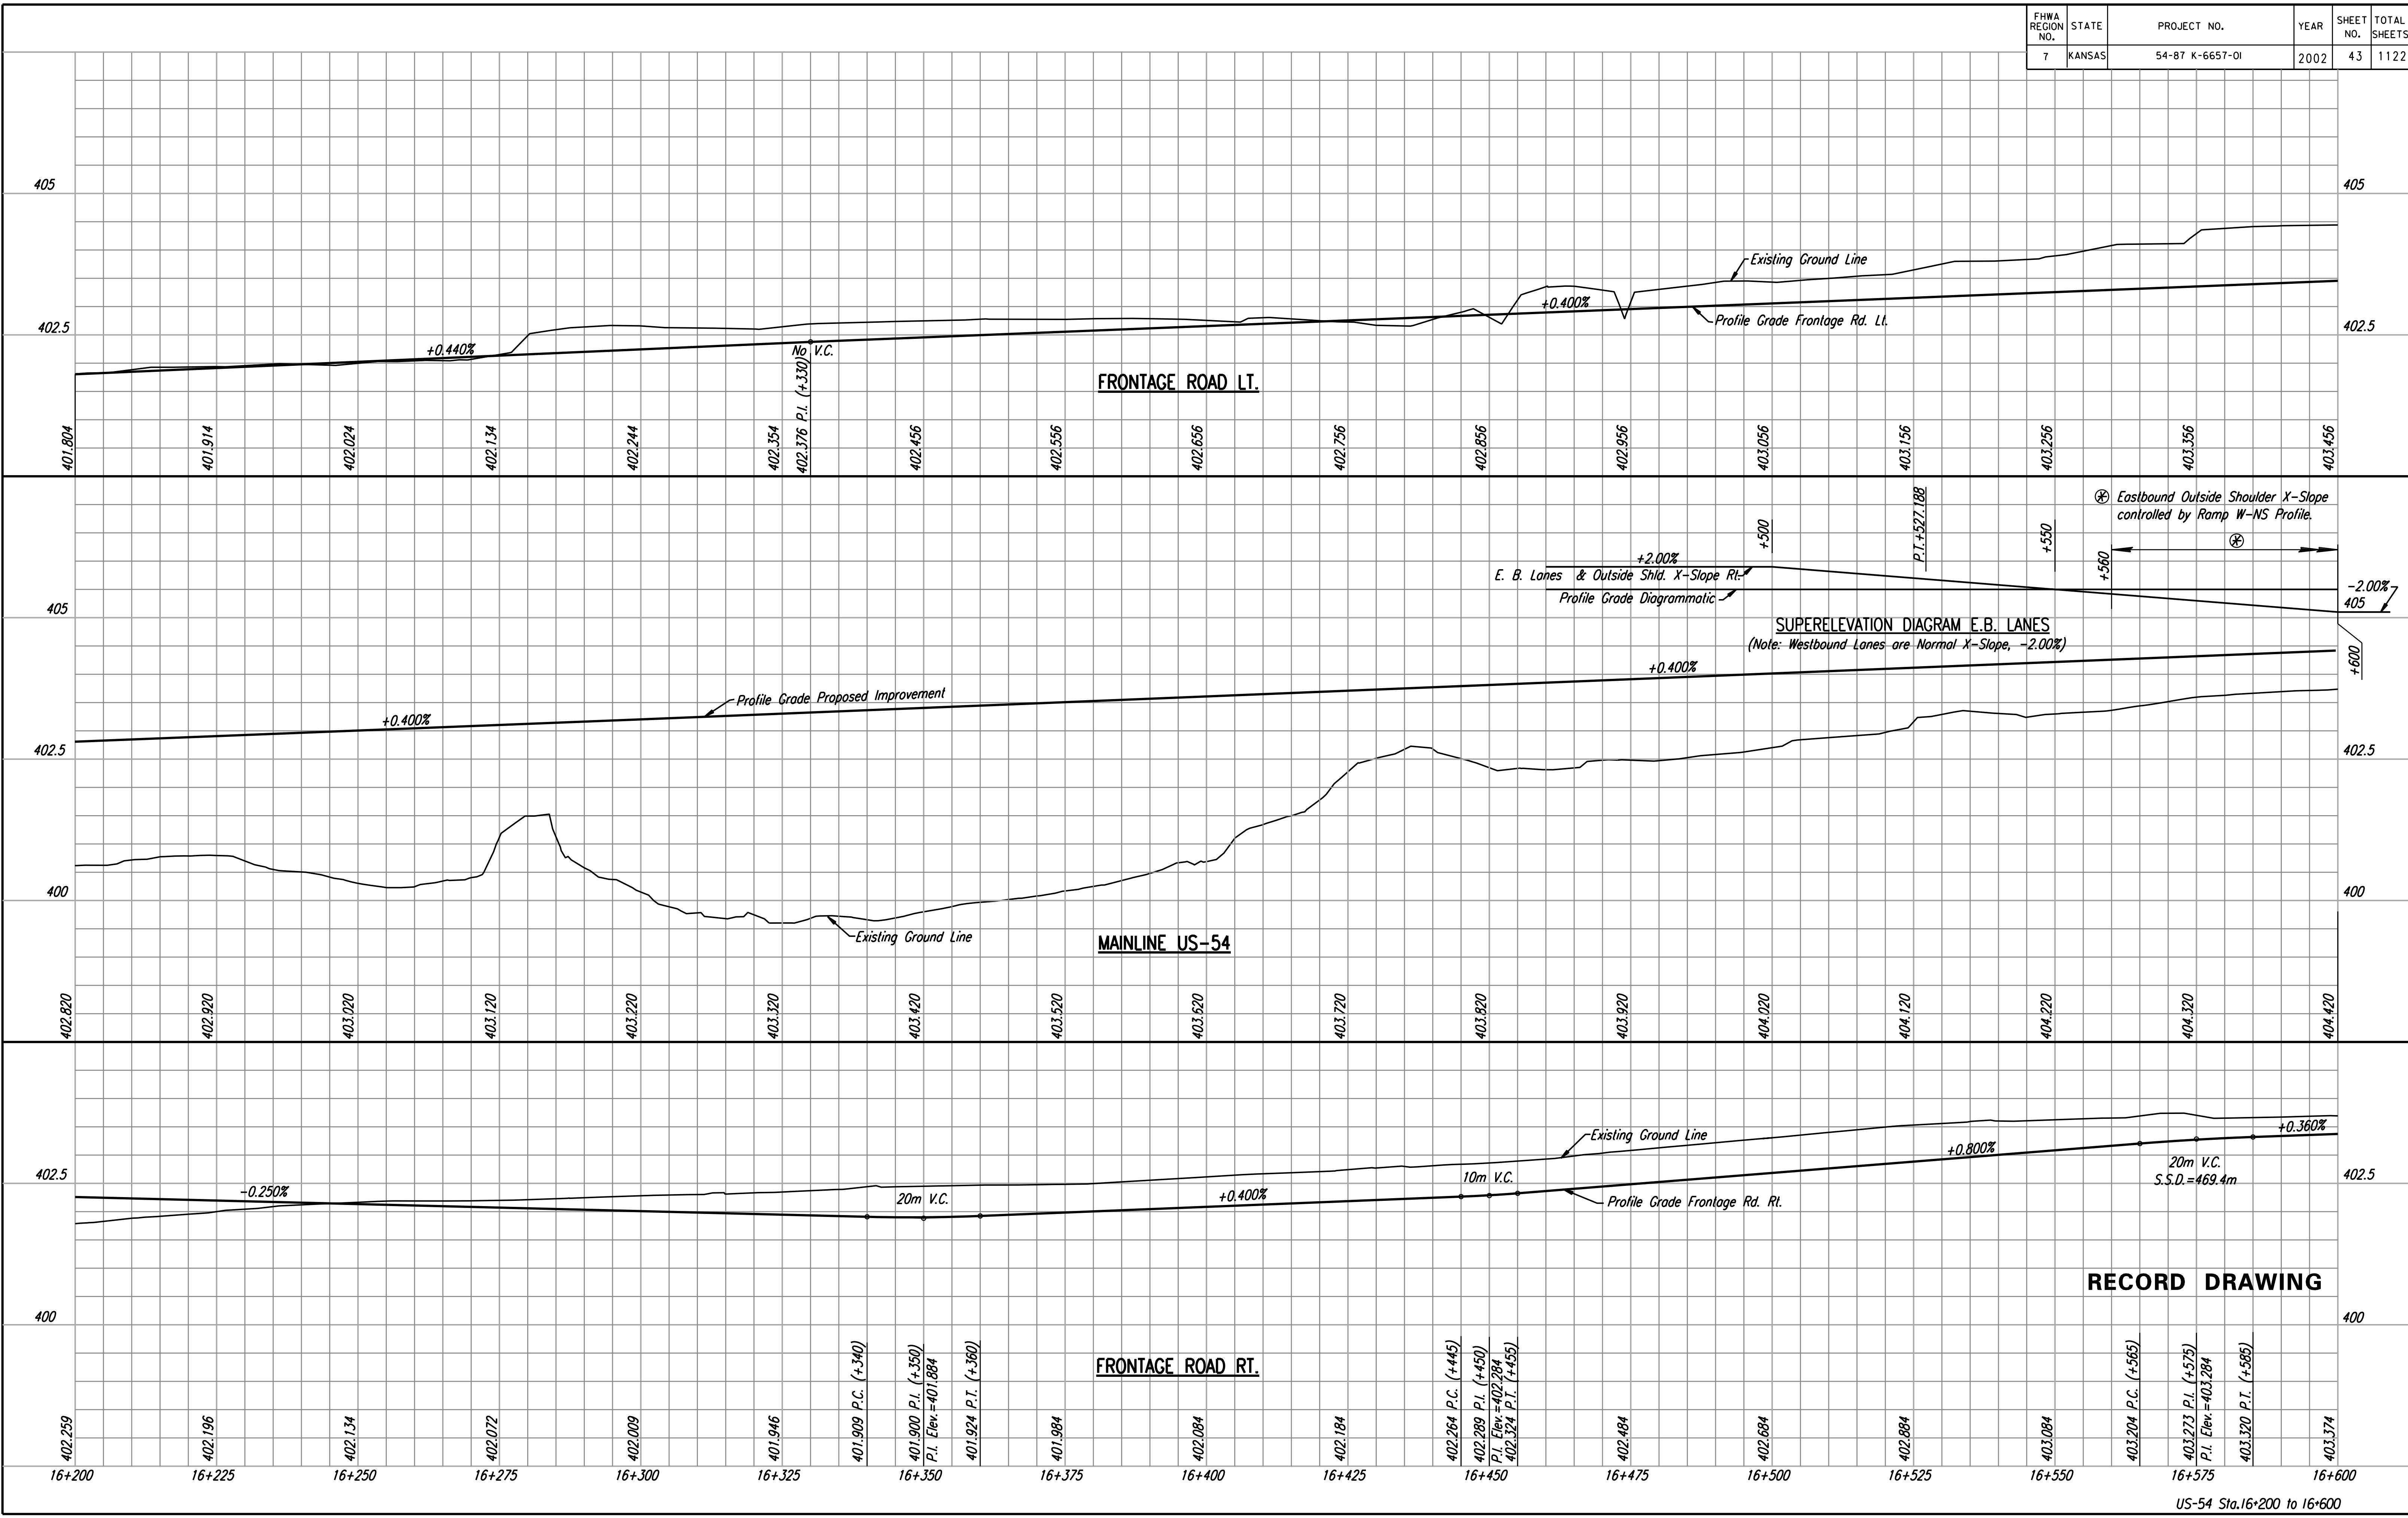

RECORD DRAWING