


FHWA REGION NO.	STATE	PROJECT NO.	YEAR	SHEET NO.	TOTAL SHEETS
7	KANSAS	54-87 K-6657-01	2002	60	1122

REFERENCES NOTED	BY	DATE
REFERENCES CHECKED		

DSNR: WDH OPER: JGP SCALE: 1:500  
 I:\1997\97362\As-Builts\ dgn's\Sh 060-pr178.dgn Last Rev: 8-8-07 By: gdr

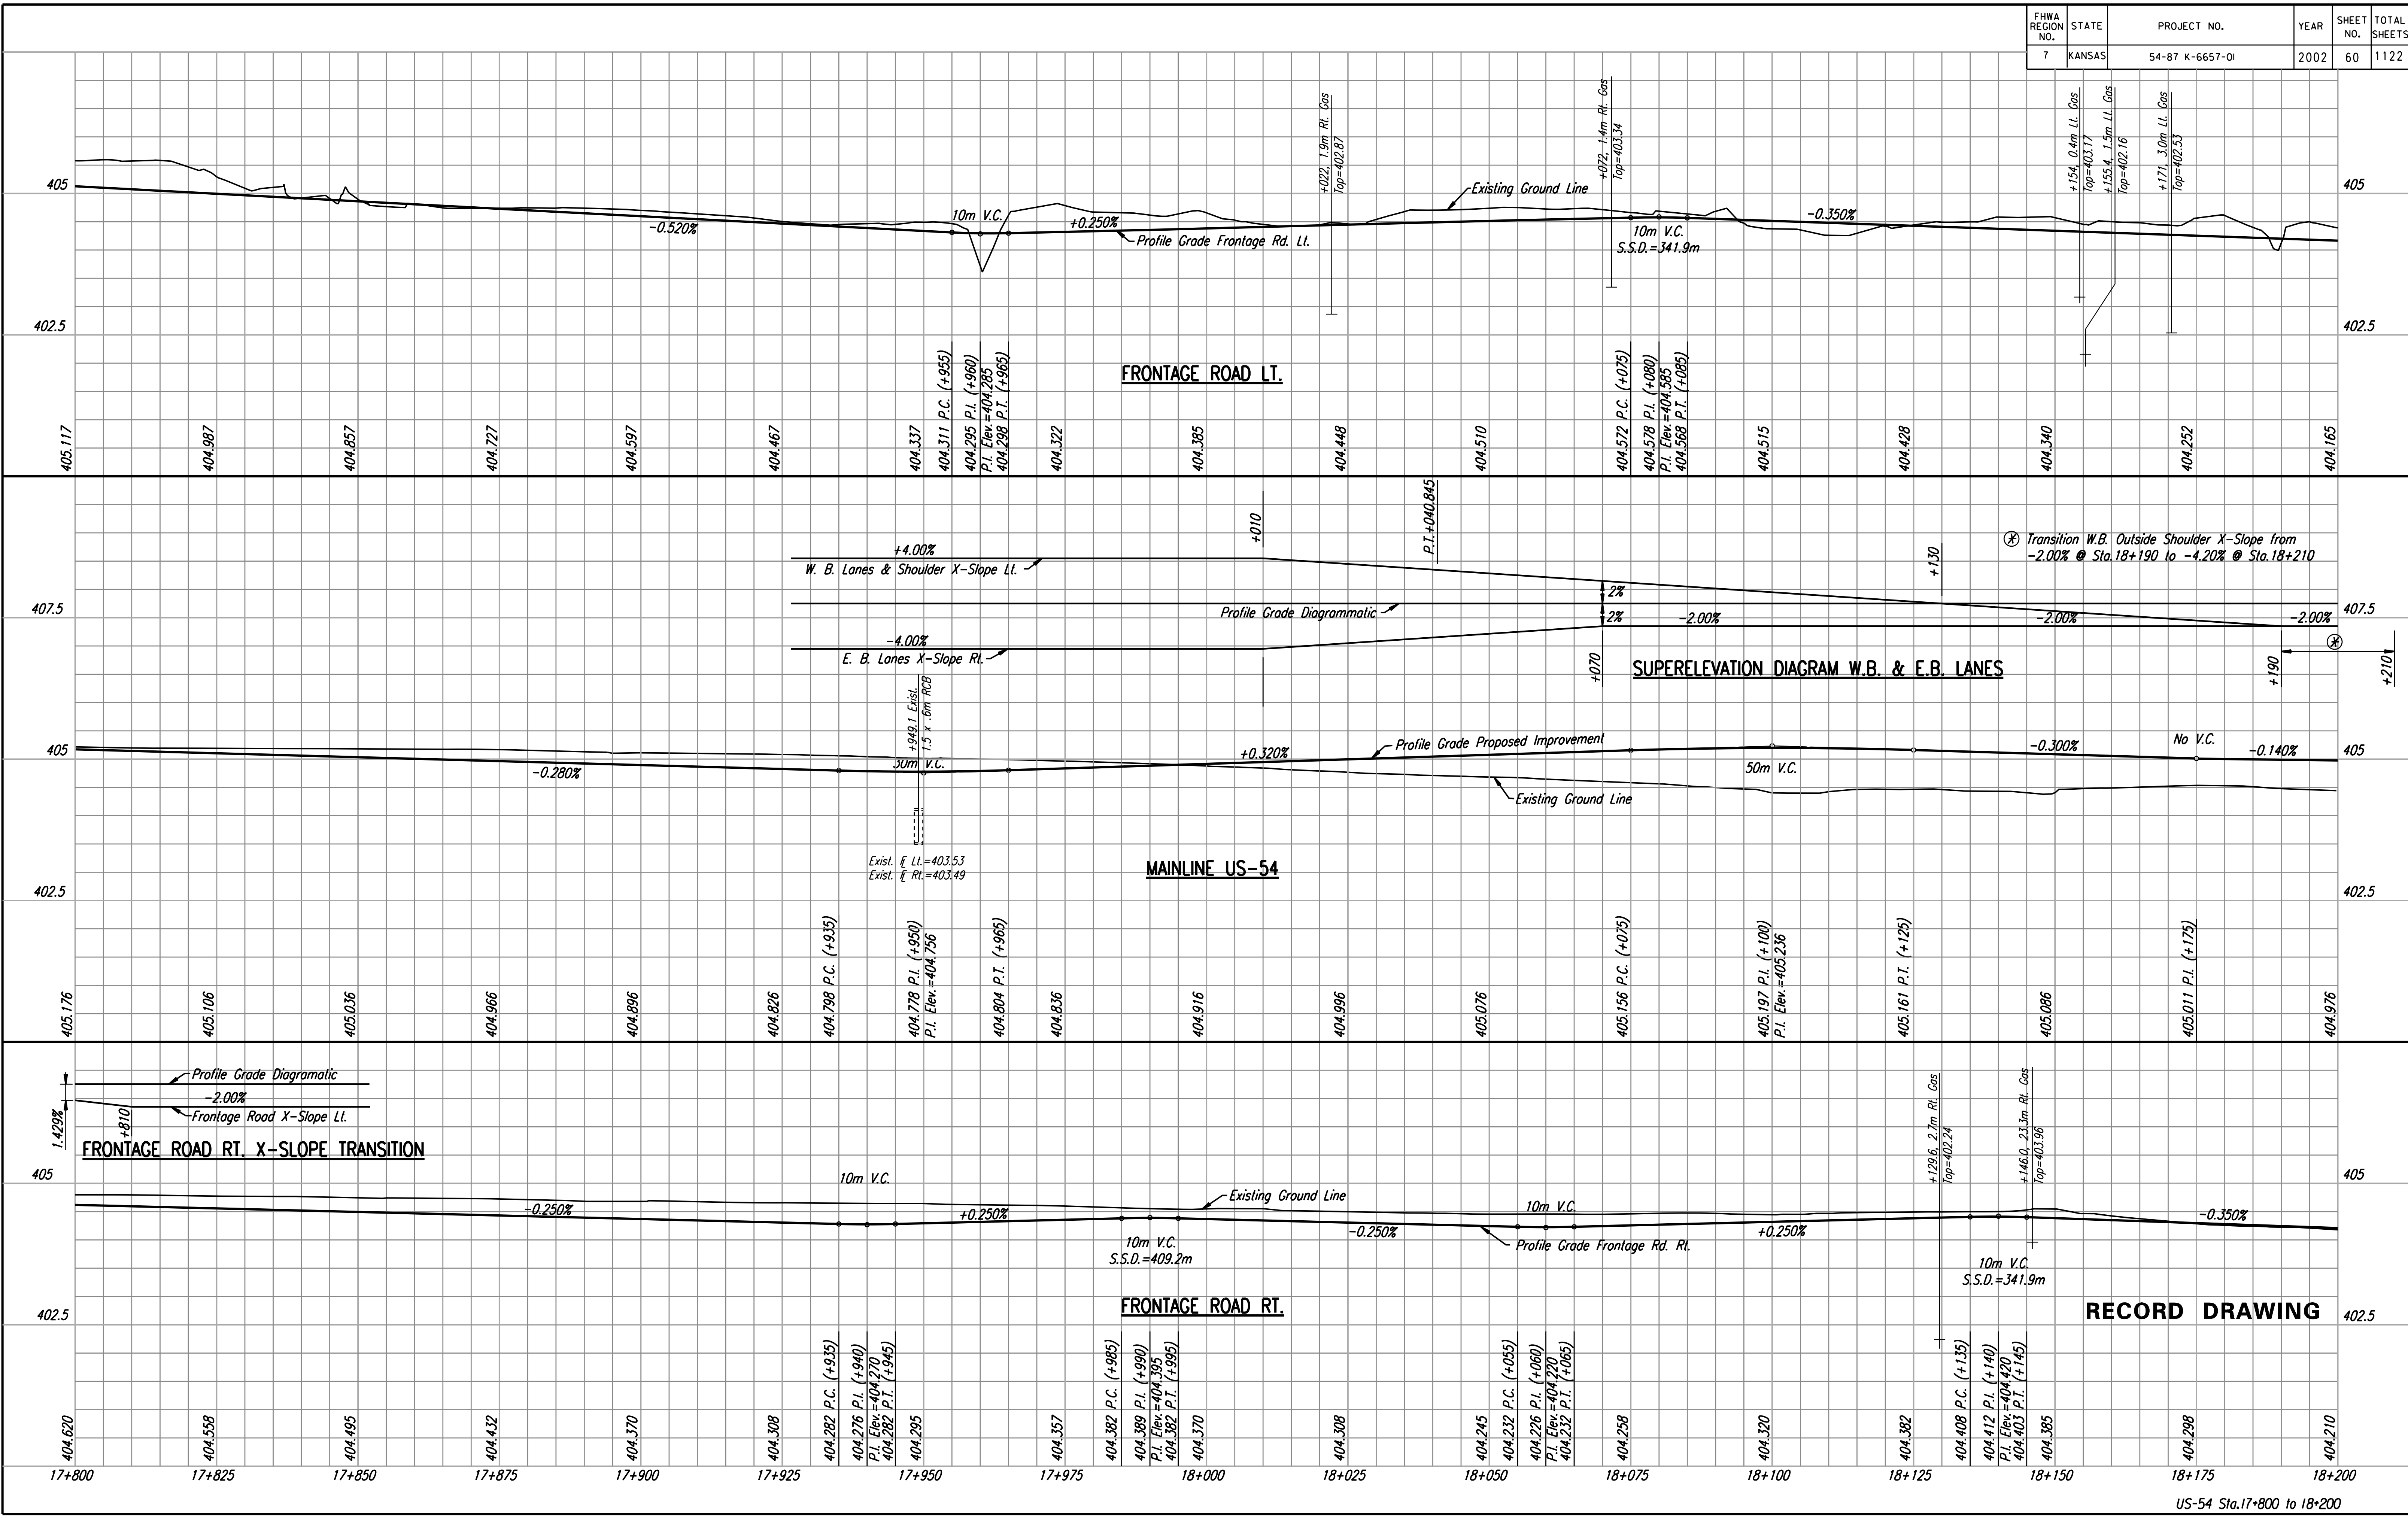

**RECORD DRAWING**