


FHWA REGION NO.	STATE	PROJECT NO.	YEAR	SHEET NO.	TOTAL SHEETS
7	KANSAS	54-87 K-6657-01	2002	67	1122

BY	DATE
REFERENCES NOTED	
REFERENCES CHECKED	

DSNR: JPS OPER: JGP SCALE: 1:500
 I:/1997/97362/As-Builts/dgn's/Sh 067-Maize-pr3900.dgn Last Rev: 8-8-07 By: gdr

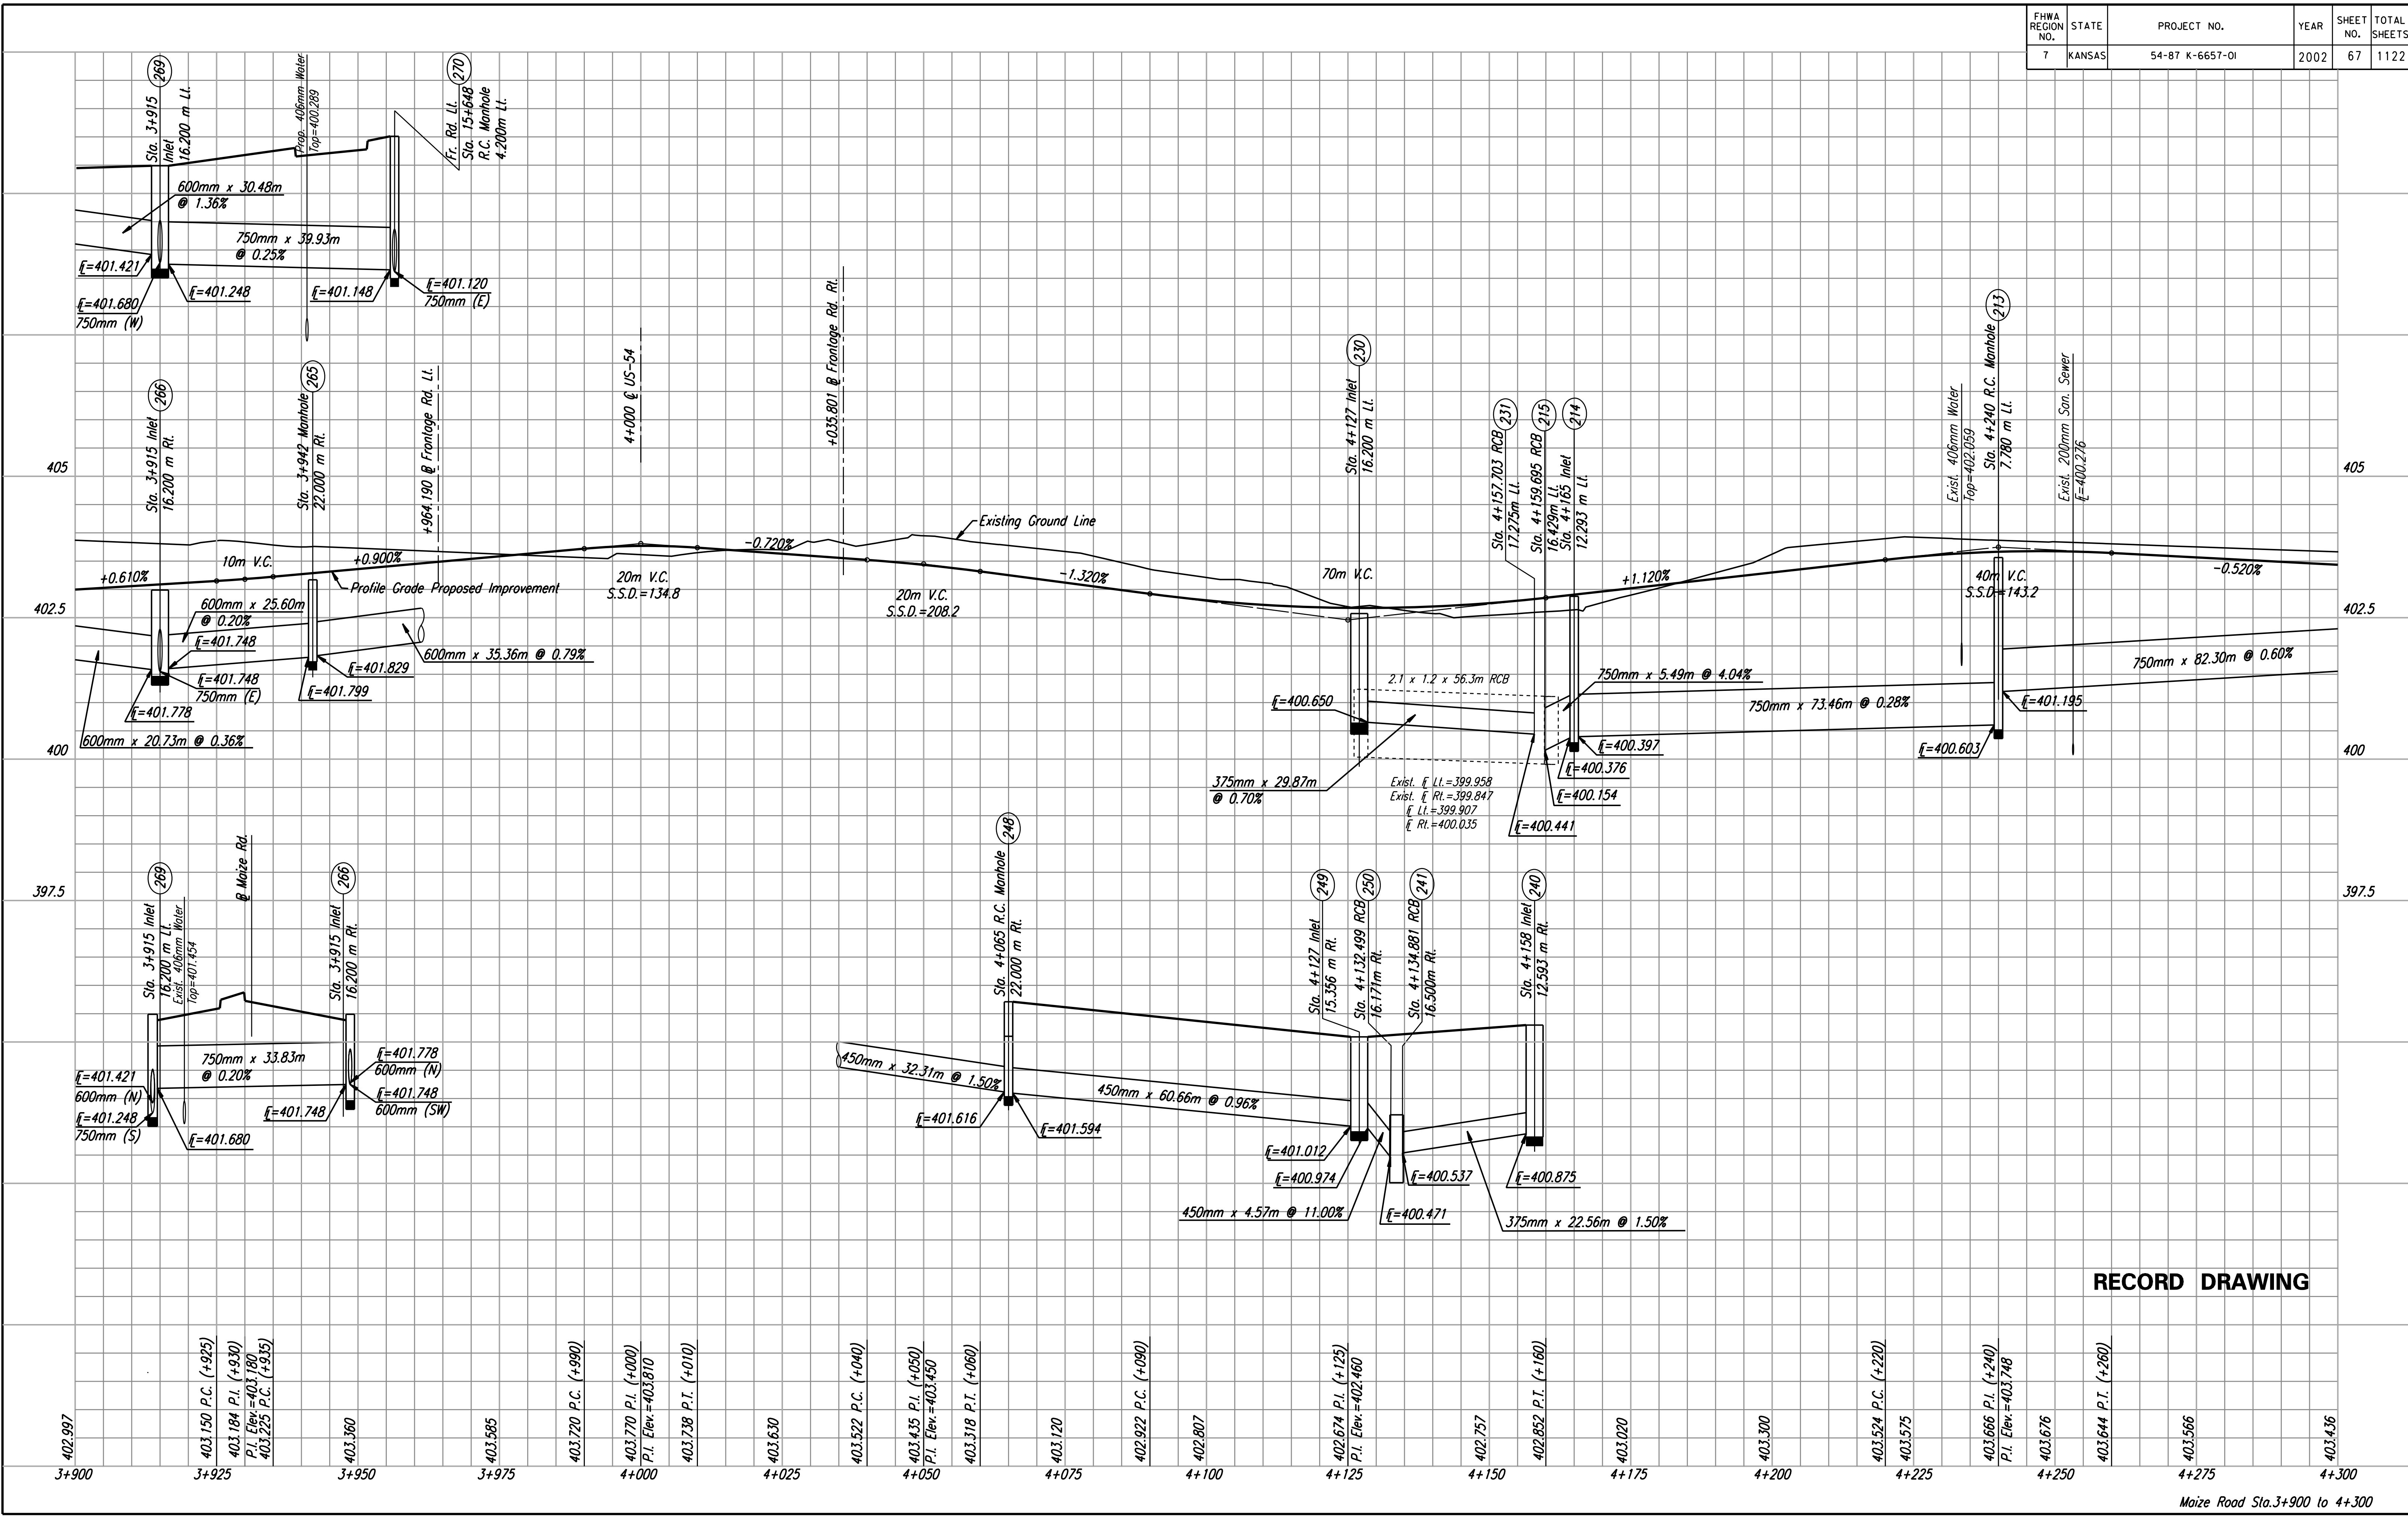

RECORD DRAWING

Maize Road Sta. 3+900 to 4+300