


FHWA REGION NO.	STATE	PROJECT NO.	YEAR	SHEET NO.	TOTAL SHEETS
7	KANSAS	54-87 K-6657-01	2002	75	1122

REFERENCES NOTED	DATE
REFERENCES CHECKED	

DSNR: RCH OPER: JGP SCALE: 1:500  
 I:/1997/97362/As-Built/dgn's/Sh 075-Tyler-pr55ty.dgn Last Rev: 8-9-07 By: gdr

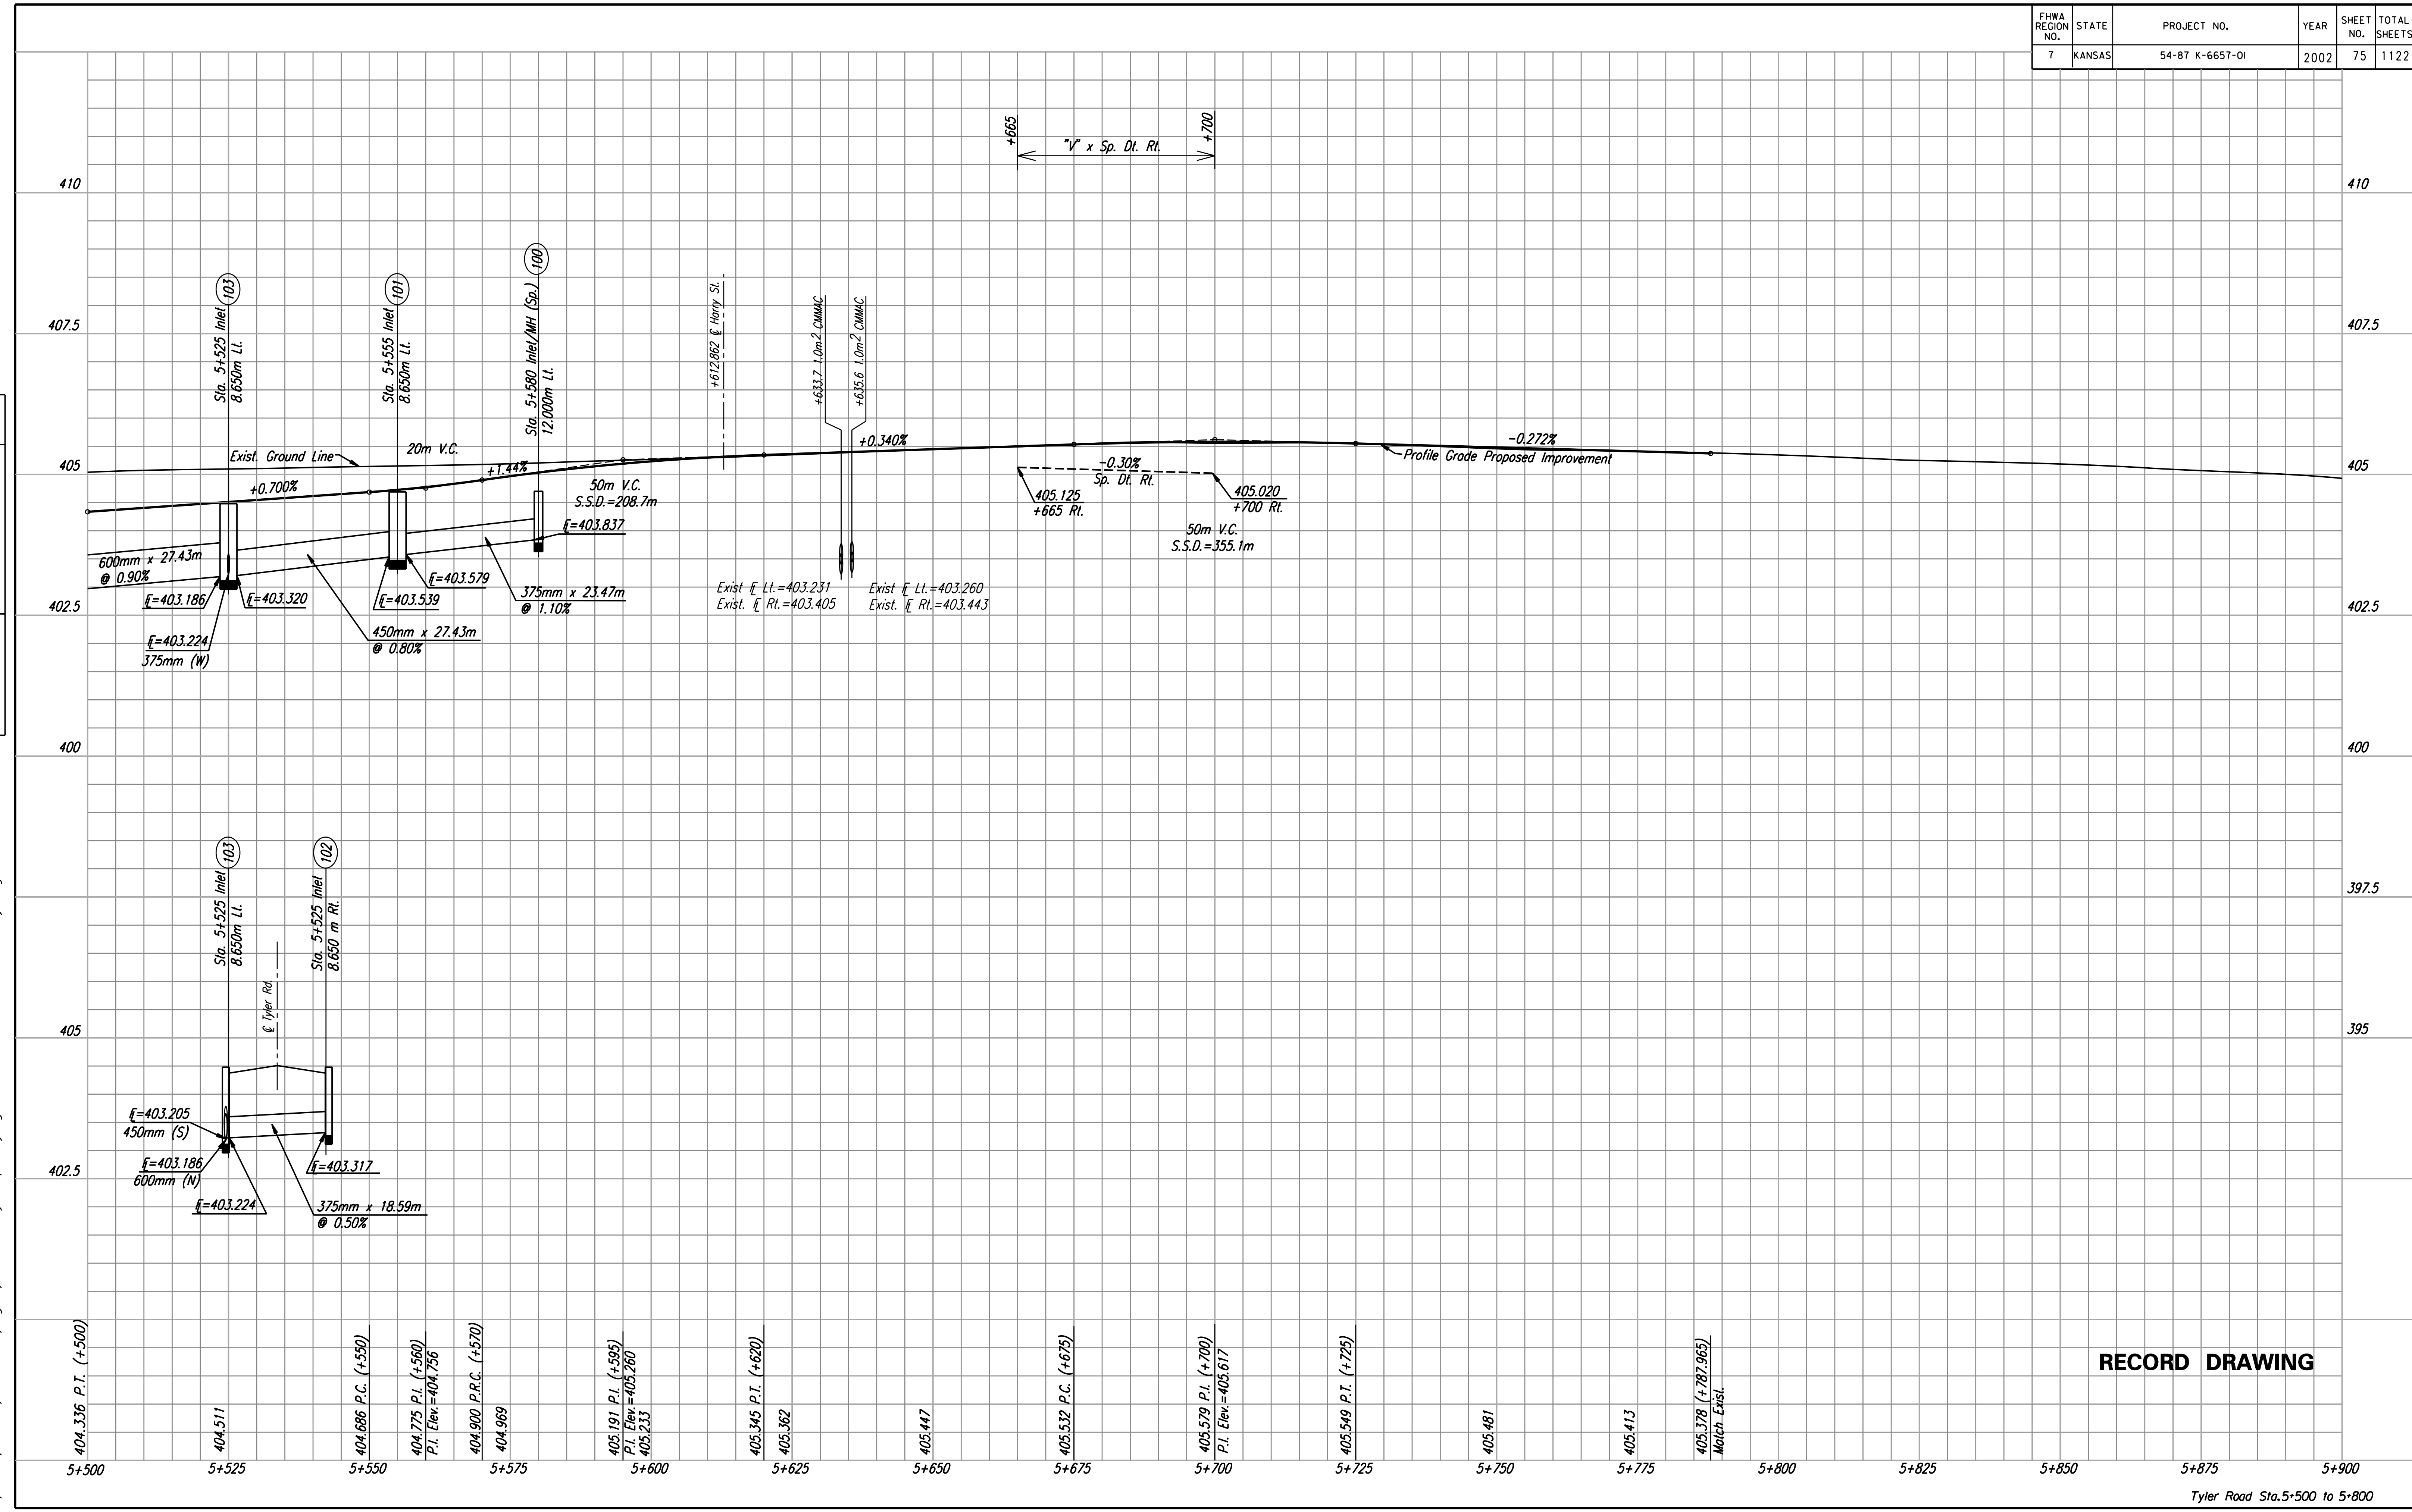

**RECORD DRAWING**