
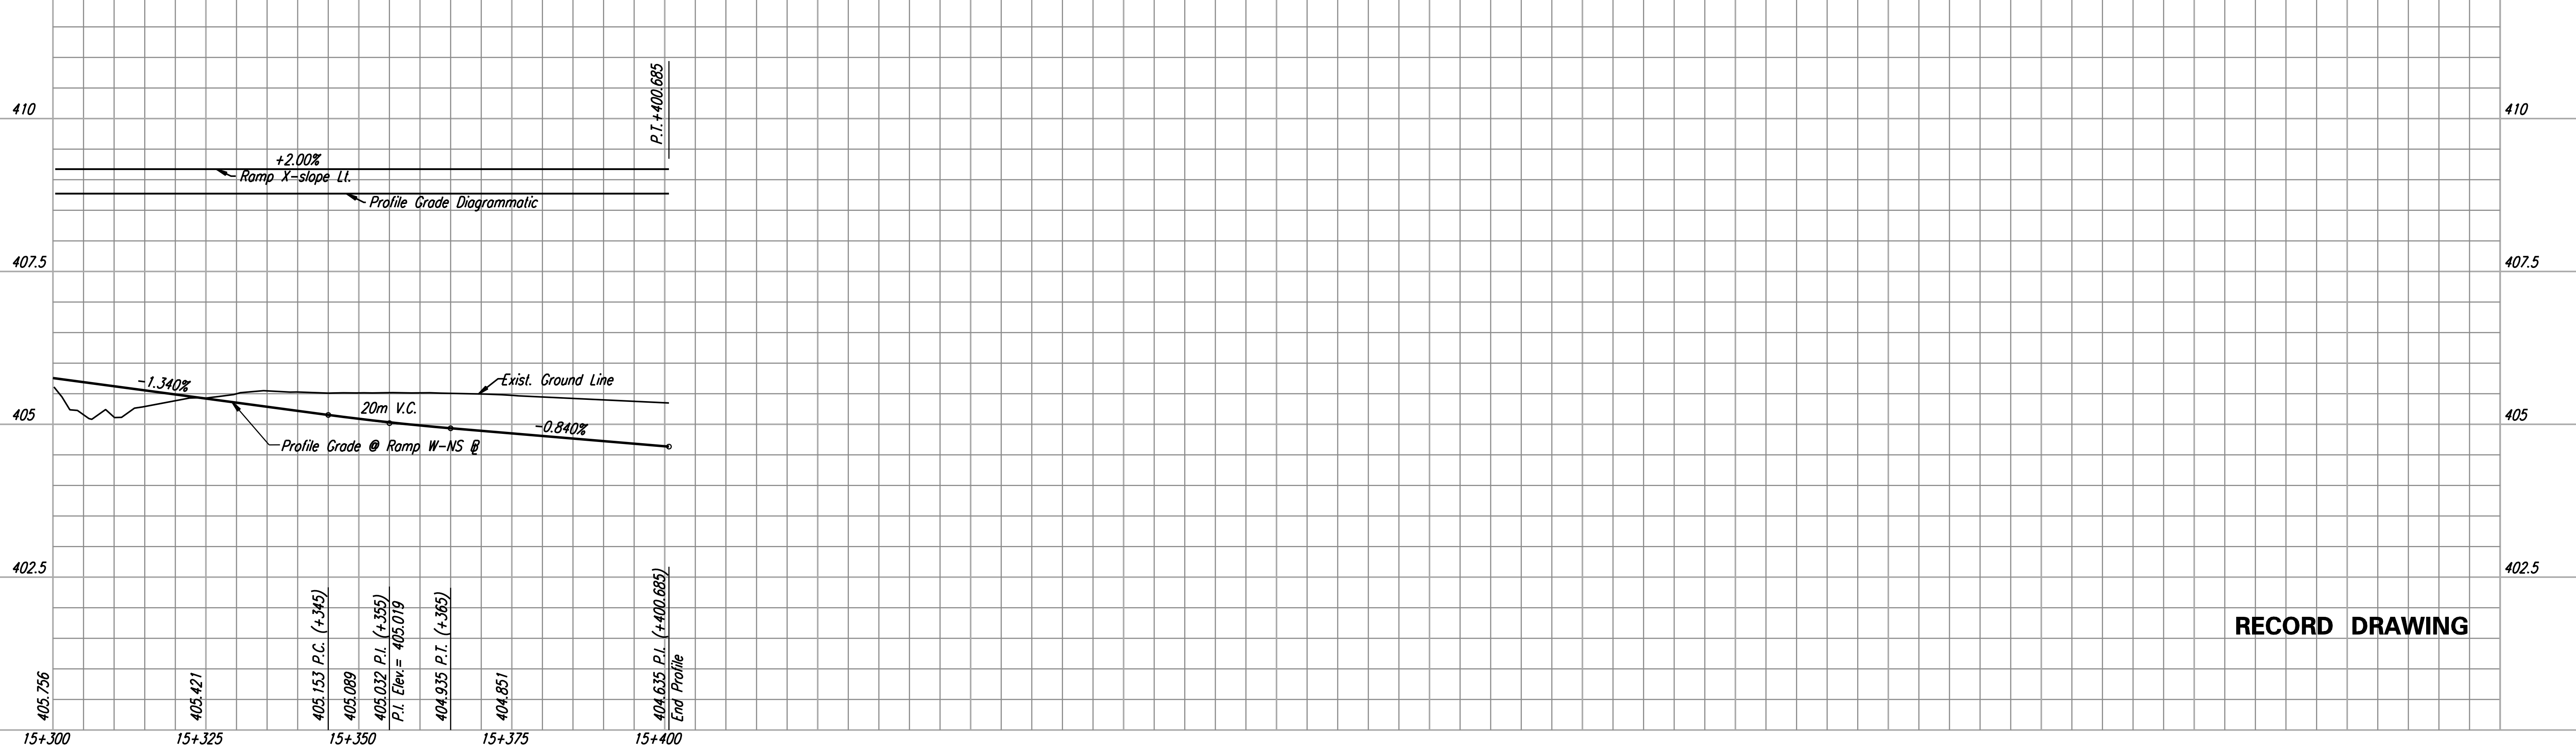


FHWA REGION NO.	STATE	PROJECT NO.	YEAR	SHEET NO.	TOTAL SHEETS
7	KANSAS	54-87 K-6657-01	2002	76	1122

REFERENCES NOTED	DATE
REFERENCES CHECKED	

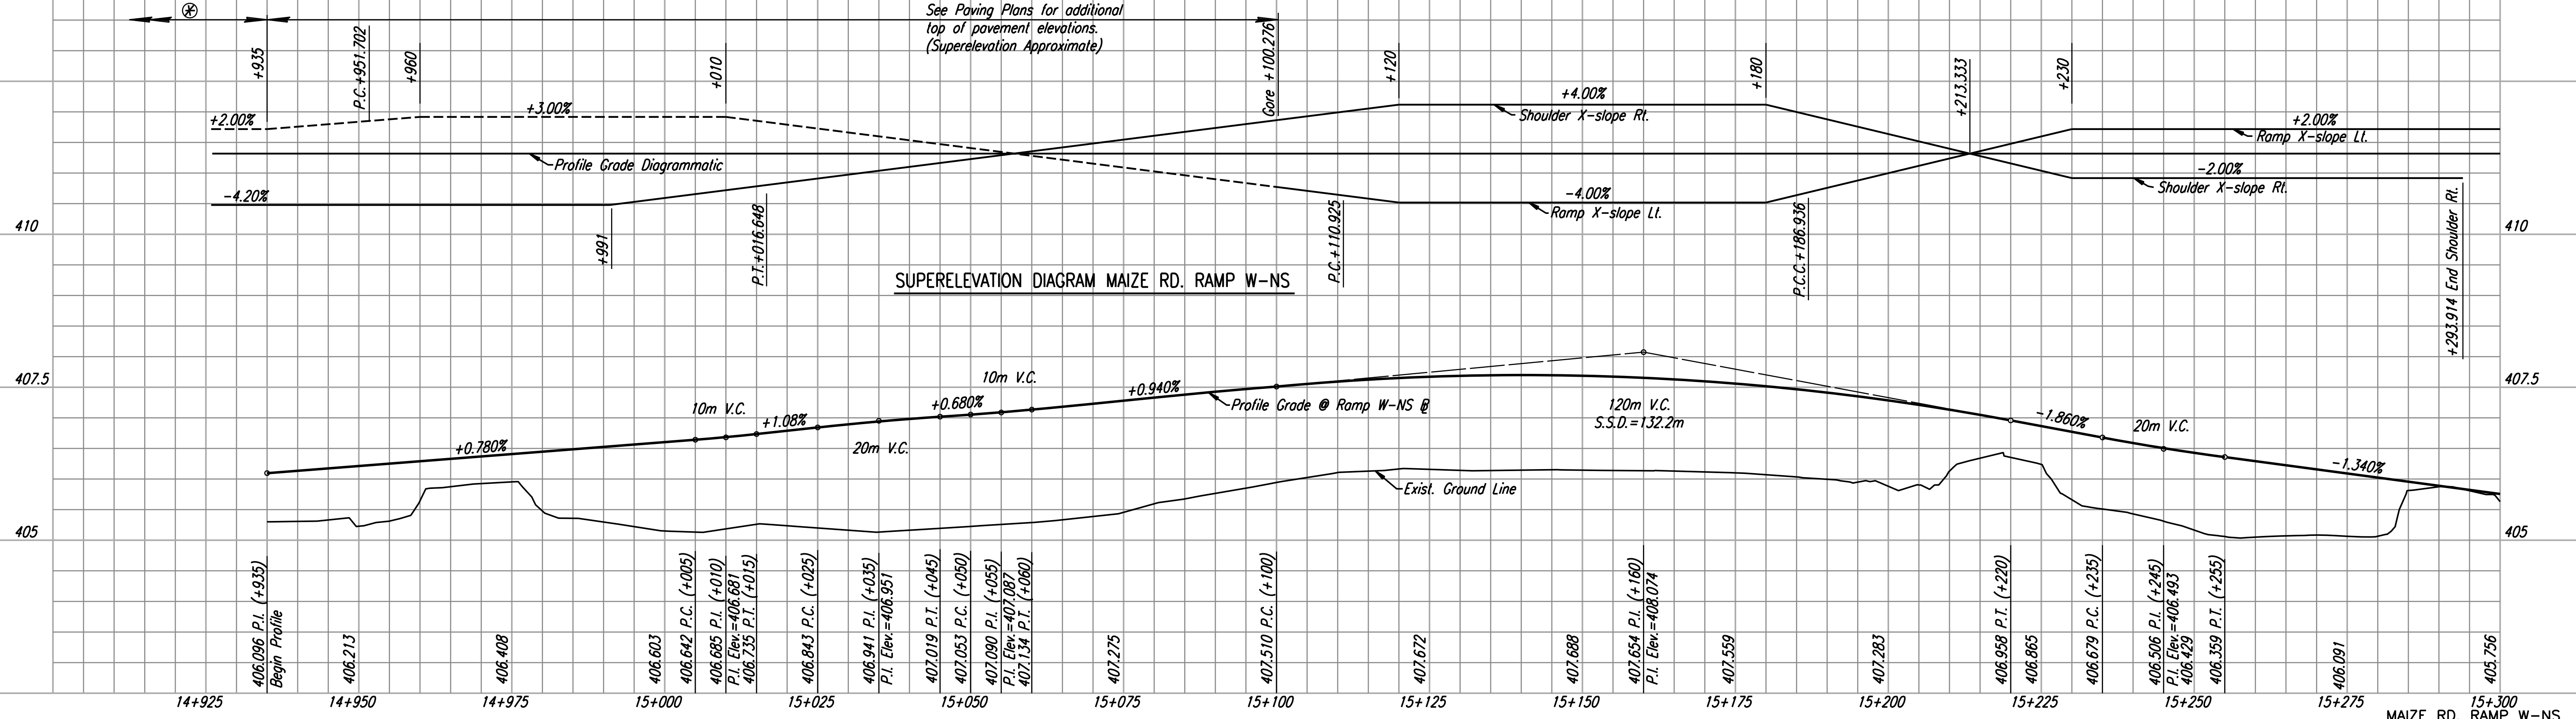

RECORD DRAWING

DSNR: JPS OPER: JGP SCALE: 1:500
 i:/1997/97362/As-Builts/dgn's/Sh 076-Maize-wmzrmp.dgn Last Rev: 8-9-07 By: gdr