
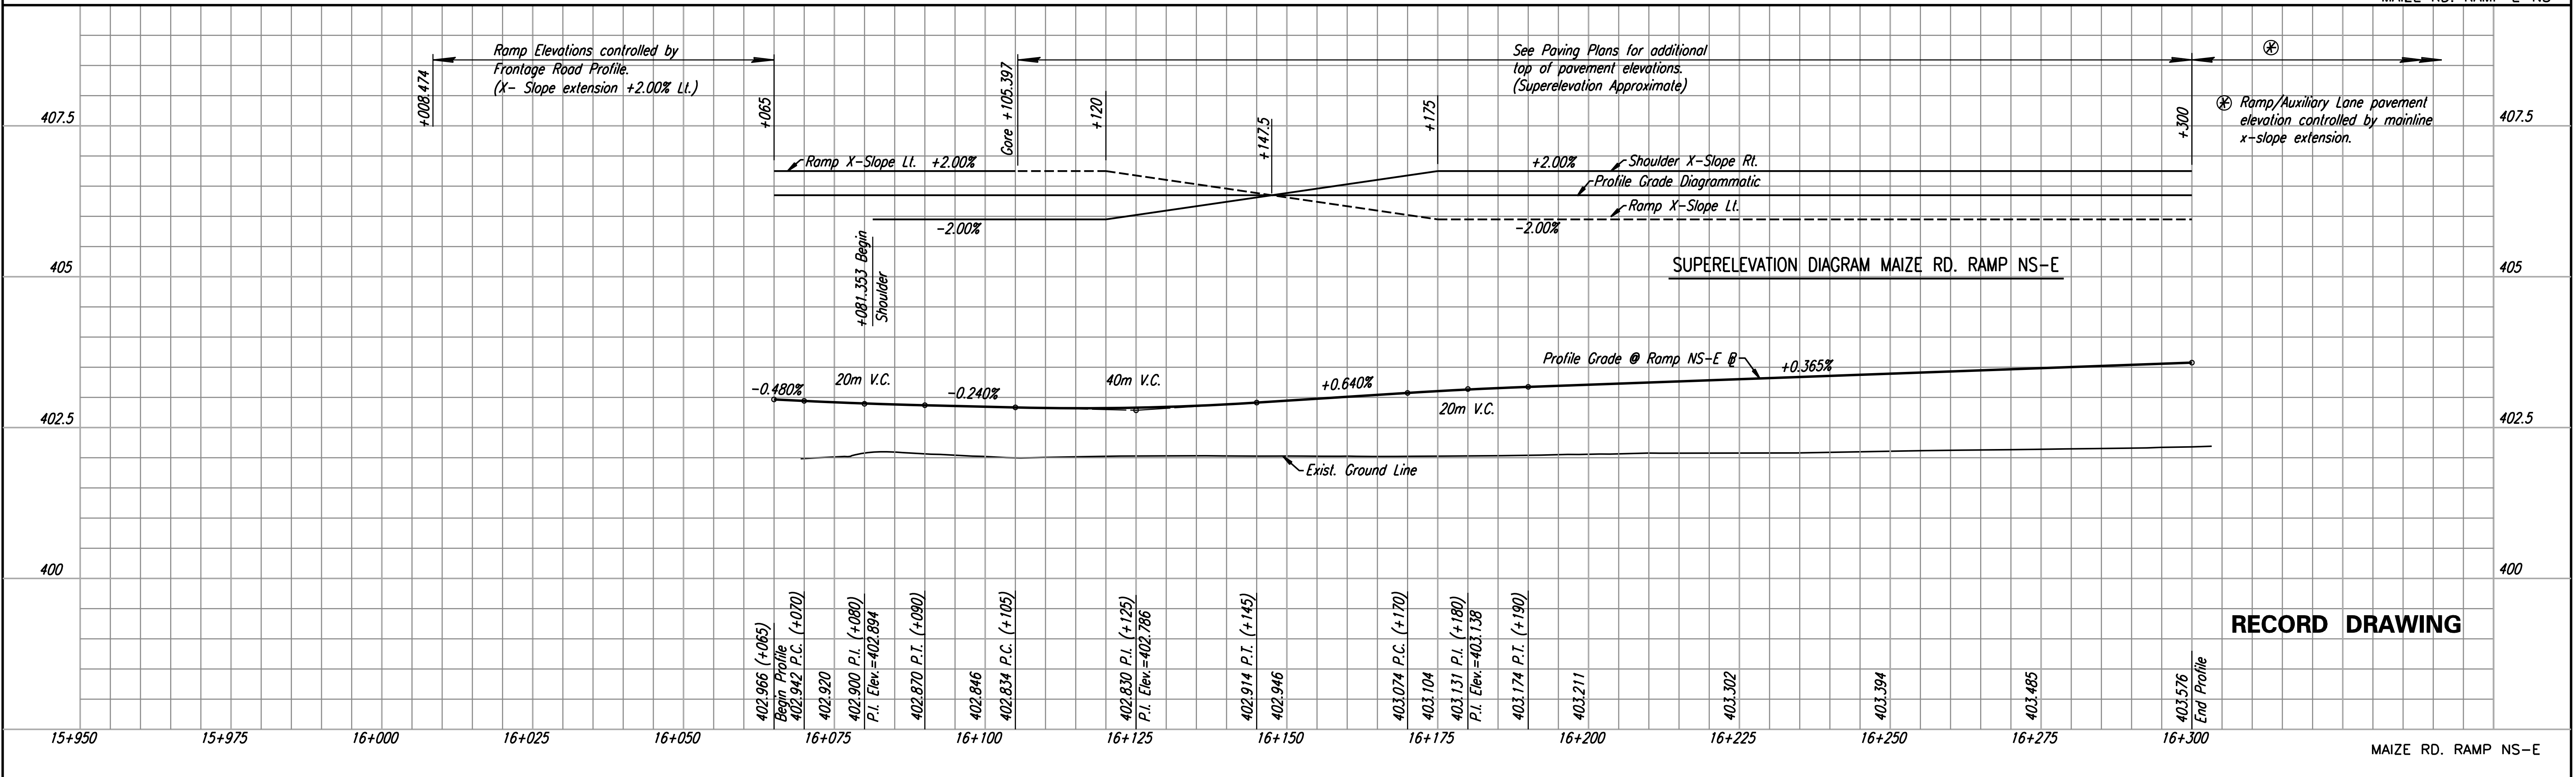


DATE	
BY	
REFERENCES NOTED	
REFERENCES CHECKED	

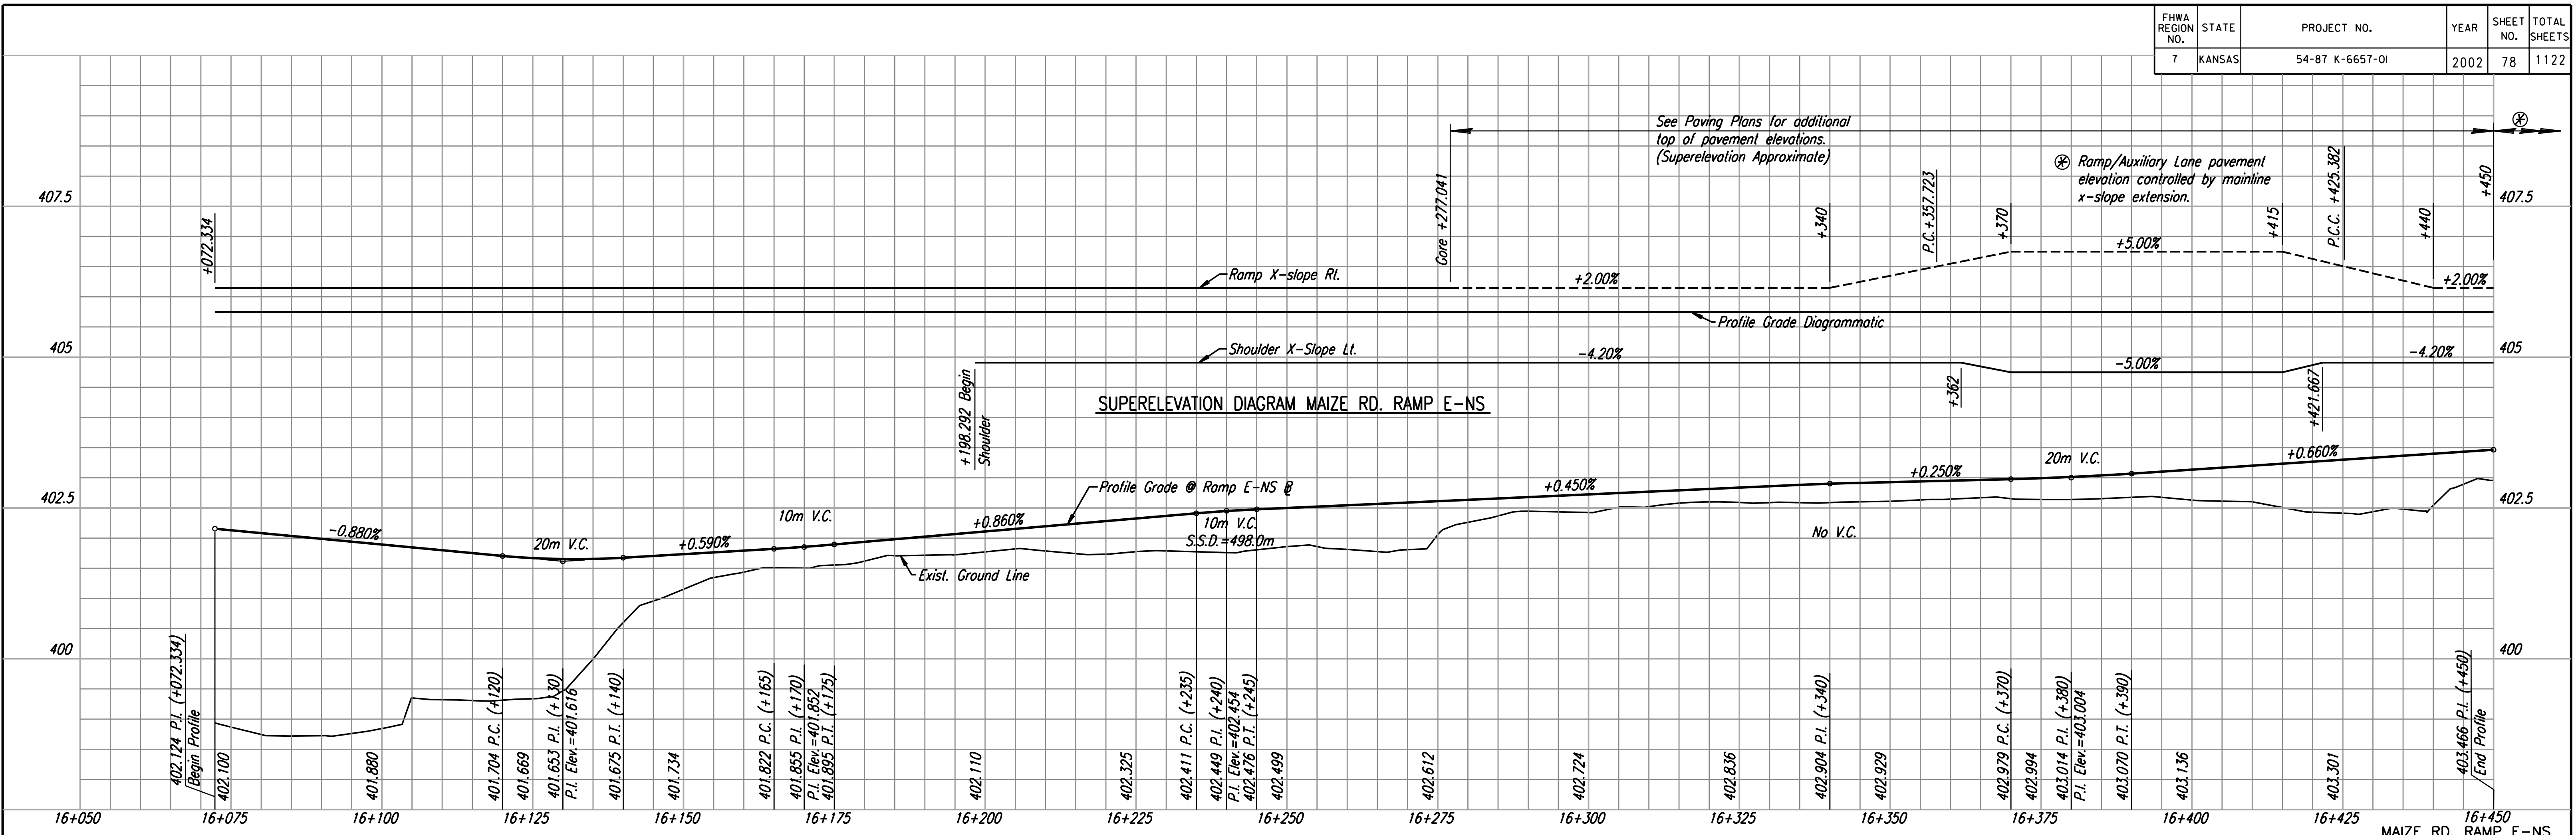

RECORD DRAWING

DSNR: RCH OPER: JGP SCALE: 1:500
 i:/1997/97362/As-Builts/dgn's/Sh 078-Maize-ernzrmp.dgn Last Rev: 8-9-07 By: gdr