
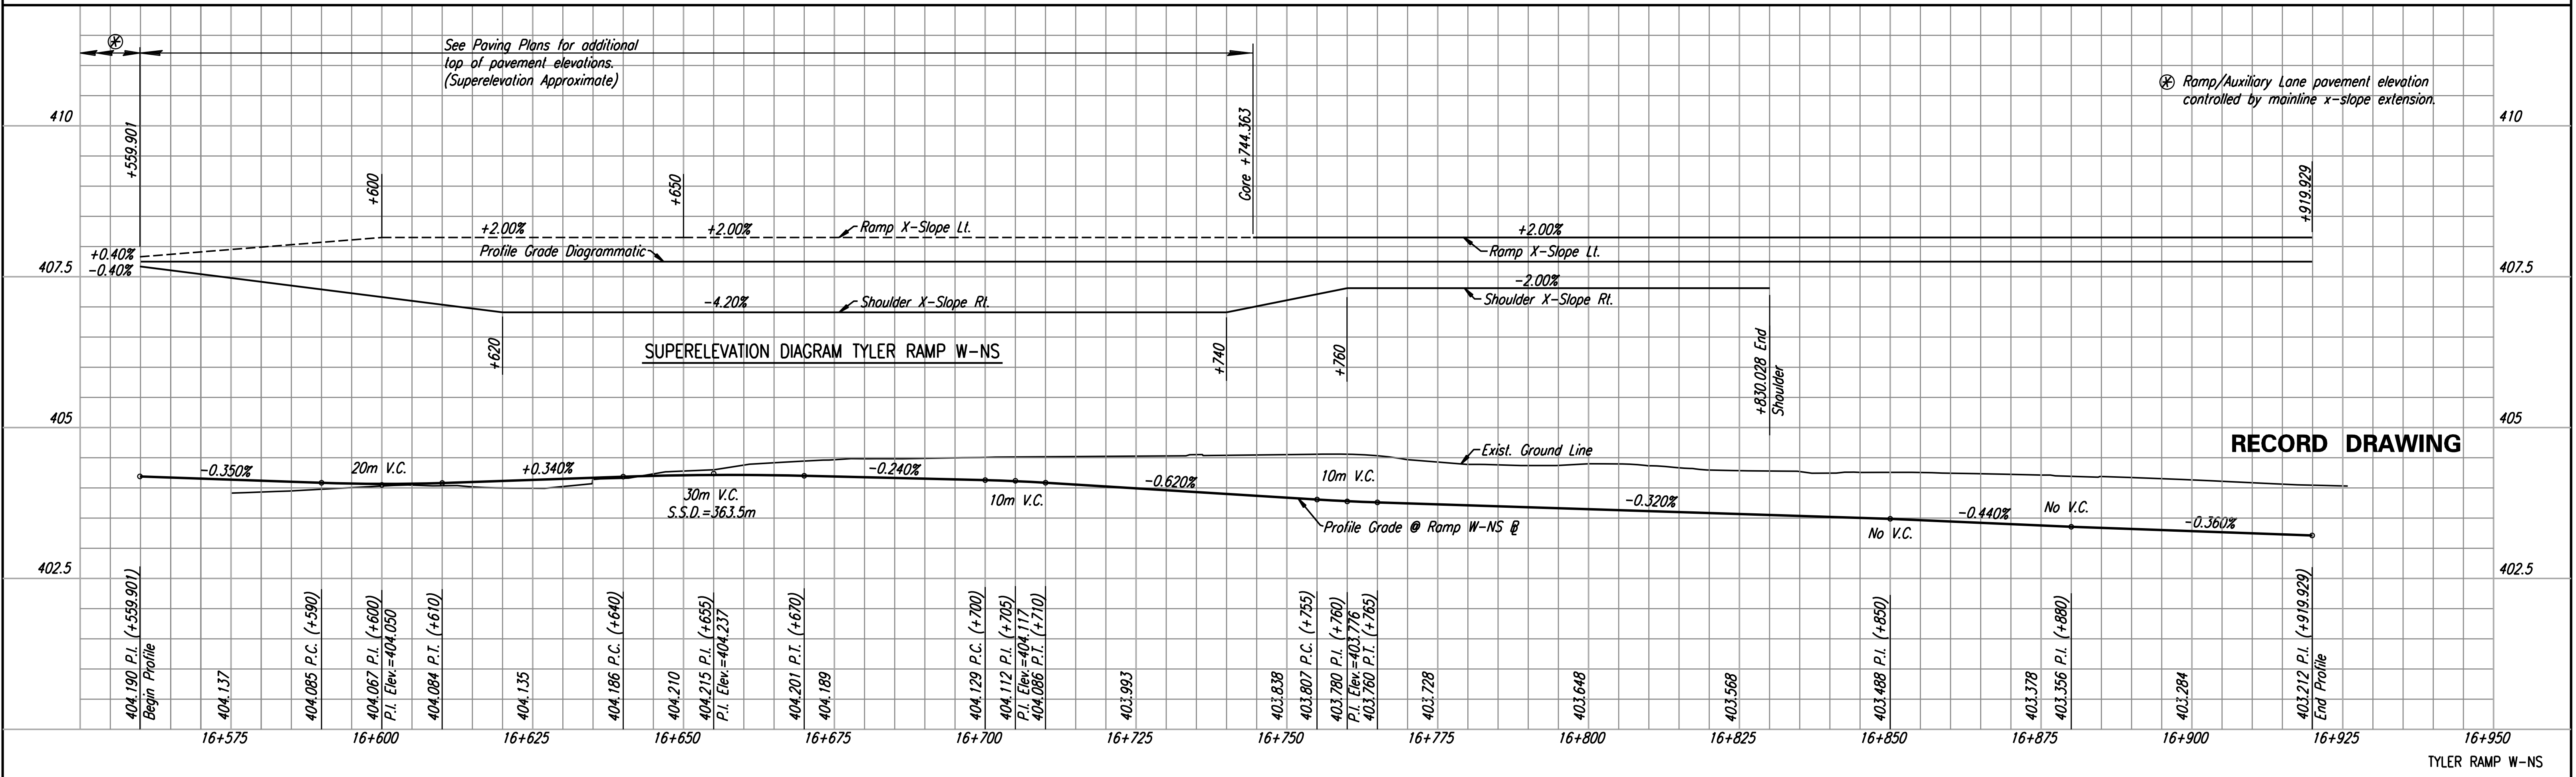


FHWA REGION NO.	STATE	PROJECT NO.	YEAR	SHEET NO.	TOTAL SHEETS
7	KANSAS	54-87 K-6657-01	2002	79	1122

DATE	
BY	
REFERENCES NOTED	
REFERENCES CHECKED	

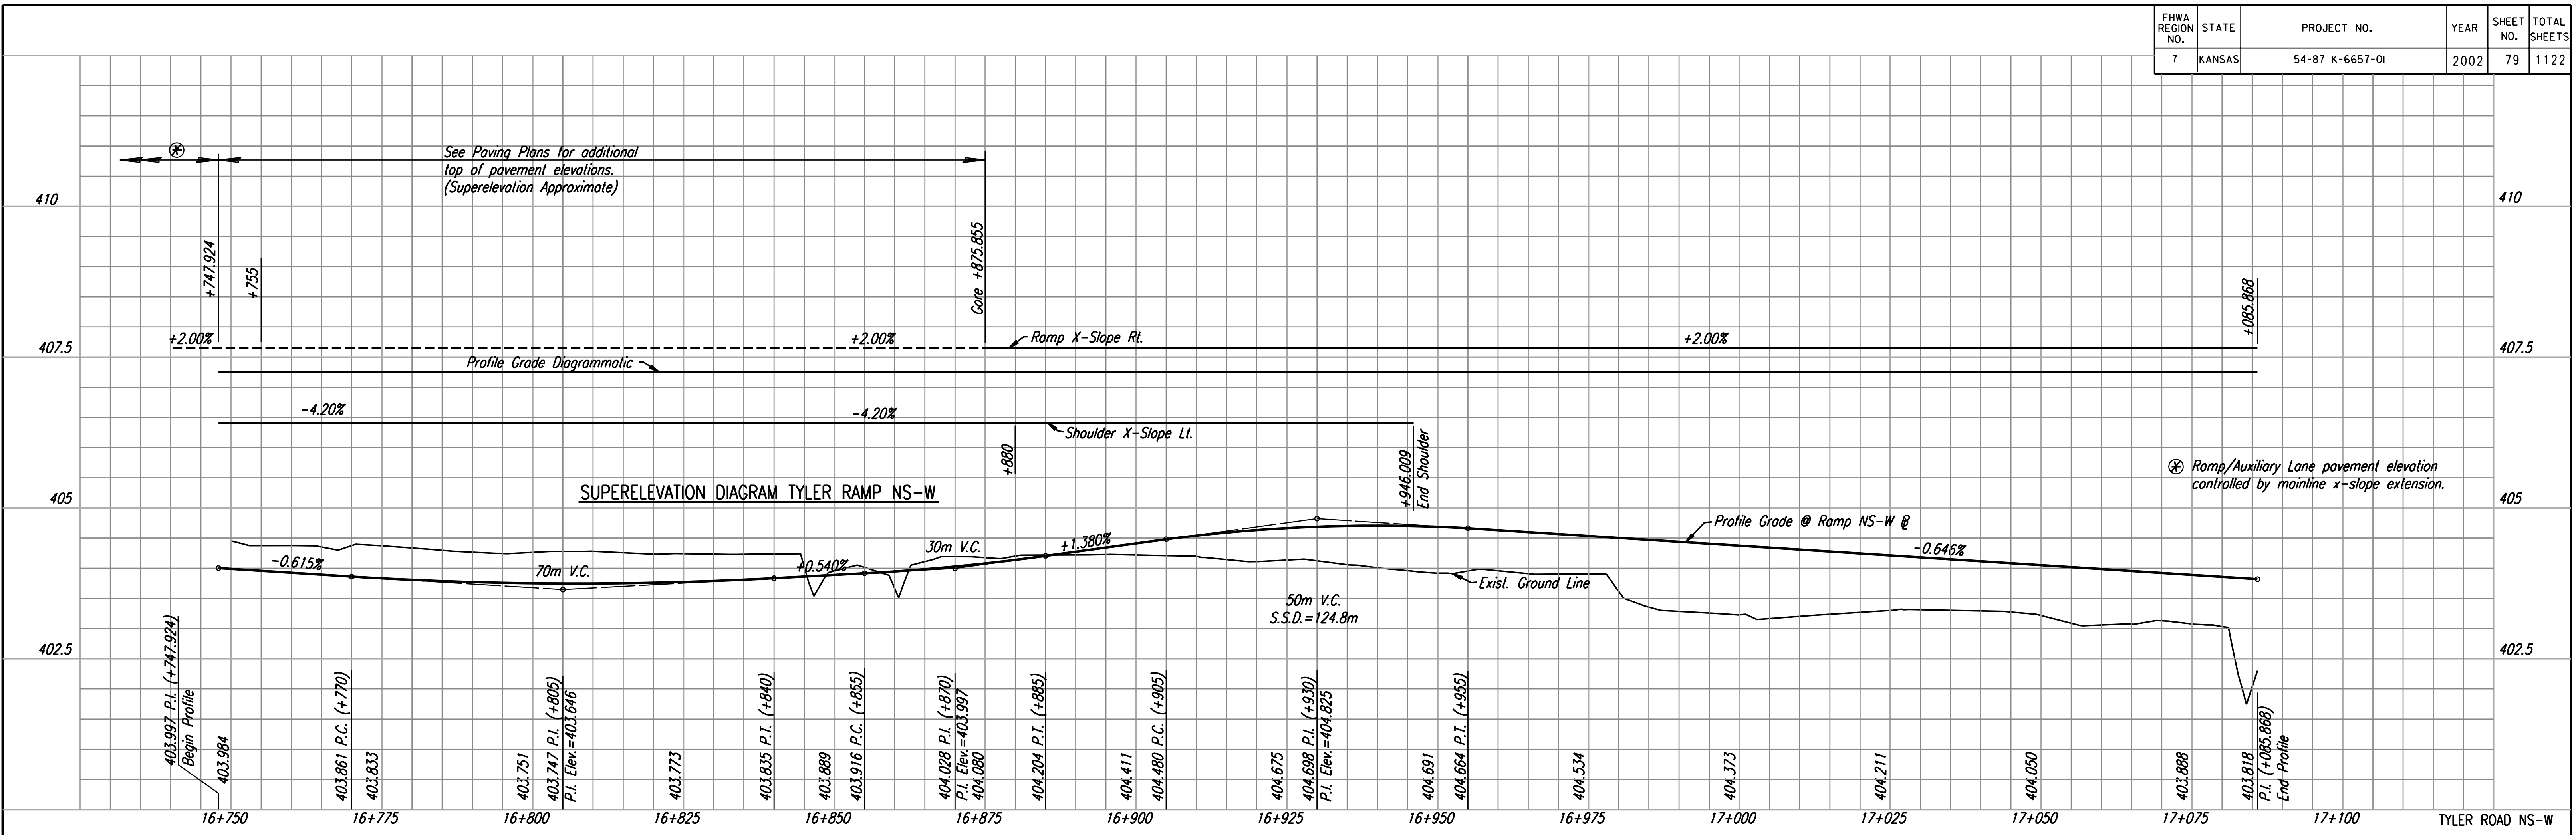

**RECORD DRAWING**

DSNR: WDH OPER: JCP SCALE: 1:500  
 k:\1997\97362\As-Builts\ dgn's\Sh 079-Tyler-tylermpw.dgn Last Rev: 8-9-07 By: gdr