
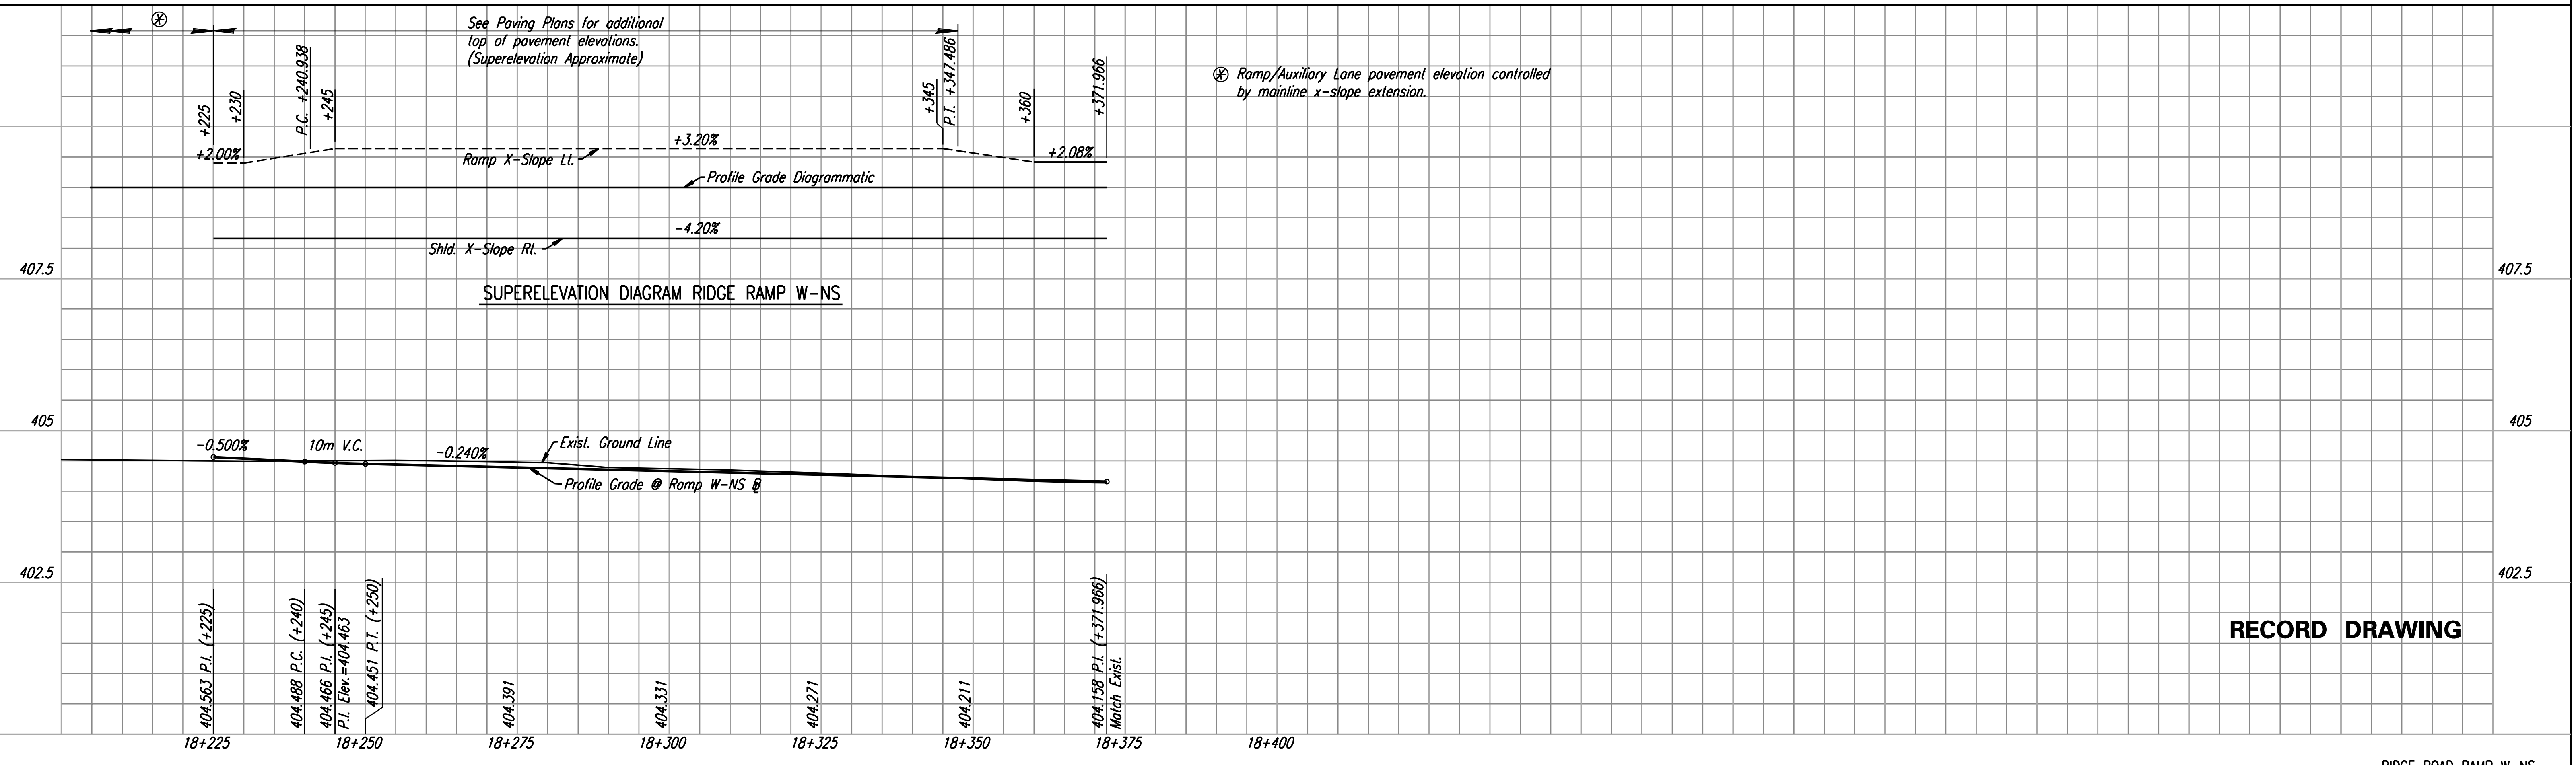


FHWA REGION NO.	STATE	PROJECT NO.	YEAR	SHEET NO.	TOTAL SHEETS
7	KANSAS	54-87 K-6657-01	2002	81	1122

DATE	BY

REFERENCES NOTED	REFERENCES CHECKED

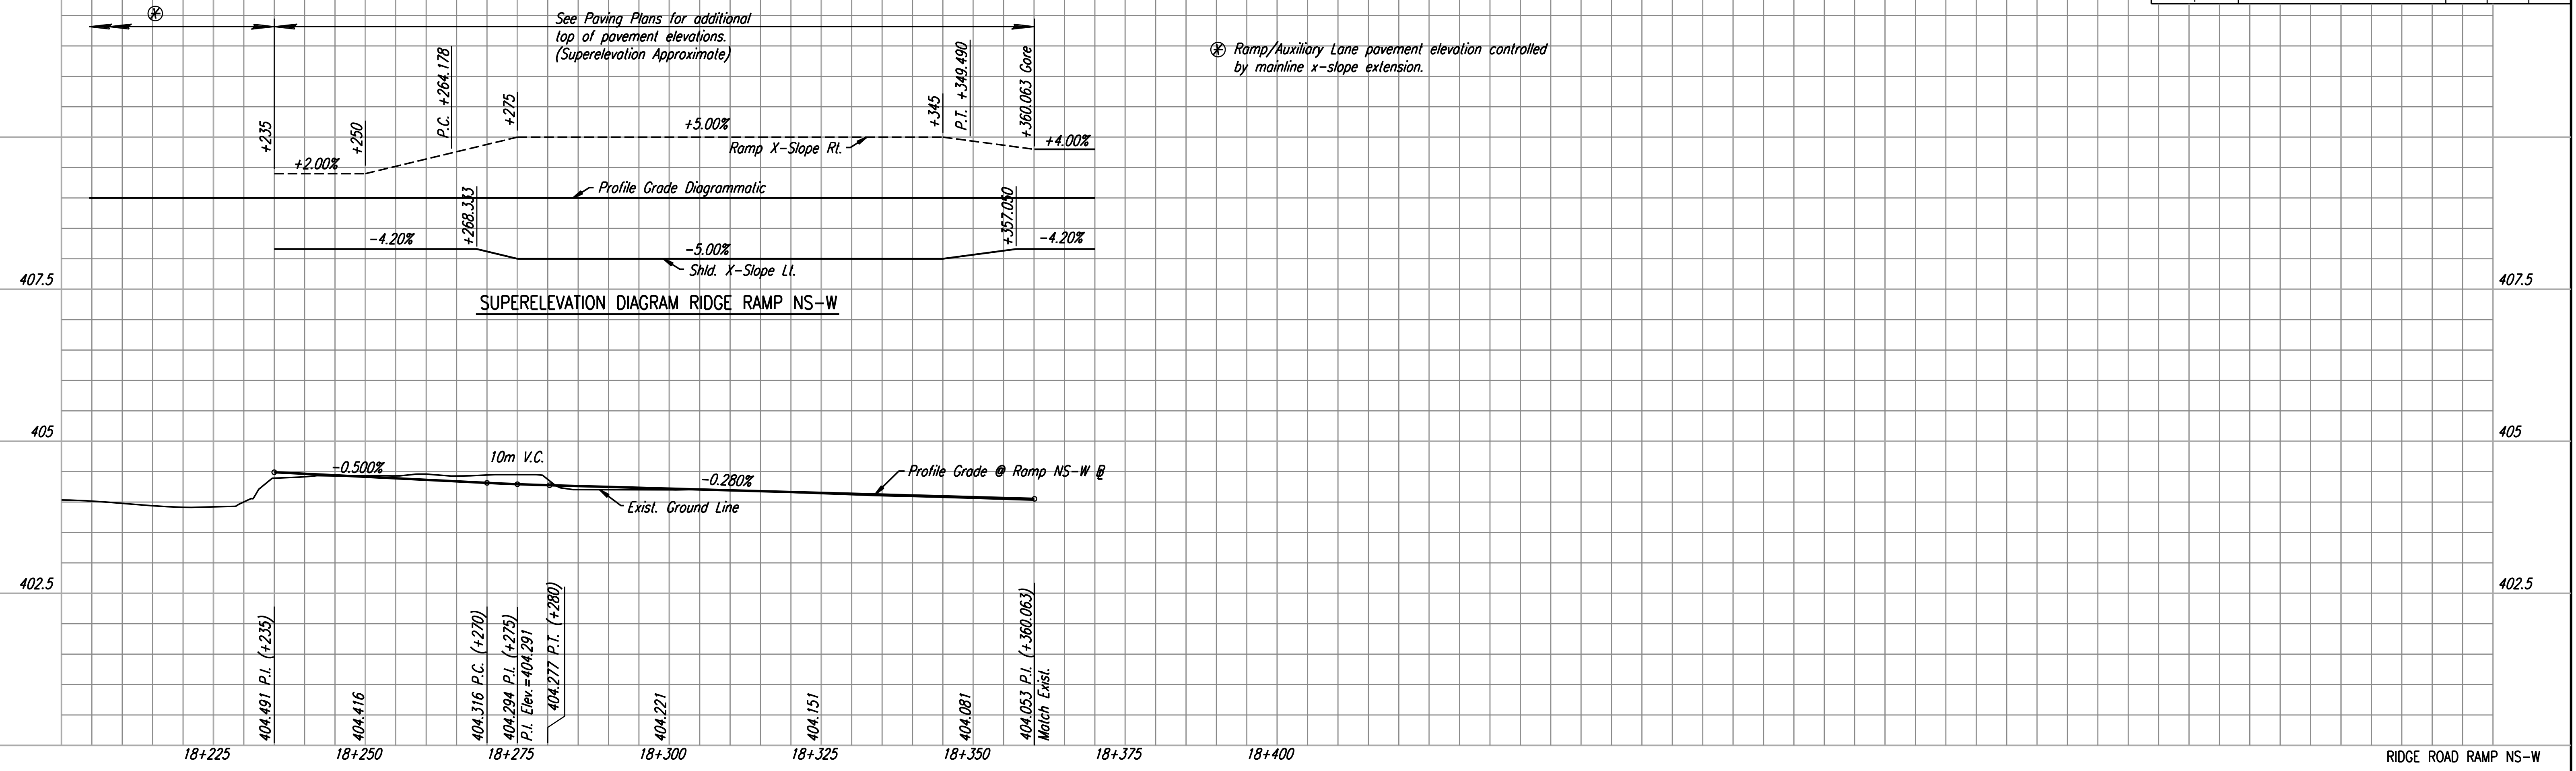

RECORD DRAWING

DSNR: JPS OPER: JGP SCALE: 1:500
 I:/1997/97362/As-Built/dgn's/Sh 081--ridgermpw.dgn Last Rev: 8-9-07 By: gdr