
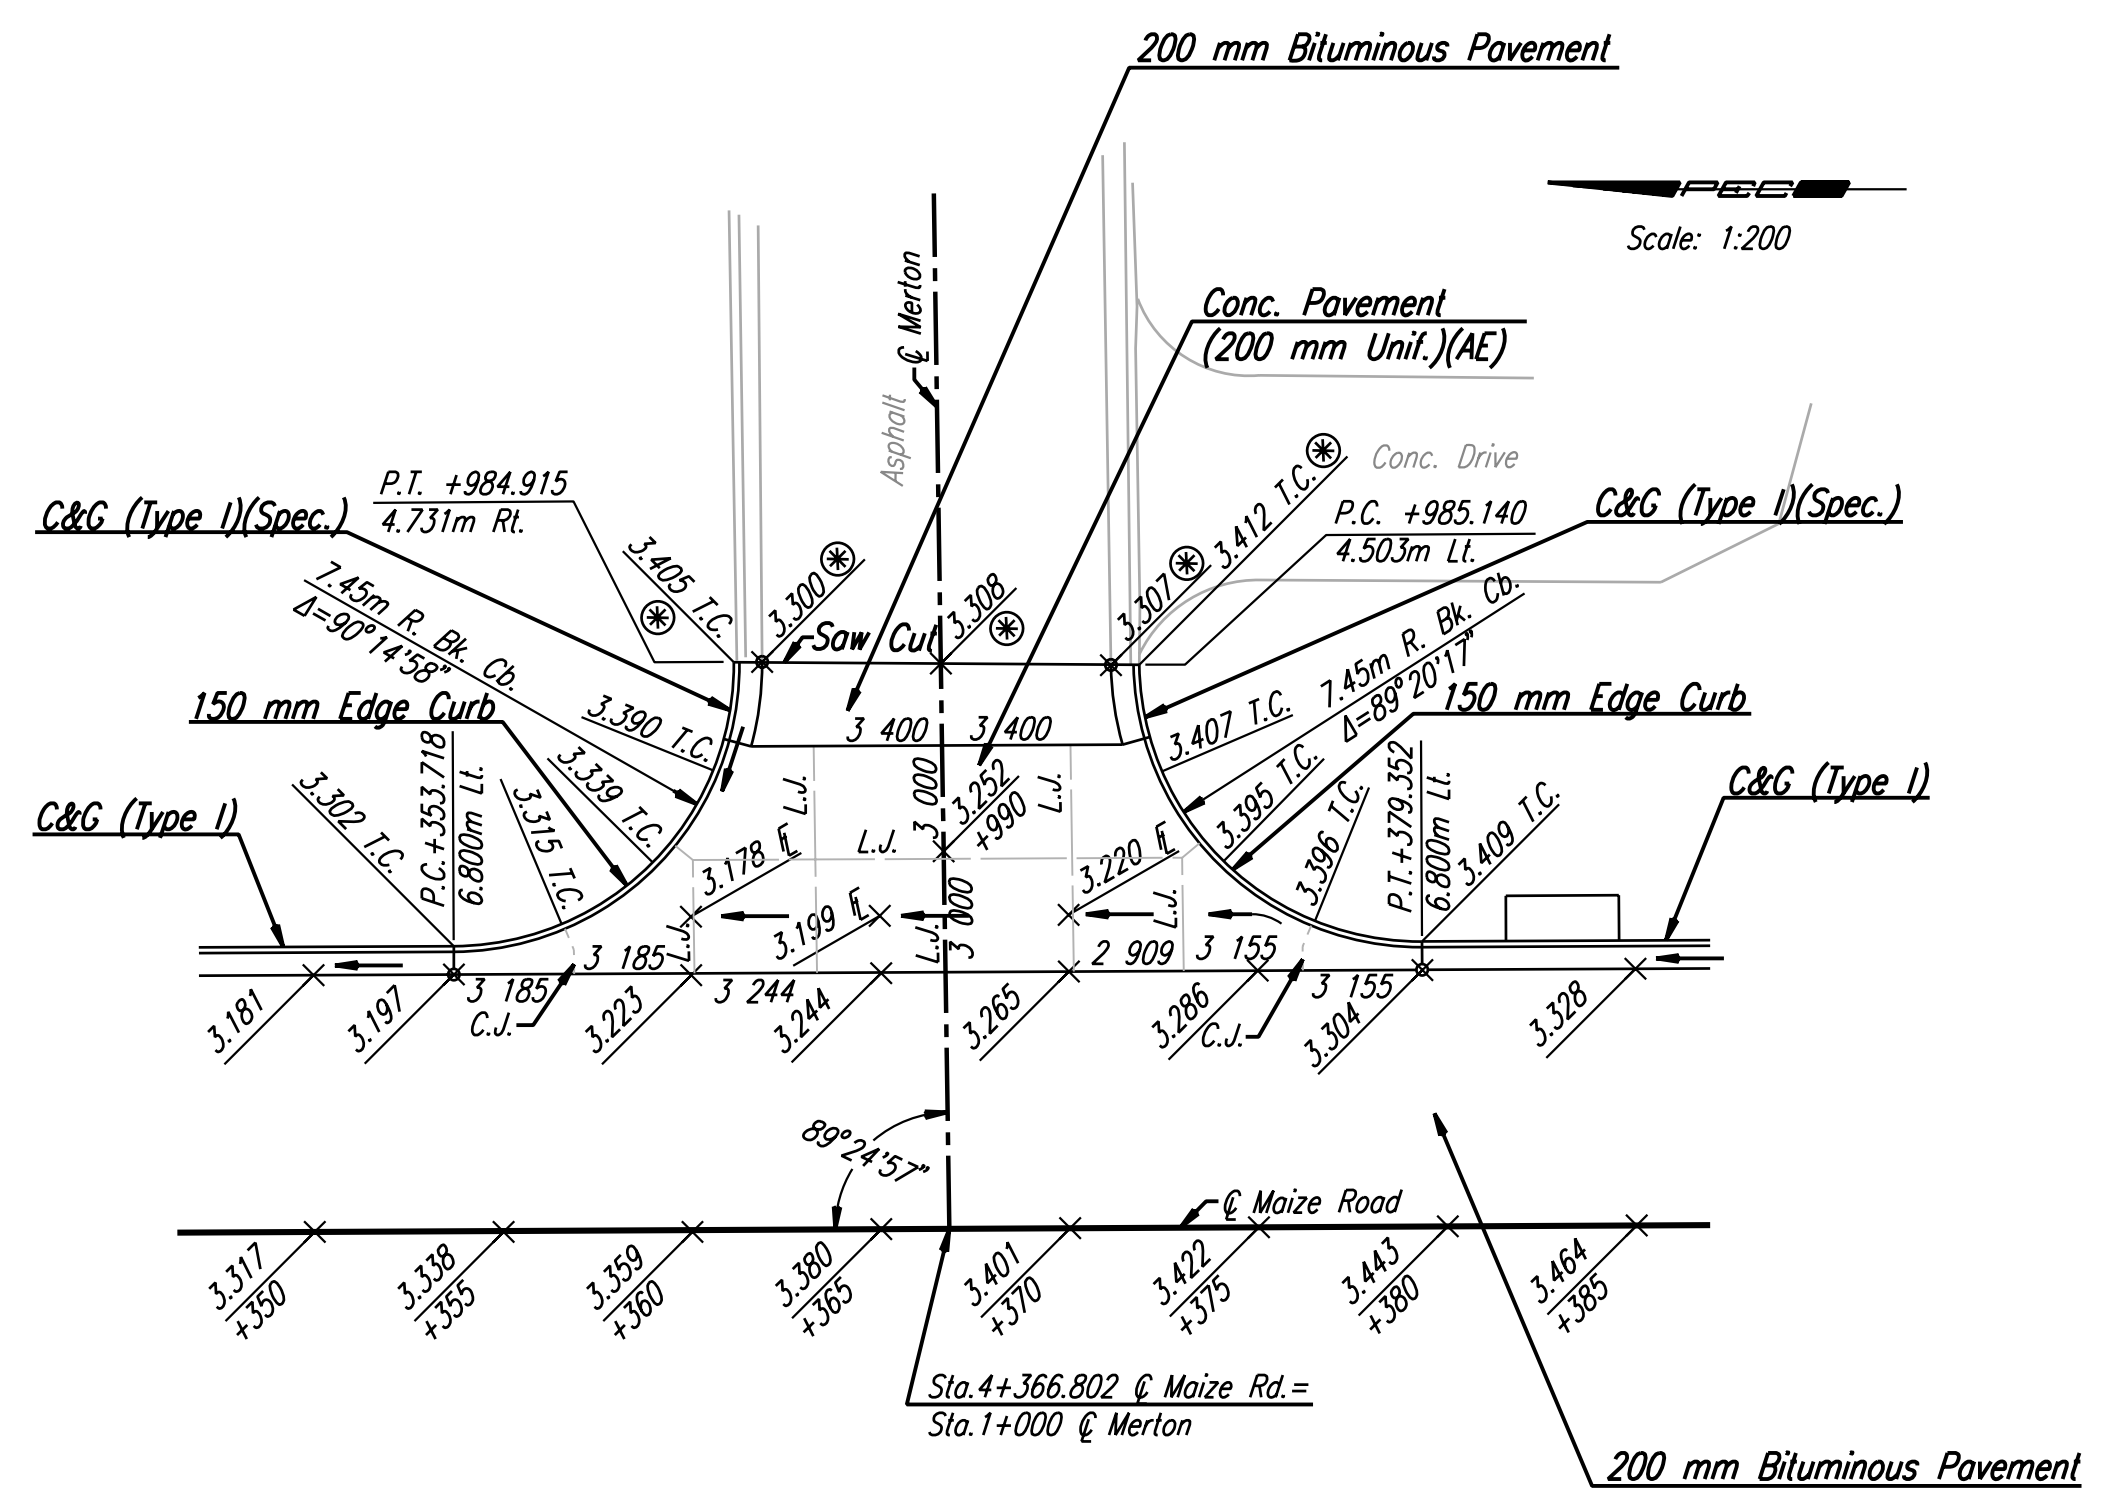
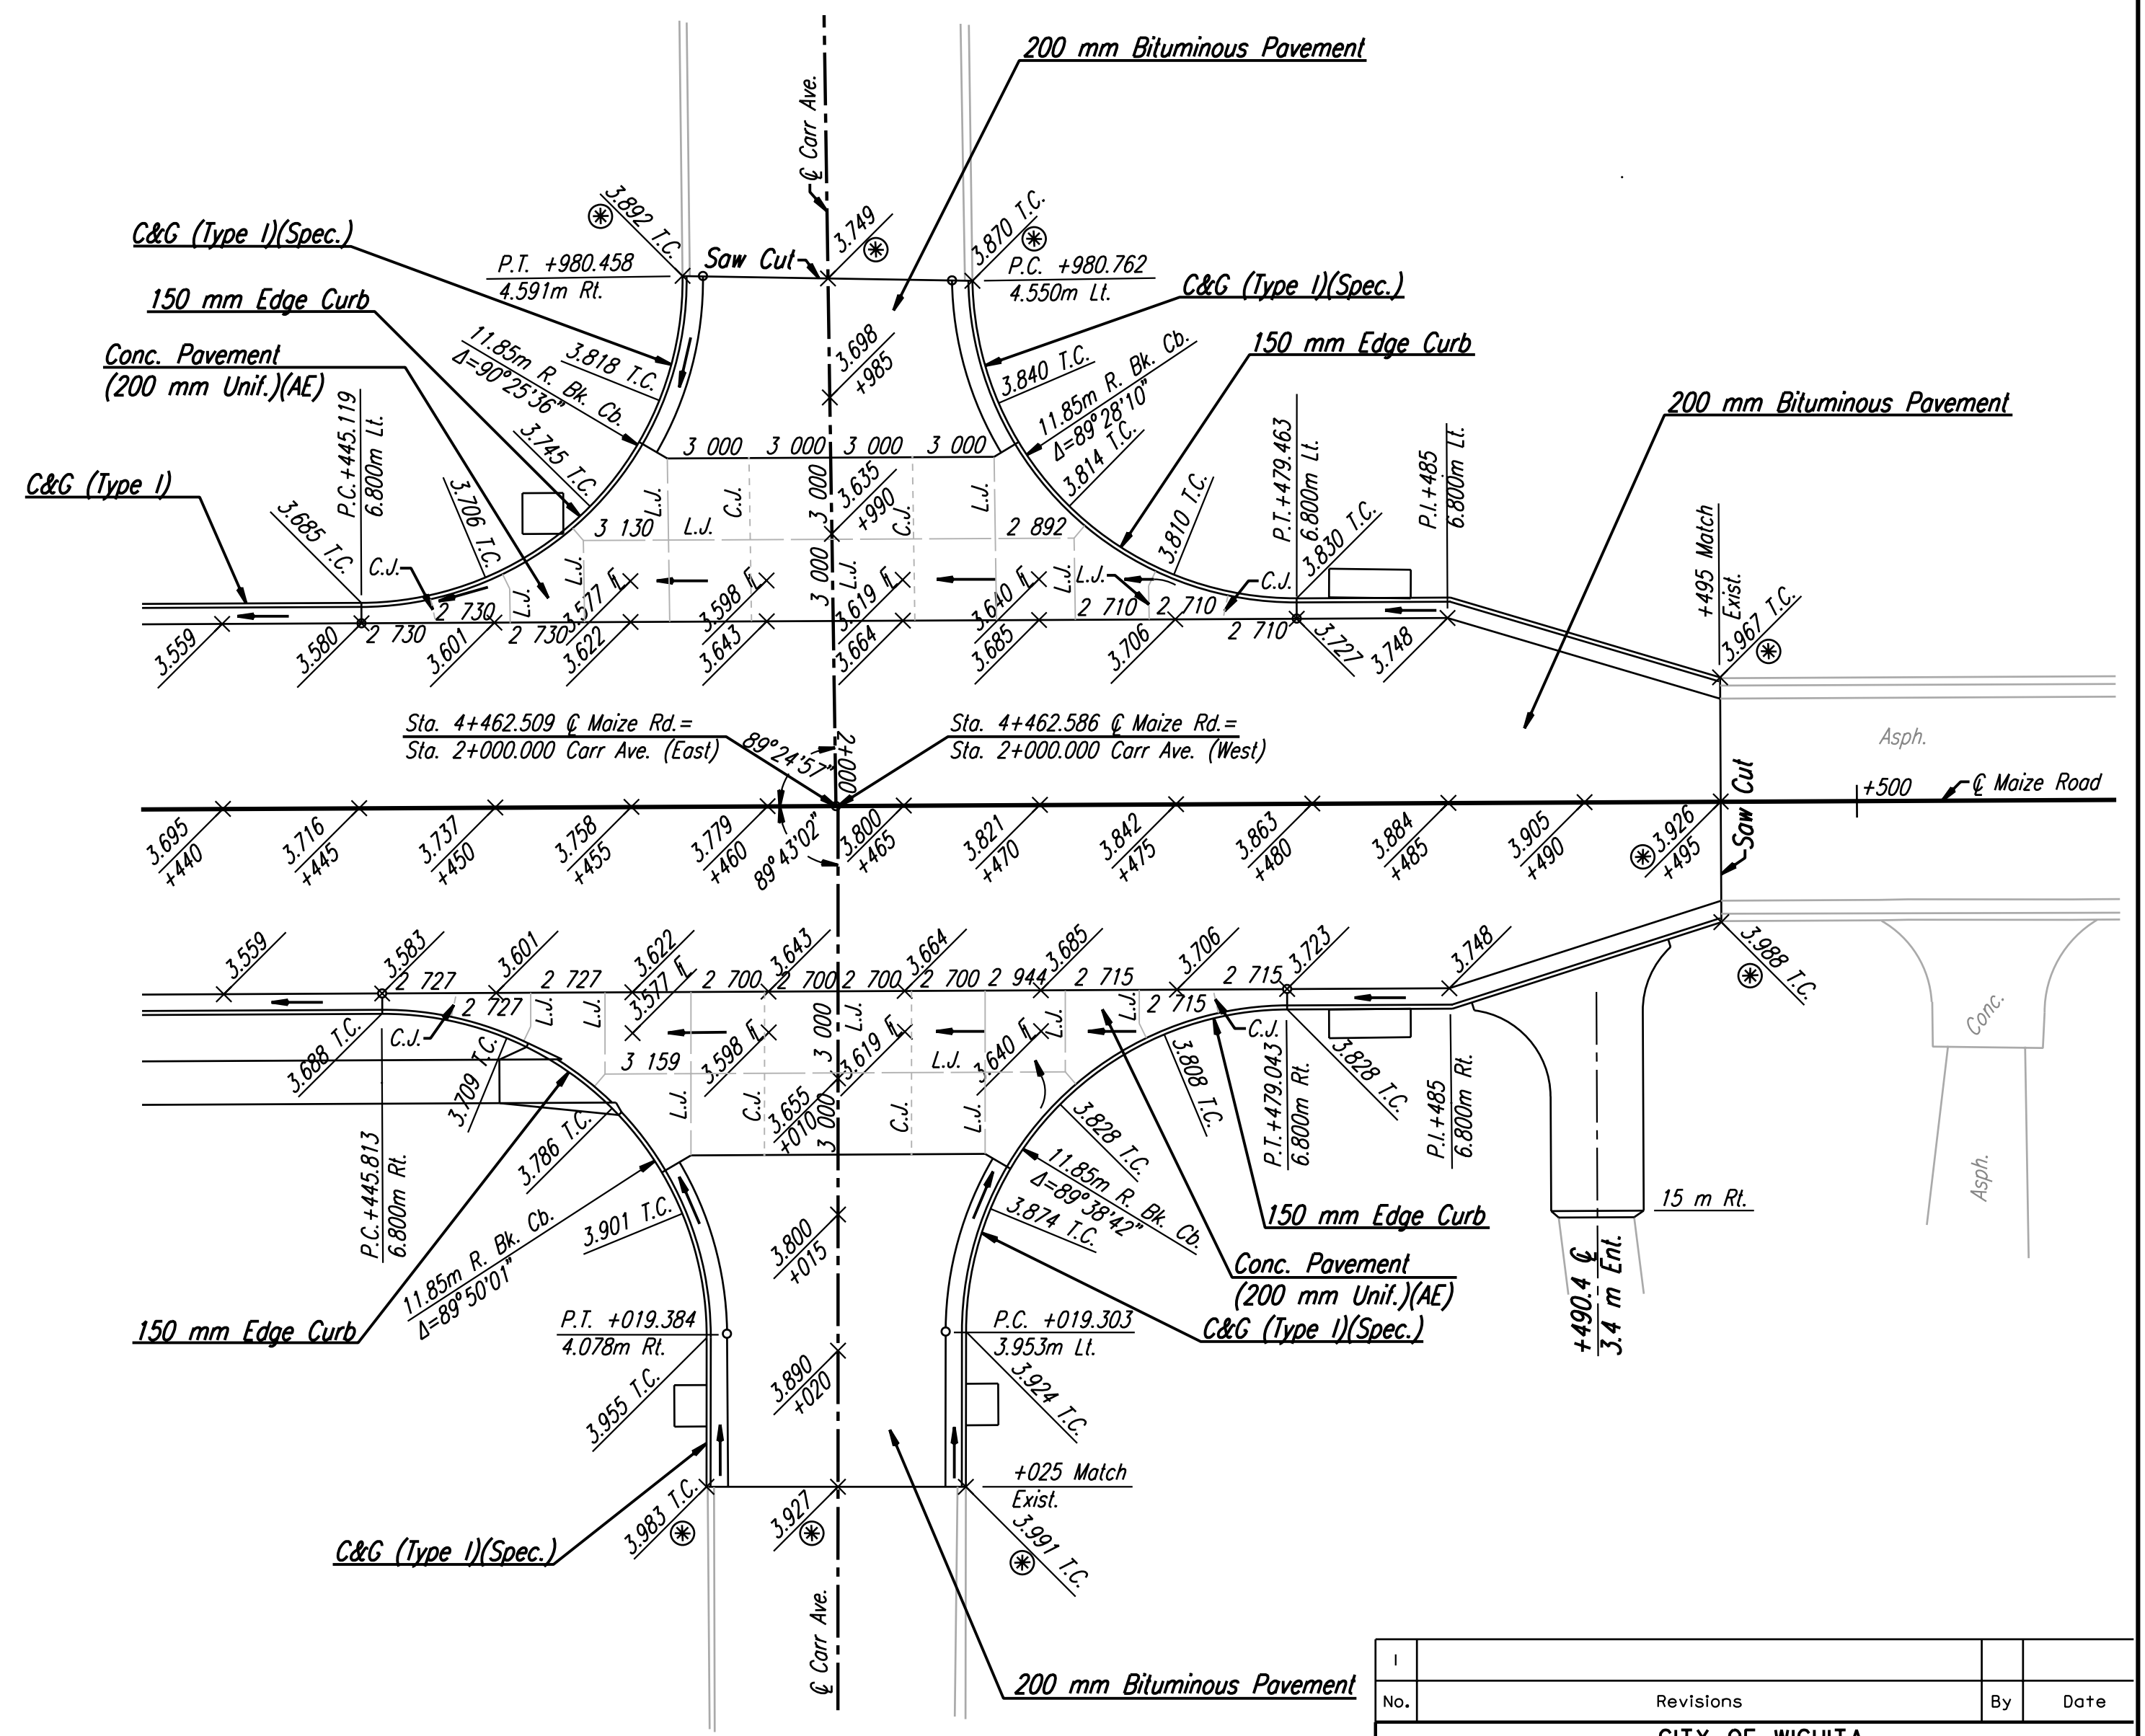


FHWA REGION NO.	STATE	PROJECT NO.	YEAR	SHEET NO.	TOTAL SHEETS
7	KANSAS	54-87 K-6657-01	2002	85	1122

DATE	
BY	
REFERENCES NOTED	
REFERENCES CHECKED	

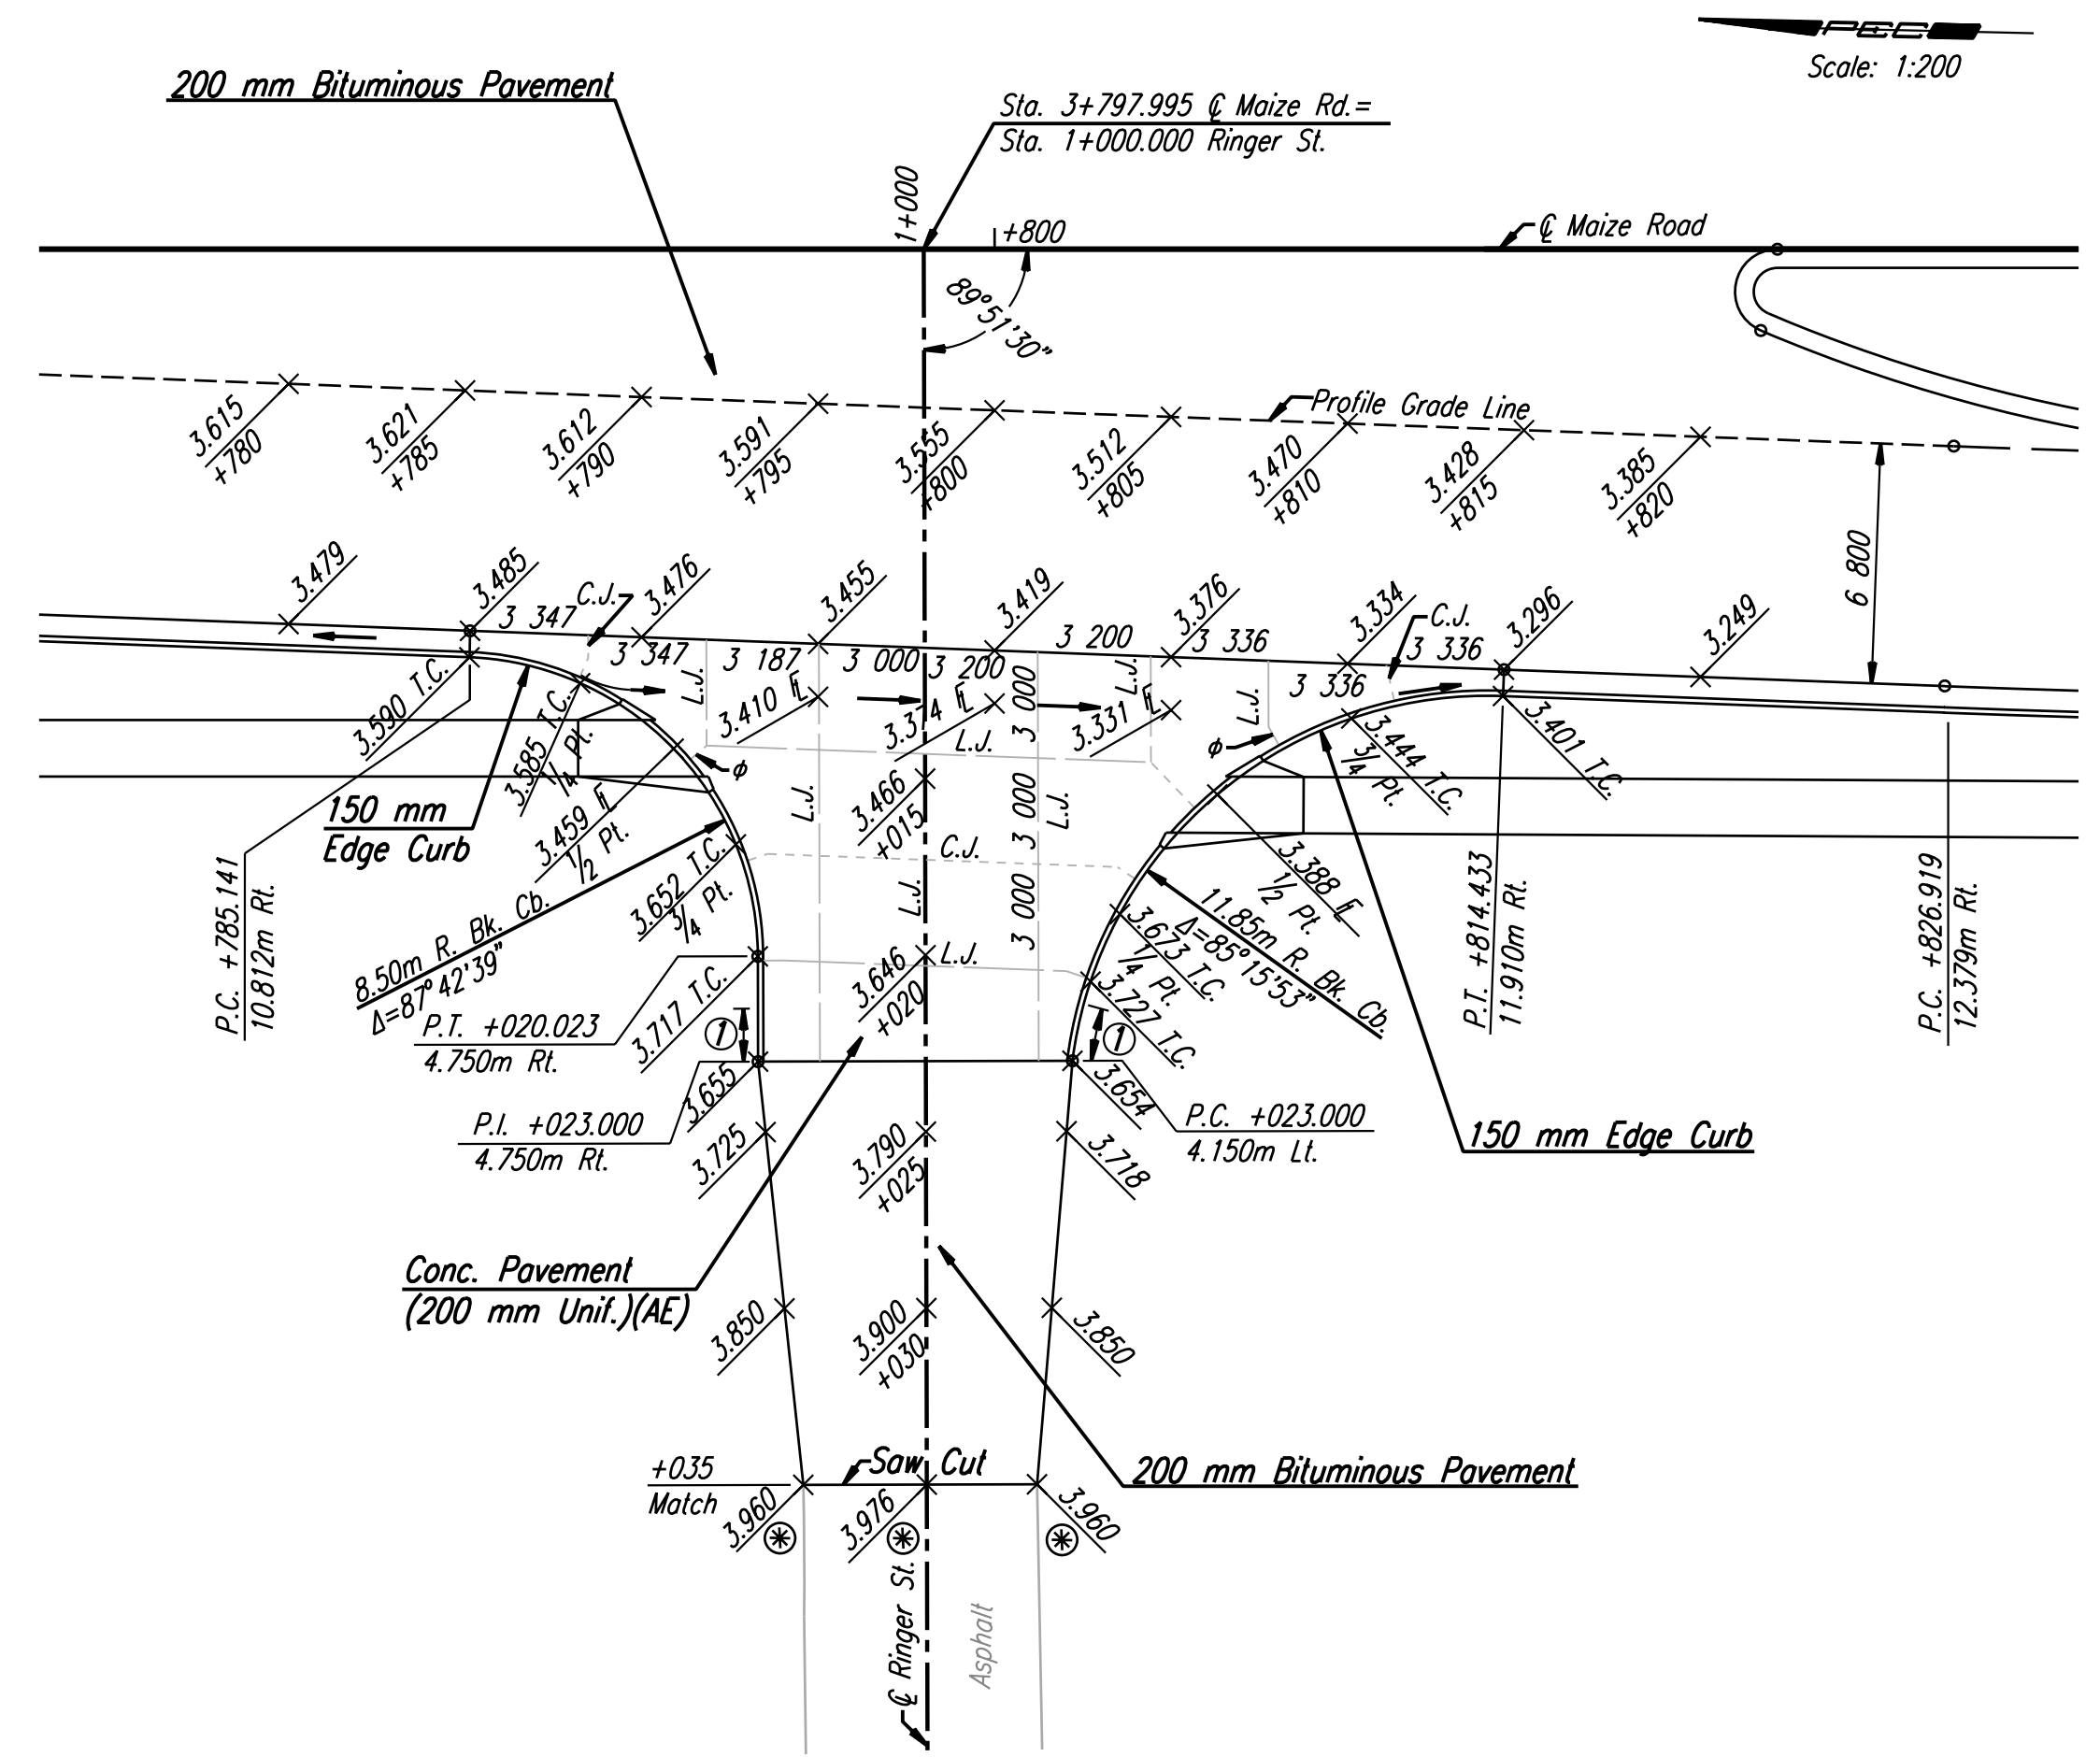

**LEGEND**

----- Longitudinal Joint (L.J.)  
 ----- Contraction Joint (C.J.)

⊕ Omit Tie Bars  
 ⊗ Match Existing  
 ① 1.5 m Transition from no curb to 150 mm curb

Note: Spot elevations are to top of finished pavement.

DSNR: JPM OPER: JGP SCALE: 1:200  
 I:/1997/97362/As-Builts/dgn's/SH\_085-maizesiderds.dgn Last Rev: 8-10-07 By: gdr

**RECORD DRAWING**

No.	Revisions	By	Date

**CITY OF WICHITA**  
**INTERSECTION DETAILS**  
**MAIZE RD. & RINGER ST.**  
**MAIZE RD. & MERTON ST.**  
**MAIZE RD. & CARR AVE.**  
 SEDGWICK COUNTY

**Professional Engineering Consultants, P.A.**  
 303 S. TOPEKA • WICHITA, KANSAS 67202  
 316-262-2691 • FAX 316-262-3003

Designed by	JPM	Checked by	WDH
Drawn by	SVB	Date	April, 2002
		Job No.	97362