



FHWA REGION NO.	STATE	PROJECT NO.	YEAR	SHEET NO.	TOTAL SHEETS
7	KANSAS	54-87 K-6657-01	2002	89	1122

DATE	
BY	
REFERENCES NOTED	
REFERENCES CHECKED	

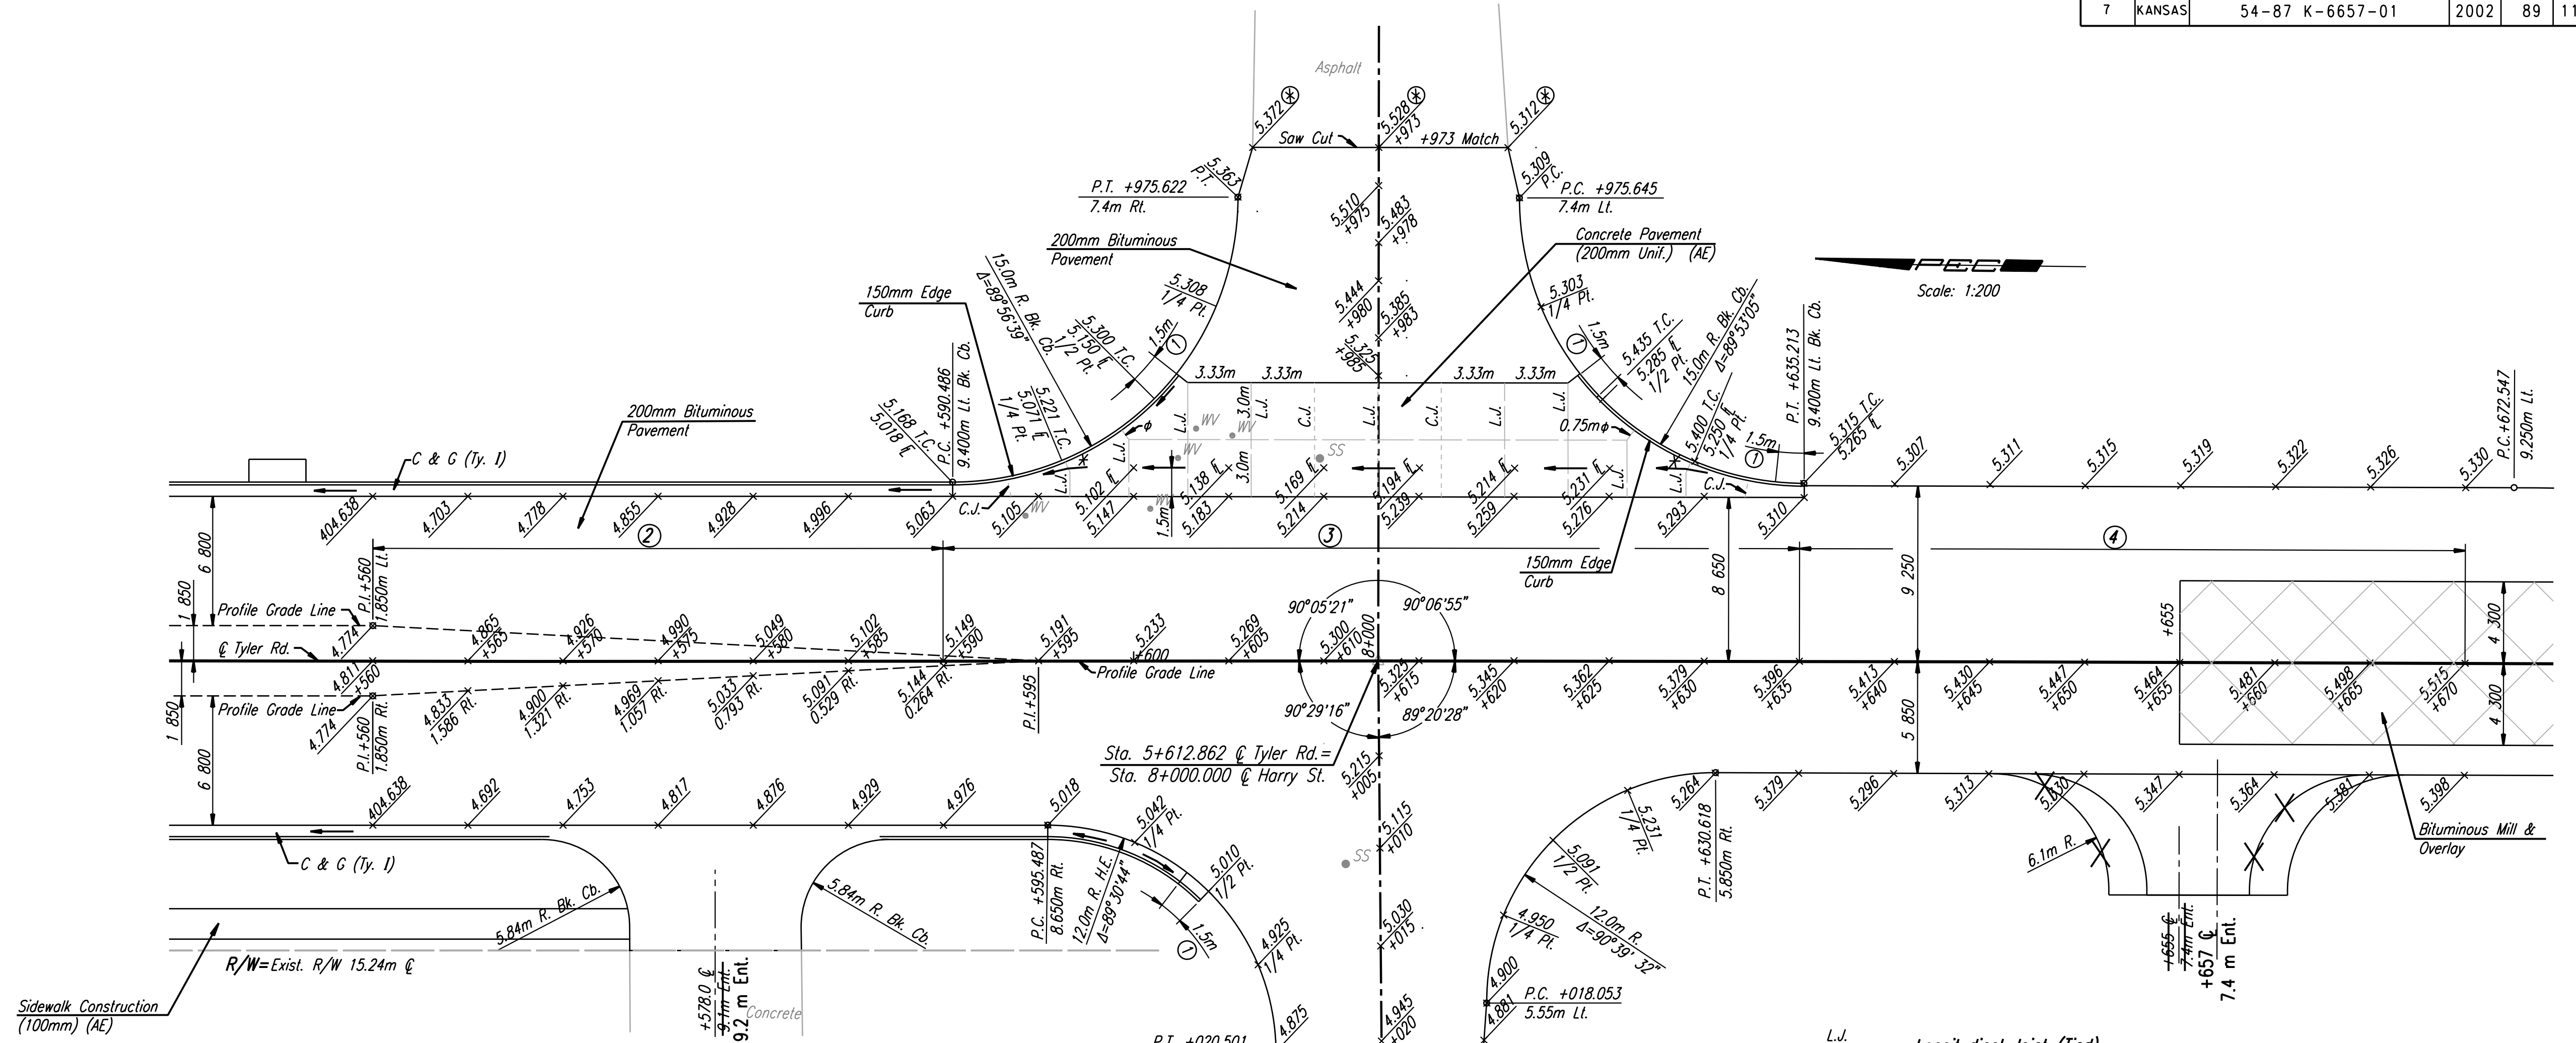

Scale: 1:200

- L.J. Longitudinal Joint (Tied)
 - C.J. Transverse Contraction Joint
 - Mill & Overlay (50mm Nominal)
 - Light Type Surfacing
 - ⊗ Match Existing
 - * Warp gutter to drain. Curb height varies. See spots.
 - ⊘ Omit tie bars (Typ.)
 - ① Transition from No Curb to 150mm Curb.
 - ② Transition X-Slope Lt. from -2.0% @ Sta. 5+560 to -1.0% @ Sta. 5+590.
 - ③ X-Slope Lt. = -1.0%
 - ④ Transition X-Slope Lt. from -1.0% @ Sta. 5+635 to -2.0% @ Sta. 5+670.
- Note: Spot Elevations are to top of finished pavement.

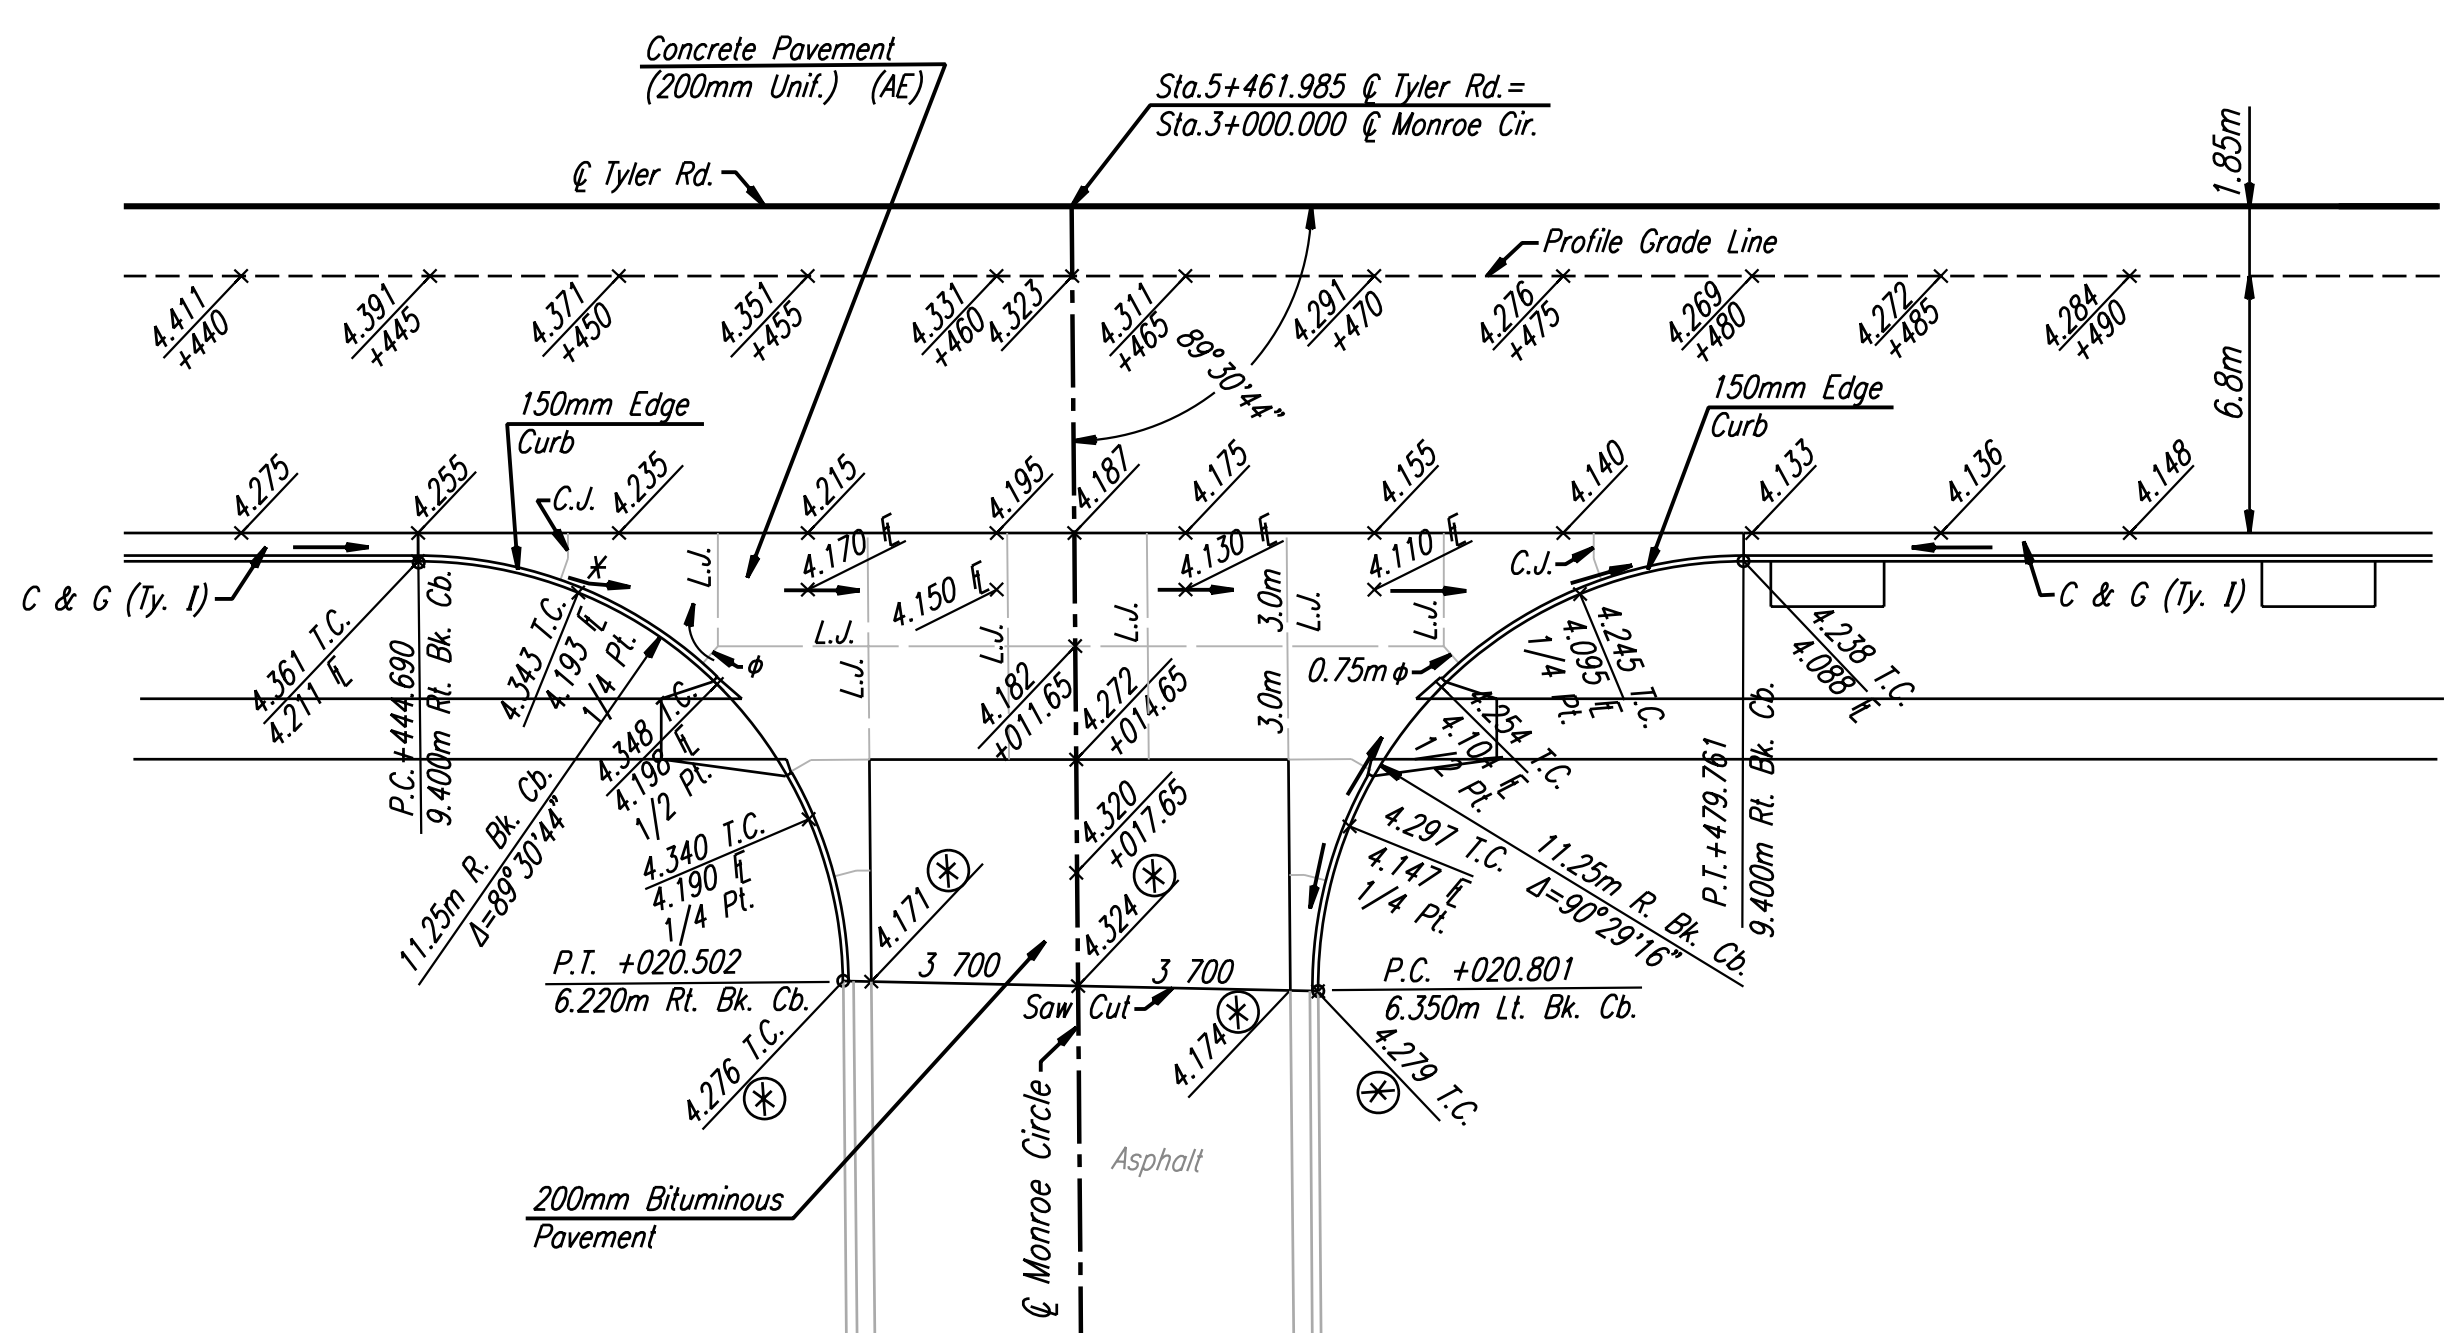

RECORD DRAWING

Revisions			
No.	By	Date	
CITY OF WICHITA			
INTERSECTION DETAILS			
TYLER RD. & HARRY ST.			
TYLER RD. & MONROE ST.			
SEDGWICK COUNTY			
Professional Engineering Consultants, P.A.			
303 S. TOPEKA • WICHITA, KANSAS 67202			
316-262-2691 • FAX 316-262-3003			
Designed by	JPM	Checked by	WDH
Drawn by	JGP	Date	April, 2002
		Job No.	97362

DSNR: JPM OPER: JGP SCALE: 1:200
 i:/1997/97362/As-Builts/dgn's/Sl_089-tylersiderds.dgn Last Rev: 8-9-07 By: gdr