


FHWA REGION NO.	STATE	PROJECT NO.	YEAR	SHEET NO.	TOTAL SHEETS
7	KANSAS	54-87 K-6657-01	2002	93	1122

DATE	
BY	
REFERENCES NOTED	
REFERENCES CHECKED	

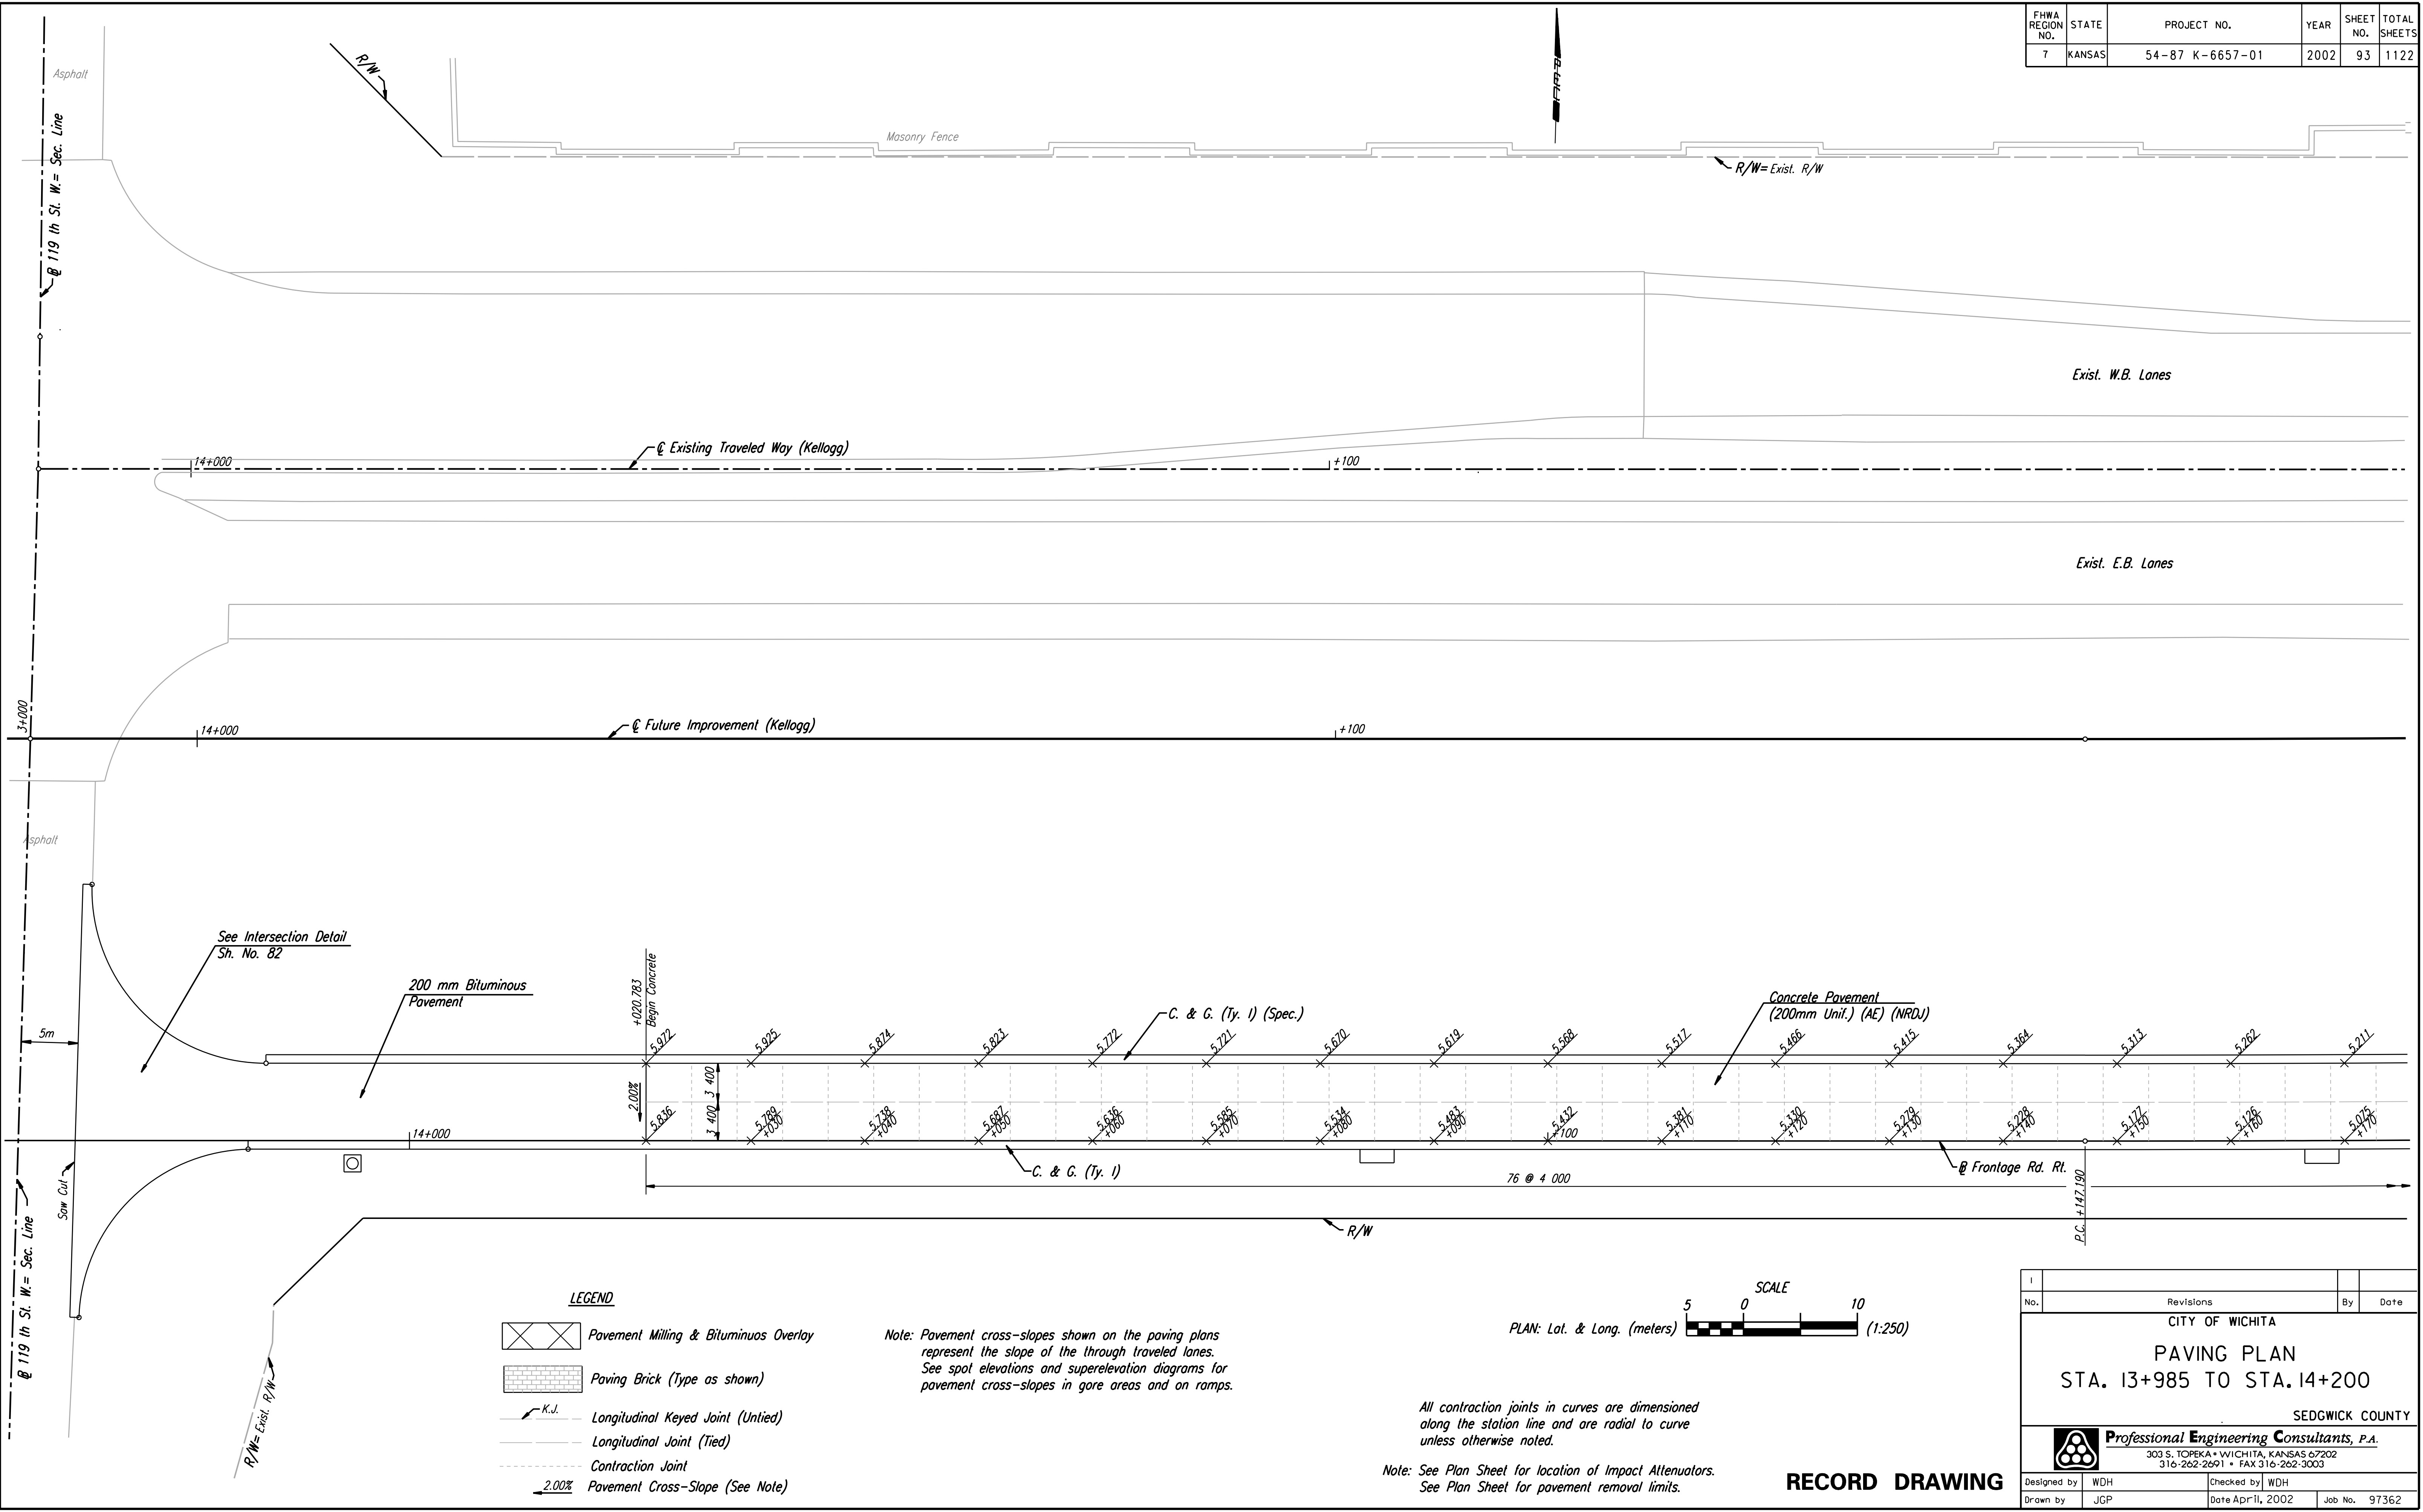


DSNR: WDH OPER: JGP SCALE: 1:250
 i:/1997/97362/As-Builts/dgn/s/Sh_093-pav140.dgn Last Rev: 8-10-07 By: gdr

LEGEND

	Pavement Milling & Bituminous Overlay
	Paving Brick (Type as shown)
	Longitudinal Keyed Joint (Untied)
	Longitudinal Joint (Tied)
	Contraction Joint
	2.00% Pavement Cross-Slope (See Note)

Note: Pavement cross-slopes shown on the paving plans represent the slope of the through traveled lanes. See spot elevations and superelevation diagrams for pavement cross-slopes in gore areas and on ramps.

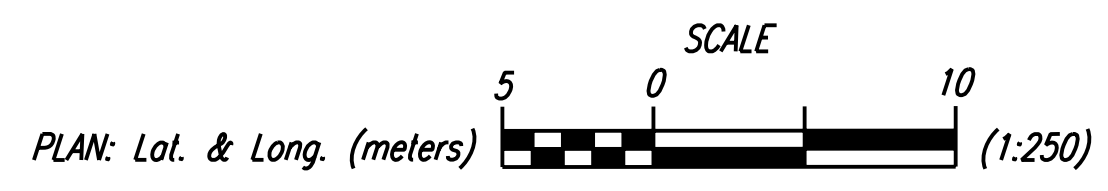

All contraction joints in curves are dimensioned along the station line and are radial to curve unless otherwise noted.
 Note: See Plan Sheet for location of Impact Attenuators. See Plan Sheet for pavement removal limits.

RECORD DRAWING

No.	Revisions	By	Date
CITY OF WICHITA			
PAVING PLAN			
STA. 13+985 TO STA. 14+200			
SEDGWICK COUNTY			
Professional Engineering Consultants, P.A.			
303 S. TOPEKA • WICHITA, KANSAS 67202 316-262-2691 • FAX 316-262-3003			
Designed by	WDH	Checked by	WDH
Drawn by	JGP	Date	April, 2002
		Job No.	97362