


FHWA REGION NO.	STATE	PROJECT NO.	YEAR	SHEET NO.	TOTAL SHEETS
7	KANSAS	54-87 K-6657-01	2002	95	1122

DATE	BY	REFERENCES NOTED	REFERENCES CHECKED

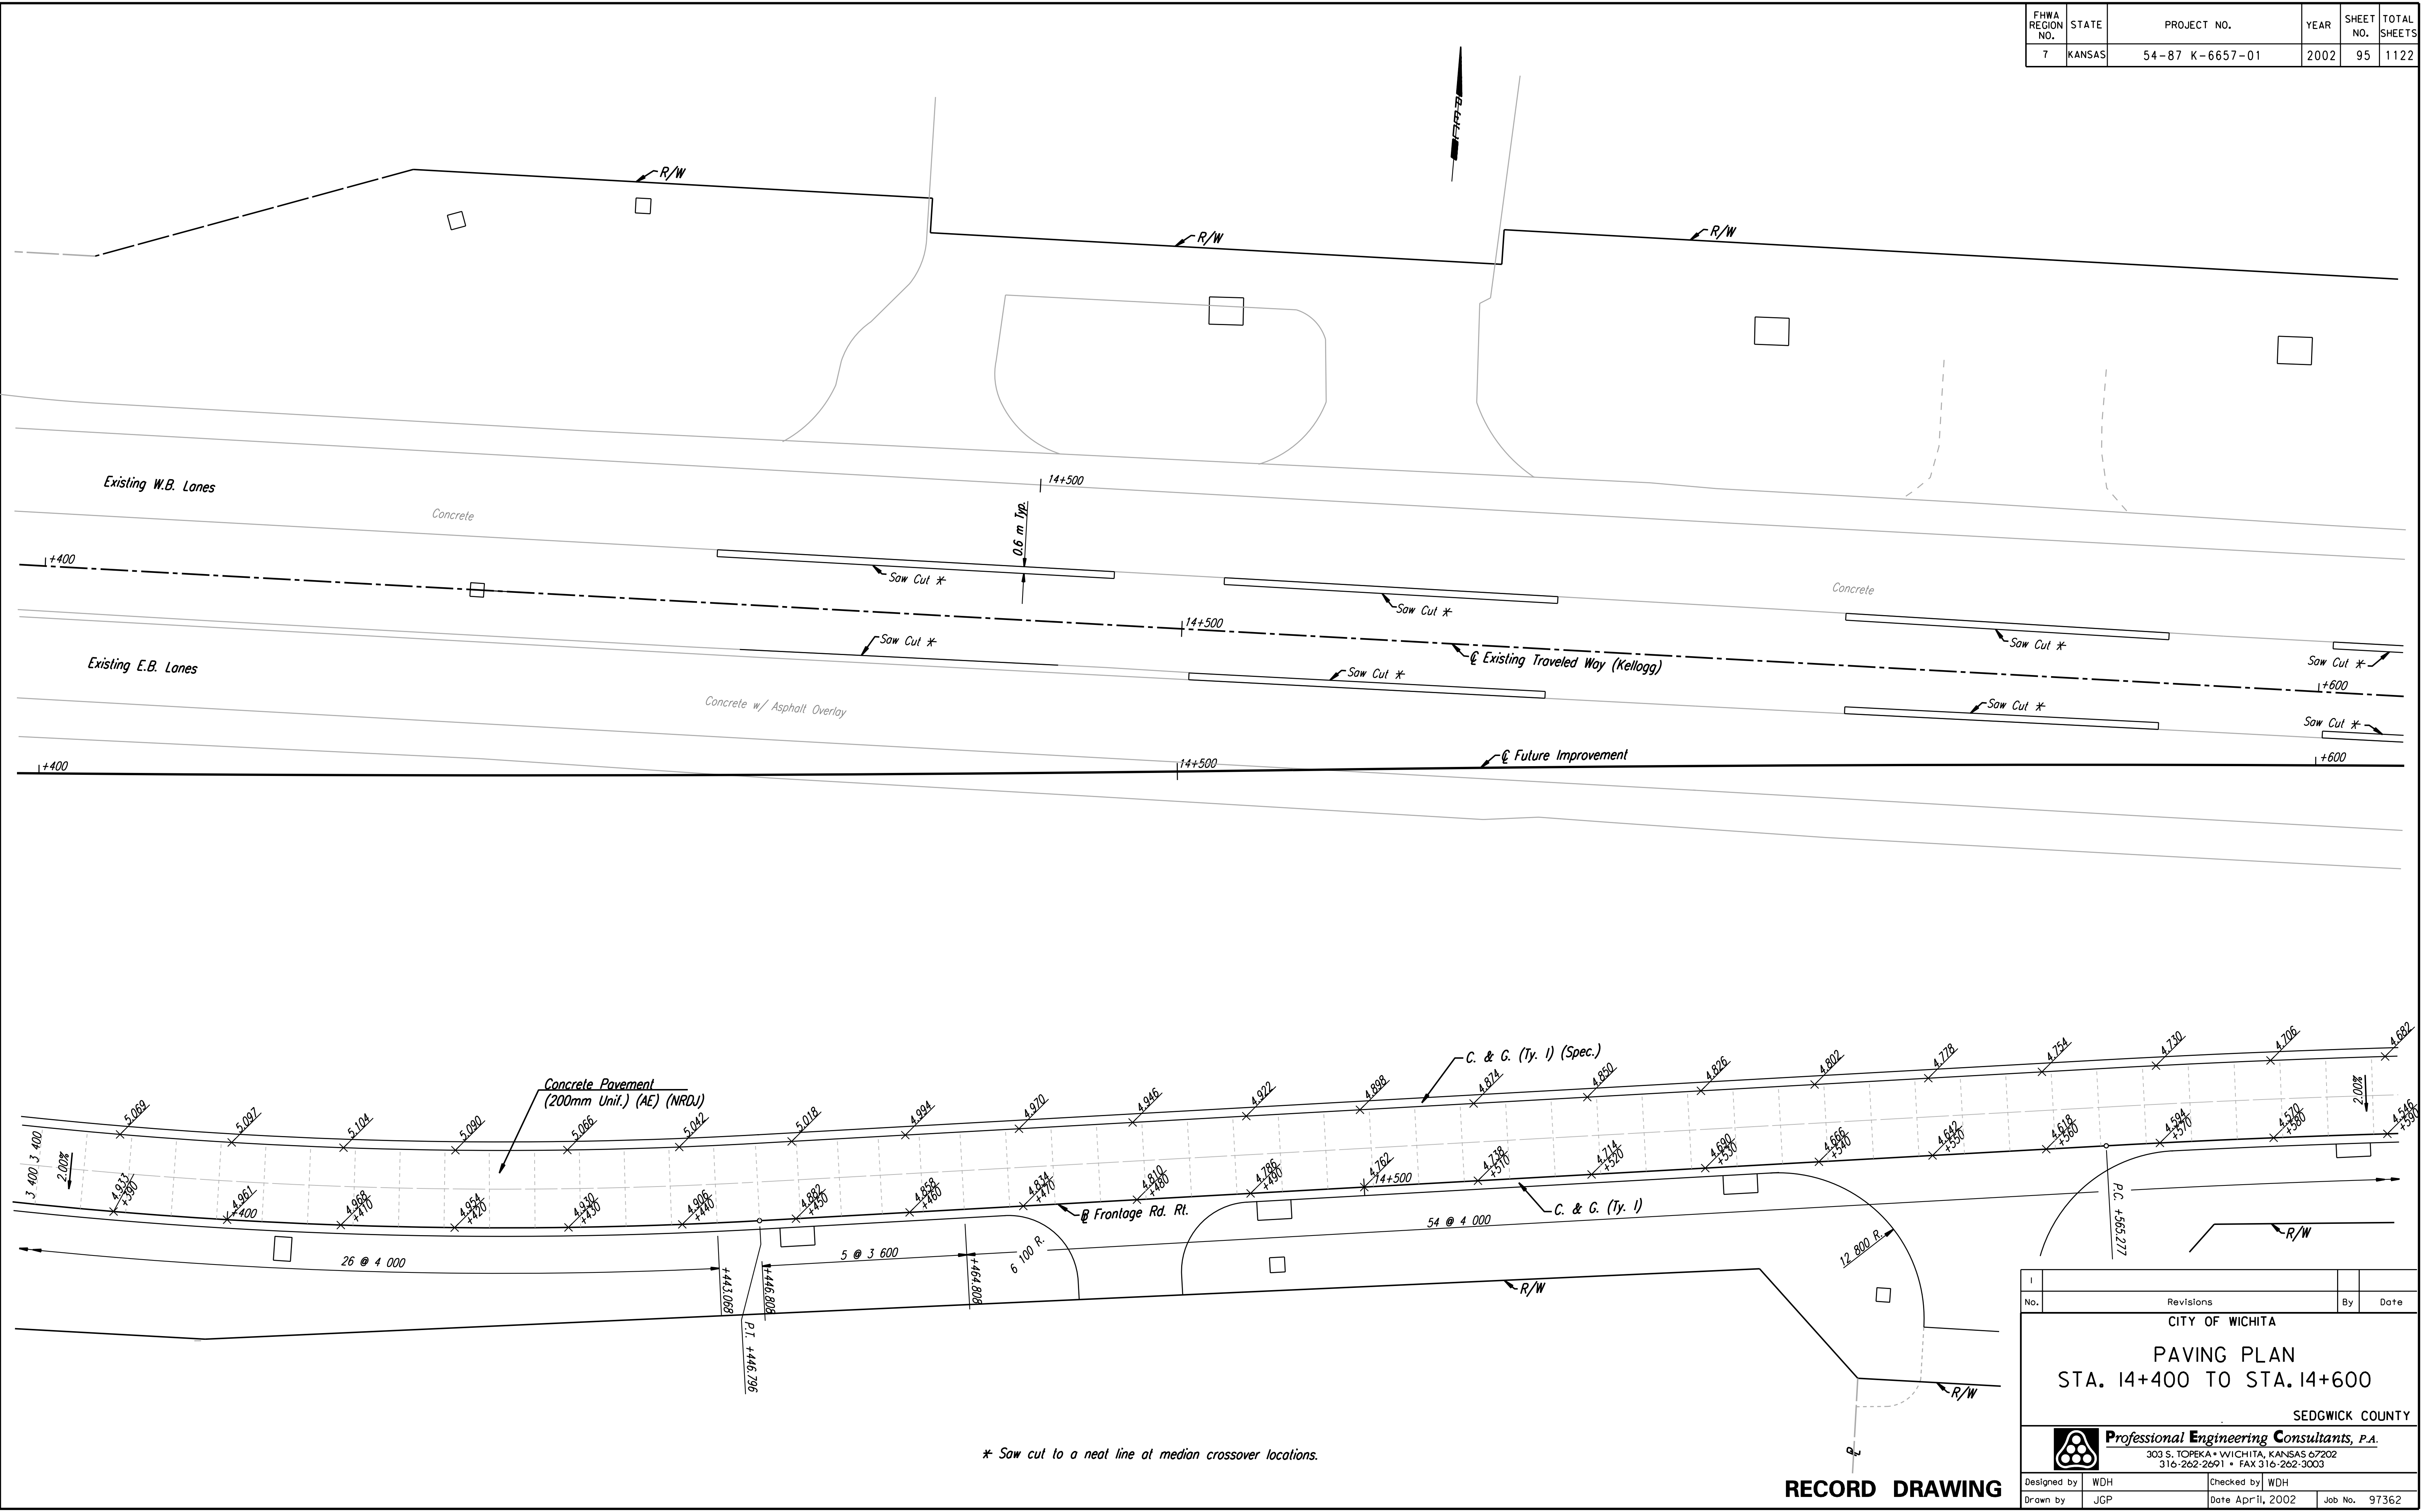

DSNR: WDH OPER: JGP SCALE: 1:250
 i:/1997/97362/As-Builts/dgn s/ISL_095-pav144.dgn Last Rev: 8-10-07 By: gdr

* Saw cut to a neat line at median crossover locations.

RECORD DRAWING

1	Revisions	By	Date

CITY OF WICHITA
PAVING PLAN
STA. 14+00 TO STA. 14+600
 SEDGWICK COUNTY

Professional Engineering Consultants, P.A.
 303 S. TOPEKA • WICHITA, KANSAS 67202
 316-262-2691 • FAX 316-262-3003

Designed by	WDH	Checked by	WDH
Drawn by	JGP	Date	April, 2002
		Job No.	97362