


FHWA REGION NO.	STATE	PROJECT NO.	YEAR	SHEET NO.	TOTAL SHEETS
7	KANSAS	54-87 K-6657-01	2002	98	1122

DATE	
BY	
REFERENCES NOTED	
REFERENCES CHECKED	

DSNR: WDH OPER: JGP SCALE: 1:250
 i:/1997/92362/As-Builts/dgn's/Sh 098-pav150.dgn Last Rev: 8-13-07 By: gdr

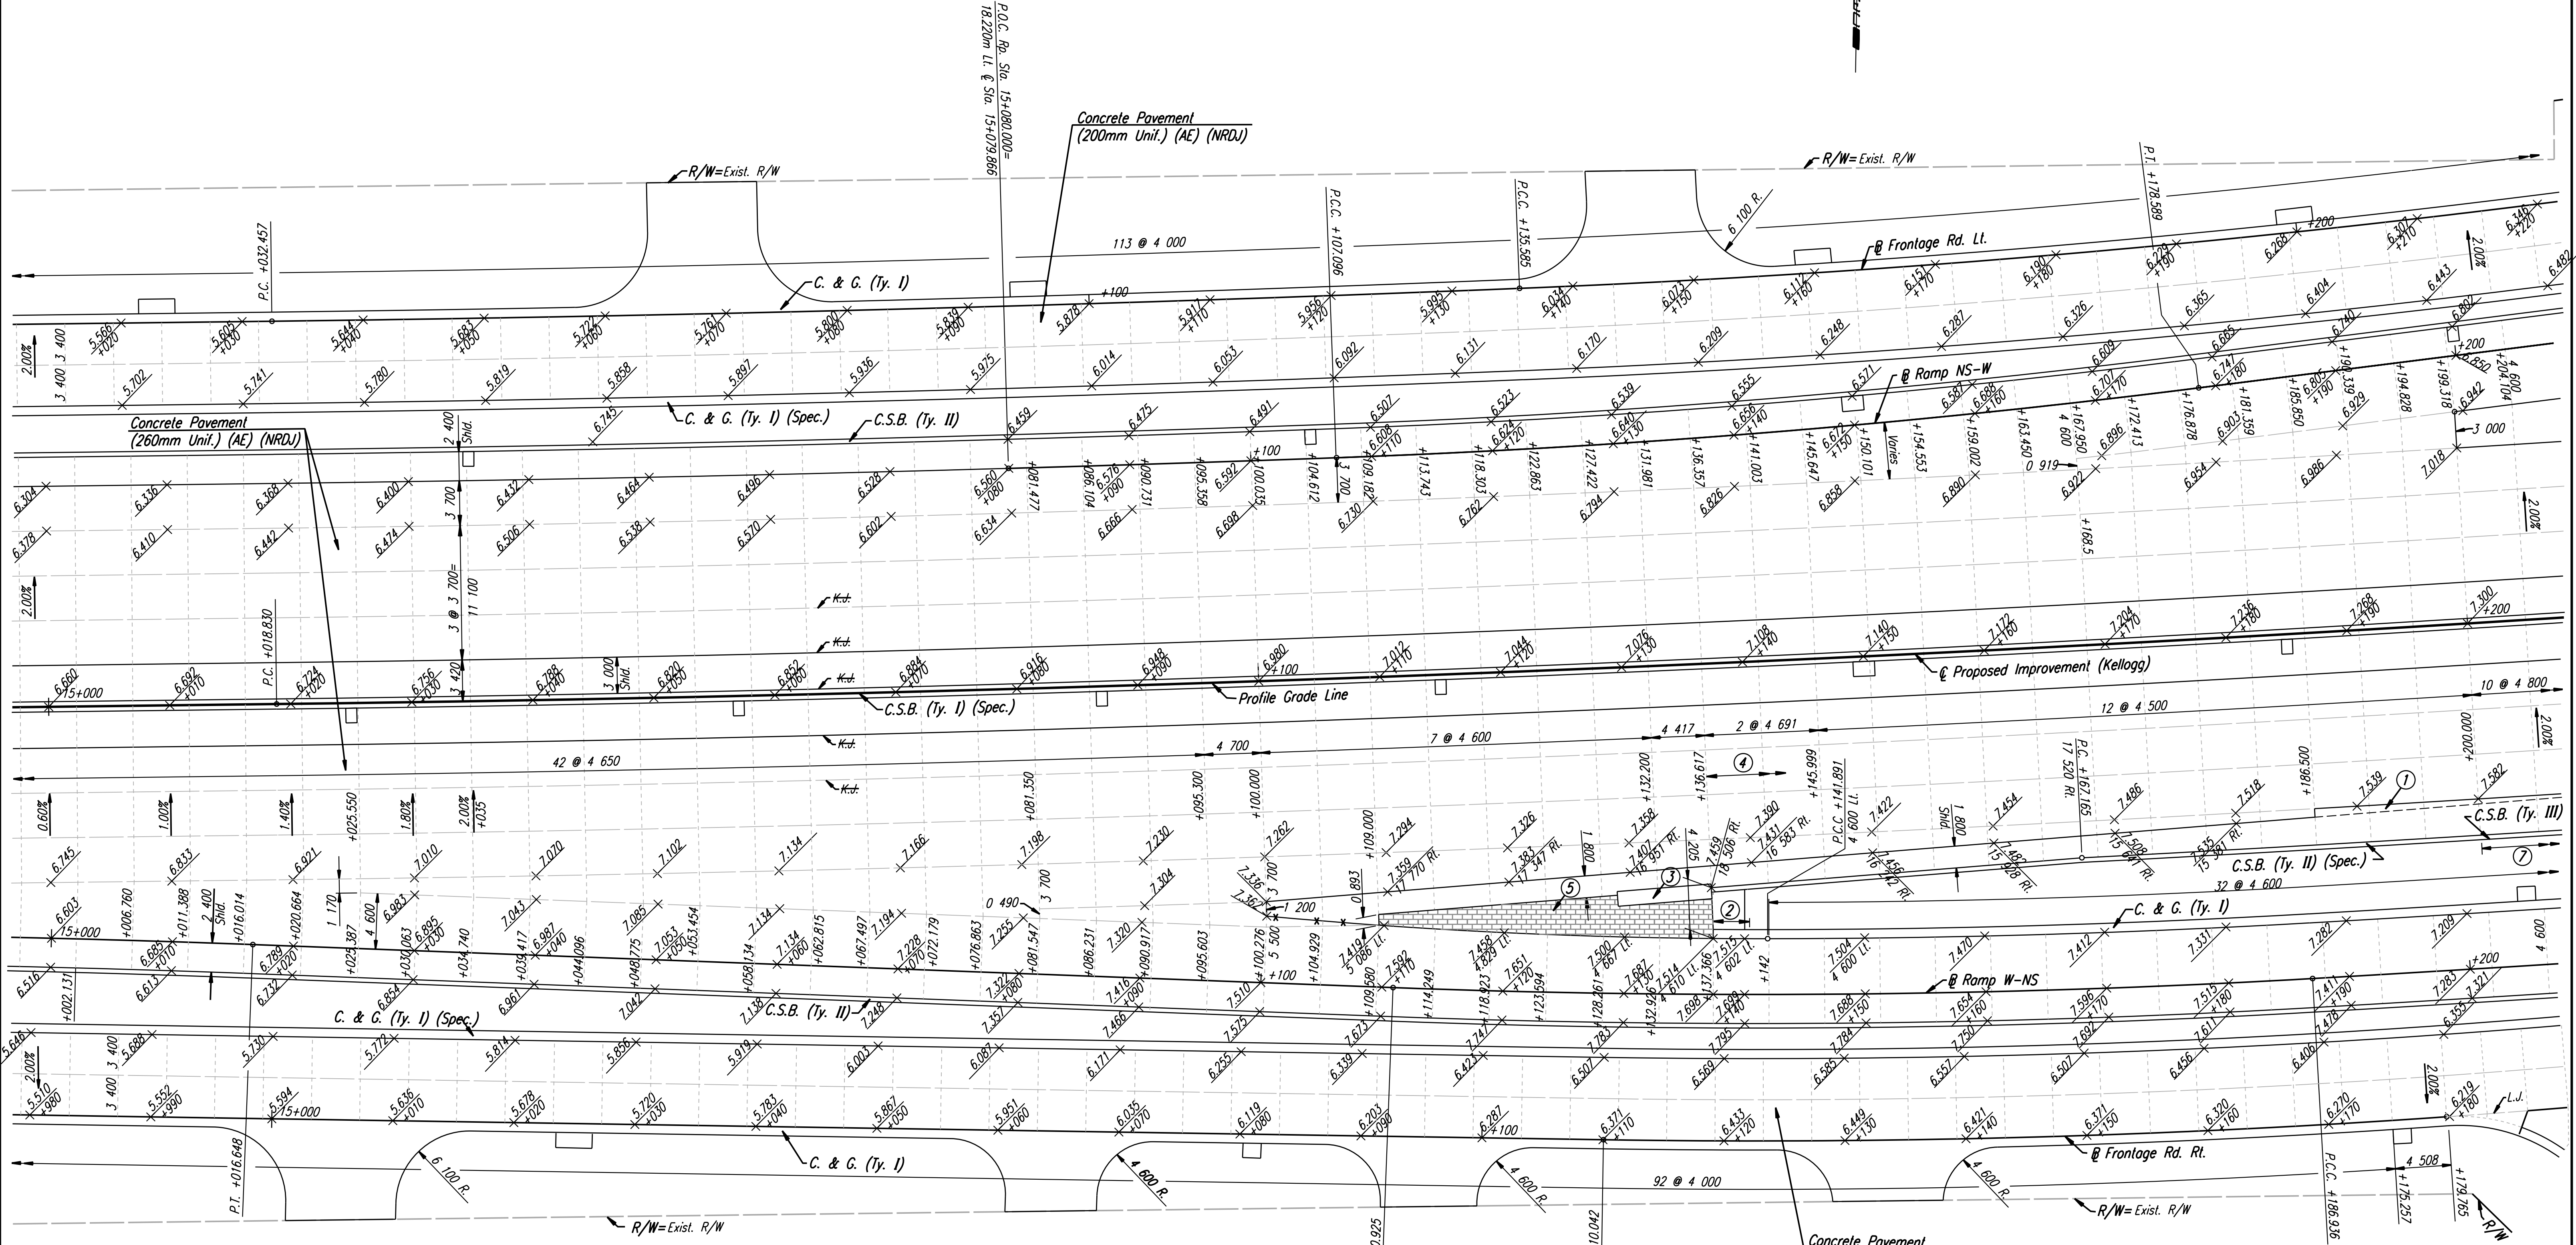

- ① To be placed monolithic with shoulder pavement. Paid for as "Concrete Pavement (260 mm Unit.) (AE) (NRDU).
- ② 3.0 m transition from no curb to 150mm curb.
- ③ Impact Attenuator. See Sh. No. 236 for Concrete Pad & Backup Wall Details.
- ④ Shoulder & Escape Lane X-Slope +2.0% Rt. Ahead.
- ⑤ Integrally Colored Cement Concrete Pavement (D=260mm) See Landscape Plans
- ⑦ C.S.B. Ty.III Sta. 15+200 to Sta. 15+230.

NOTE:
Tie bars were omitted across all Side Roads along Frontage Road Pavement.

RECORD DRAWING

No.	Revisions	By	Date

CITY OF WICHITA
PAVING PLAN
 STA. 15+000 TO STA. 15+200
 SEDGWICK COUNTY

Professional Engineering Consultants, P.A.
 303 S. TOPEKA • WICHITA, KANSAS 67202
 316-262-2691 • FAX 316-262-3003

Designed by	WDH	Checked by	WDH
Drawn by	JGP	Date	Apr 11, 2002
		Job No.	97362