

FHWA REGION NO.	STATE	PROJECT NO.	YEAR	SHEET NO.	TOTAL SHEETS
7	KANSAS	54-87 K-6657-01	2002	231	1122

NOTE:
 Delineator buttons installed at 60 m spacing along ϕ CSB.
 All ramps delineators installed at 30 m spacing.

GENERAL NOTES

The delineators shall be spaced on 60 m centers, except through curves of radius less than 580 m and along ramps and ramp tapers where the spacing shall be on 30 m centers. Delineators should be installed back to back when used on 810 mm median barrier for two-way roadways. The delineator color shall be yellow when used on the left side or white when used on the right side of the roadway.

The flat sheet sign blank shall be made of the aluminum alloy and thickness shown.

The 76 mm x 200 mm delineator sign face shall be covered with high performance white reflective sheeting. The 125 mm x 125 mm delineator sign face shall be covered with high performance yellow reflecting sheeting.

The type of adhesive for reflective sheeting shall be heat activated or pressure sensitive.

The 83 mm diameter white or yellow button delineator shall comply with the KDOT Standard Specifications.

The delineator bracket shall be fabricated from aluminum in the thickness and sizes shown. The material for the brackets shall comply with the Standard Specifications. All holes for mounting the delineator to the bracket shall be 10 mm diameter. The holes for mounting the bracket to the barrier shall be 11 mm diameter. All burrs and sharp edges shall be smoothed off. The brackets shall not be fabricated by the use of welding.


All items of the fastening accessories shall be Zinc or Cadmium plated.

The machine screws, nuts, and washers used to fasten the delineator to the bracket shall comply with the Standard Specifications.


Only one type of delineator shall be used on any project. The type of delineator (flat sheet or button) used on the project shall be as directed by the Engineer.

All work and materials required for the installation of the delineators shall be Subsidiary to the bid item "Concrete Safety Barrier".


When delineators are installed on median or roadside barriers approaching a bridge, they shall be installed on the bridge rail in accordance with the spacing and details on this sheet.

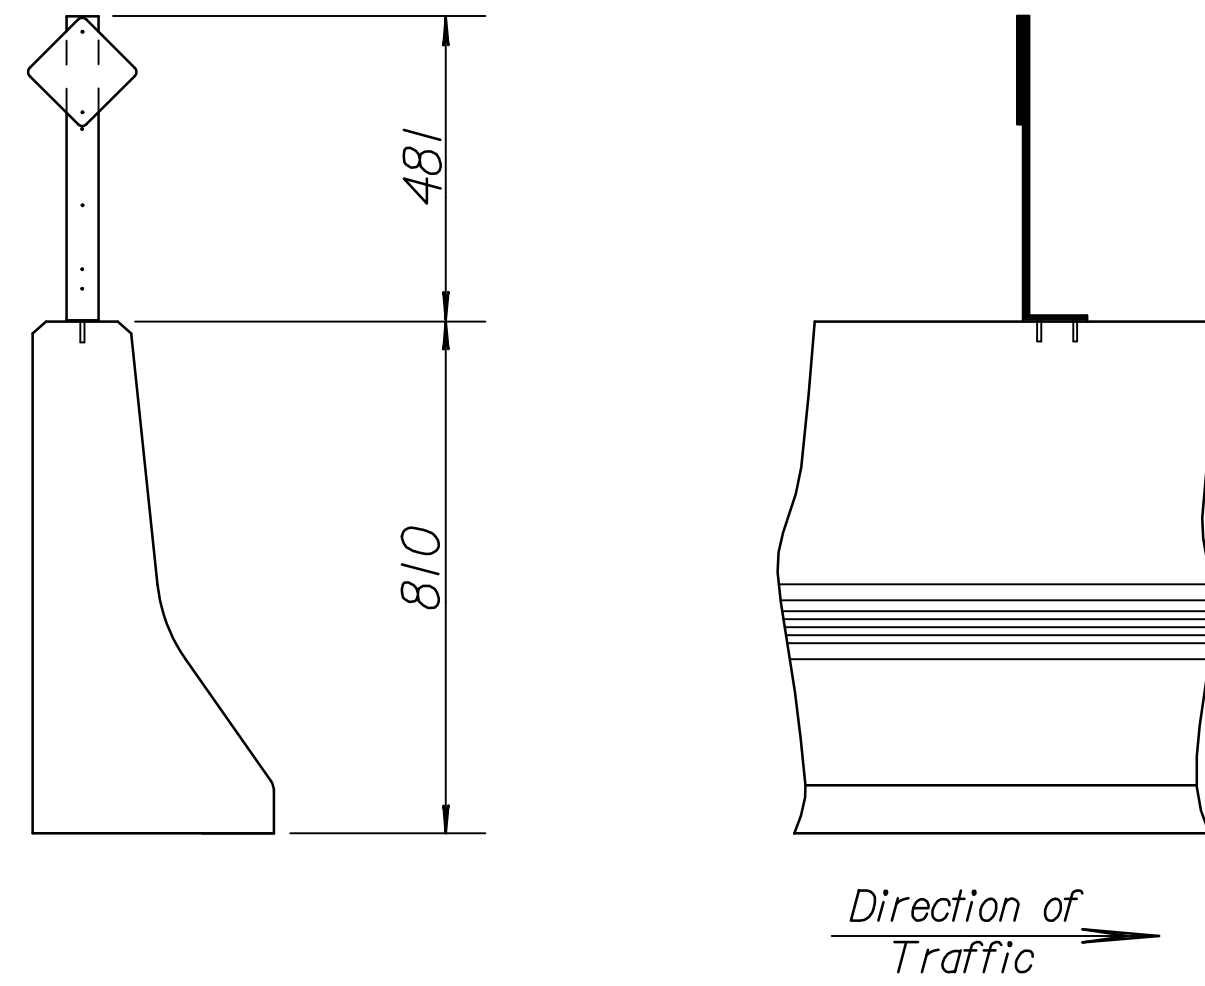

TYPICAL MOUNTING DETAIL

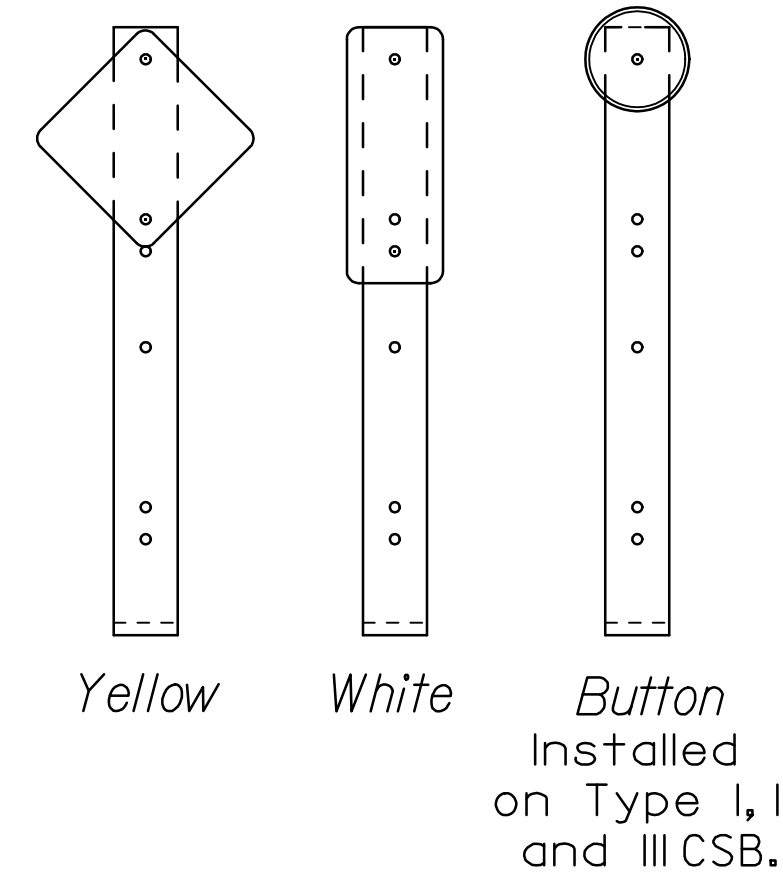


DELINEATOR POSITION DETAILS

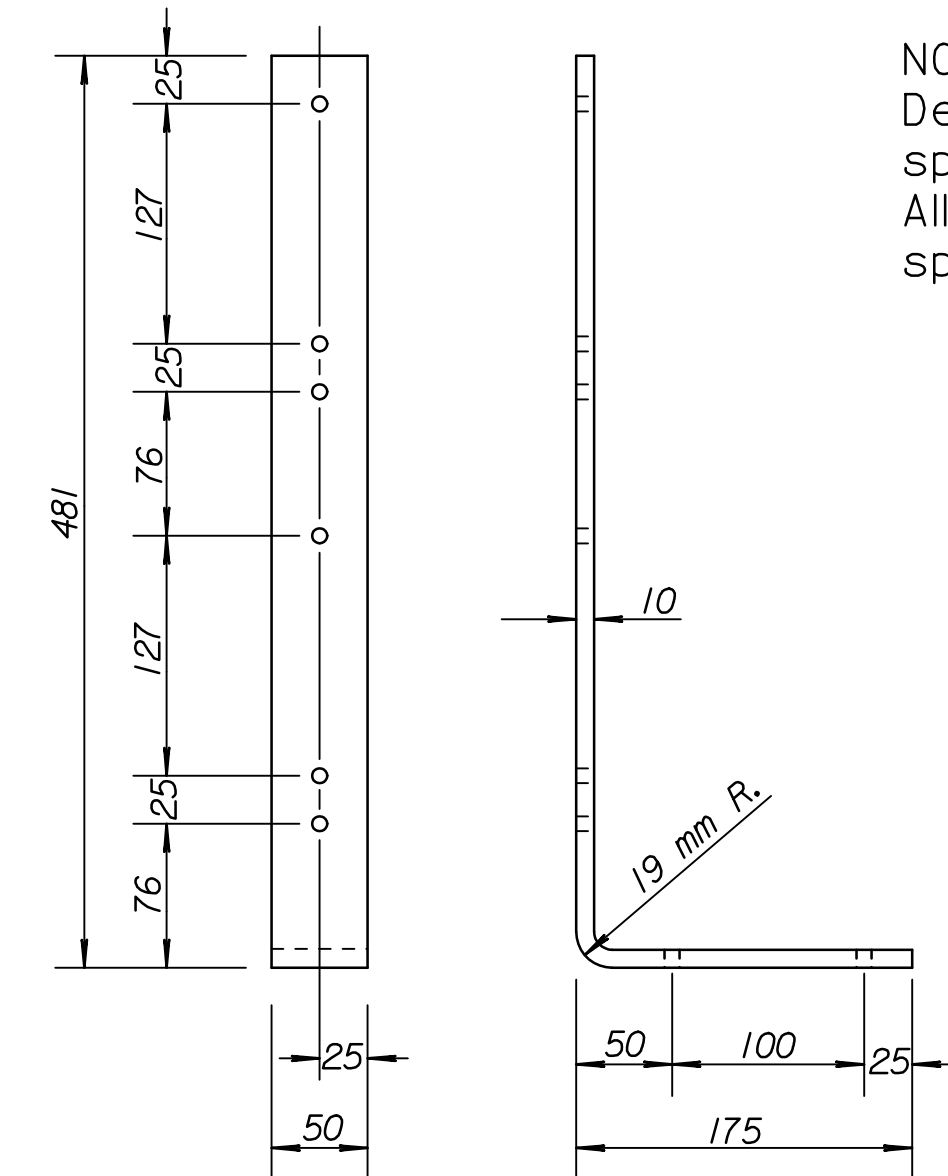


DELINEATOR BRACKET DETAILS


DESIGN DETAILS FOR DELINEATION ON 810 mm CONCRETE SAFETY BARRIER SECTION

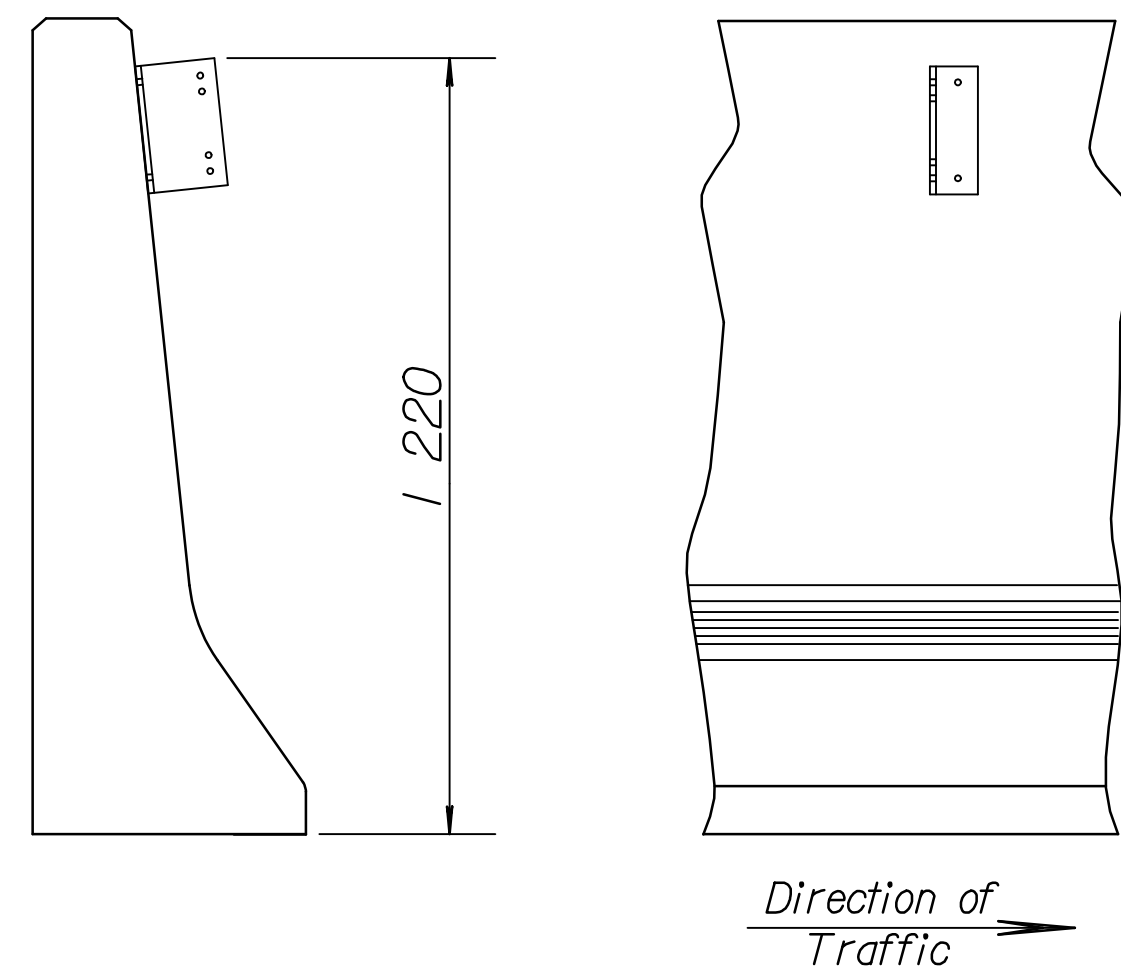

TYPICAL MOUNTING DETAIL

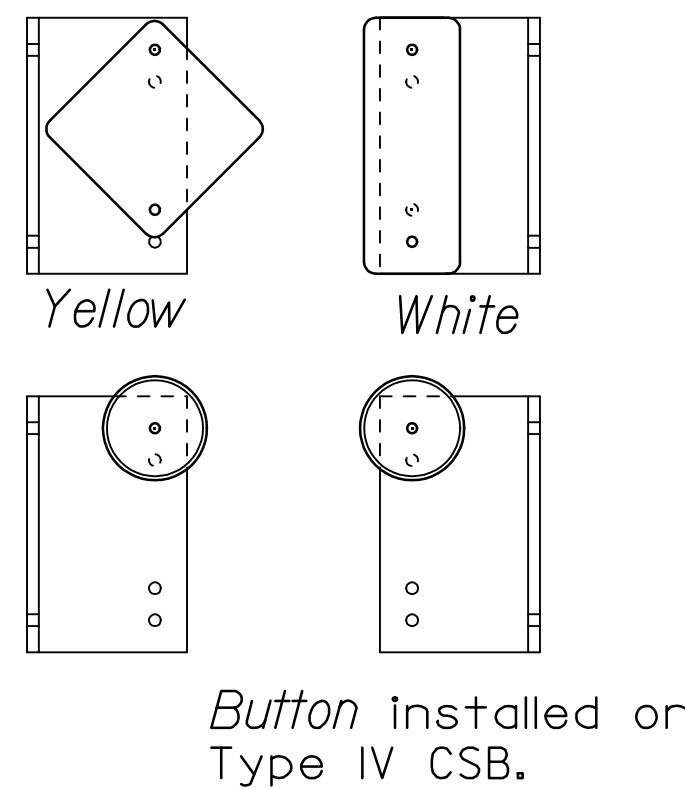


DELINEATOR POSITION DETAILS

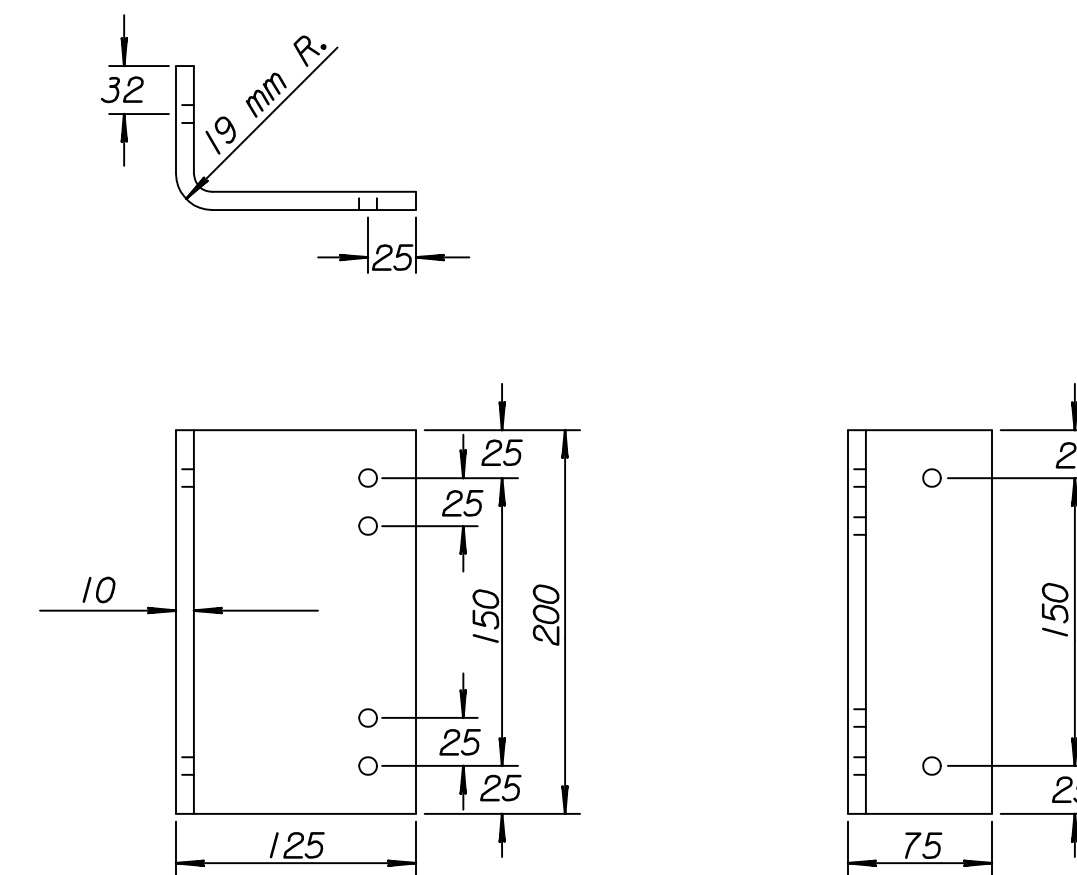


DELINEATOR BRACKET DETAILS

DESIGN DETAILS FOR DELINEATION ON 1295 mm CONCRETE SAFETY BARRIER SECTION

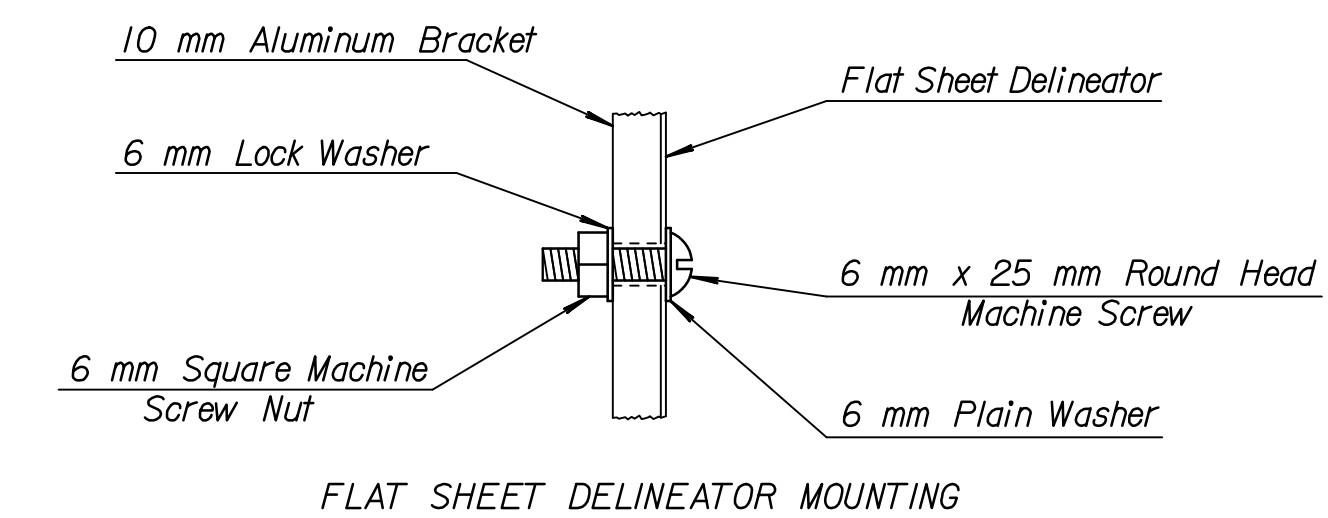


FLAT SHEET DELINEATOR MOUNTING

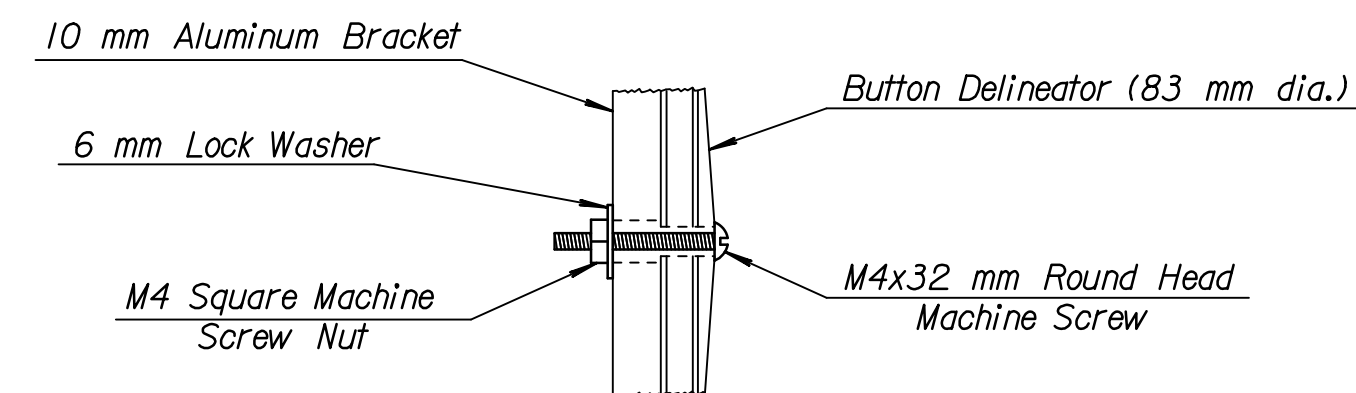

BUTTON DELINEATOR MOUNTING

DETAILS FOR ATTACHING DELINEATORS TO BRACKETS

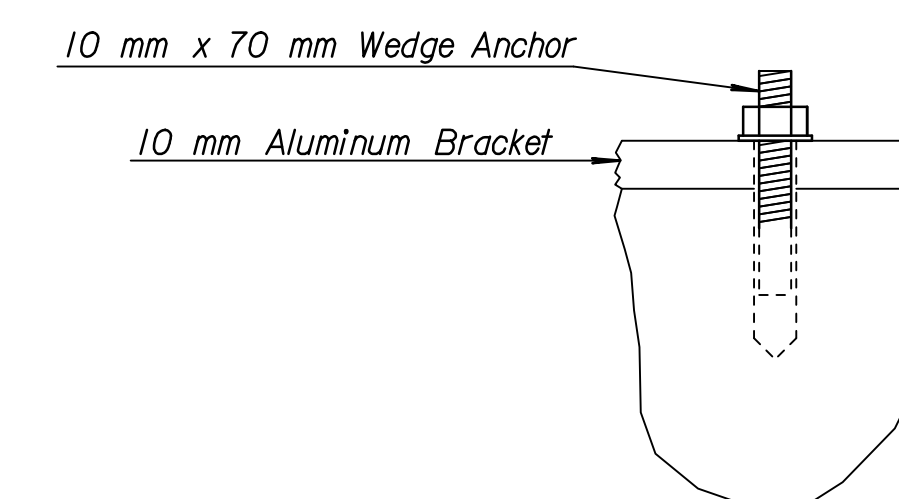


DETAILS FOR ATTACHING BRACKETS TO SAFETY BARRIER

RECORD DRAWING

KANSAS DEPARTMENT OF TRANSPORTATION				
NO.	DATE	REVISIONS	BY	APP'D
DESIGN DETAILS FOR DELINEATION ON CONCRETE SAFETY BARRIER				
RD649 SI				
DESIGNED	7-13-94	APPROVED	James O. Brewer	
DESIGN CK.	DETAIL CK.	QUANTITIES	TRACED	Bowser
		QUAN. CK.	TRACE	CK. Seitz

NOTE: The aluminum sign blanks are to be ASTM B-209(H), Alloy 6061-T6, or 5154-H38, or 5052-H38. The aluminum sign blank shall be 1 mm thick. Both faces and all cut edges of sign to be degreased and etched. All holes shall be 8 mm diameter.

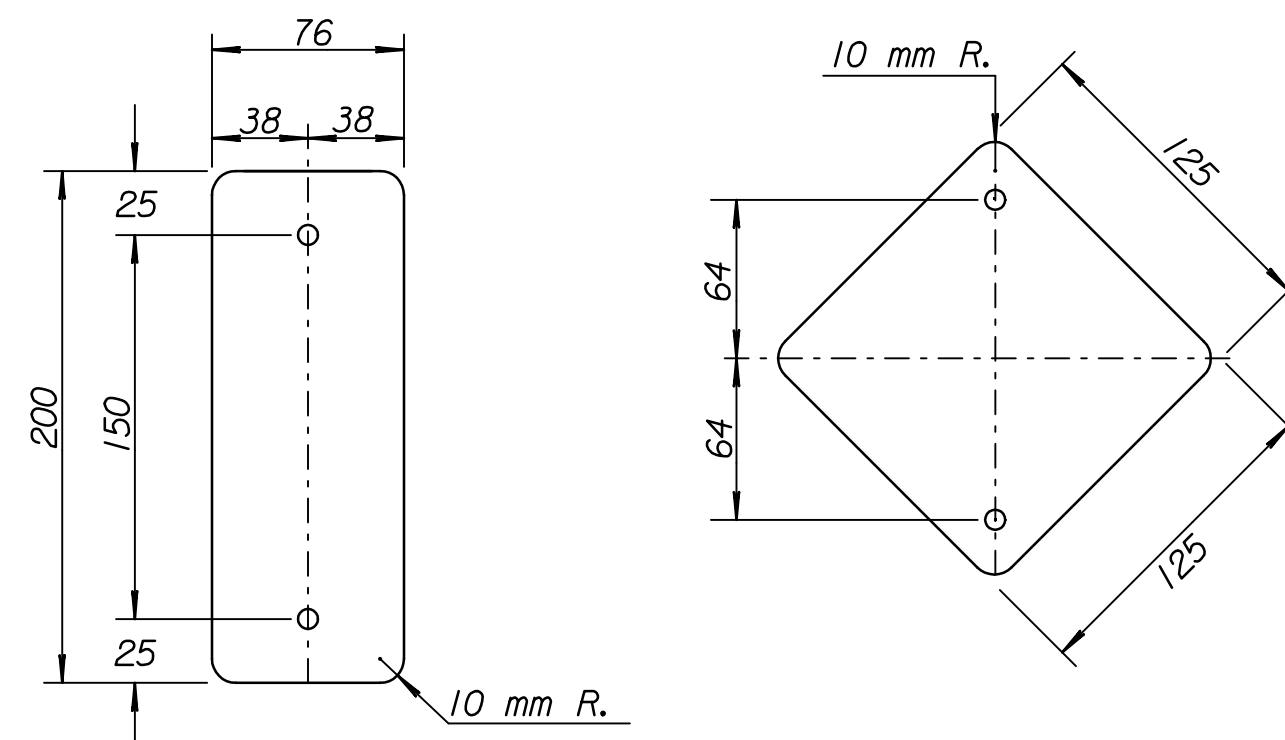

FLAT SHEET SIGN BLANK DETAILS:

Drawn By: gdr
 Plofted: 8-20-2007
 File: I:\1997\97362\As-Builts\dgn\Sh 231-KDOT_SID-RD649SI.dgn
 Last Rev: 8-20-07 By: gdr