


FHWA REGION NO.	STATE	PROJECT NO.	YEAR	SHEET NO.	TOTAL SHEETS
7	KANSAS	54-87 K-6657-01	2002	102	1122

DATE	
BY	
REFERENCES NOTED	
REFERENCES CHECKED	

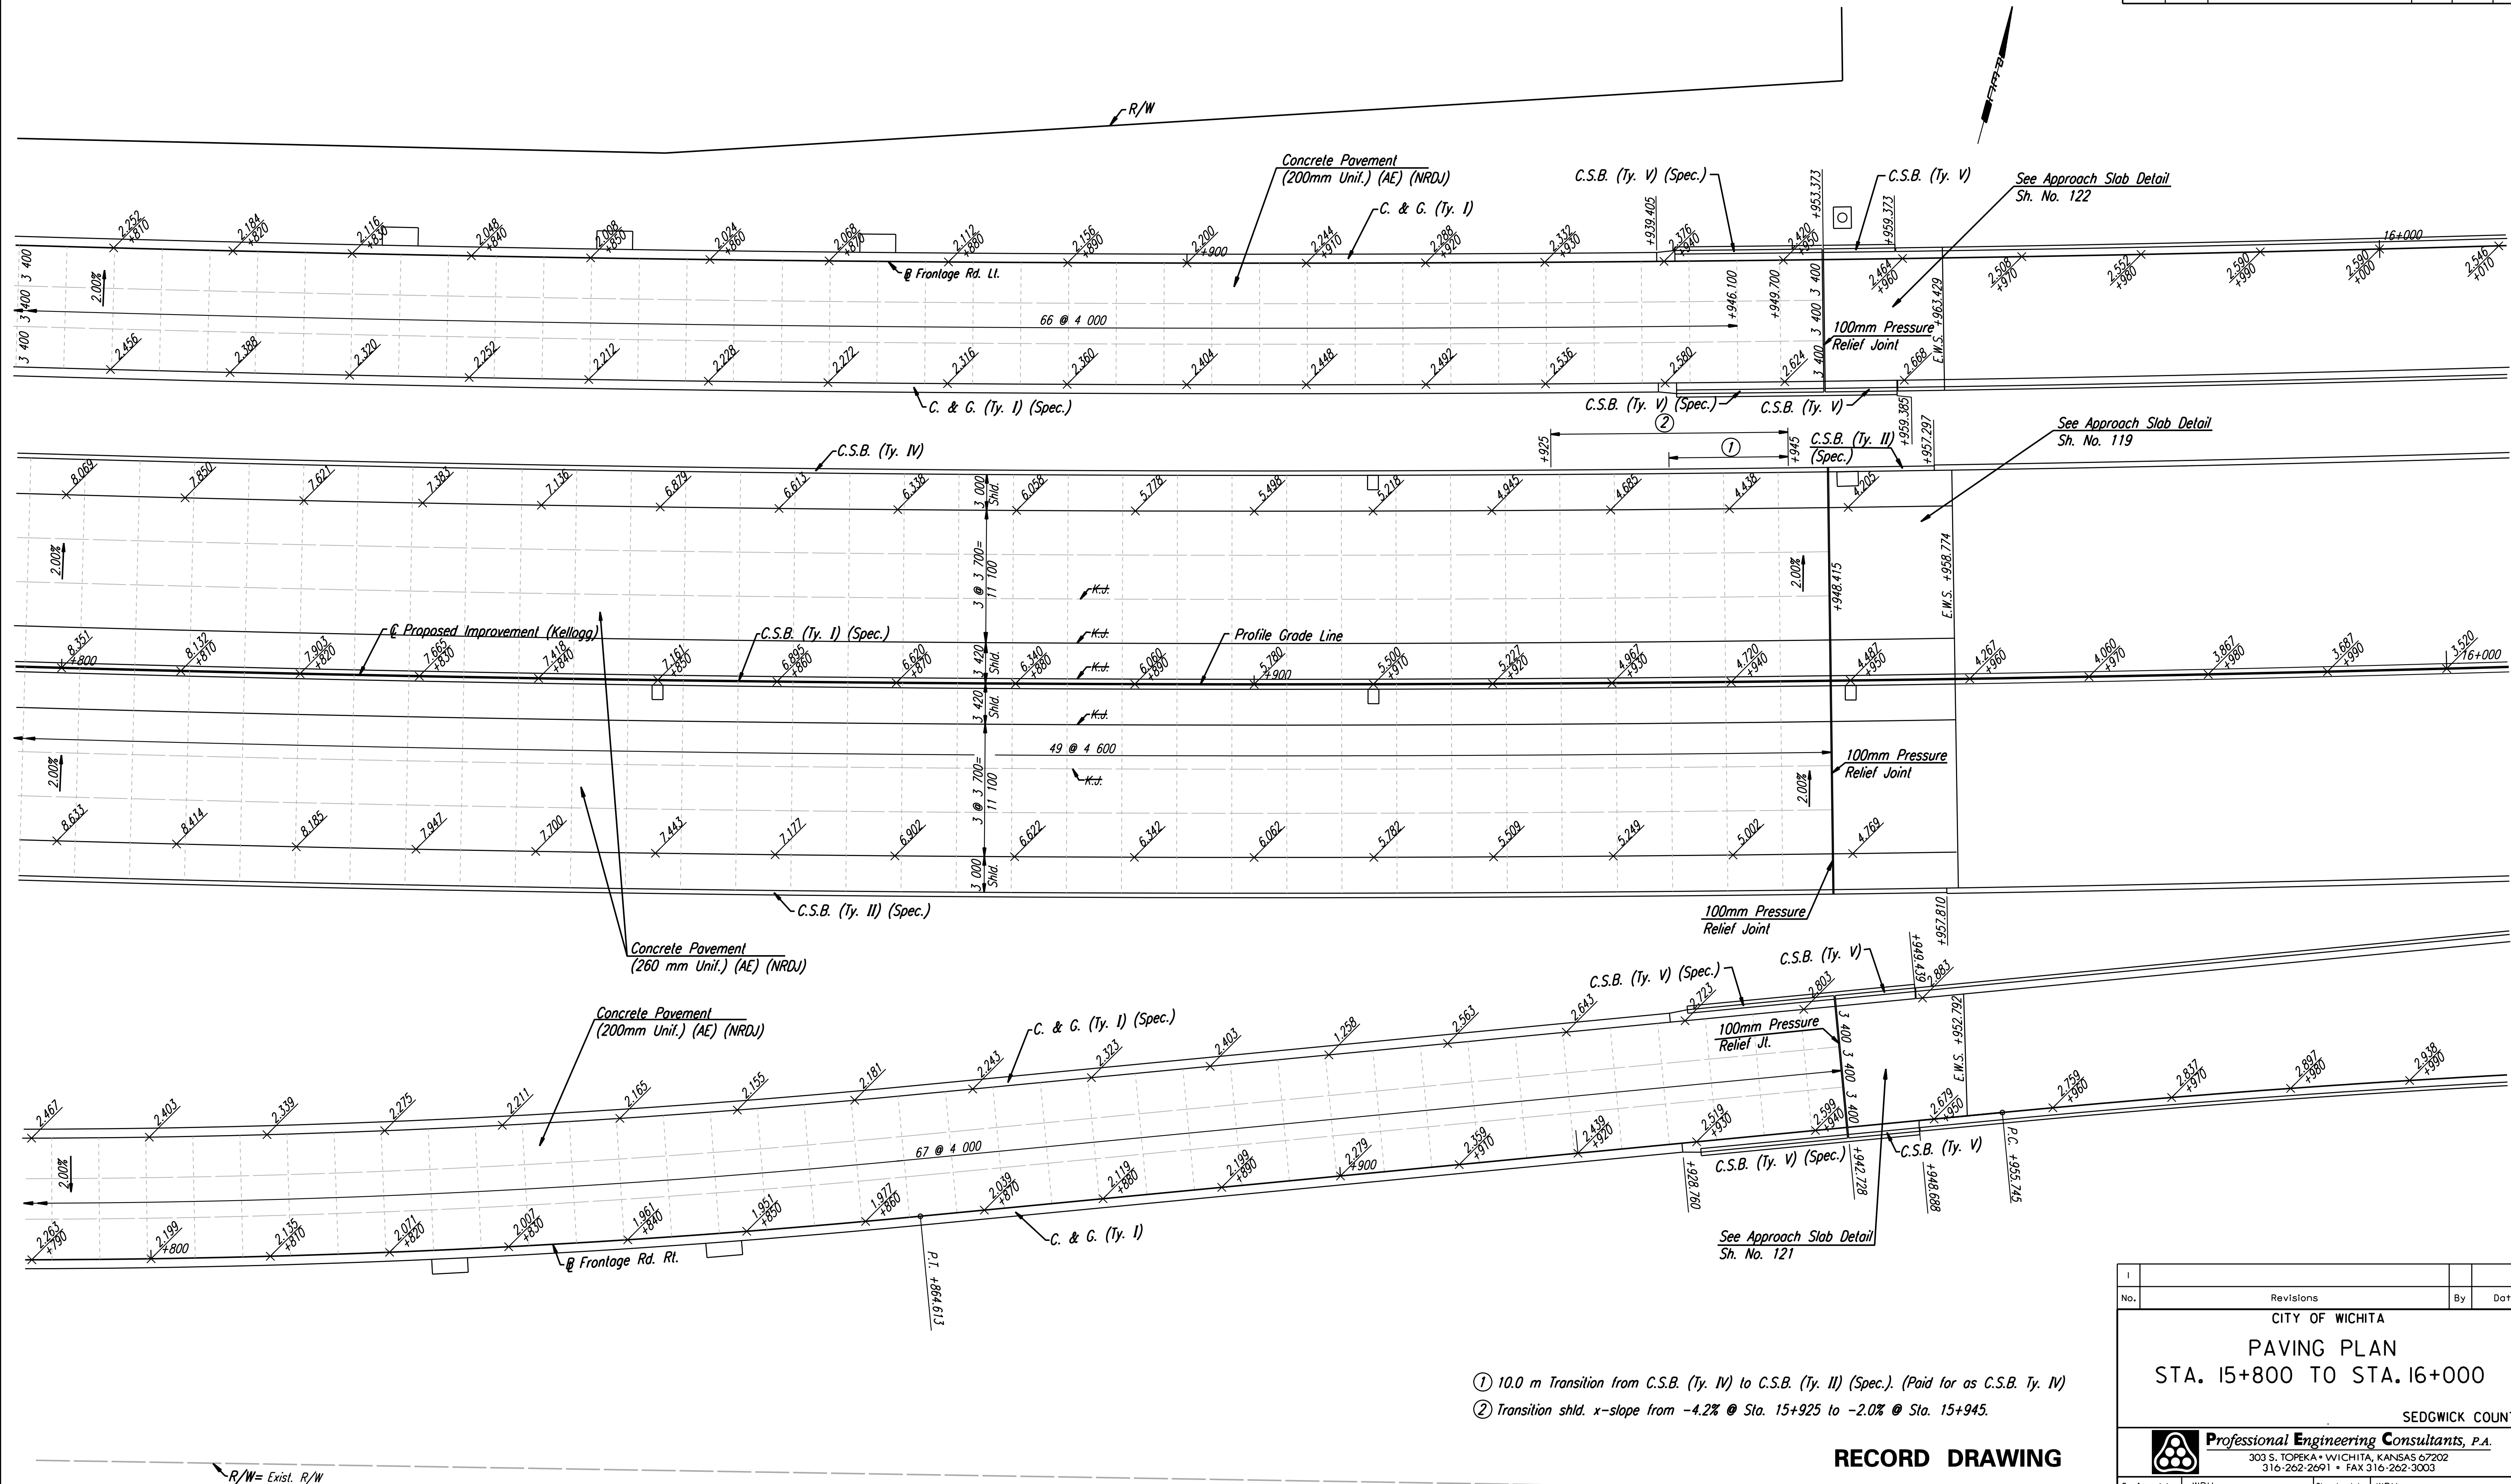

DSNR: WDH OPER: JGP SCALE: 1:250  
 I:/1997/97362/As-Builts/dgn's/Sh 102-pav158.dgn Last Rev: 8-13-07 By: gdr

- ① 10.0 m Transition from C.S.B. (Ty. IV) to C.S.B. (Ty. II) (Spec.). (Paid for as C.S.B. Ty. IV)
- ② Transition shld. x-slope from -4.2% @ Sta. 15+925 to -2.0% @ Sta. 15+945.

**RECORD DRAWING**

No.	Revisions	By	Date

**CITY OF WICHITA**  
**PAVING PLAN**  
**STA. 15+800 TO STA. 16+000**  
 SEDGWICK COUNTY

**Professional Engineering Consultants, P.A.**  
303 S. TOPEKA • WICHITA, KANSAS 67202  
 316-262-2691 • FAX 316-262-3003

Designed by	WDH	Checked by	WDH
Drawn by	JGP	Date	April, 2002
		Job No.	97362