


FHWA REGION NO.	STATE	PROJECT NO.	YEAR	SHEET NO.	TOTAL SHEETS
7	KANSAS	54-87 K-6657-01	2002	105	1122

DATE	
BY	
REFERENCES NOTED	
REFERENCES CHECKED	

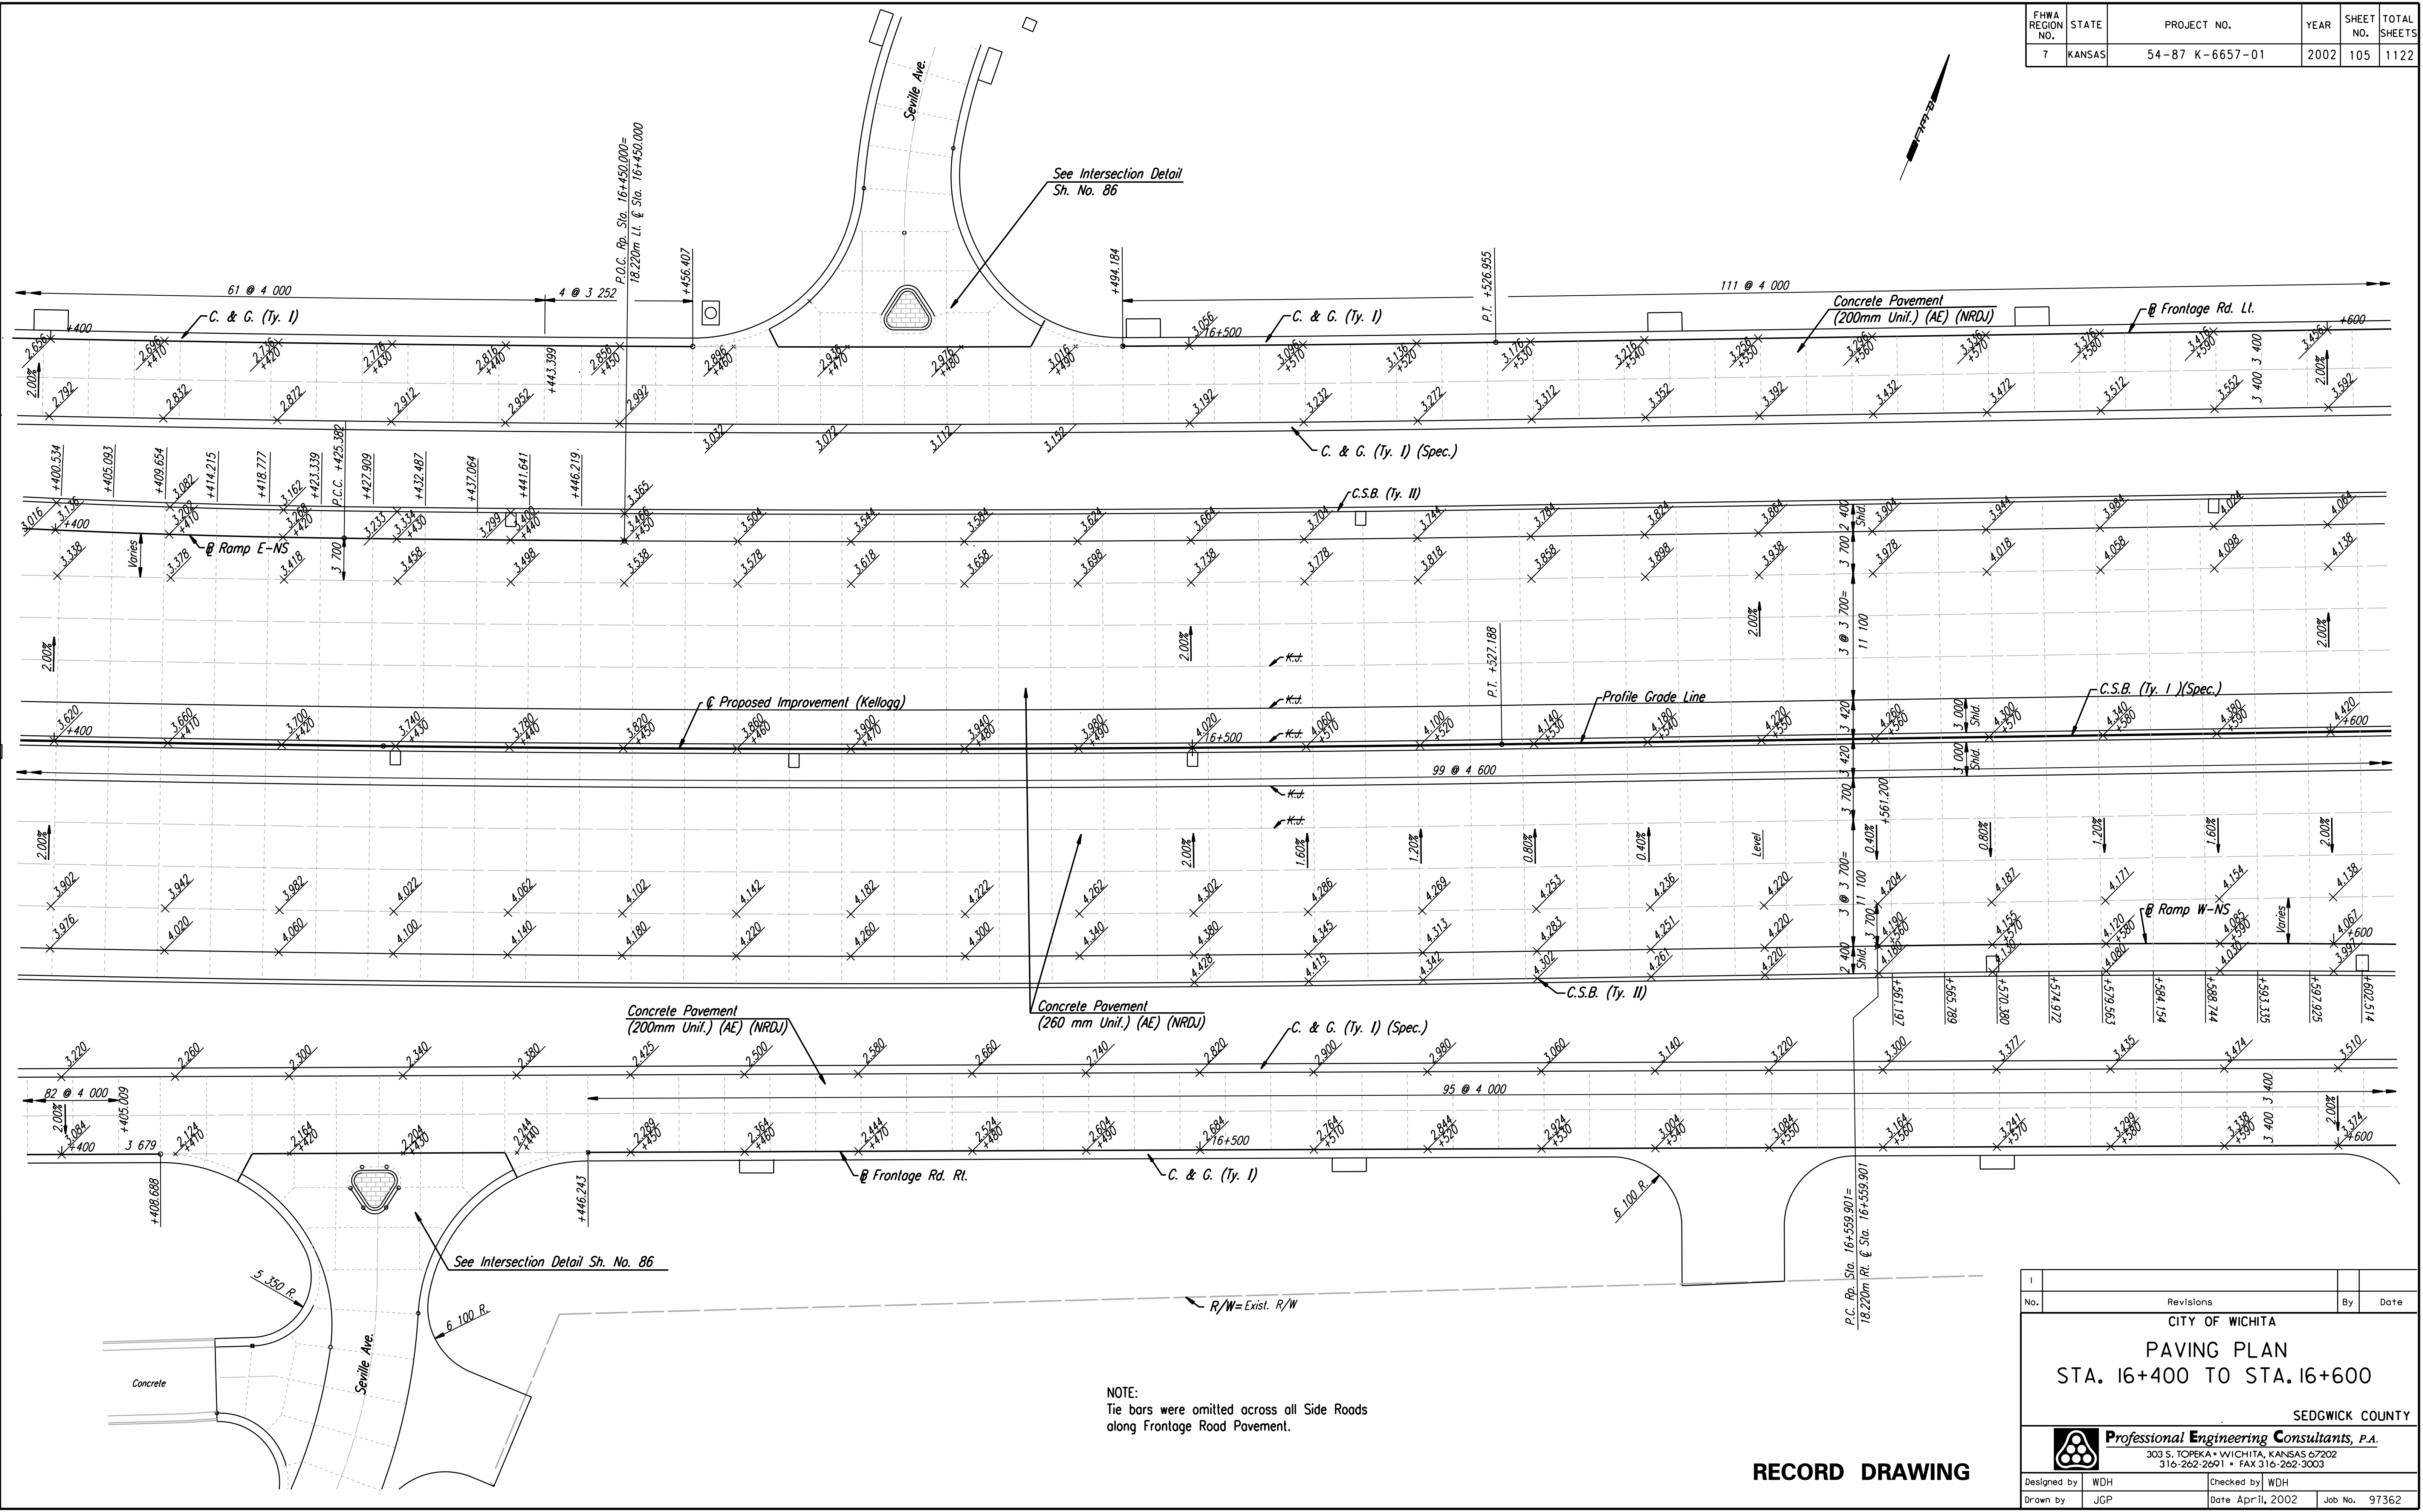

DSNR: WDH OPER: JGP SCALE: 1:250  
 I:/1997/97362/As-Builts/dgn's/Sh 105-pav164.dgn Last Rev: 8-13-07 By: gdr

NOTE:  
 Tie bars were omitted across all Side Roads along Frontage Road Pavement.

**RECORD DRAWING**

No.	Revisions	By	Date

CITY OF WICHITA  
**PAVING PLAN**  
 STA. 16+400 TO STA. 16+600

SEDGWICK COUNTY

**Professional Engineering Consultants, P.A.**  
 303 S. TOPEKA • WICHITA, KANSAS 67202  
 316-262-2691 • FAX 316-262-3003

Designed by	WDH	Checked by	WDH
Drawn by	JGP	Date	April, 2002
		Job No.	97362