


FHWA REGION NO.	STATE	PROJECT NO.	YEAR	SHEET NO.	TOTAL SHEETS
7	KANSAS	54-87 K-6657-01	2002	109	1122

DATE	
BY	
REFERENCES NOTED	
REFERENCES CHECKED	

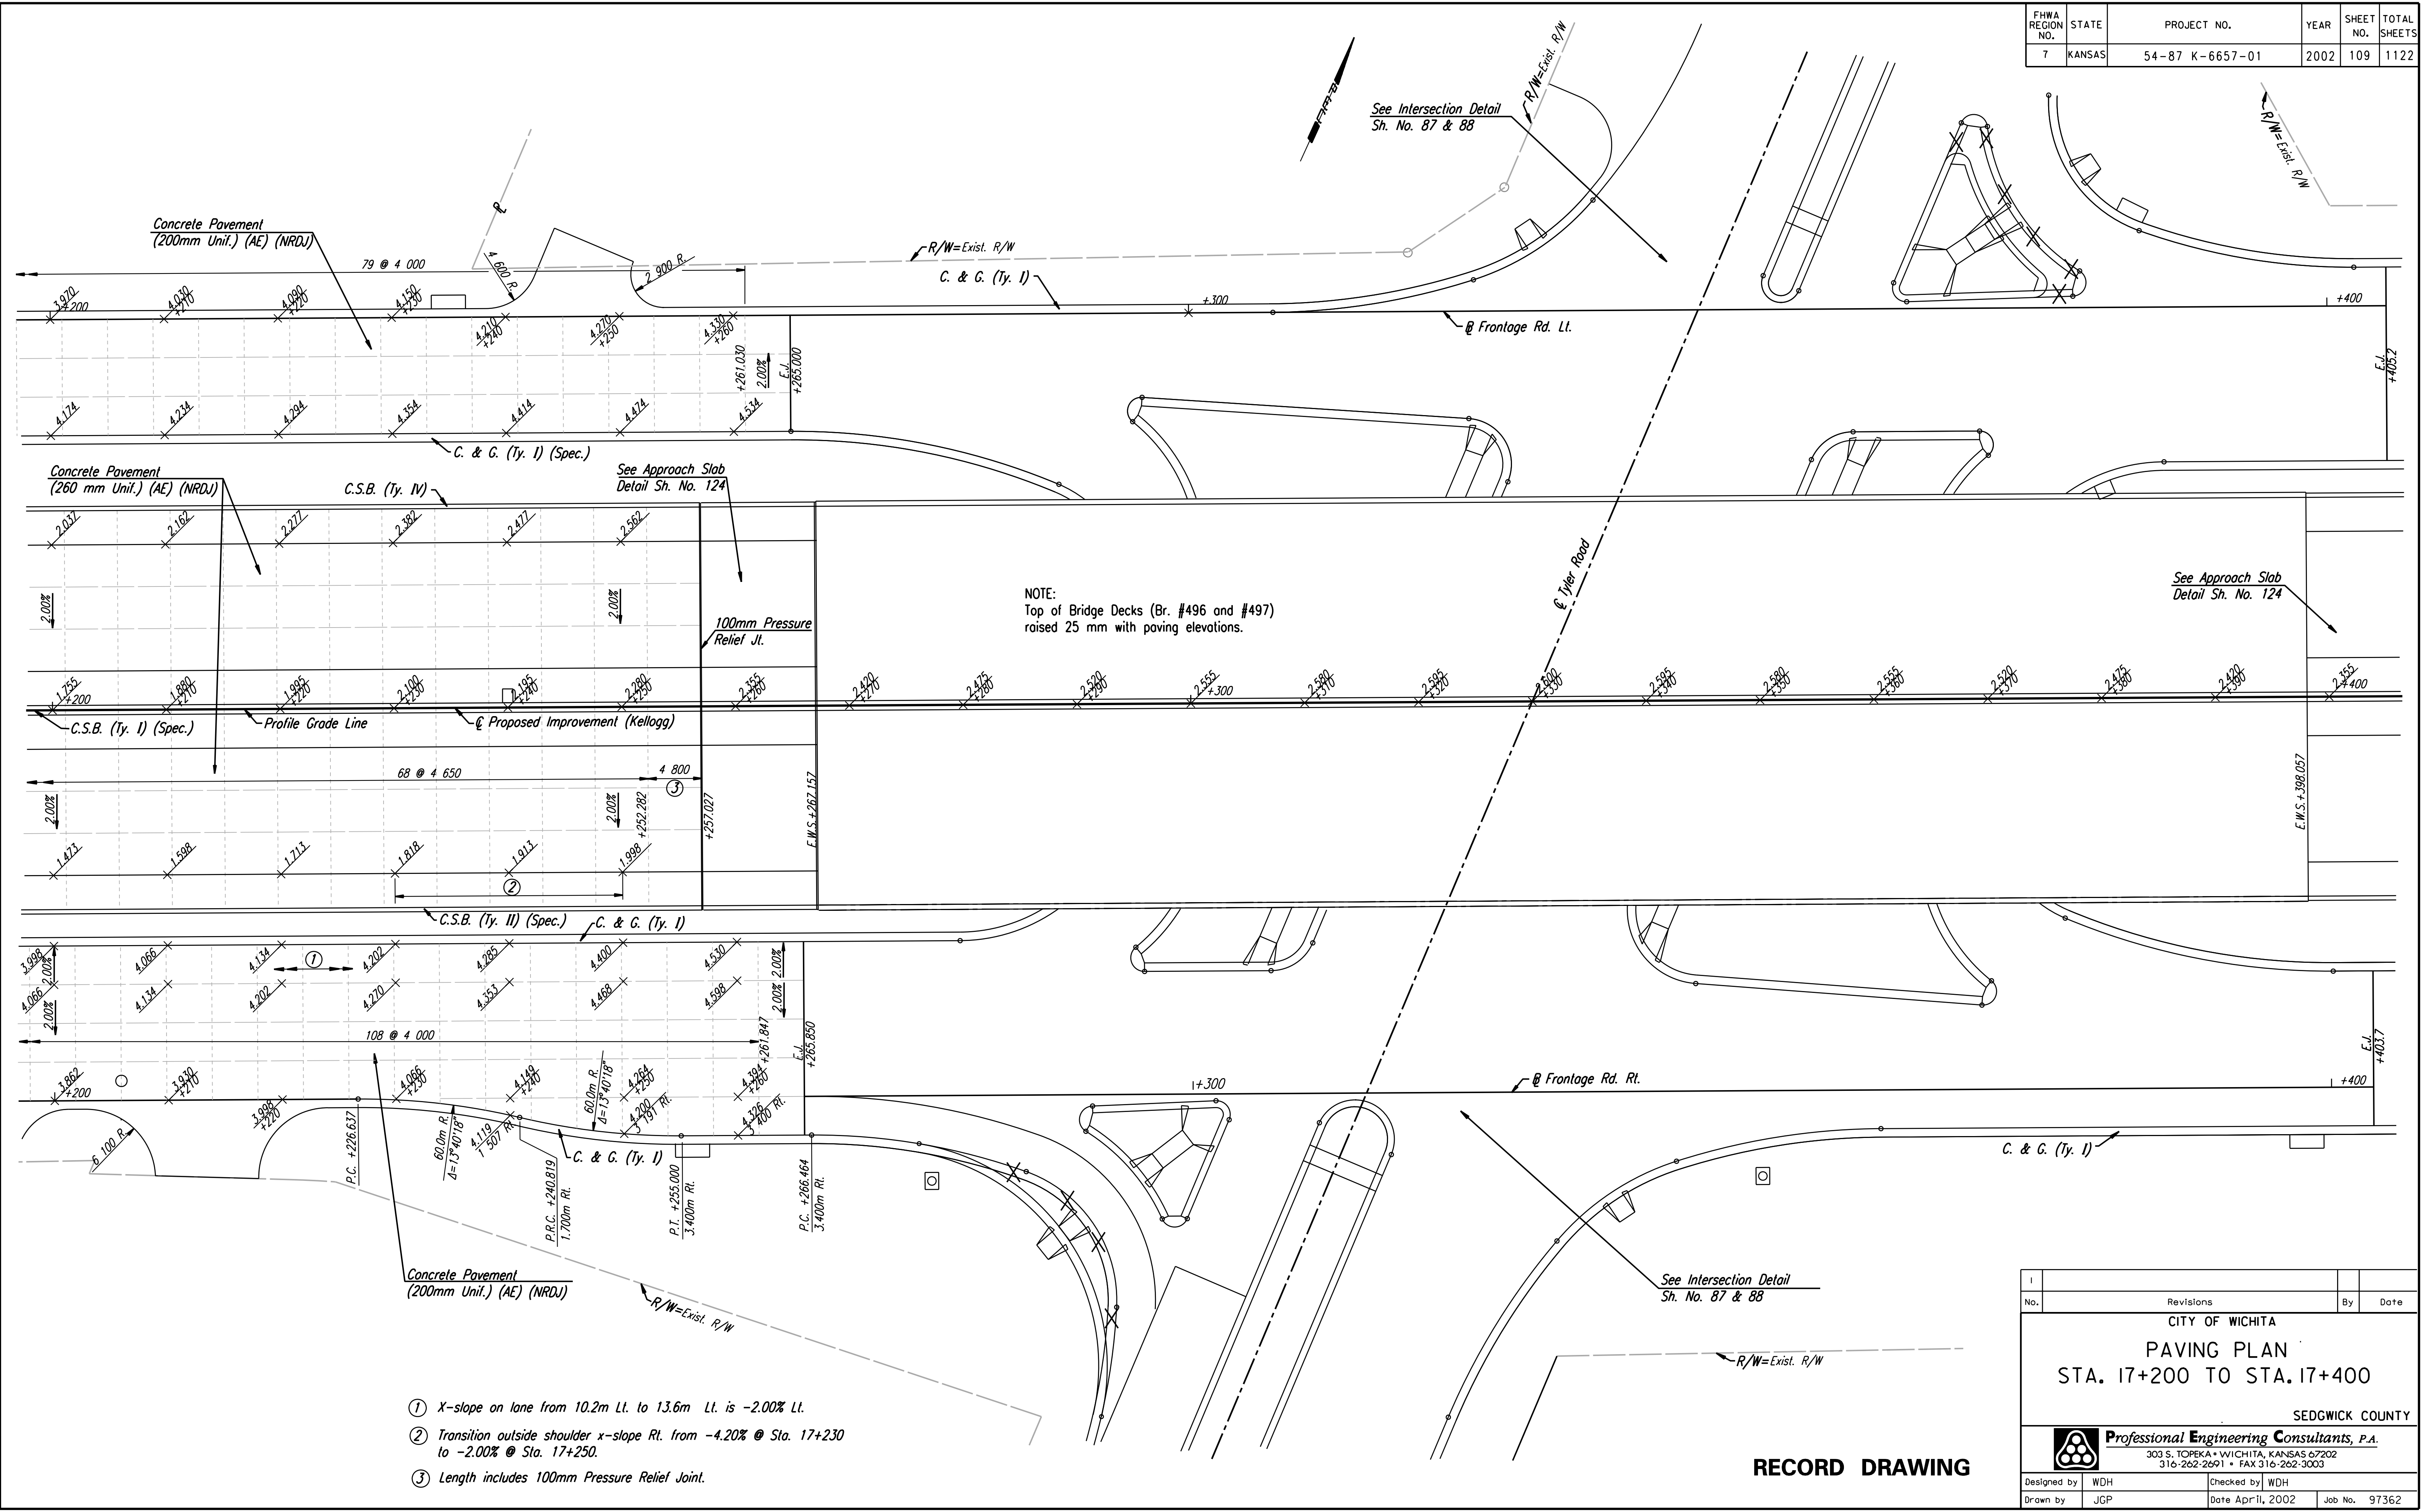

DSNR: WDH OPER: JGP SCALE: 1:250  
 i:/1997/97362/As-Built/dgn's/Sh 109-pav172.dgn Last Rev: 8-13-07 By: gdr

- ① X-slope on lane from 10.2m Lt. to 13.6m Lt. is -2.00% Lt.
- ② Transition outside shoulder x-slope Rt. from -4.20% @ Sta. 17+230 to -2.00% @ Sta. 17+250.
- ③ Length includes 100mm Pressure Relief Joint.

**RECORD DRAWING**

No.	Revisions	By	Date

**CITY OF WICHITA**  
**PAVING PLAN**  
**STA. 17+200 TO STA. 17+400**  
 SEDGWICK COUNTY

**Professional Engineering Consultants, P.A.**  
 303 S. TOPEKA • WICHITA, KANSAS 67202  
 316-262-2691 • FAX 316-262-3003

Designed by	WDH	Checked by	WDH
Drawn by	JGP	Date	Apr 11, 2002
		Job No.	97362