


FHWA REGION NO.	STATE	PROJECT NO.	YEAR	SHEET NO.	TOTAL SHEETS
7	KANSAS	54-87 K-6657-01	2002	113	1122

DATE	
BY	
REFERENCES NOTED	
REFERENCES CHECKED	

DSNR: WDH OPER: JGP SCALE: 1:250
 I:/1997/97362/As-Builts/dgn's/Sh 113-pav180.dgn Last Rev: 8-14-07 By: gdr

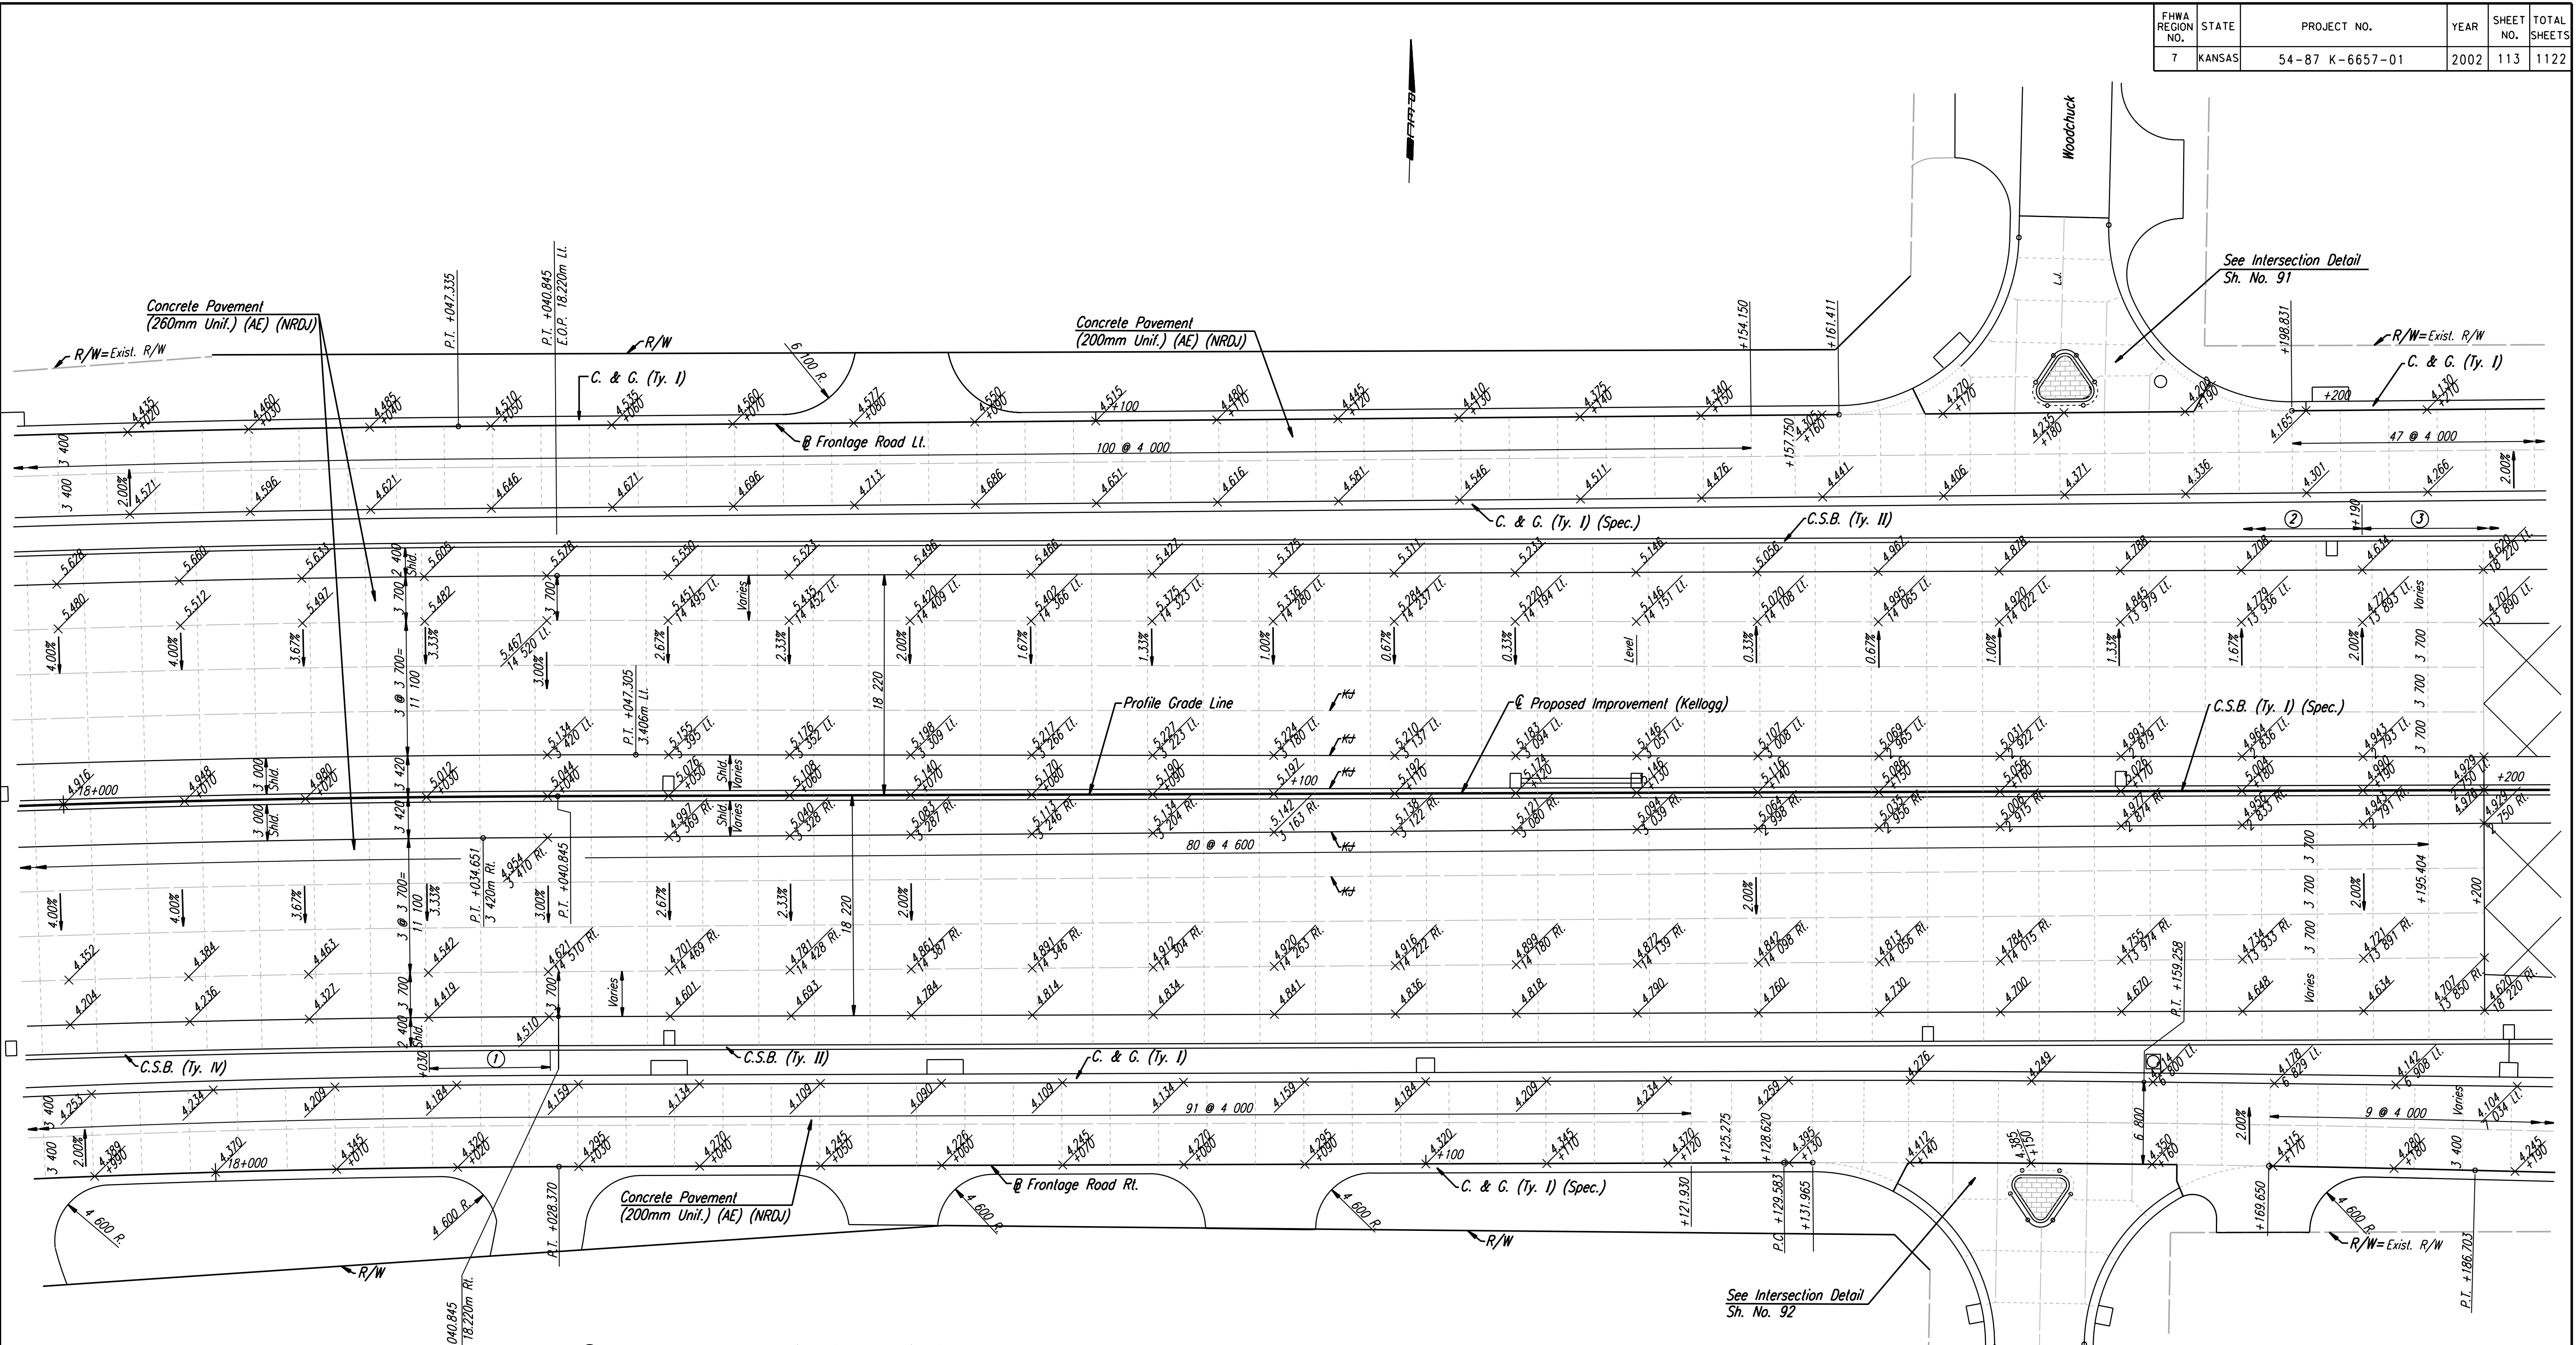

- ① 10.0m transition from C.S.B. (Ty. IV) to C.S.B. (Ty.II). Paid for as C.S.B. (Ty. IV).
- ② See profile & superelevation diagram for x-slope transition.
- ③ Transition outside shoulder x-slope Lt. from -2.00% Lt. @ Sta. 18+190 to -4.20% Lt. @ Sta. 18+210.

NOTE:
 Tie bars were omitted across all Side Roads along Frontage Road Pavement.

RECORD DRAWING

No.	Revisions	By	Date

CITY OF WICHITA
PAVING PLAN
 STA. 18+000 TO STA. 18+200

SEDGWICK COUNTY

Professional Engineering Consultants, P.A.
 303 S. TOPEKA • WICHITA, KANSAS 67202
 316-262-2691 • FAX 316-262-3003

Designed by	WDH	Checked by	WDH
Drawn by	JGP	Date	April, 2002
		Job No.	97362