




STATE	PROJECT NO.	YEAR	SHEET NO.	TOTAL SHEETS
KANSAS	54-87 K-6657-01	2002	120	1122

DATE	
BY	
REFERENCES NOTED	
REFERENCES CHECKED	

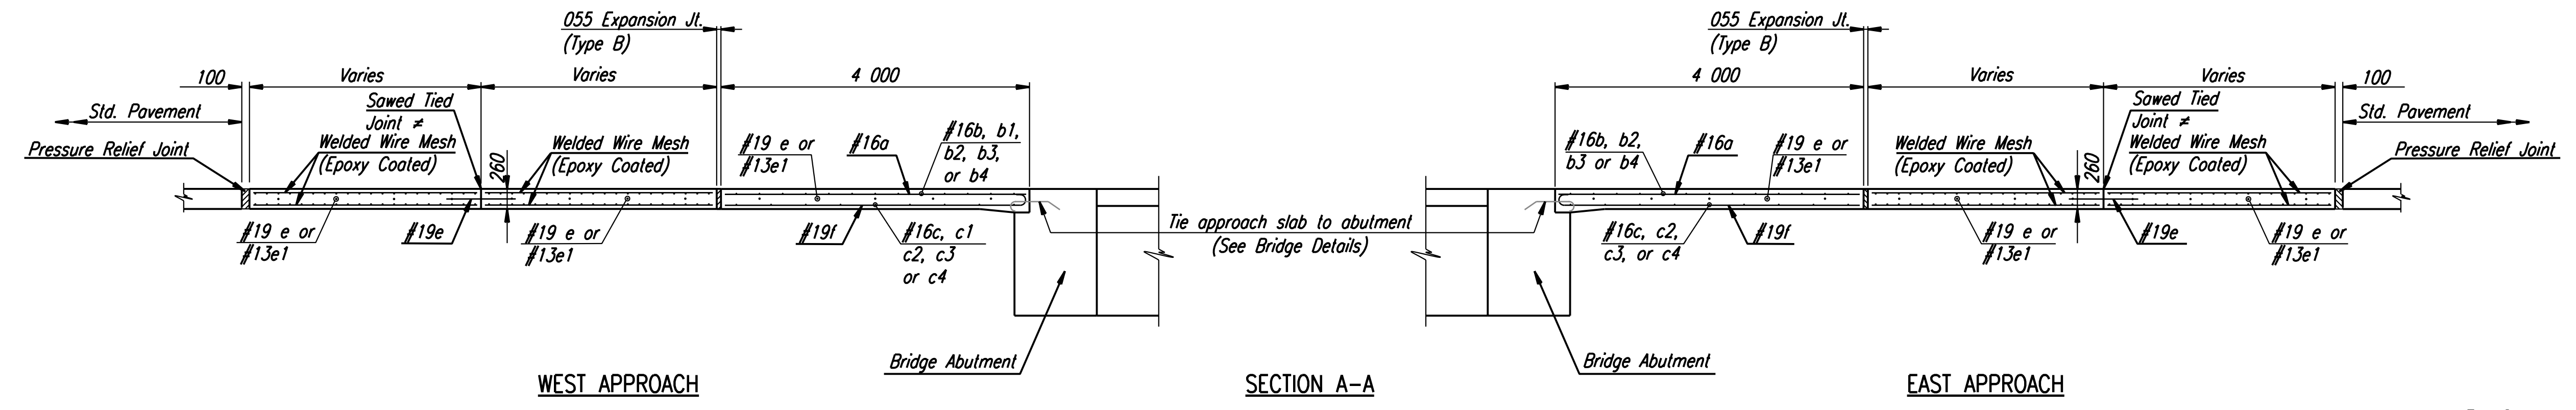

\* The Contractor has the option of substituting a Tied Keyed Construction Joint for the Sawed Tied Joint shown.

For Treatment of Type B Joint through barriers, See Concrete Safety Barrier Detail Sheet.

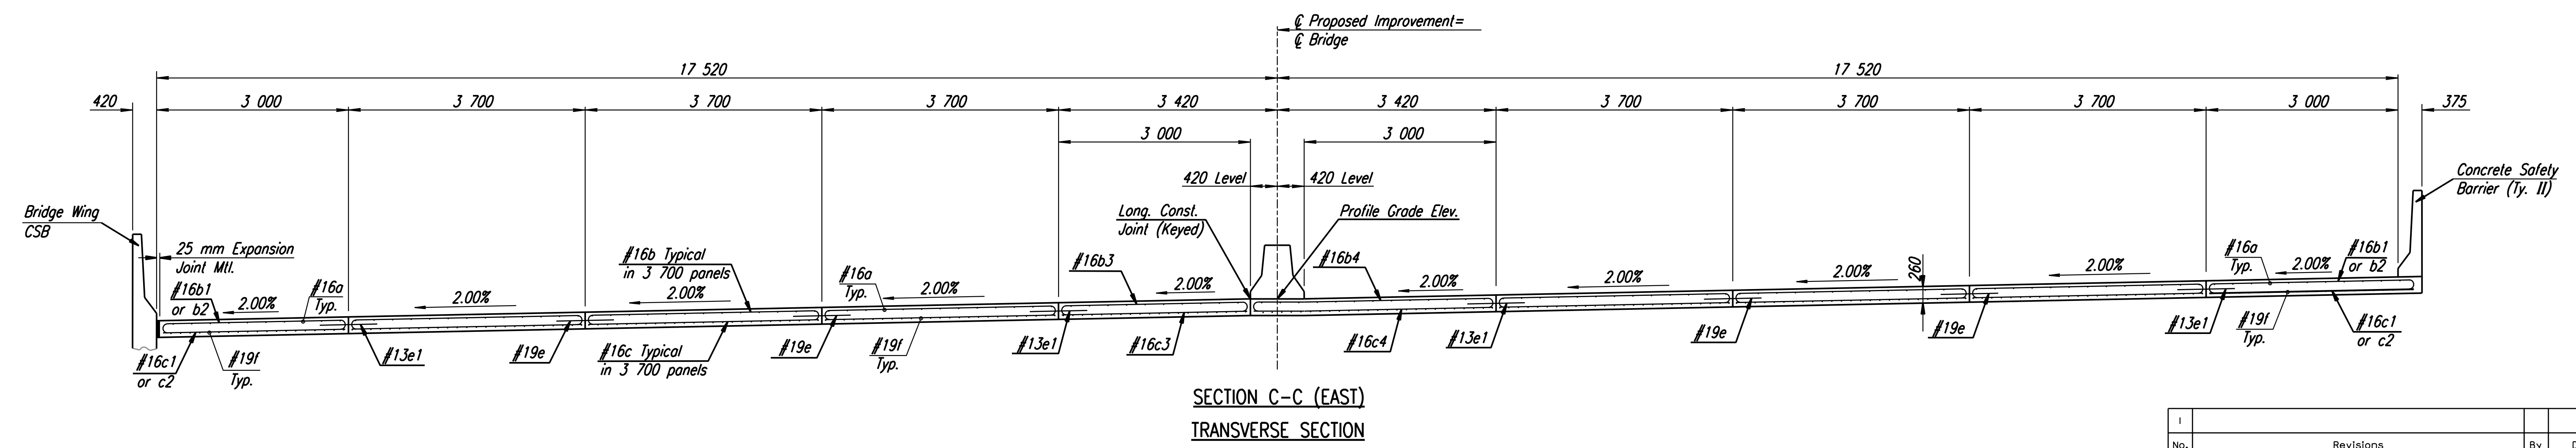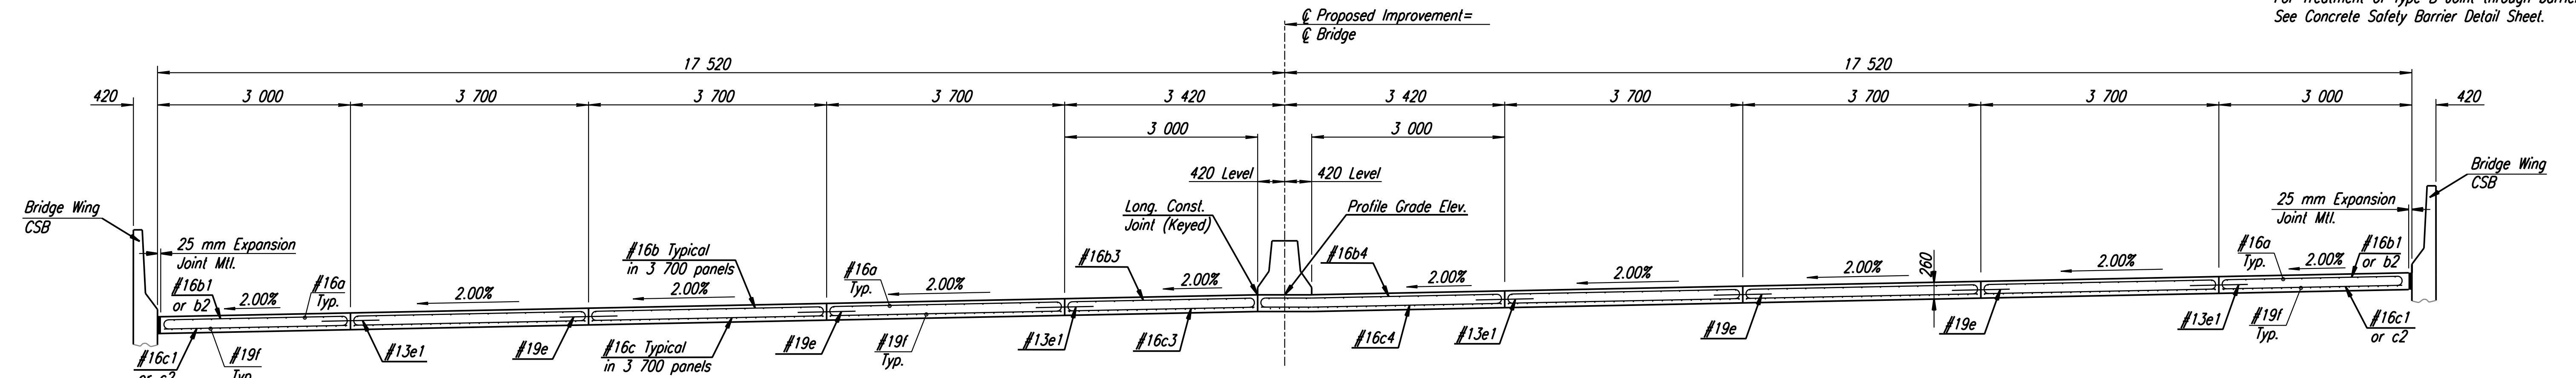

For Concrete Safety Barrier reinforcing details, see Sh. No. 228. Concrete Safety Barrier shall be reinforced through the entire length of the approach pavement.

**RECORD DRAWING**

CITY OF WICHITA			
CONCRETE BRIDGE APPROACH PAVEMENT			
E.B. & W.B. US-54 OVER COWSKIN CREEK			
SEDGWICK COUNTY			
Professional Engineering Consultants, P.A.			
303 S. TOPEKA • WICHITA, KANSAS 67202			
316-262-2691 • FAX 316-262-3003			
Designed by	WDH	Checked by	
Drawn by	JGP	Date	April, 2002
		Job No.	97362

DSNR: OPER: JGP SCALE: 1:50  
 i:/1997/97362/As-Builts/dgn's/Sh 120-ApprSlab-cowsect.dgn Last Rev: 8-14-07 By: gdr