



STATE	PROJECT NO.	YEAR	SHEET NO.	TOTAL SHEETS
KANSAS	54-87 K-6657-01	2002	125	1122

DATE	
BY	
REFERENCES NOTED	
REFERENCES CHECKED	

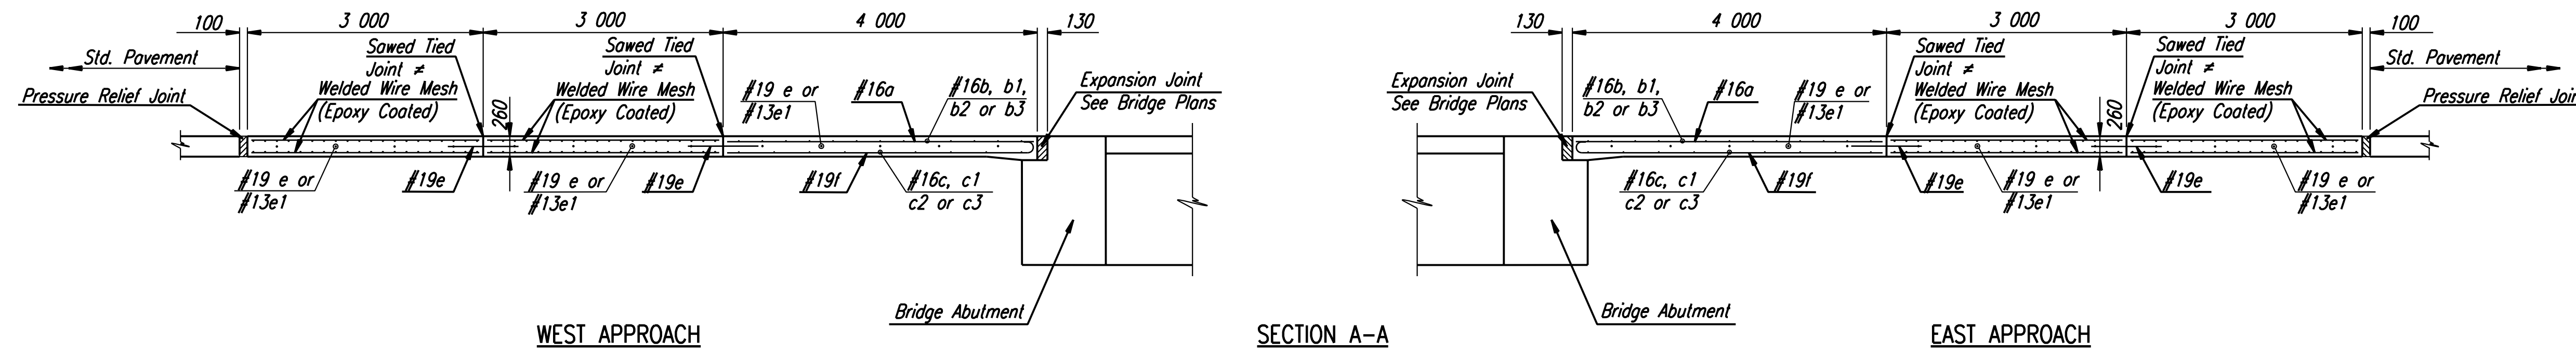

* The Contractor has the option of substituting a Tied Keyed Construction Joint for the Sawed Tied Joint shown.

LONGITUDINAL SECTIONS

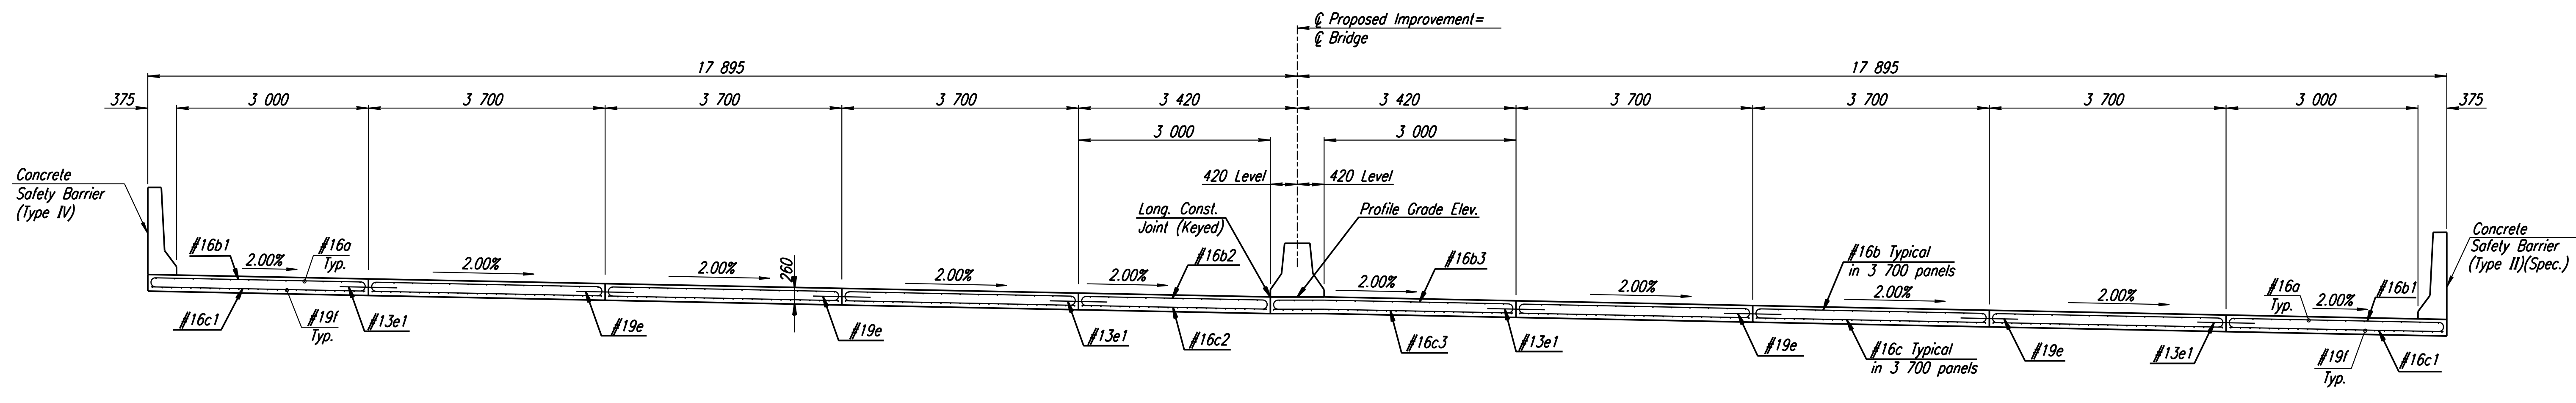

For Concrete Safety Barrier reinforcing details, see Sh. Nos. 228-230
Concrete Safety Barrier shall be reinforced through the entire length of the approach pavement.

DSNR: OPER: JGP SCALE: 1:50
 i:/1997/97362/As-Builts/dgn's/Sh 125-ApprSlab-tylsect.dgn Last Rev: 8-14-07 By: gdr

No.	Revisions	By	Date
CITY OF WICHITA			
CONCRETE BRIDGE APPROACH PAVEMENT E.B. & W.B. US-54 OVER TYLER ROAD			
SEDGWICK COUNTY			
Professional Engineering Consultants, P.A. <small>303 S. TOPEKA • WICHITA, KANSAS 67202 316-262-2691 • FAX 316-262-3003</small>			
Designed by	WDH	Checked by	
Drawn by	JGP	Date	April, 2002
		Job No.	97362

RECORD DRAWING