


FHWA REGION NO.	STATE	PROJECT NO.	YEAR	SHEET NO.	TOTAL SHEETS
7	KANSAS	54-87 K-6657-01	2002	151	1122

DATE	BY	REFERENCES NOTED	REFERENCES CHECKED

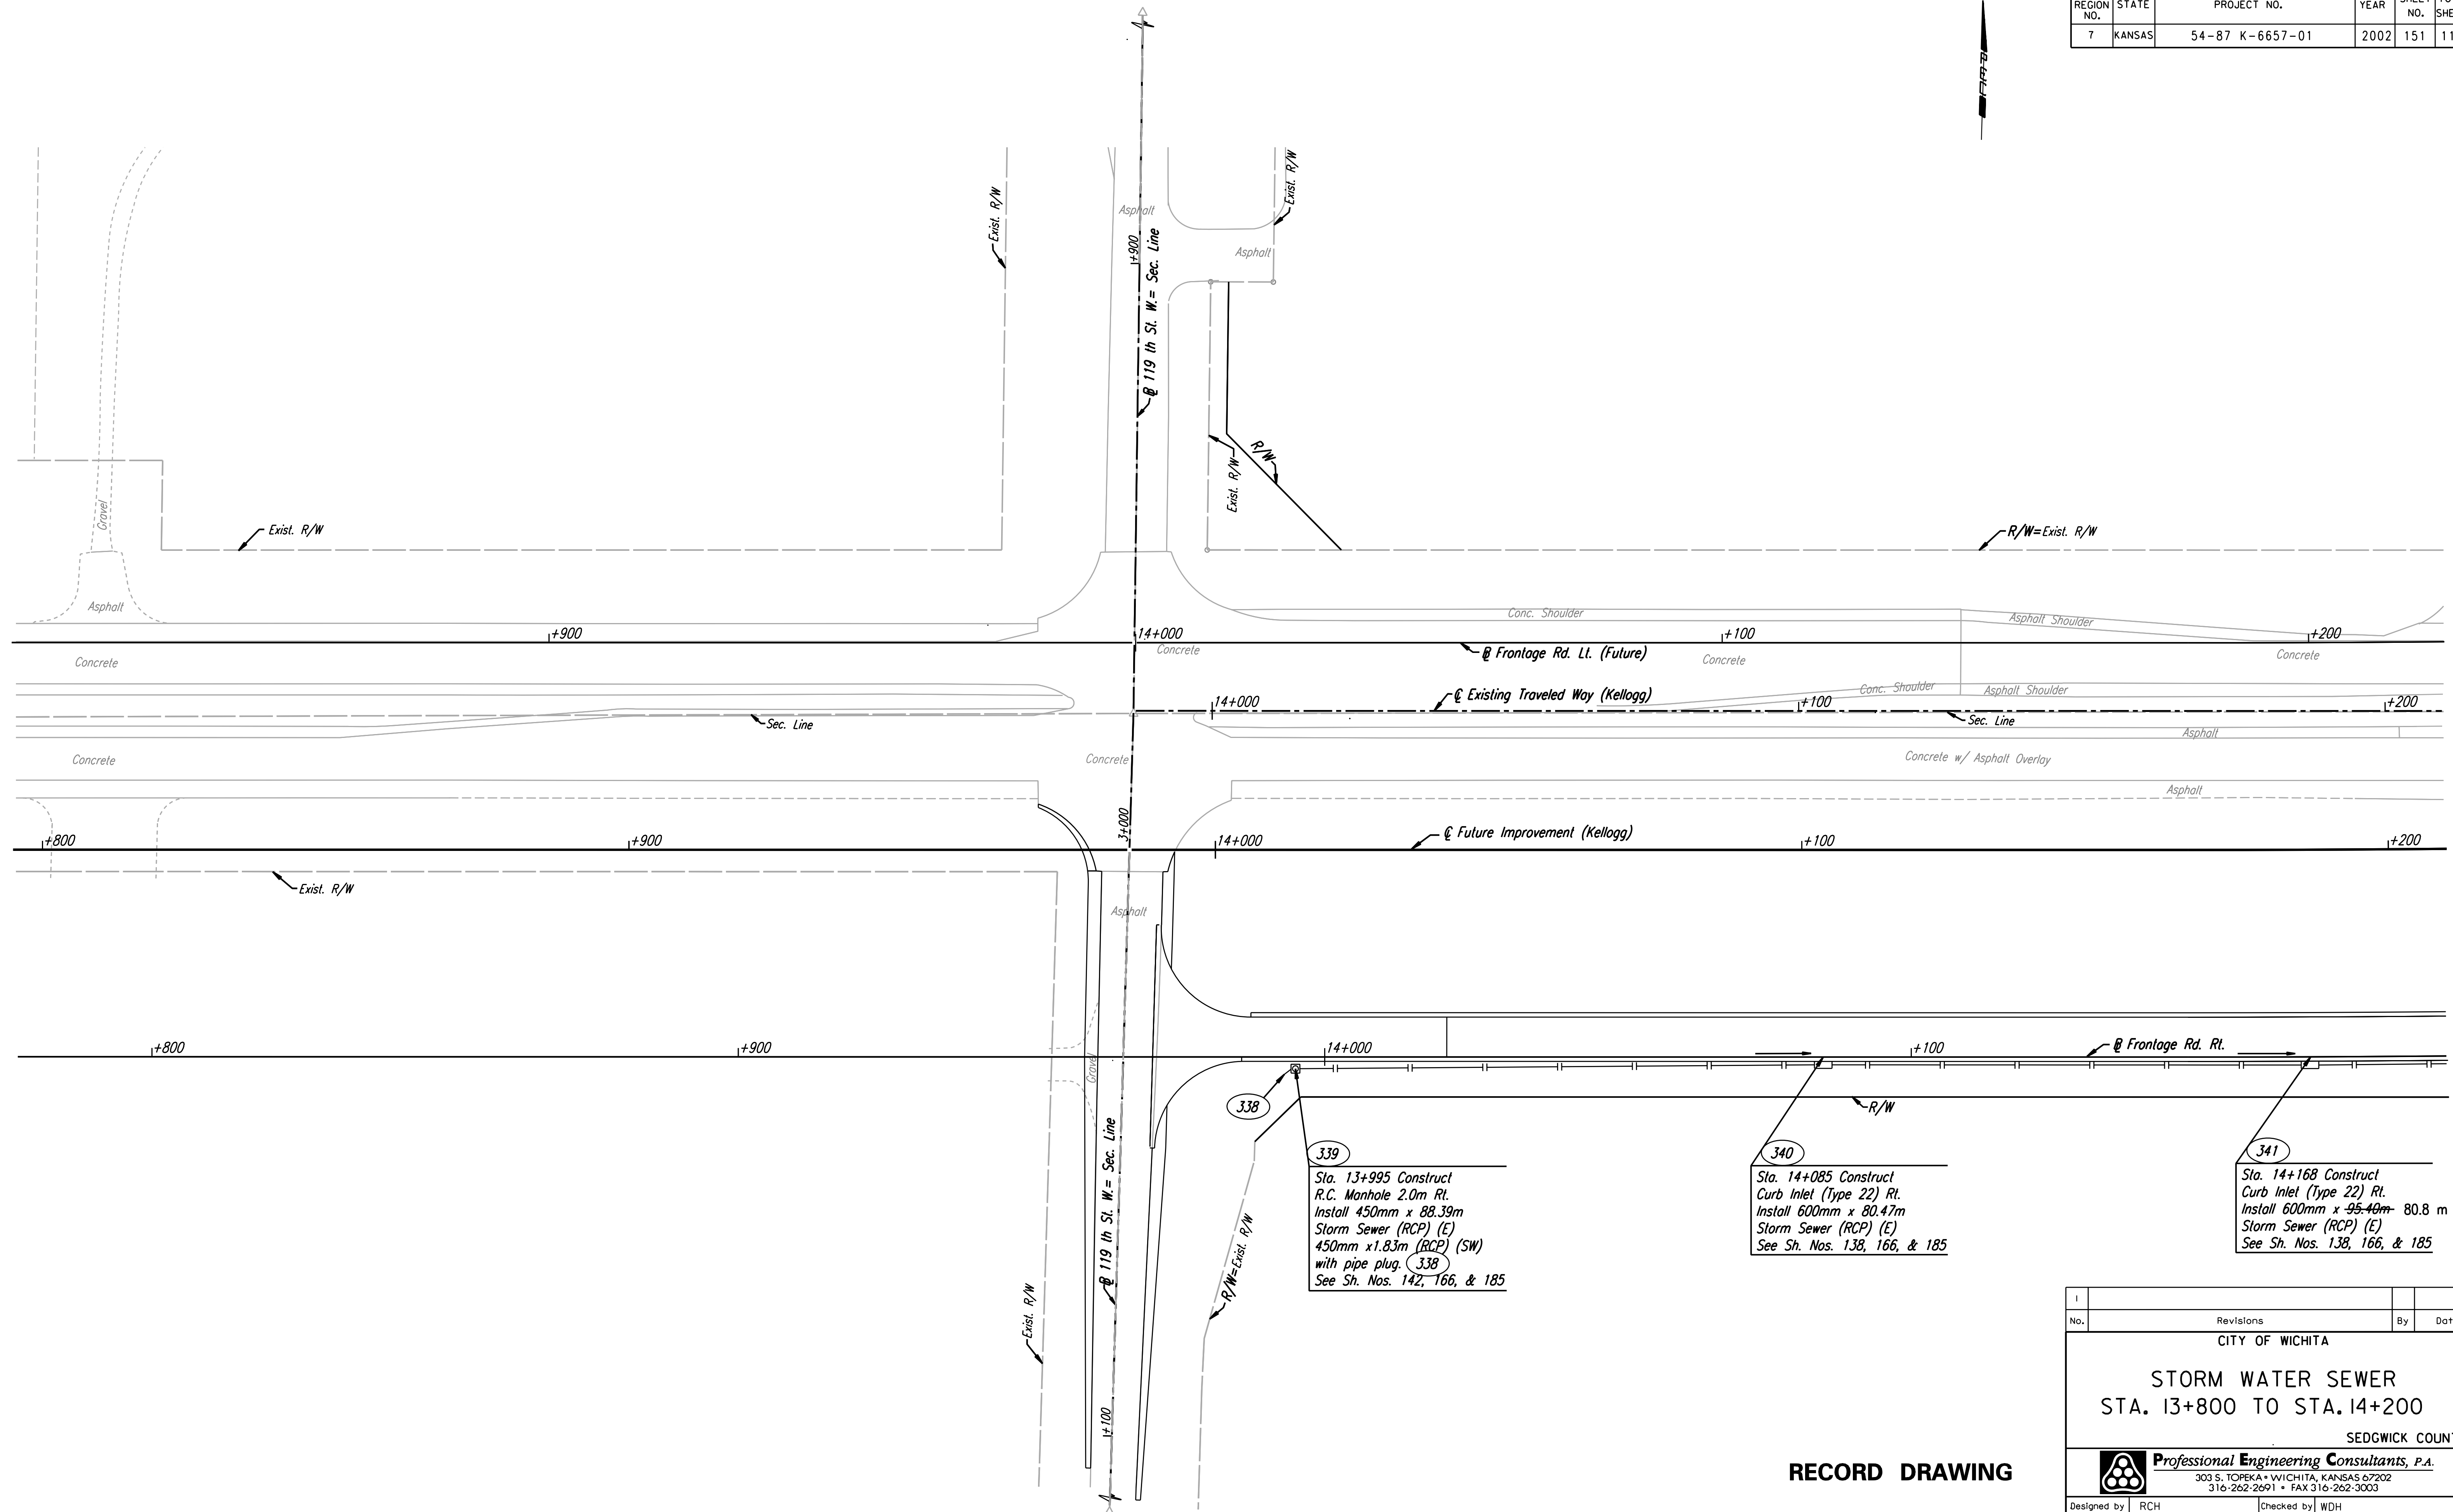

DSNR: JPS OPER: JGP SCALE: 1:500
 i:/1997/97362/As-Builts/dgn/151-swst138.dgn Last Rev: 7-31-07 By: gdr

339
 Sta. 13+995 Construct
 R.C. Manhole 2.0m Rt.
 Install 450mm x 88.39m
 Storm Sewer (RCP) (E)
 450mm x 1.83m (RCP) (SW)
 with pipe plug. **338**
 See Sh. Nos. 142, 166, & 185

340
 Sta. 14+085 Construct
 Curb Inlet (Type 22) Rt.
 Install 600mm x 80.47m
 Storm Sewer (RCP) (E)
 See Sh. Nos. 138, 166, & 185

341
 Sta. 14+168 Construct
 Curb Inlet (Type 22) Rt.
 Install 600mm x ~~95.40m~~ 80.8 m
 Storm Sewer (RCP) (E)
 See Sh. Nos. 138, 166, & 185

RECORD DRAWING

1			
No.	Revisions	By	Date
CITY OF WICHITA			
STORM WATER SEWER STA. 13+800 TO STA. 14+200			
SEDGWICK COUNTY			
Professional Engineering Consultants, P.A. <small>303 S. TOPEKA • WICHITA, KANSAS 67202 316-262-2691 • FAX 316-262-3003</small>			
Designed by	RCH	Checked by	WDH
Drawn by	JGP	Date	April, 2002
		Job No.	97362