


FHWA REGION NO.	STATE	PROJECT NO.	YEAR	SHEET NO.	TOTAL SHEETS
7	KANSAS	54-87 K-6657-01	2002	152	1122

* Construct 200mm masonry plug in inlet opening. (Subsidiary).

DATE	
BY	
REFERENCES NOTED	
REFERENCES CHECKED	

DSNR: JPS OPER: JGP SCALE: 1:500
 I:/1997/97362/As-Builts/dgn's/Sh_152-sws142.dgn Last Rev: 7-31-07 By: gdr

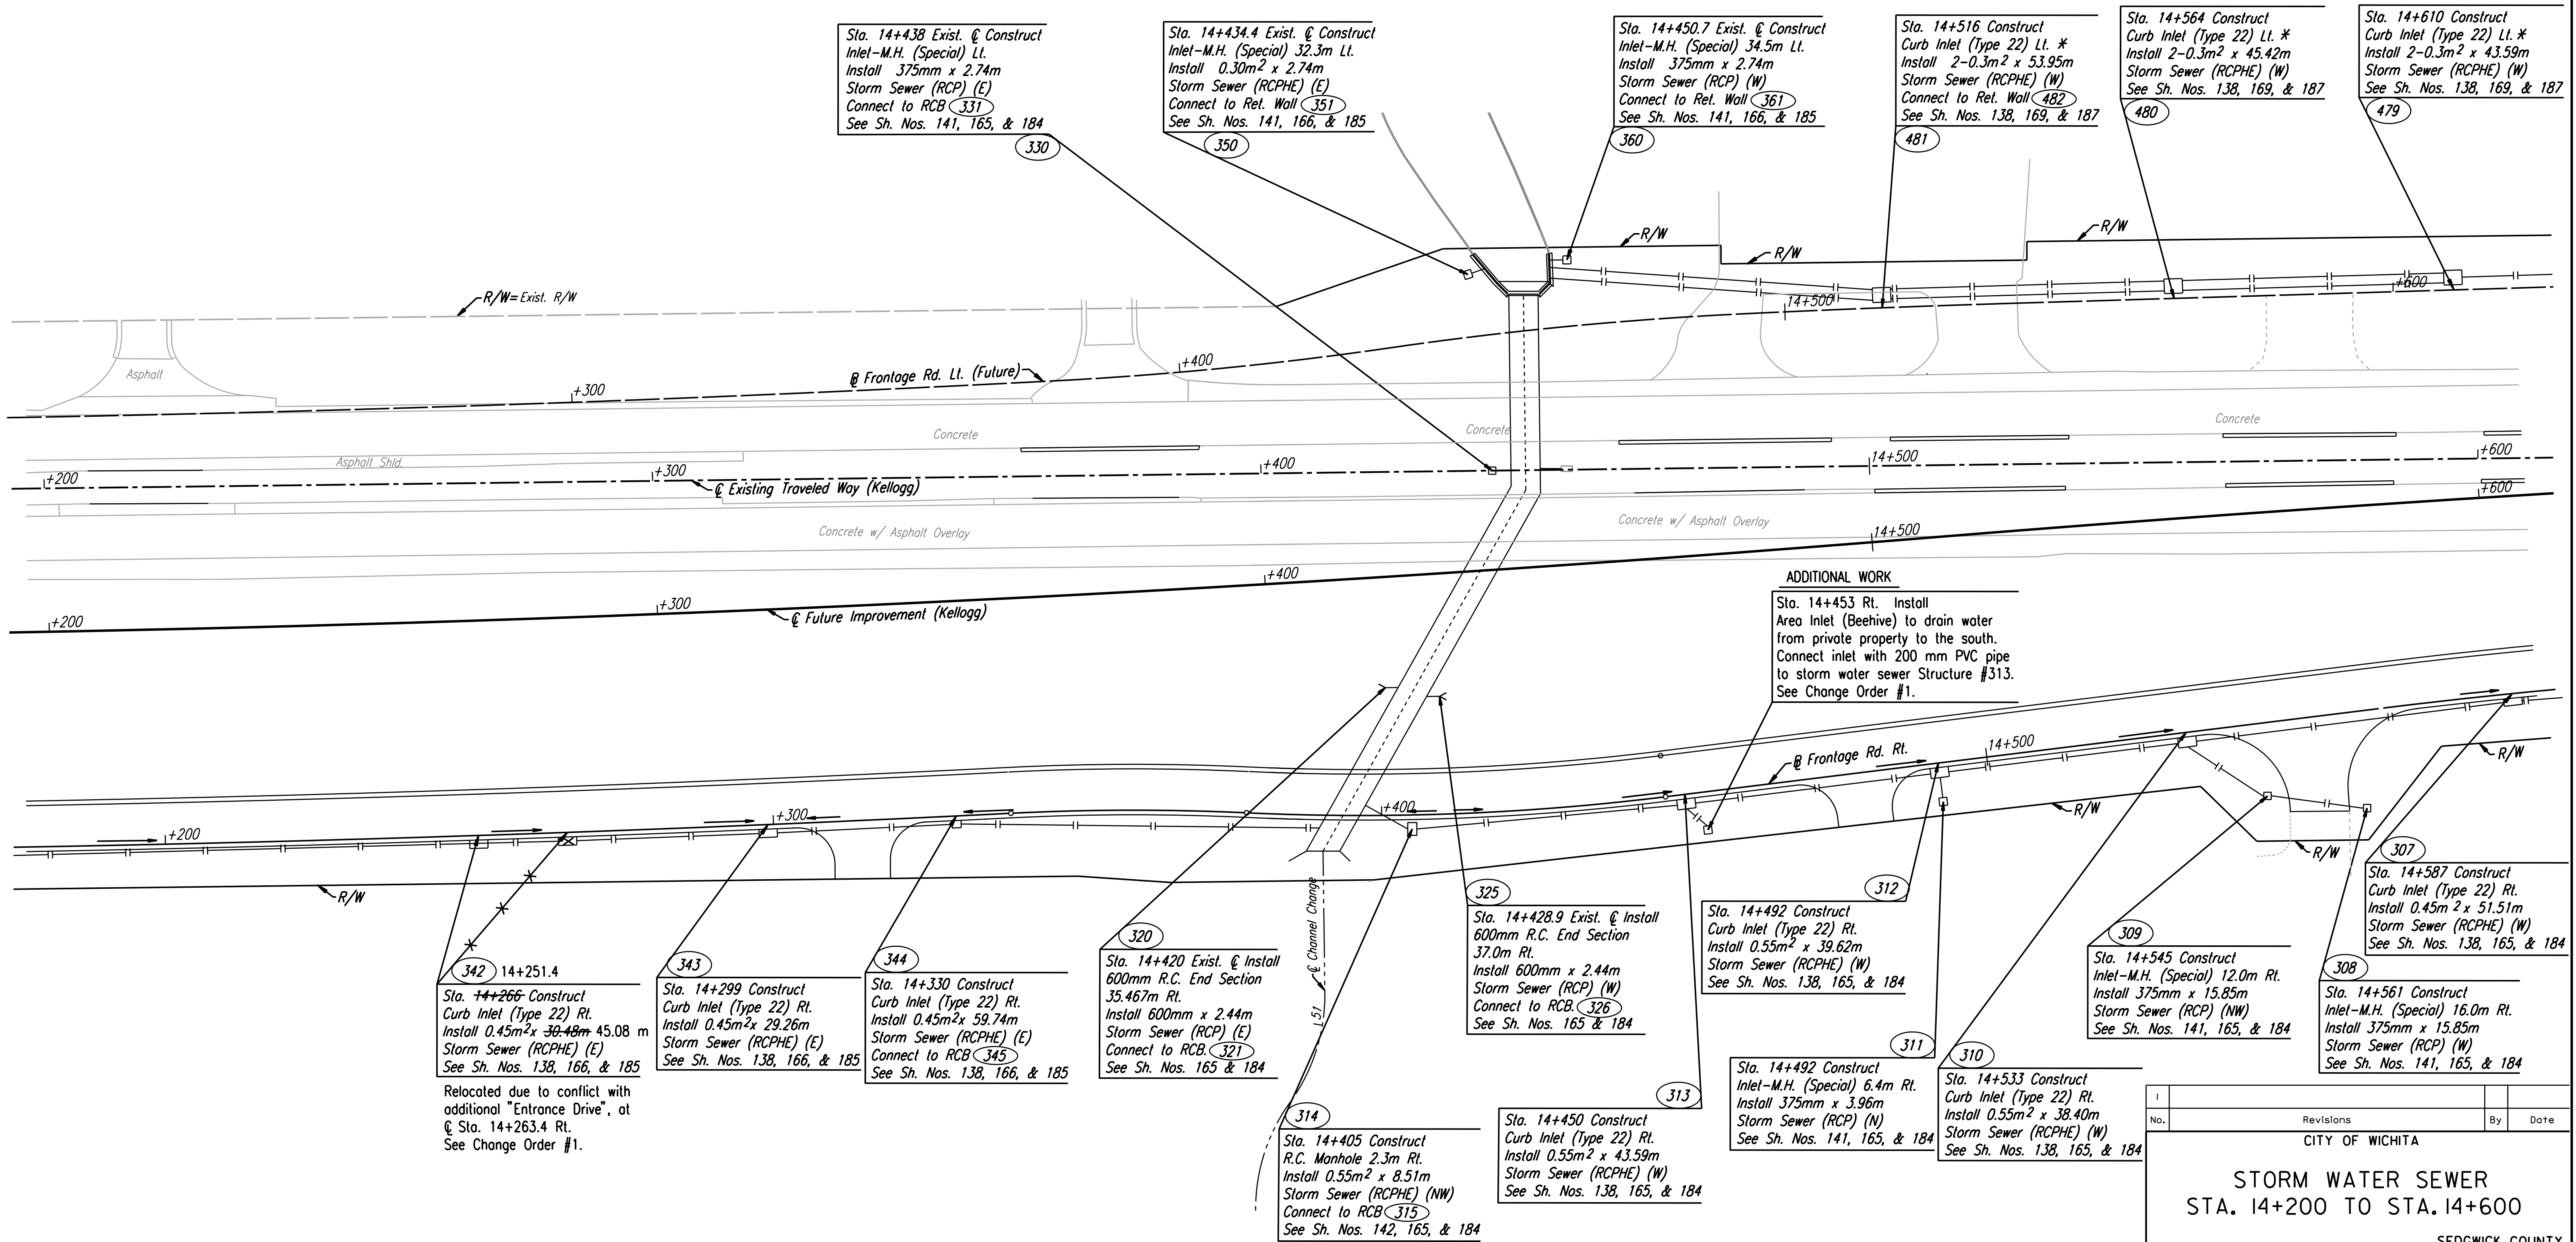

ADDITIONAL WORK

Sta. 14+453 Rt. Install Area Inlet (Beehive) to drain water from private property to the south. Connect inlet with 200 mm PVC pipe to storm water sewer Structure #313. See Change Order #1.

Sta. 14+266 Construct Curb Inlet (Type 22) Rt. Install 0.45m² x 30.49m Storm Sewer (RCPHE) (E) See Sh. Nos. 138, 166, & 185
 Relocated due to conflict with additional "Entrance Drive", at Sta. 14+263.4 Rt. See Change Order #1.

Sta. 14+299 Construct Curb Inlet (Type 22) Rt. Install 0.45m² x 29.26m Storm Sewer (RCPHE) (E) See Sh. Nos. 138, 166, & 185

Sta. 14+330 Construct Curb Inlet (Type 22) Rt. Install 0.45m² x 59.74m Storm Sewer (RCPHE) (E) Connect to RCB 345 See Sh. Nos. 138, 166, & 185

Sta. 14+420 Exist. @ Install 600mm R.C. End Section 35.467m Rt. Install 600mm x 2.44m Storm Sewer (RCP) (E) Connect to RCB 321 See Sh. Nos. 165 & 184

Sta. 14+405 Construct R.C. Manhole 2.3m Rt. Install 0.55m² x 8.51m Storm Sewer (RCPHE) (NW) Connect to RCB 315 See Sh. Nos. 142, 165, & 184

Sta. 14+450 Construct Curb Inlet (Type 22) Rt. Install 0.55m² x 43.59m Storm Sewer (RCPHE) (W) See Sh. Nos. 138, 165, & 184

Sta. 14+428.9 Exist. @ Install 600mm R.C. End Section 37.0m Rt. Install 600mm x 2.44m Storm Sewer (RCP) (W) Connect to RCB 326 See Sh. Nos. 165 & 184

Sta. 14+492 Construct Curb Inlet (Type 22) Rt. Install 0.55m² x 39.62m Storm Sewer (RCPHE) (W) See Sh. Nos. 138, 165, & 184

Sta. 14+545 Construct Inlet-M.H. (Special) 12.0m Rt. Install 375mm x 15.85m Storm Sewer (RCP) (NW) See Sh. Nos. 141, 165, & 184

Sta. 14+587 Construct Curb Inlet (Type 22) Rt. Install 0.45m² x 51.51m Storm Sewer (RCPHE) (W) See Sh. Nos. 138, 165, & 184

No.	Revisions	By	Date

CITY OF WICHITA
STORM WATER SEWER
STA. 14+200 TO STA. 14+600
 SEDGWICK COUNTY

RECORD DRAWING

Professional Engineering Consultants, P.A.
 303 S. TOPEKA • WICHITA, KANSAS 67202
 316-262-2691 • FAX 316-262-3003

Designed by	RCH	Checked by	WDH
Drawn by	JGP	Date	April, 2002
		Job No.	97362