

FHWA REGION NO.	STATE	PROJECT NO.	YEAR	SHEET NO.	TOTAL SHEETS
7	KANSAS	54-87 K-6657-01	2002	153	1122

**ADDITIONAL WORK**


Sta. 14+993 Lt. Construct Inlet (Special) to drain water from north-south Drainage swale on private property to the north. Connect 200 mm PVC pipe to storm water sewer (RCPHE). See Change Order #2.

**ADDITIONAL WORK**

Sta. 14+924 Lt. Construct Inlet (Special) to drain water from north-south ditch on private property to the north. Connect 200 mm PVC pipe to storm water sewer (RCPHE). See Change Order #2.

DATE	
BY	
REFERENCES NOTED	
REFERENCES CHECKED	

\* Construct 200mm masonry plug in inlet opening. (Subsidiary).

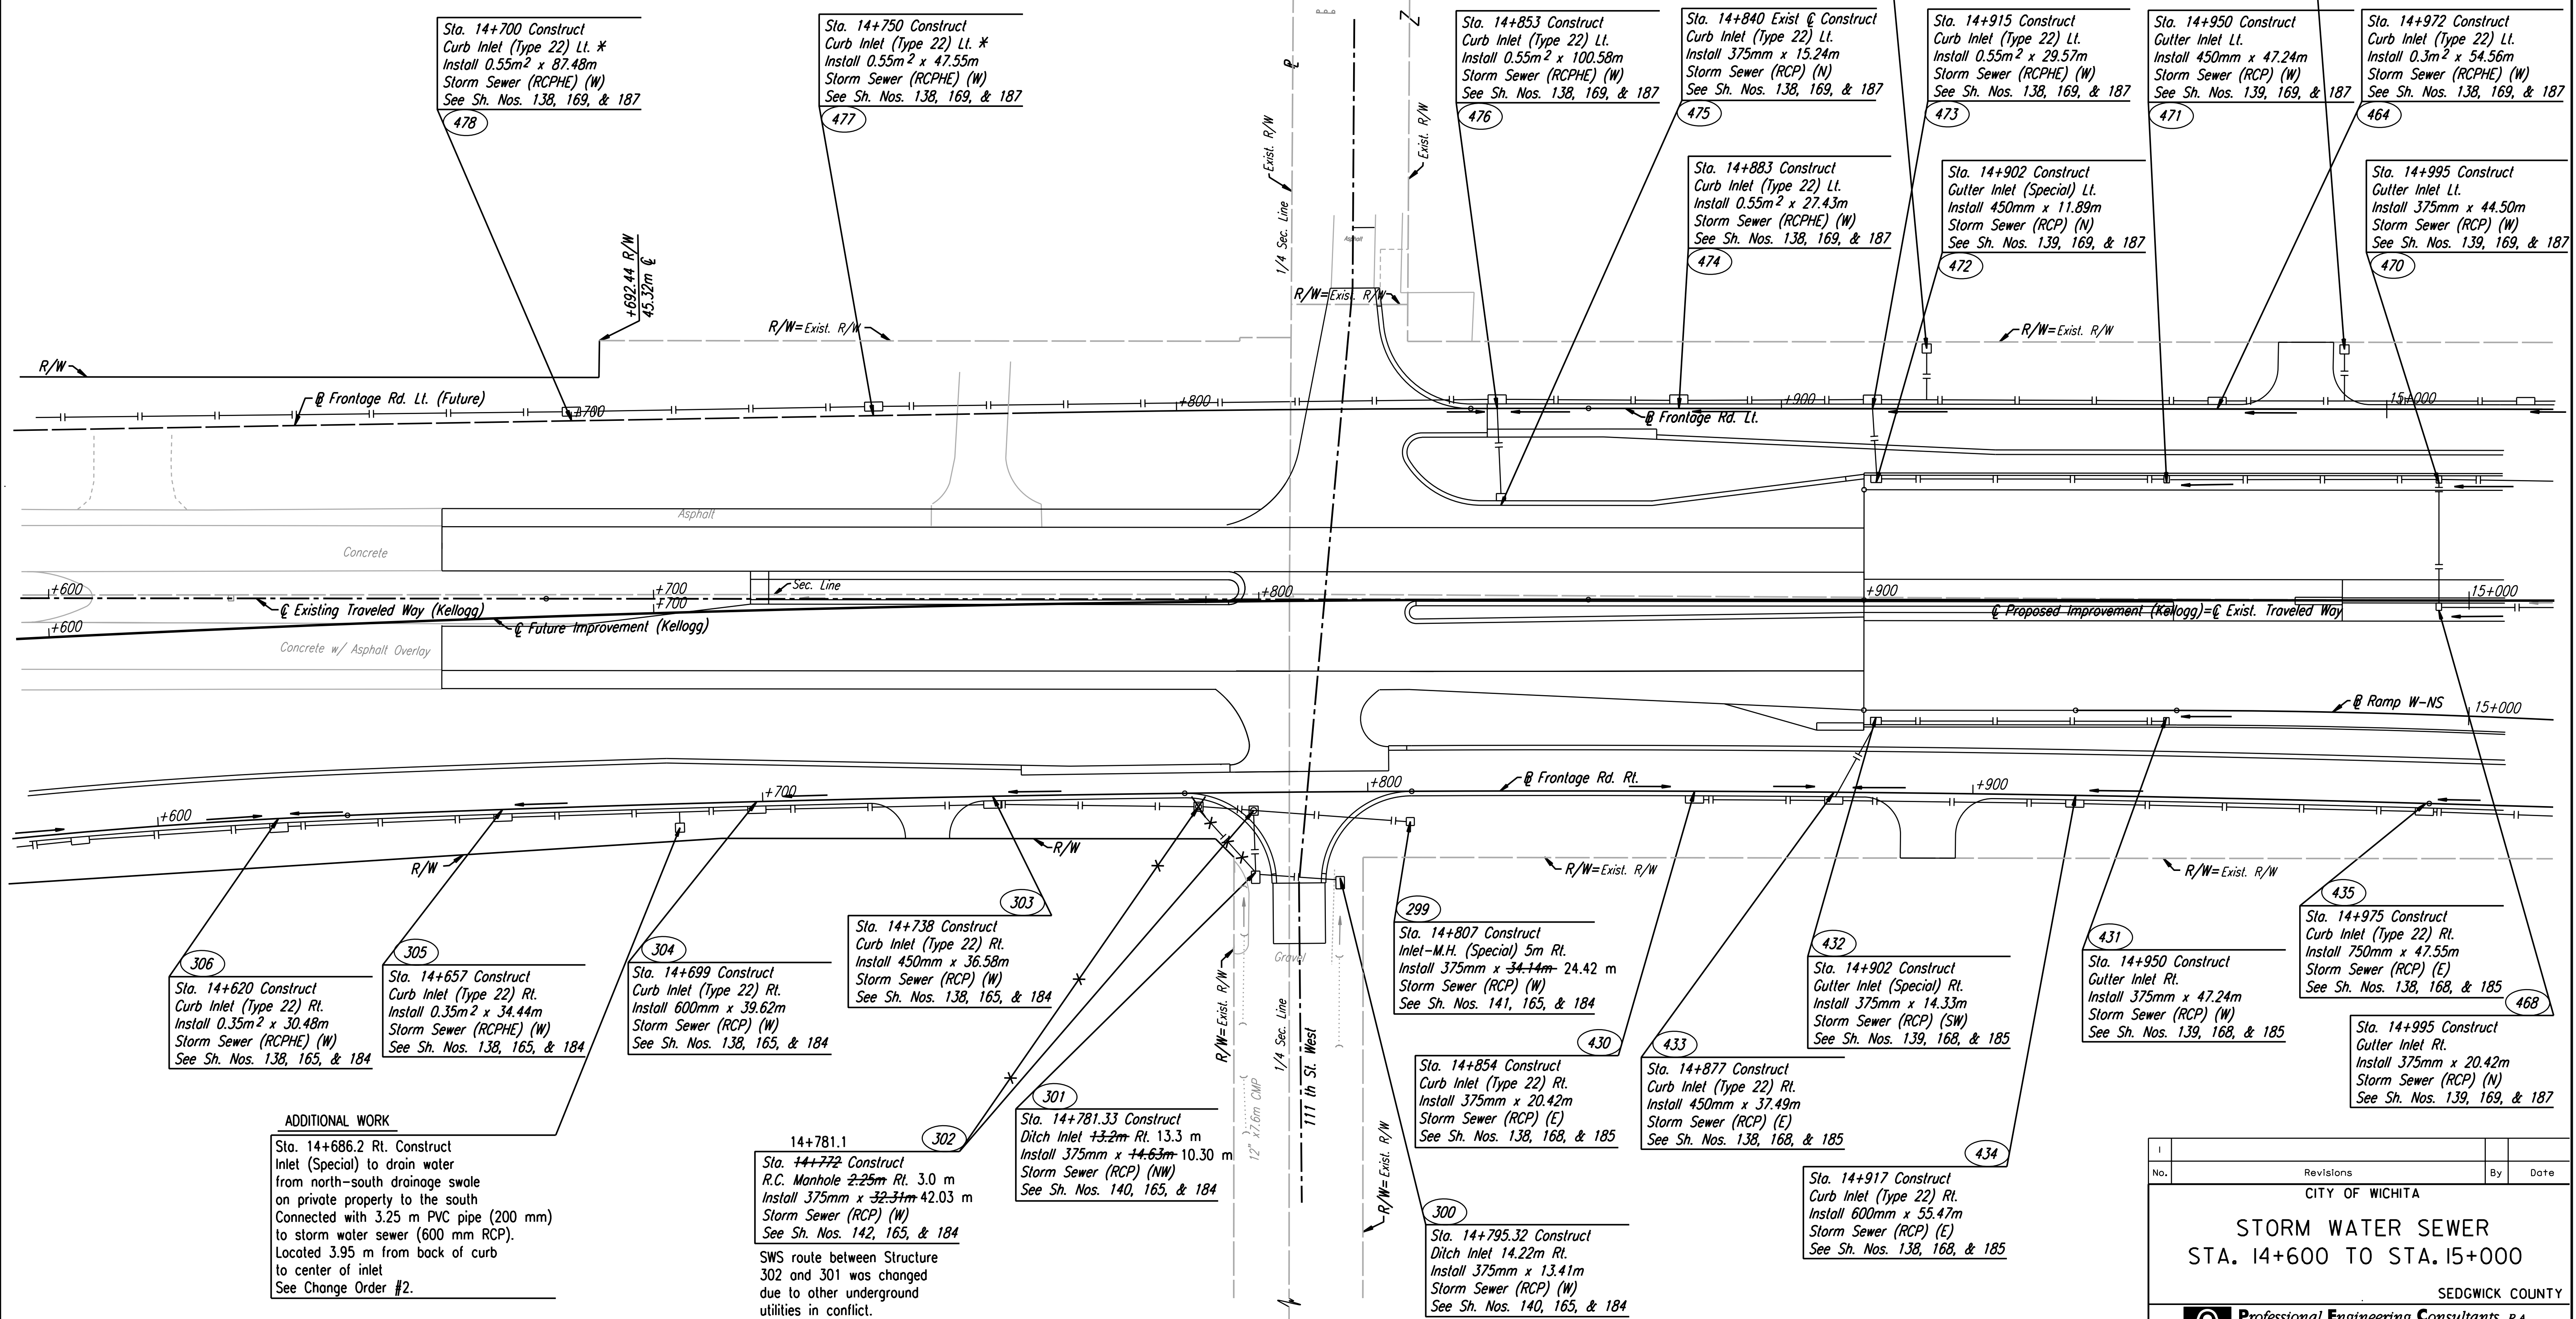

**ADDITIONAL WORK**

Sta. 14+686.2 Rt. Construct Inlet (Special) to drain water from north-south drainage swale on private property to the south. Connected with 3.25 m PVC pipe (200 mm) to storm water sewer (600 mm RCP). Located 3.95 m from back of curb to center of inlet. See Change Order #2.

Sta. 14+772 Construct R.C. Manhole 2-25m Rt. 3.0 m. Install 375mm x 32.31m 42.03 m Storm Sewer (RCP) (W). See Sh. Nos. 142, 165, & 184.

SWS route between Structure 302 and 301 was changed due to other underground utilities in conflict.

Sta. 14+620 Construct Curb Inlet (Type 22) Rt. Install 0.35m<sup>2</sup> x 30.48m Storm Sewer (RCPHE) (W). See Sh. Nos. 138, 165, & 184.

Sta. 14+657 Construct Curb Inlet (Type 22) Rt. Install 0.35m<sup>2</sup> x 34.44m Storm Sewer (RCPHE) (W). See Sh. Nos. 138, 165, & 184.

Sta. 14+699 Construct Curb Inlet (Type 22) Rt. Install 600mm x 39.62m Storm Sewer (RCP) (W). See Sh. Nos. 138, 165, & 184.

Sta. 14+738 Construct Curb Inlet (Type 22) Rt. Install 450mm x 36.58m Storm Sewer (RCP) (W). See Sh. Nos. 138, 165, & 184.

Sta. 14+781.33 Construct Ditch Inlet 13.3m Rt. 13.3 m. Install 375mm x 14.63m 10.30 m Storm Sewer (RCP) (NW). See Sh. Nos. 140, 165, & 184.

Sta. 14+807 Construct Inlet-M.H. (Special) 5m Rt. Install 375mm x 24.42 m Storm Sewer (RCP) (W). See Sh. Nos. 141, 165, & 184.

Sta. 14+854 Construct Curb Inlet (Type 22) Rt. Install 375mm x 20.42m Storm Sewer (RCP) (E). See Sh. Nos. 138, 168, & 185.

Sta. 14+795.32 Construct Ditch Inlet 14.22m Rt. Install 375mm x 13.41m Storm Sewer (RCP) (W). See Sh. Nos. 140, 165, & 184.

Sta. 14+877 Construct Curb Inlet (Type 22) Rt. Install 450mm x 37.49m Storm Sewer (RCP) (E). See Sh. Nos. 138, 168, & 185.

Sta. 14+917 Construct Curb Inlet (Type 22) Rt. Install 600mm x 55.47m Storm Sewer (RCP) (E). See Sh. Nos. 138, 168, & 185.

Sta. 14+902 Construct Gutter Inlet (Special) Rt. Install 375mm x 14.33m Storm Sewer (RCP) (SW). See Sh. Nos. 139, 168, & 185.

Sta. 14+950 Construct Gutter Inlet Rt. Install 375mm x 47.24m Storm Sewer (RCP) (W). See Sh. Nos. 139, 168, & 185.

Sta. 14+975 Construct Curb Inlet (Type 22) Rt. Install 750mm x 47.55m Storm Sewer (RCP) (E). See Sh. Nos. 138, 168, & 185.

Sta. 14+995 Construct Gutter Inlet Rt. Install 375mm x 20.42m Storm Sewer (RCP) (N). See Sh. Nos. 139, 169, & 187.

No.	Revisions	By	Date

CITY OF WICHITA  
**STORM WATER SEWER**  
STA. 14+600 TO STA. 15+000

SEDGWICK COUNTY

**Professional Engineering Consultants, P.A.**  
303 S. TOPEKA • WICHITA, KANSAS 67202  
316-262-2691 • FAX 316-262-3003

Designed by	RCH	Checked by	WDH
Drawn by	JGP	Date	April, 2002
		Job No.	97362

**RECORD DRAWING**

DSNR: JPS OPER: JGP SCALE: 1:500  
 I:/1997/97362/As-Builts/dgn s/SH\_153-sws-146.dgn Last Rev: 8-1-07 By: gdr